



EXISTING SITE PLAN

1:200 REFER 2 - CD 200

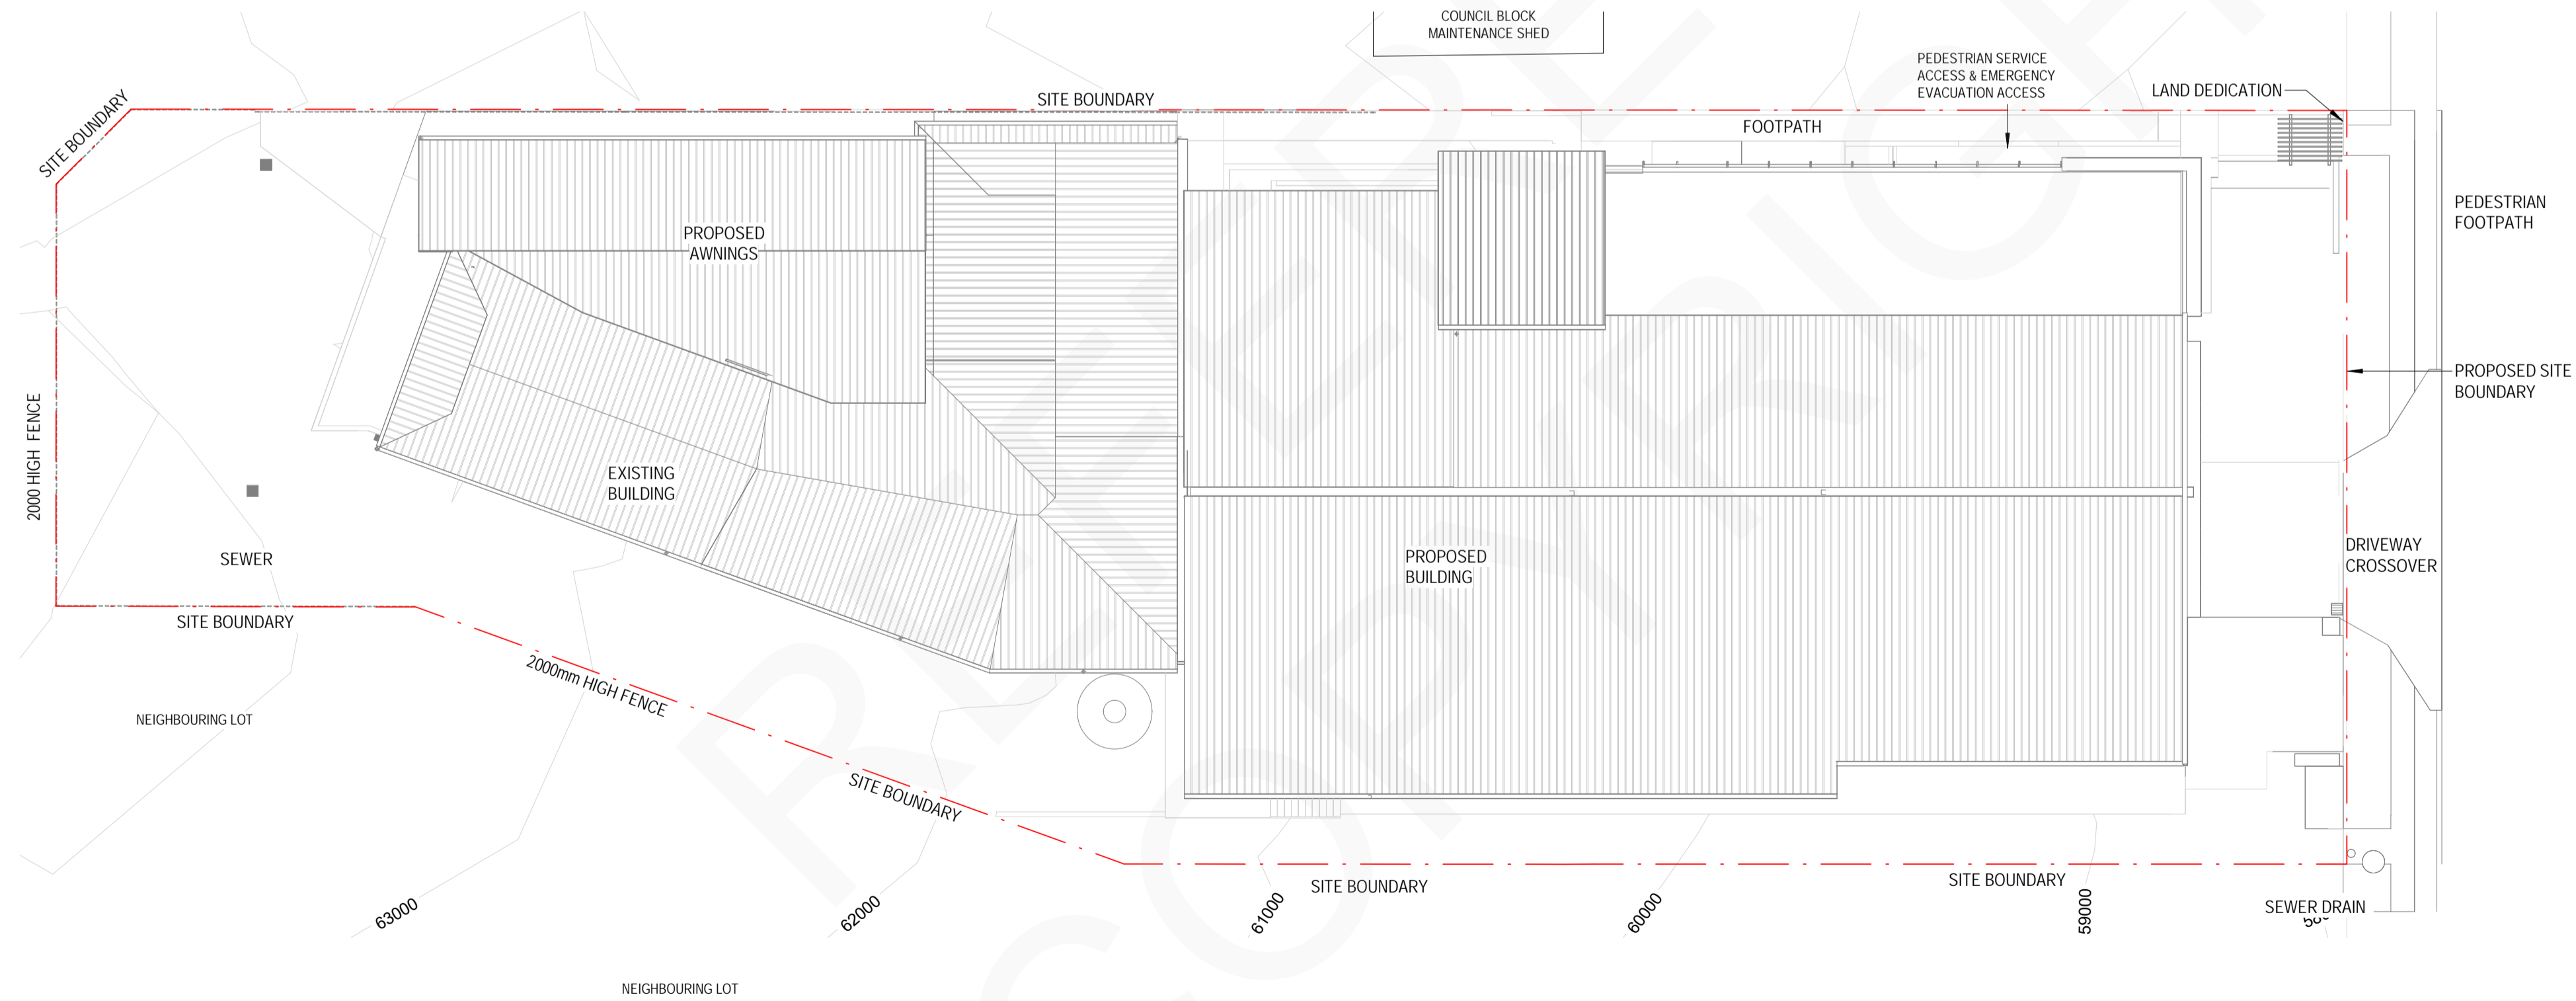


PROPOSED SITE PLAN

1:200 REFER 1 - CD 200

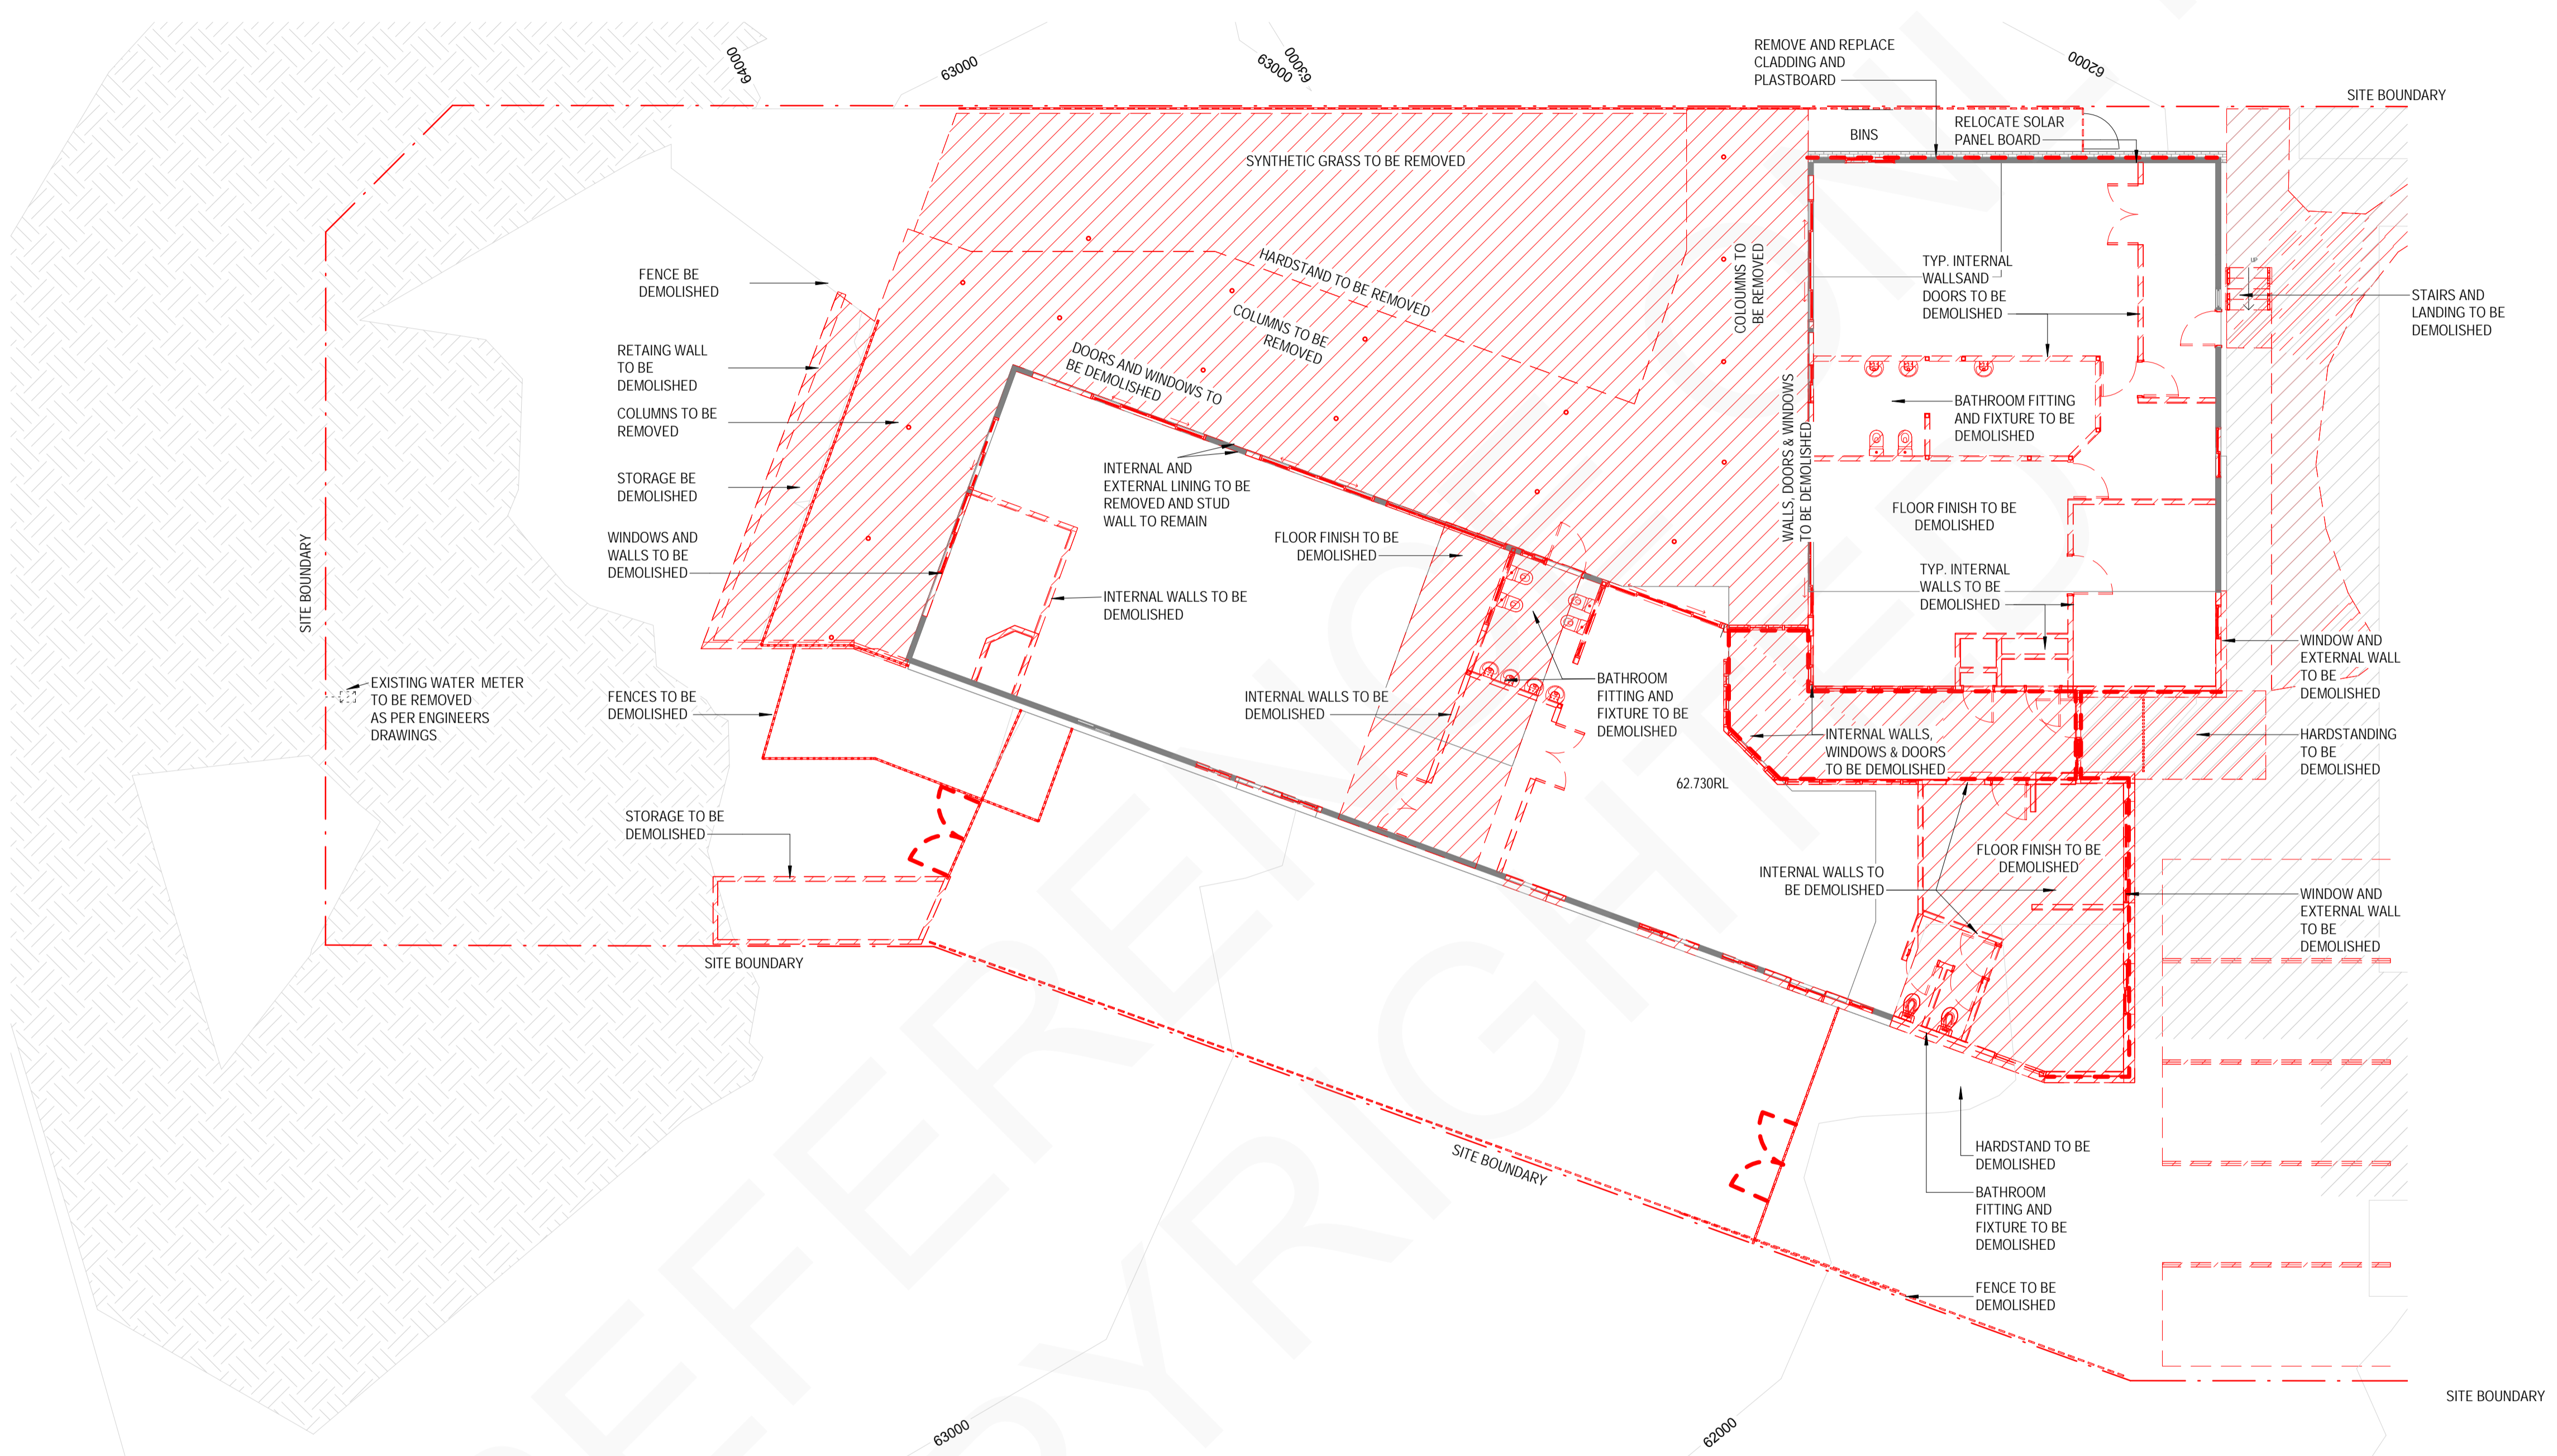


EXISTING & DEMO - GROUND FLOOR
PLAN-PART A

1:100 REFER 1 - CD.200

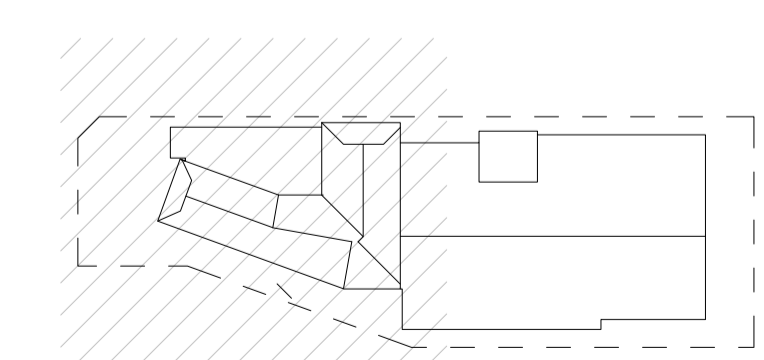


ROOF KEY PLAN - PART A

1:1000

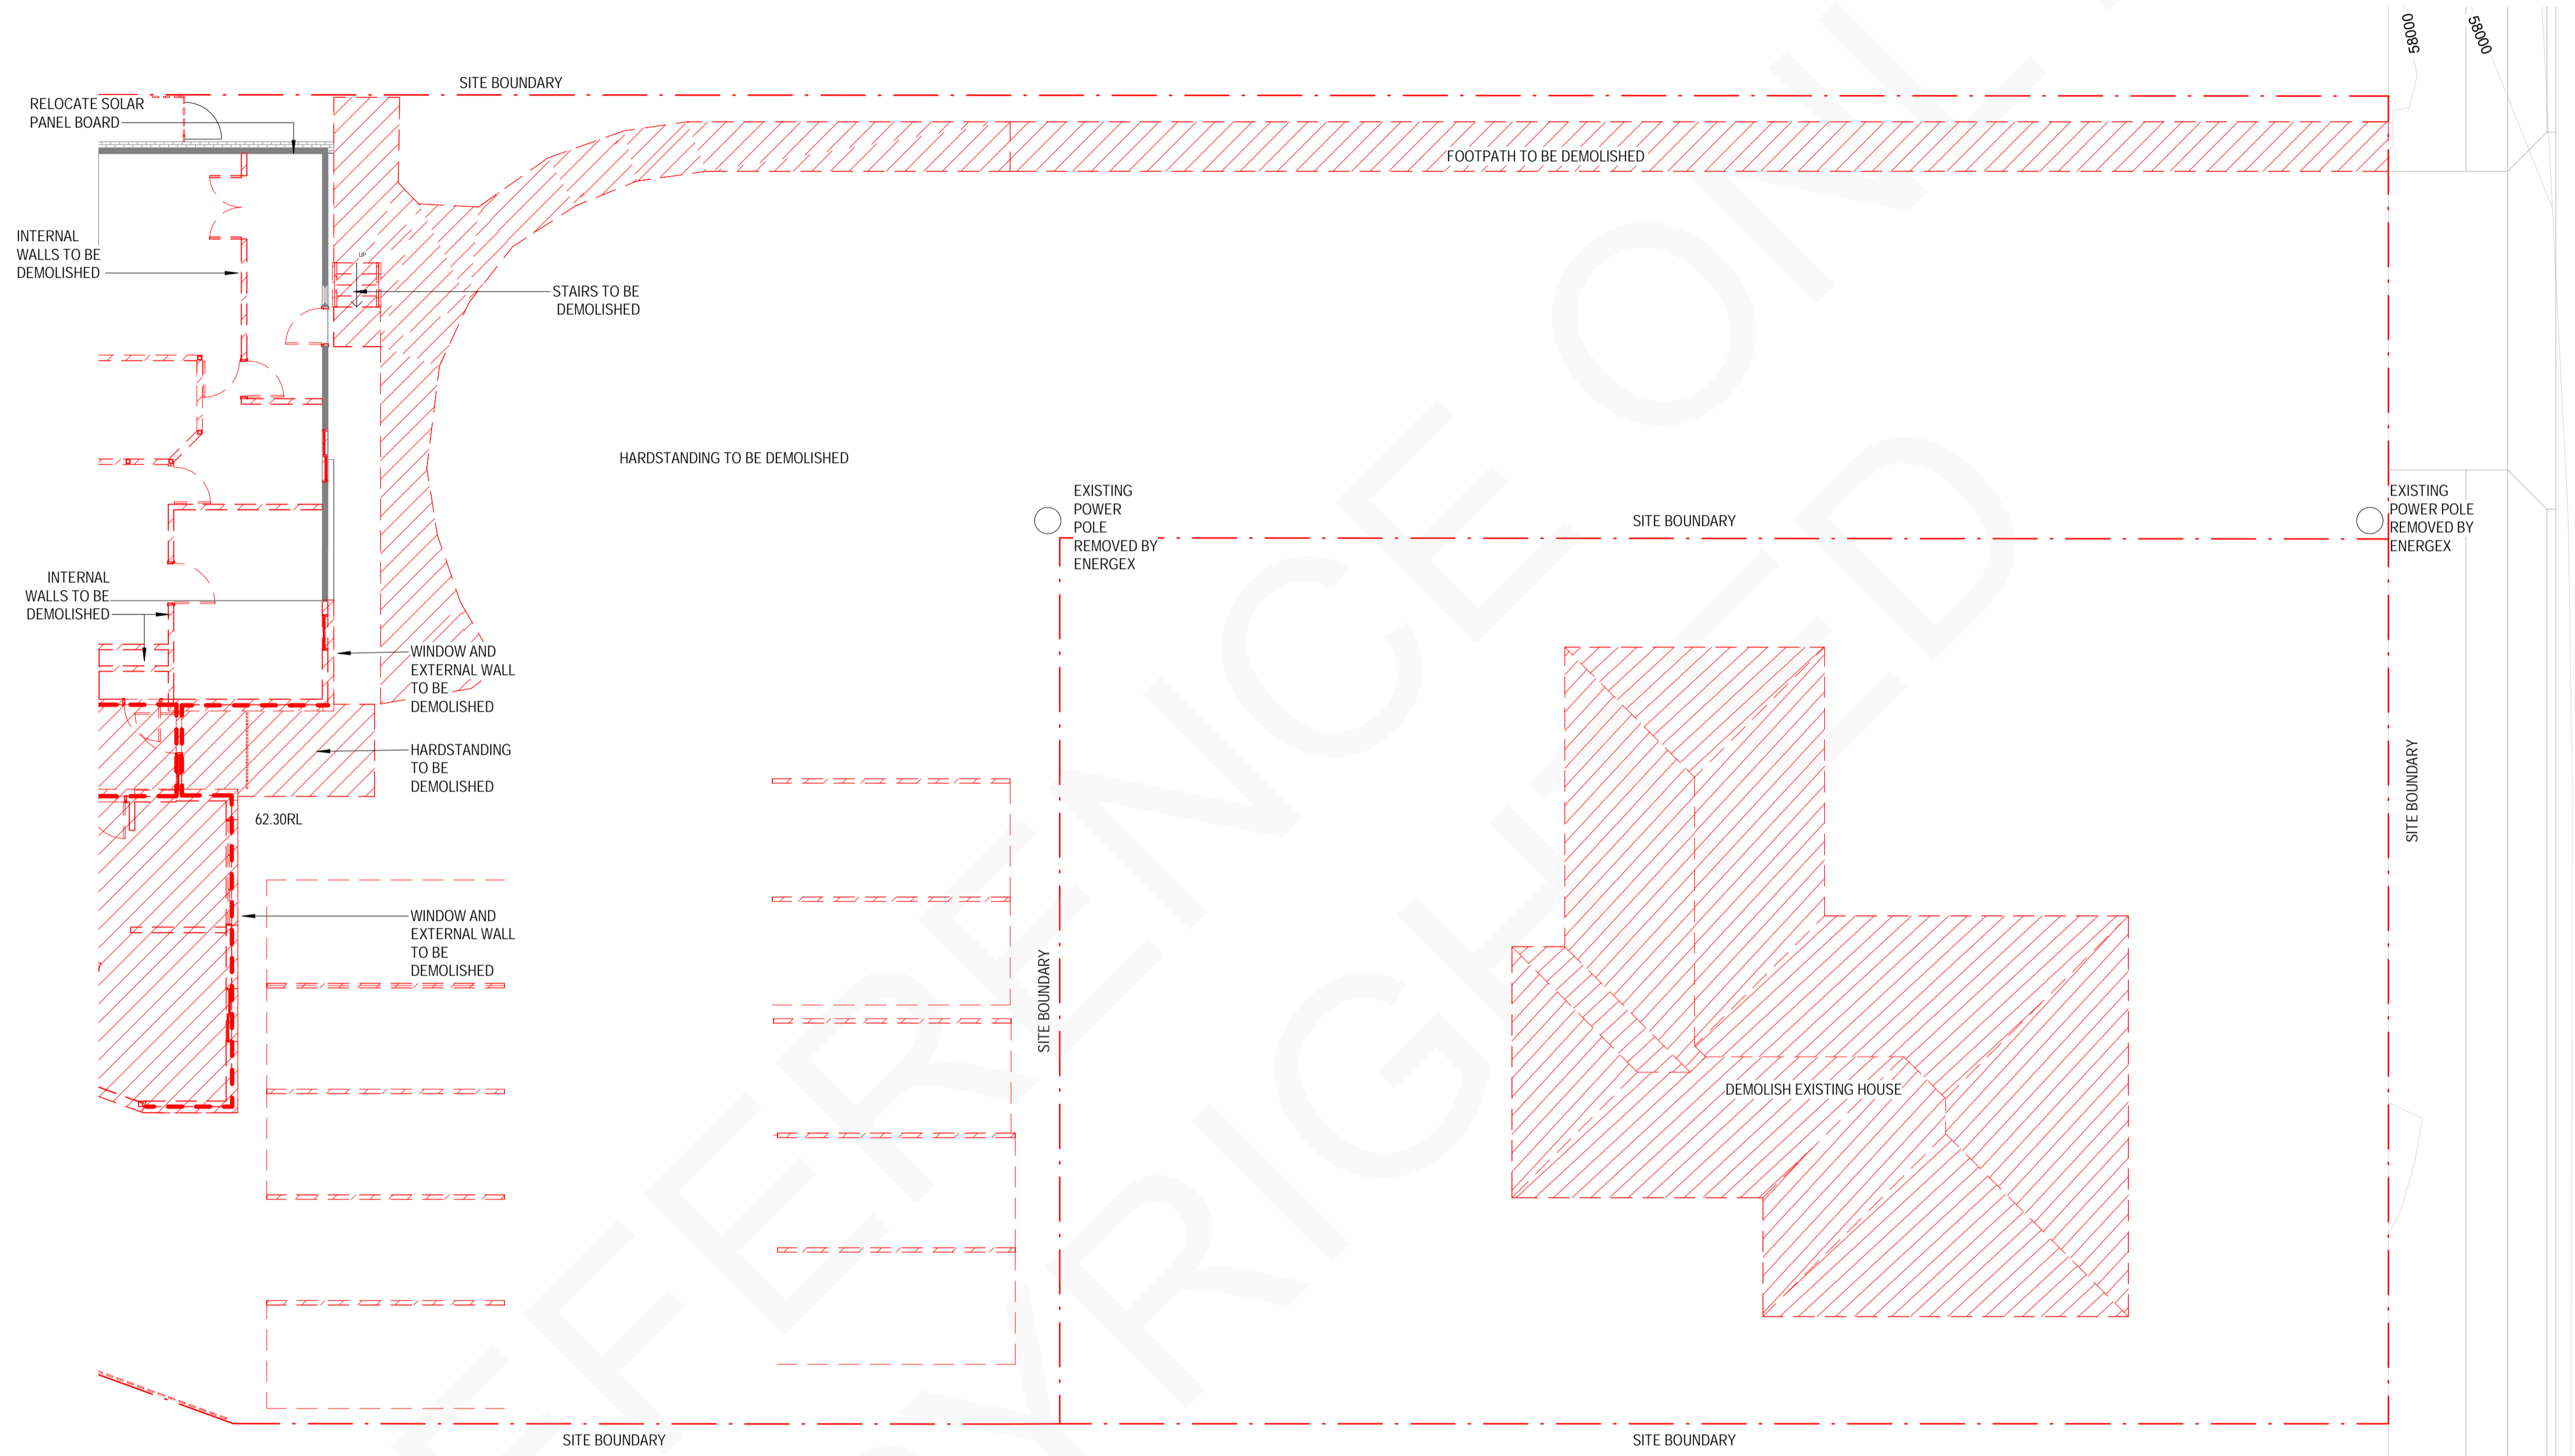


EXISTING & DEMO - GROUND FLOOR
PLAN-PART B

1:100 REFER 1 - CD.200

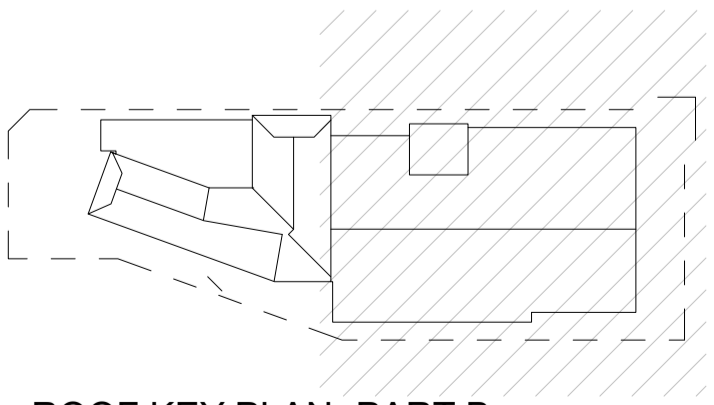

ROOF KEY PLAN- PART B

1:1000

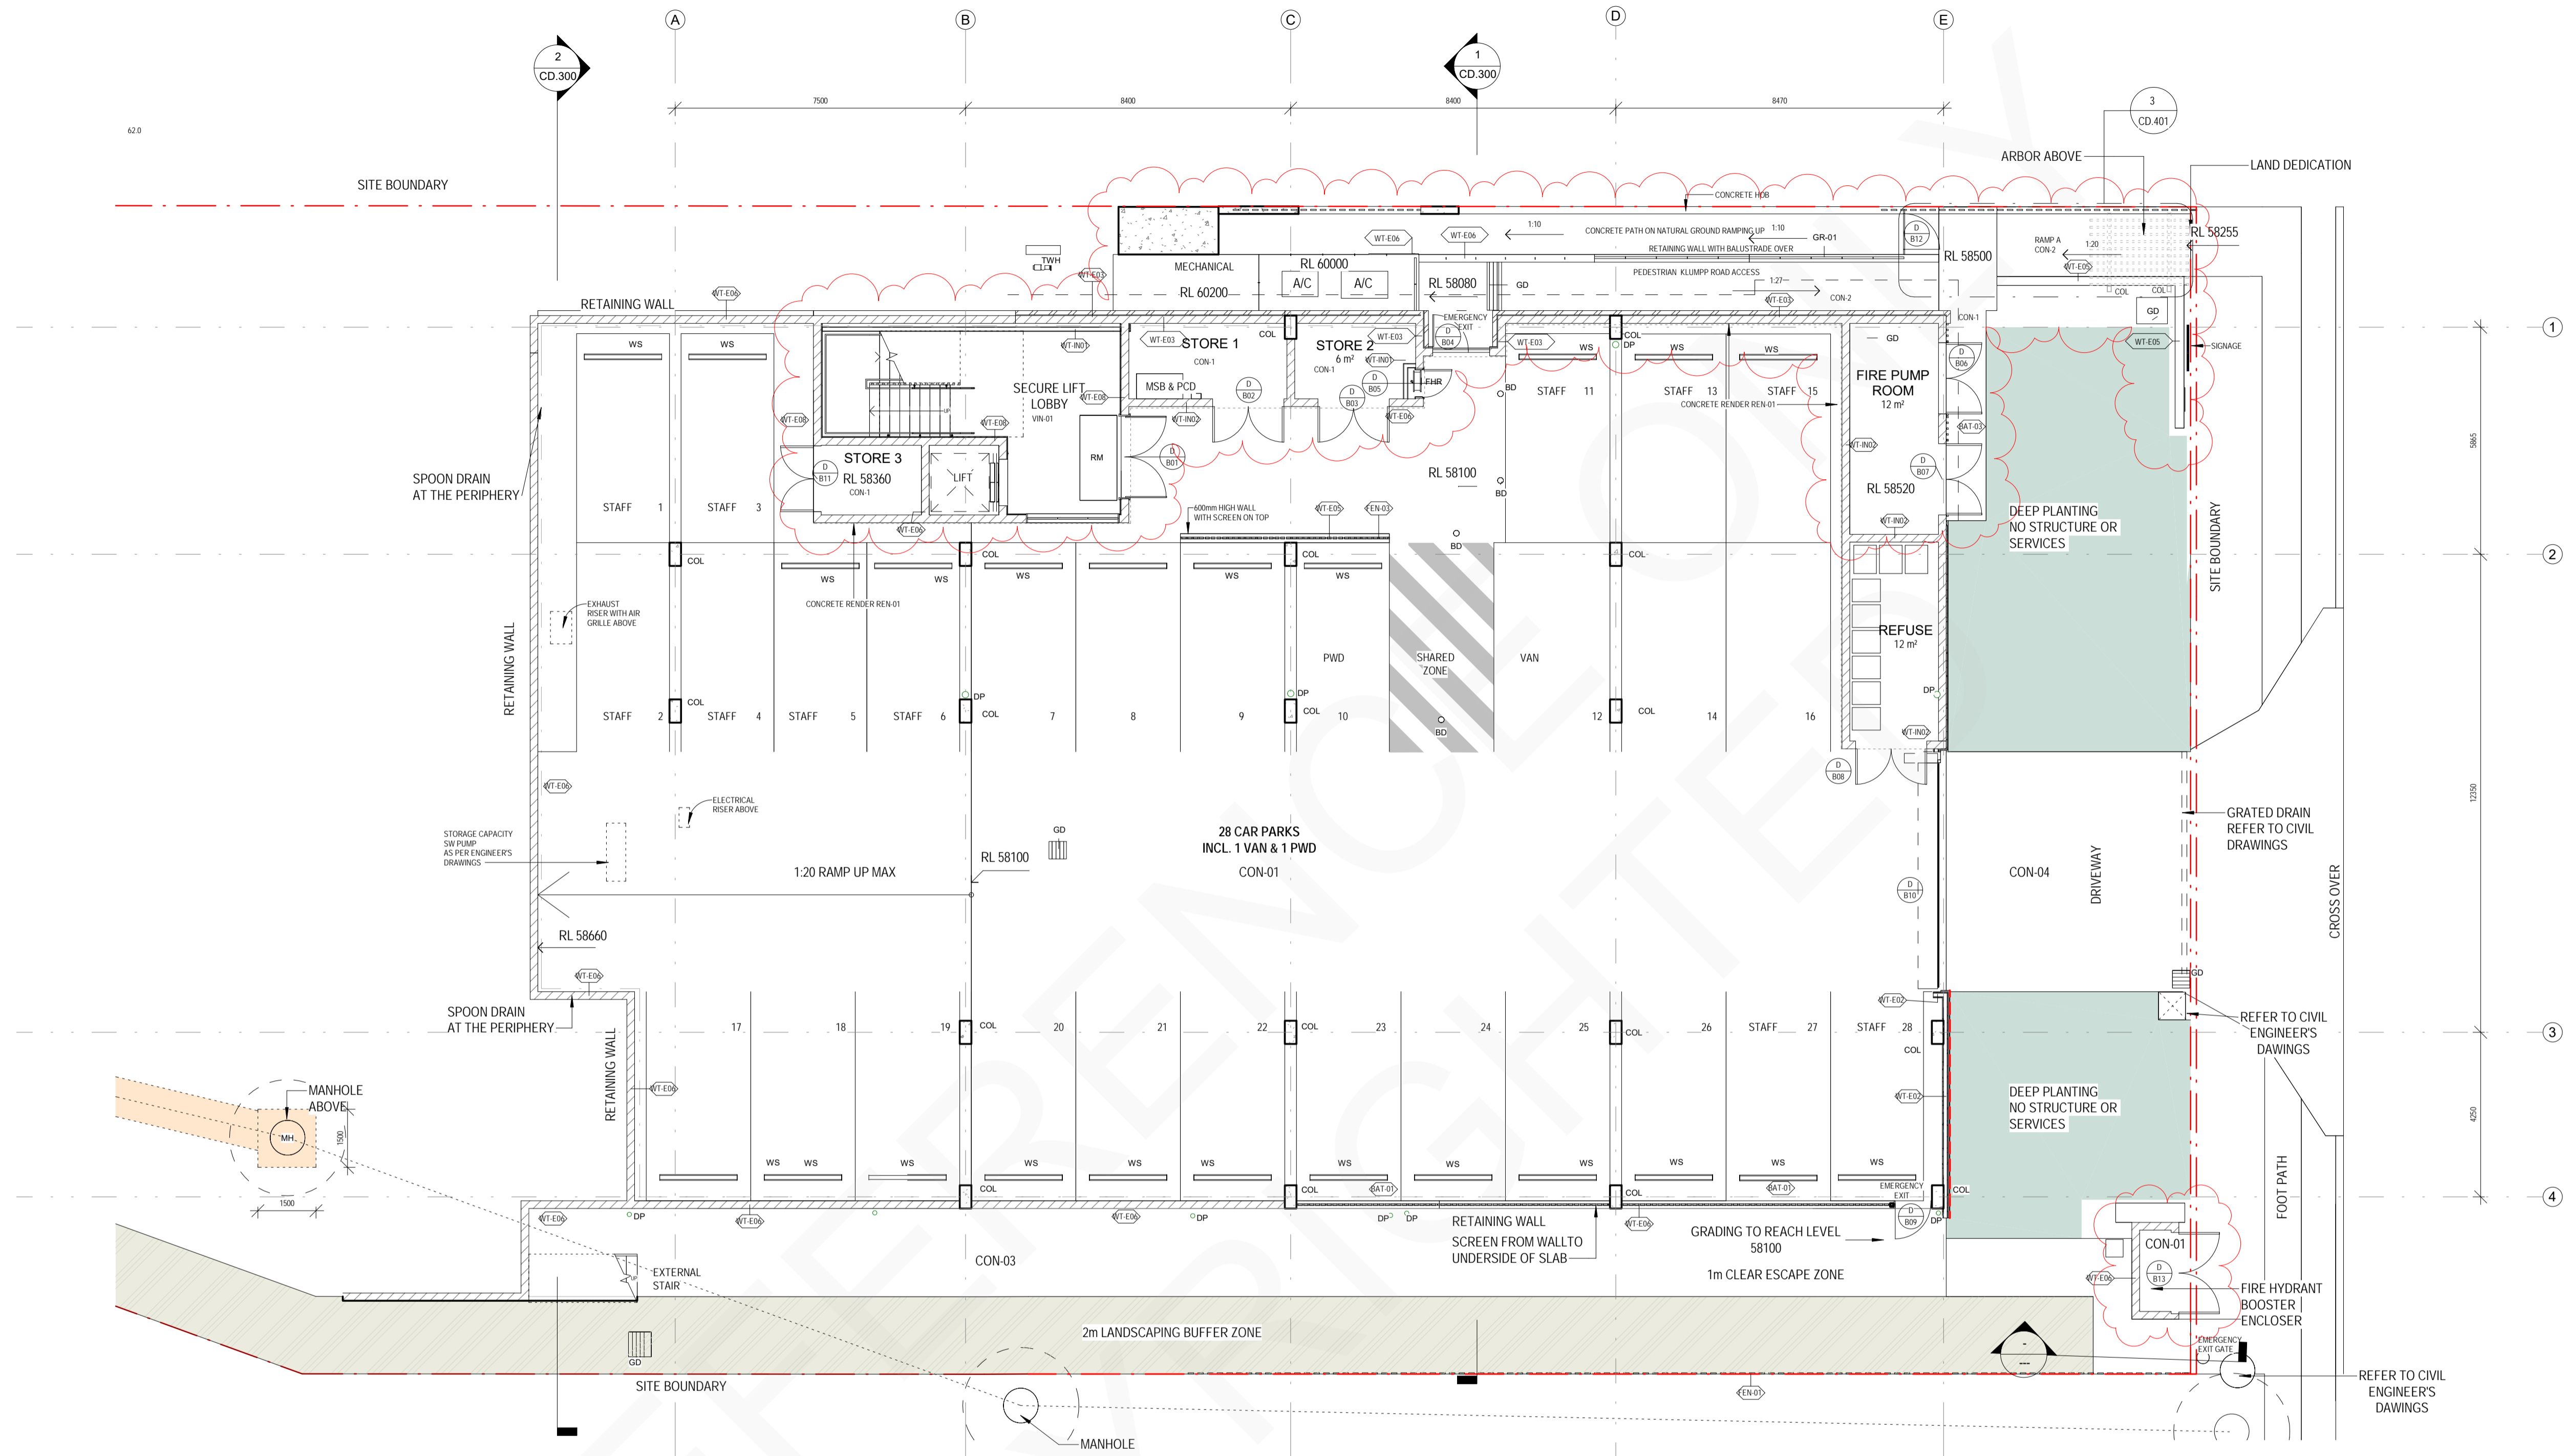


PROPOSED GA PLAN - CARPARK FLOOR PLAN


1:100 REFER 1 - CD.200

AG	AGRICULTURAL PIPE LINE
BAL-01	BALUSTRADE
BAL-02	BALUSTRADE
BAL-03	BALUSTRADE
BD	BOLLARD
BG	BOX GUTTER
BRK-01	BRICK FACADE
BV	BRICK VENEER
COL	COLUMN
DP	DOWN PIPE
EG	EAVES GUTTER
FEN-02	FENCING
FEN-02/1	FIRE HOSE REEL
FHR	CONCRETE FINISH
FLR CON-1	FLOOR WASTE GUTTER
FWG	GRADED DRAIN SEWAGE
GD	GULLY
GR-01	GUARDRAIL 1200MM HIGH
GR-02	GUARDRAIL 1500MM HIGH
GR-03	GUARDRAIL 1800MM HIGH
INL	INTAKE LOUVER
J	JOINERY
LIN-01	HORIZONTAL CLADDING
LO	LOCKER
MH	MANHOLE
OHF	OVERHEAD FLASHING
PLD	PLANTING DRAIN
PNT-01	PAINT EXTERIOR
PNT-03	PAINT EXTERIOR OVER CONCRETE
PNT-04	ROOF PAINT
RFS01	METAL ROOF STRUCTURE
RFS02	SOLARSPAN SANDWICH PANEL
RM	RECESSED ENTRY MAT
RP	REFRIGERANT PIPES
TGSI	TACTILE INDICATORS TO AS 1428
TR	TROUGH
TS	TIMBERLOOK ALUMINIUM BATTERY SCREEN
TWH	TWIN HYDRANT WALL LIGHT ABOVE 1500MM FROM STAIR THREAD FTL
WL	WHEEL STOP
WS	

PLANTING REGION LEGEND	
DEEP PLANTING	
SCREEN PLANTING	
MULCH	

FLOOR MATERIALS:	
VIN -	VINYL
CON-	CONCRETE
REFER TO SCHEDULES	

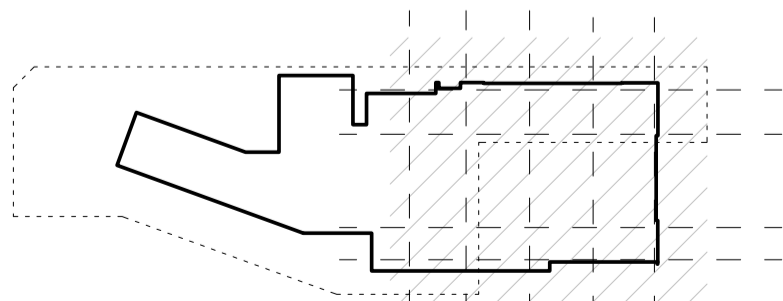

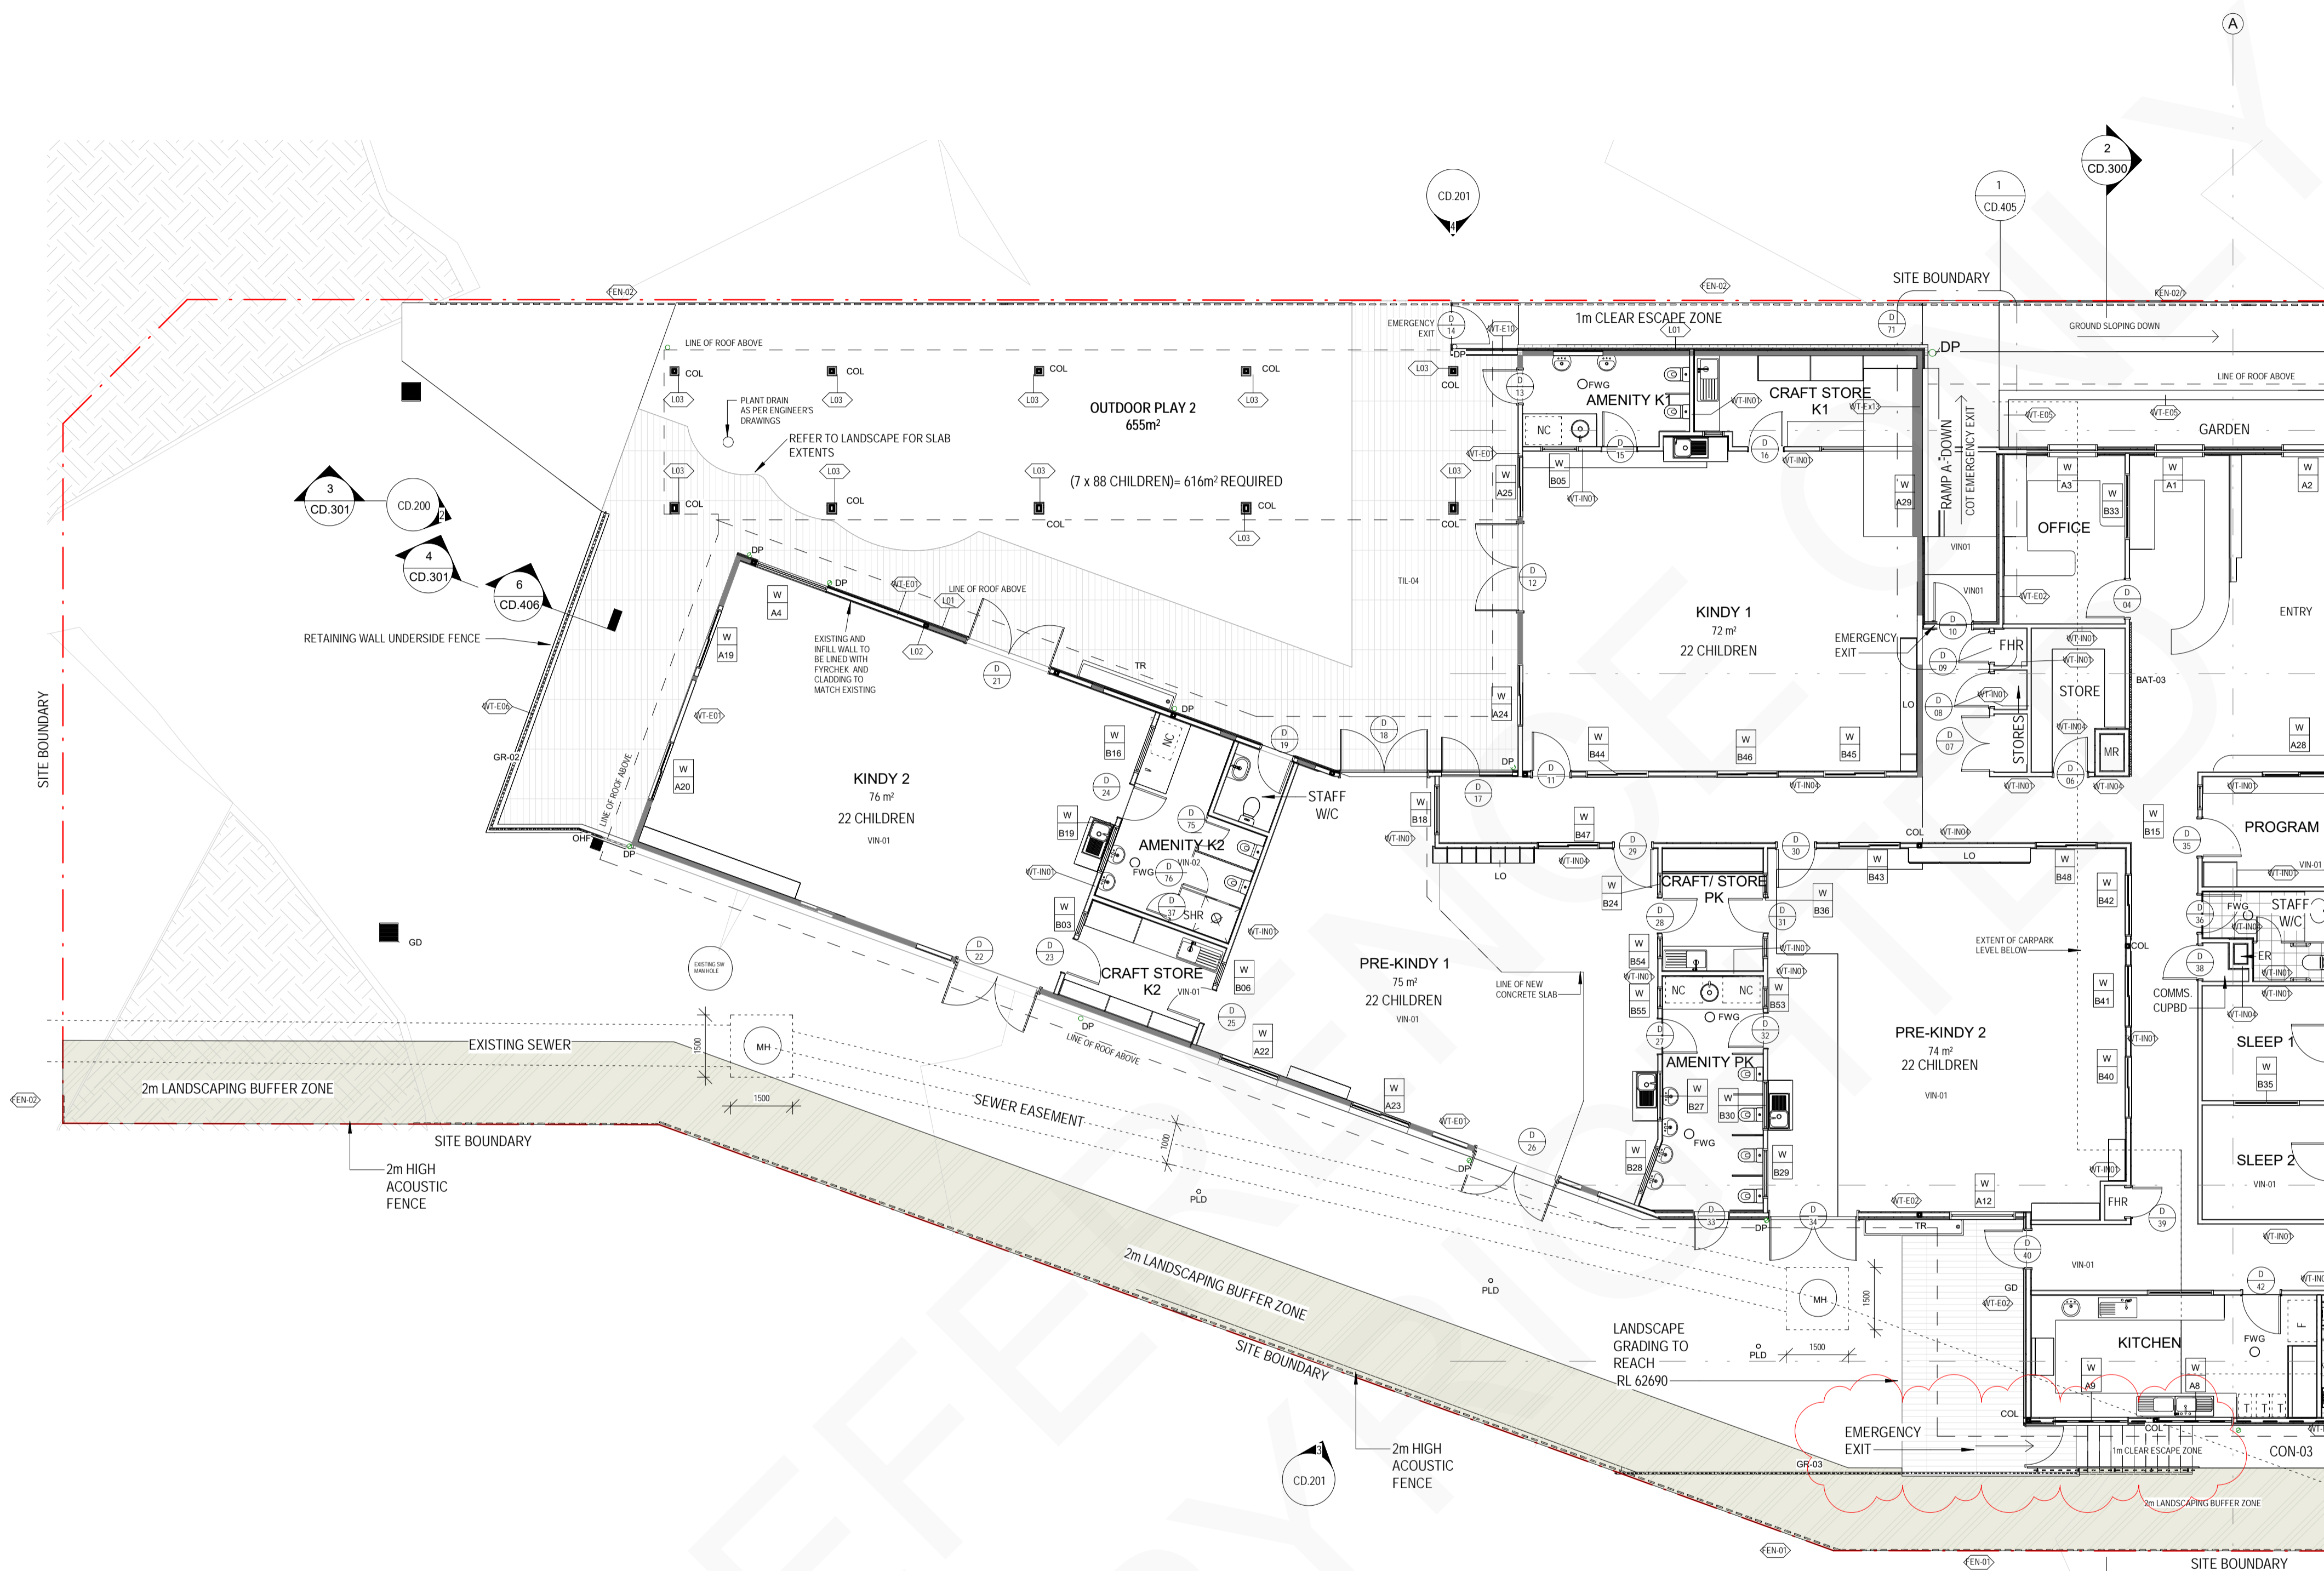


AG	AGRICULTURAL PIPE LINE
BAL-01	BALUSTRADE
BAL-02	BALUSTRADE
BAT-03	BAT-03
BD	BOLLARD
BG	BOX GUTTER
BRK-01	BRICK FACADE
BV	BRICK VENEER
COL	COLUMN
DP	DOWN PIPE
EG	EAVES GUTTER
FEN-02	FENCING
FEN-02/1	FIRE HOSE REEL
FHR	CONCRETE FINISH
FLR CON-1	FLOOR WASTE GUTTER
FWG	GRATED DRAIN SEWAGE GULLY
GD	GUARDRAIL 1200MM HIGH
GR-01	GUARDRAIL 1500MM HIGH
GR-02	GUARDRAIL 1800mm HIGH
GR-03	INTAKE LOUVER
INL	JOINERY
J	HORIZONTAL CLADDING
LIN-01	LOCKER
LO	MANHOLE
MH	OVERHEAD FLASHING
OHF	PLANTING DRAIN
PLD	PAINT EXTERIOR
PNT-01	PAINT EXTERIOR OVER CONCRETE
PNT-03	ROOF PAINT
PNT-04	METAL ROOF STRUCTURE
RF-01	SOLARSPAN SANDWICH PANEL
RF-02	REFRIGERANT PIPES
RM	TACTILE INDICATORS TO AS 1428
RP	TROUGH
TGSI	TIMBERLOOK ALUMINIUM BATTEN SCREEN
TR	TWIN HYDRANT
TS	WALL LIGHT ABOVE 1500MM FROM STAIR
TWH	THREAD FEL
WL	WHEEL STOP
WS	

PLANTING REGION LEGEND	
DEEP PLANTING	
SCREEN PLANTING	
MULCH	


FLOOR MATERIALS LEGEND	
VIN	VINYL
CON	CONCRETE
TIL	TILE

REFER TO SCHEDULES

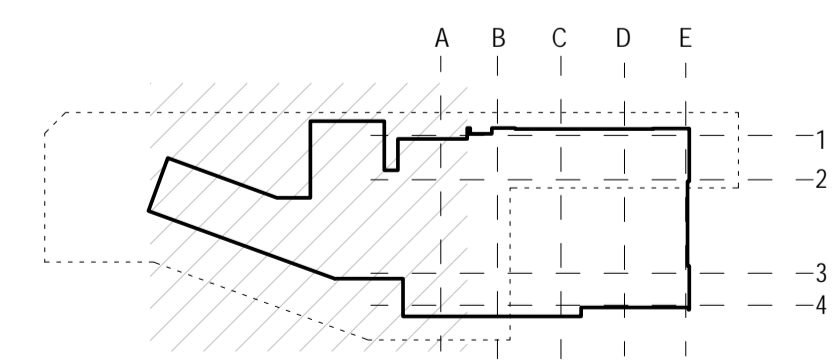


KEYPLAN PART A

1:1000

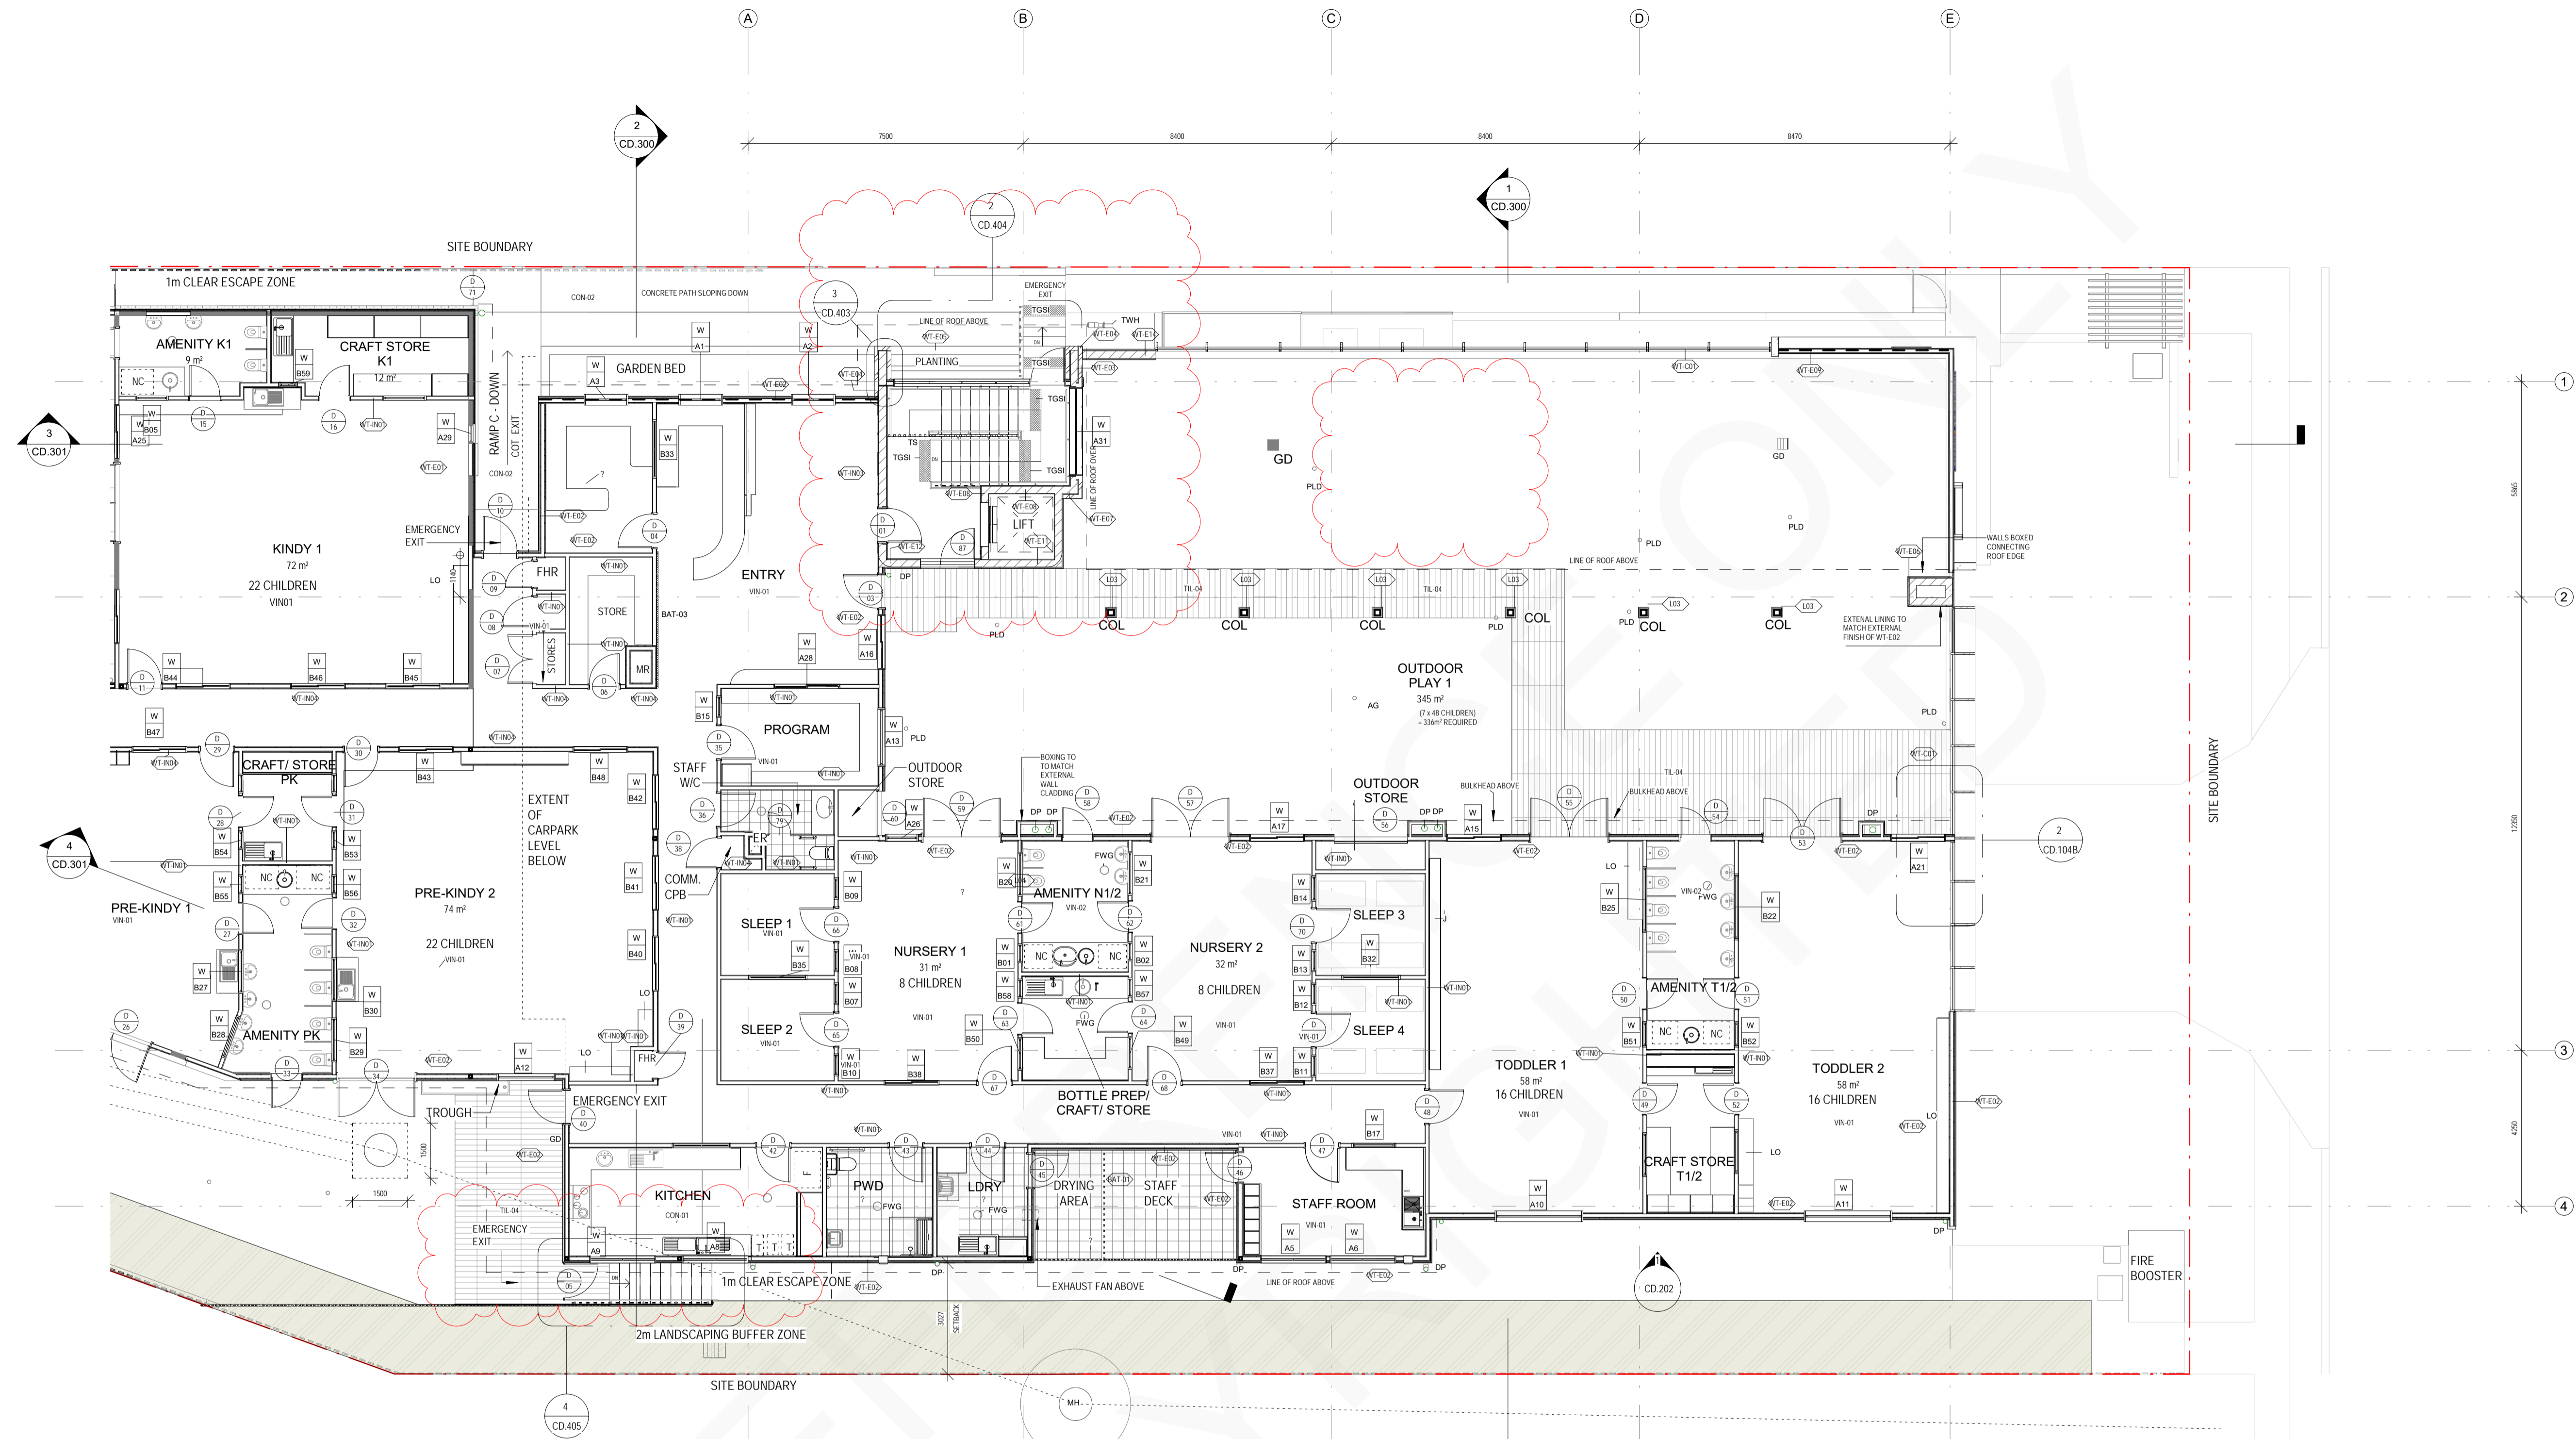


PROPOSED GA PLAN - GROUND FLOOR PLAN- PART B

1:100

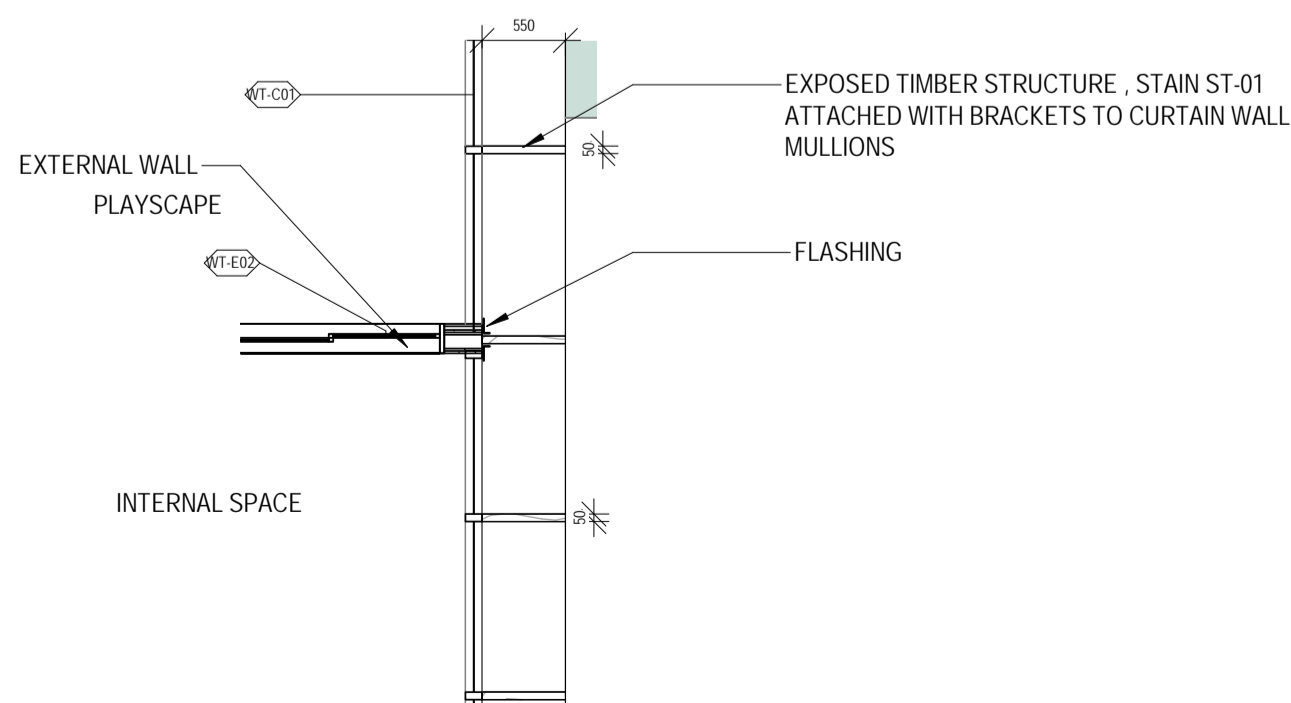

CURTAIN WALL DETAIL

REFER 2 - CD.104B

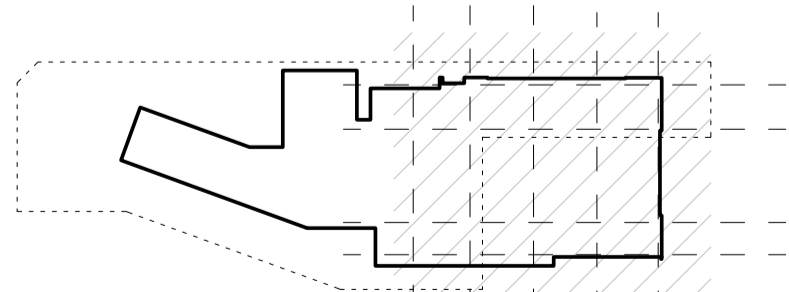


KEYPLAN PART B

1:1000

AG	AGRICULTURAL PIPE LINE
BAL-01	BALUSTRADE
BAL-02	BALUSTRADE
BAT-03	BALUSTRADE
BD	BOLLARD
BG	BOX GUTTER
BRK-01	BRICK FACADE
BV	BRICK VENEER
COL	COLUMN
DP	DOWN PIPE
EG	EAVES GUTTER
FEN-02	FENCING
FEN-021	FENCING
FHR	FIRE HOSE REEL
FLR CON-1	FLOOR FINISH
FWG	FLOOR WASTE GUTTER
GD	GRADED DRAIN SEWAGE
GR-01	GULLY
GR-02	GUARDRAIL 1200MM HIGH
GR-03	GUARDRAIL 1500MM HIGH
INL	GUARDRAIL 1800mm HIGH
J	INTAKE LOUVER
JO	JOINERY
LIN-01	HORIZONTAL CLADDING
LO	LOCKER
MH	MANHOLE
OHF	OVERHEAD FLASHING
PLD	PLANTING DRAIN
PNT-01	PAINT EXTERIOR
PNT-03	PAINT EXTERIOR OVER CONCRETE
PNT-04	ROOF PAINT
RF-01	METAL ROOF STRUCTURE
RF-02	SOLARSPAN SANDWICH PANEL
RF-02	RECESSED ENTRY MAT
RM	REFRIGERANT PIPES
RP	TACTILE INDICATORS TO AS 1428
TGSI	TROUGH
TR	TIMBERLOOK ALUMINIUM
TS	BATTEN SCREEN
TWH	TWIN HYDRANT
WL	WALL LIGHT ABOVE 1500MM FROM STAIR
WS	WHEEL STOP


PLANTING REGION LEGEND	
DEEP PLANTING	
SCREEN PLANTING	
MULCH	

FLOOR MATERIALS LEGEND	
VIN	VINYL
CON	CONCRETE
TIL	TILE
REFER TO SCHEDULES	

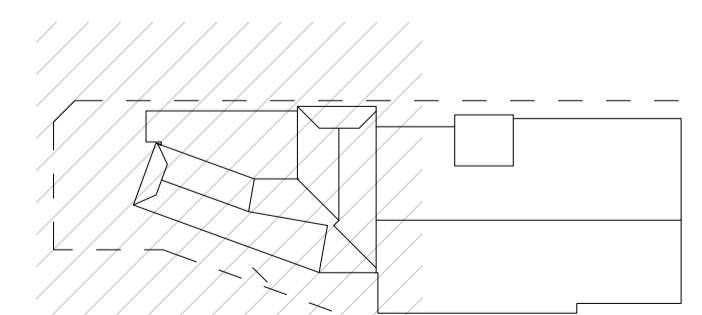

AG	AGRICULTURAL PIPE LINE
BAL	BALUSTRADE
BAL-02	BALUSTRADE
BAT-03	
BD	BOLLARD
BG	BOX GUTTER
BKR-01	BRICK FACADE
BV	BRICK VENEER
COL	COLUMN
CP	DOWN PIPE
EG	EAVES GUTTER
FEN-02	FENCING
FEN/021	
FHR	FIRE HOSE REEL
FLR CON-1	CONCRETE FINISH
FWG	FLUR WASTE GUTTER
GD	GRADED DRAIN SEWAGE GULLY
GR-01	GUARDRAIL 1200MM HIGH
GR-02	GUARDRAIL 1500MM HIGH
GR-03	GUARDRAIL 1800mm HIGH
INTL	INTERNAL LOUVRE
J	JOINERY
LIN-01	HORIZONTAL CLADDING
LO	LOCKER
MH	MANHOLE
OHF	OVERHEAD FLASHING
PLD	PLANTING DRAIN
PNT-01	PAINT EXTERIOR
PNT-03	PAINT EXTERIOR OVER CONCRETE
PNT-04	ROOF PAINT
RF501	ROOF METAL STRUCTURE
RF502	SOLARSPAN SANDWICH PANEL
RM	RECESSED ENTRY MAT
RP	REFRIGERANT PIPES
TGSI	TACTILE INDICATORS TO AS 1428
TR	TROUGH
TS	TIMBERLOOK ALUMINIUM BATTEN SCREEN
TWH	TWIN HYDRANT
WL	WALL LIGHT ABOVE 1500MM FROM STAIR THRESHOLD
WS	WHEEL STOP

ROOF KEY PLAN - PART A

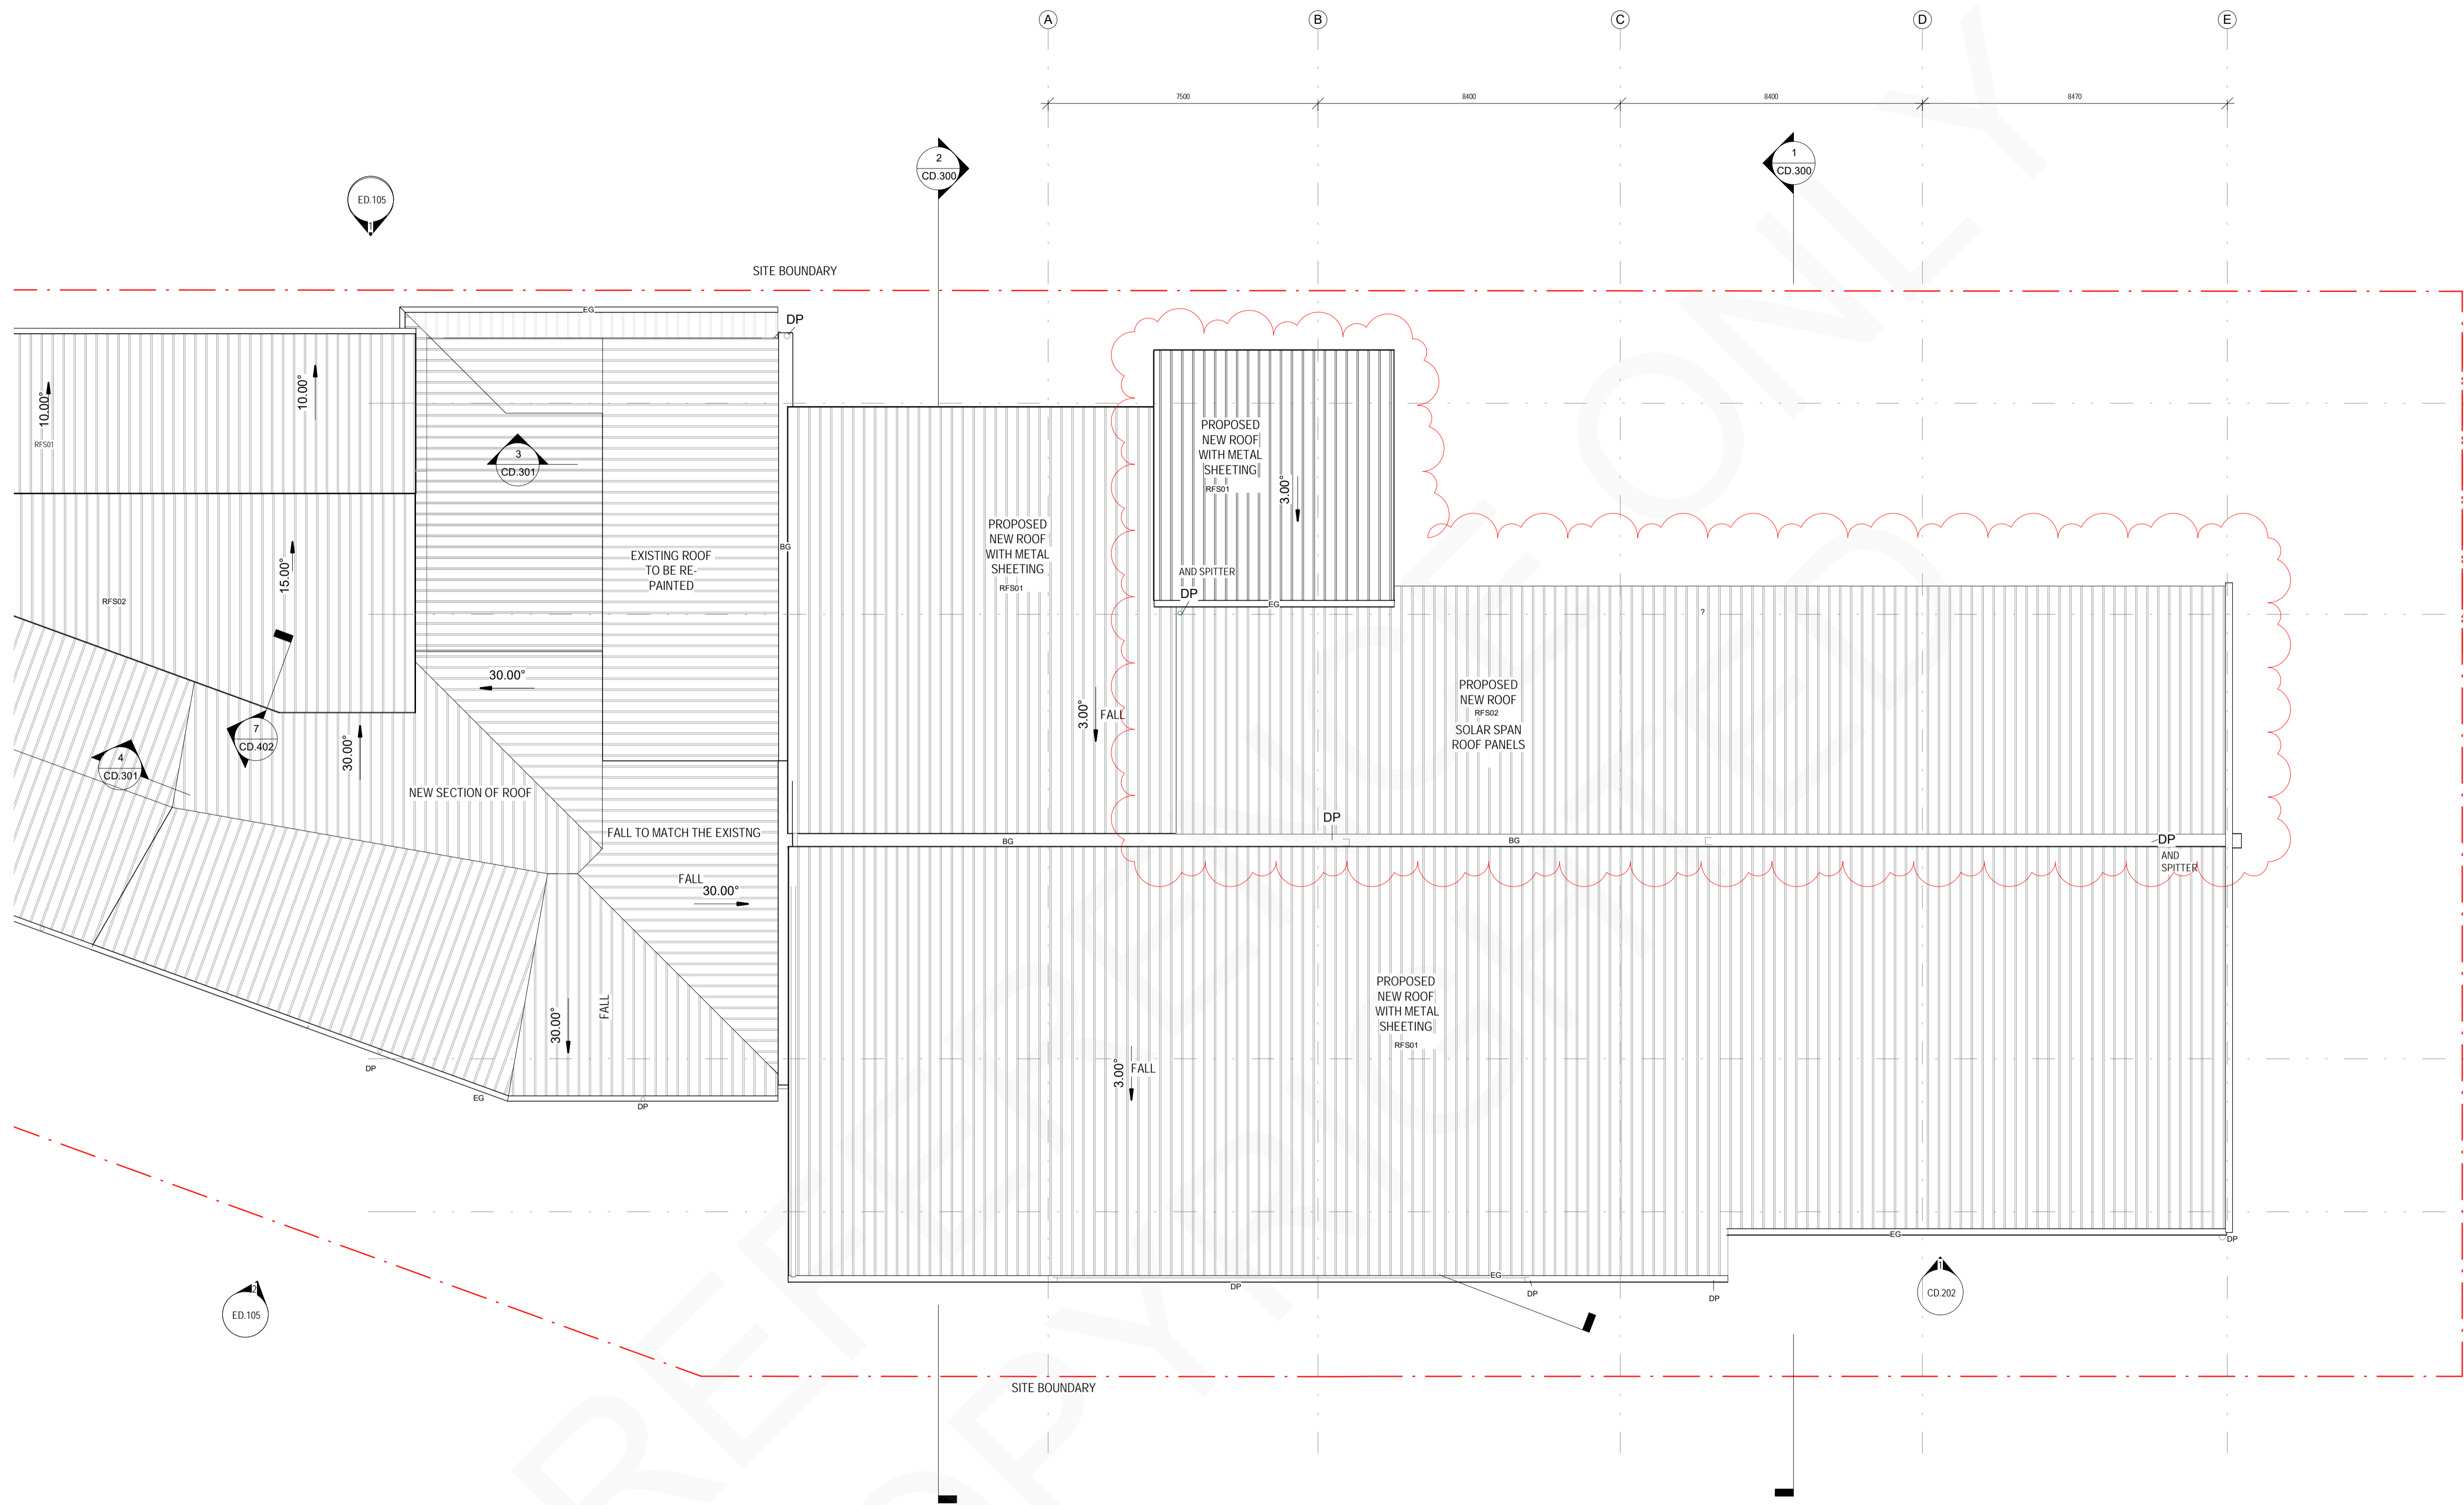


- | | |
|-----------|------------------------------------|
| AG | AGRICULTURAL PIPE LINE |
| BAL-01 | BALUSTRADE |
| BAL-02 | BALUSTRADE |
| BAT-03 | |
| BD | BOLLARD |
| BG | BOX GUTTER |
| BRK-01 | BRICK FACADE |
| BV | BRICK VENEER |
| COL | COLUMN |
| DP | DOWN PIPE |
| EG | EAVES GUTTER |
| FEN-02 | FENCING |
| FEN-02/1 | |
| FHR | FIRE HOSE REEL |
| FLR CON-1 | CONCRETE FINISH |
| FWG | FLOOR WASTE GUTTER |
| GD | GRADED DRAIN SEWAGE |
| GR-01 | GULLY |
| GR-02 | GUARDRAIL 1200MM HIGH |
| GR-03 | GUARDRAIL 1500MM HIGH |
| INL | GUARDRAIL 1800mm HIGH |
| J | INTAKE LOUVER |
| LIN-01 | JOINERY |
| LO | HORIZONTAL CLADDING |
| MANH | LOCKER |
| OHF | MANHOLE |
| PLD | OVERHEAD FLASHING |
| PNT-01 | PLANTING DRAIN |
| PNT-03 | PAINTE EXTERIOR |
| PNT-04 | PAINTE EXTERIOR OVER CONCRETE |
| RF-01 | ROOF PAINT |
| RF-02 | METAL ROOF STRUCTURE |
| RF-03 | SOLARSPAN SANDWICH PANEL |
| RF-04 | RECESSED ENTRY MAT |
| RF-05 | REFRIGERANT PIPES |
| RF-06 | TACTICLE INDICATORS TO AS 1428 |
| RF-07 | TROUGH |
| RF-08 | TIMBERLOOK ALUMINIUM |
| RF-09 | BATTEN SCREEN |
| RF-10 | TWIN HYDRANT |
| RF-11 | WALL LIGHT ABOVE 1500MM FROM STAIR |
| RF-12 | THREAD FFL |
| RF-13 | WHEEL STOP |

- 1 1985
- 2 12350
- 3 4250
- 4

REFER TO SCHEDULES


PROPOSED GA PLAN - ROOF LEVEL - PART B

REFER 1 - CD.200

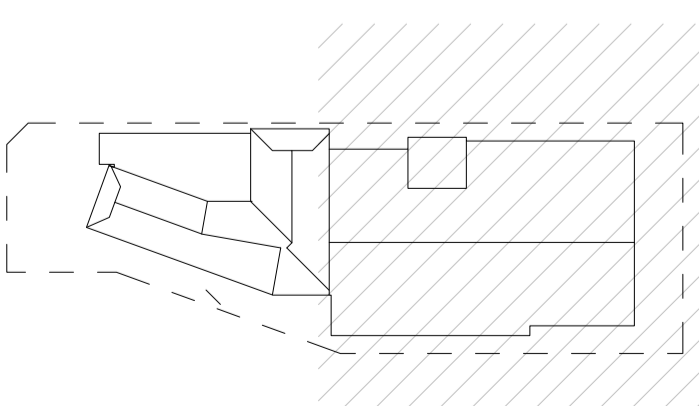

ROOF KEY PLAN- PART B


1:1000

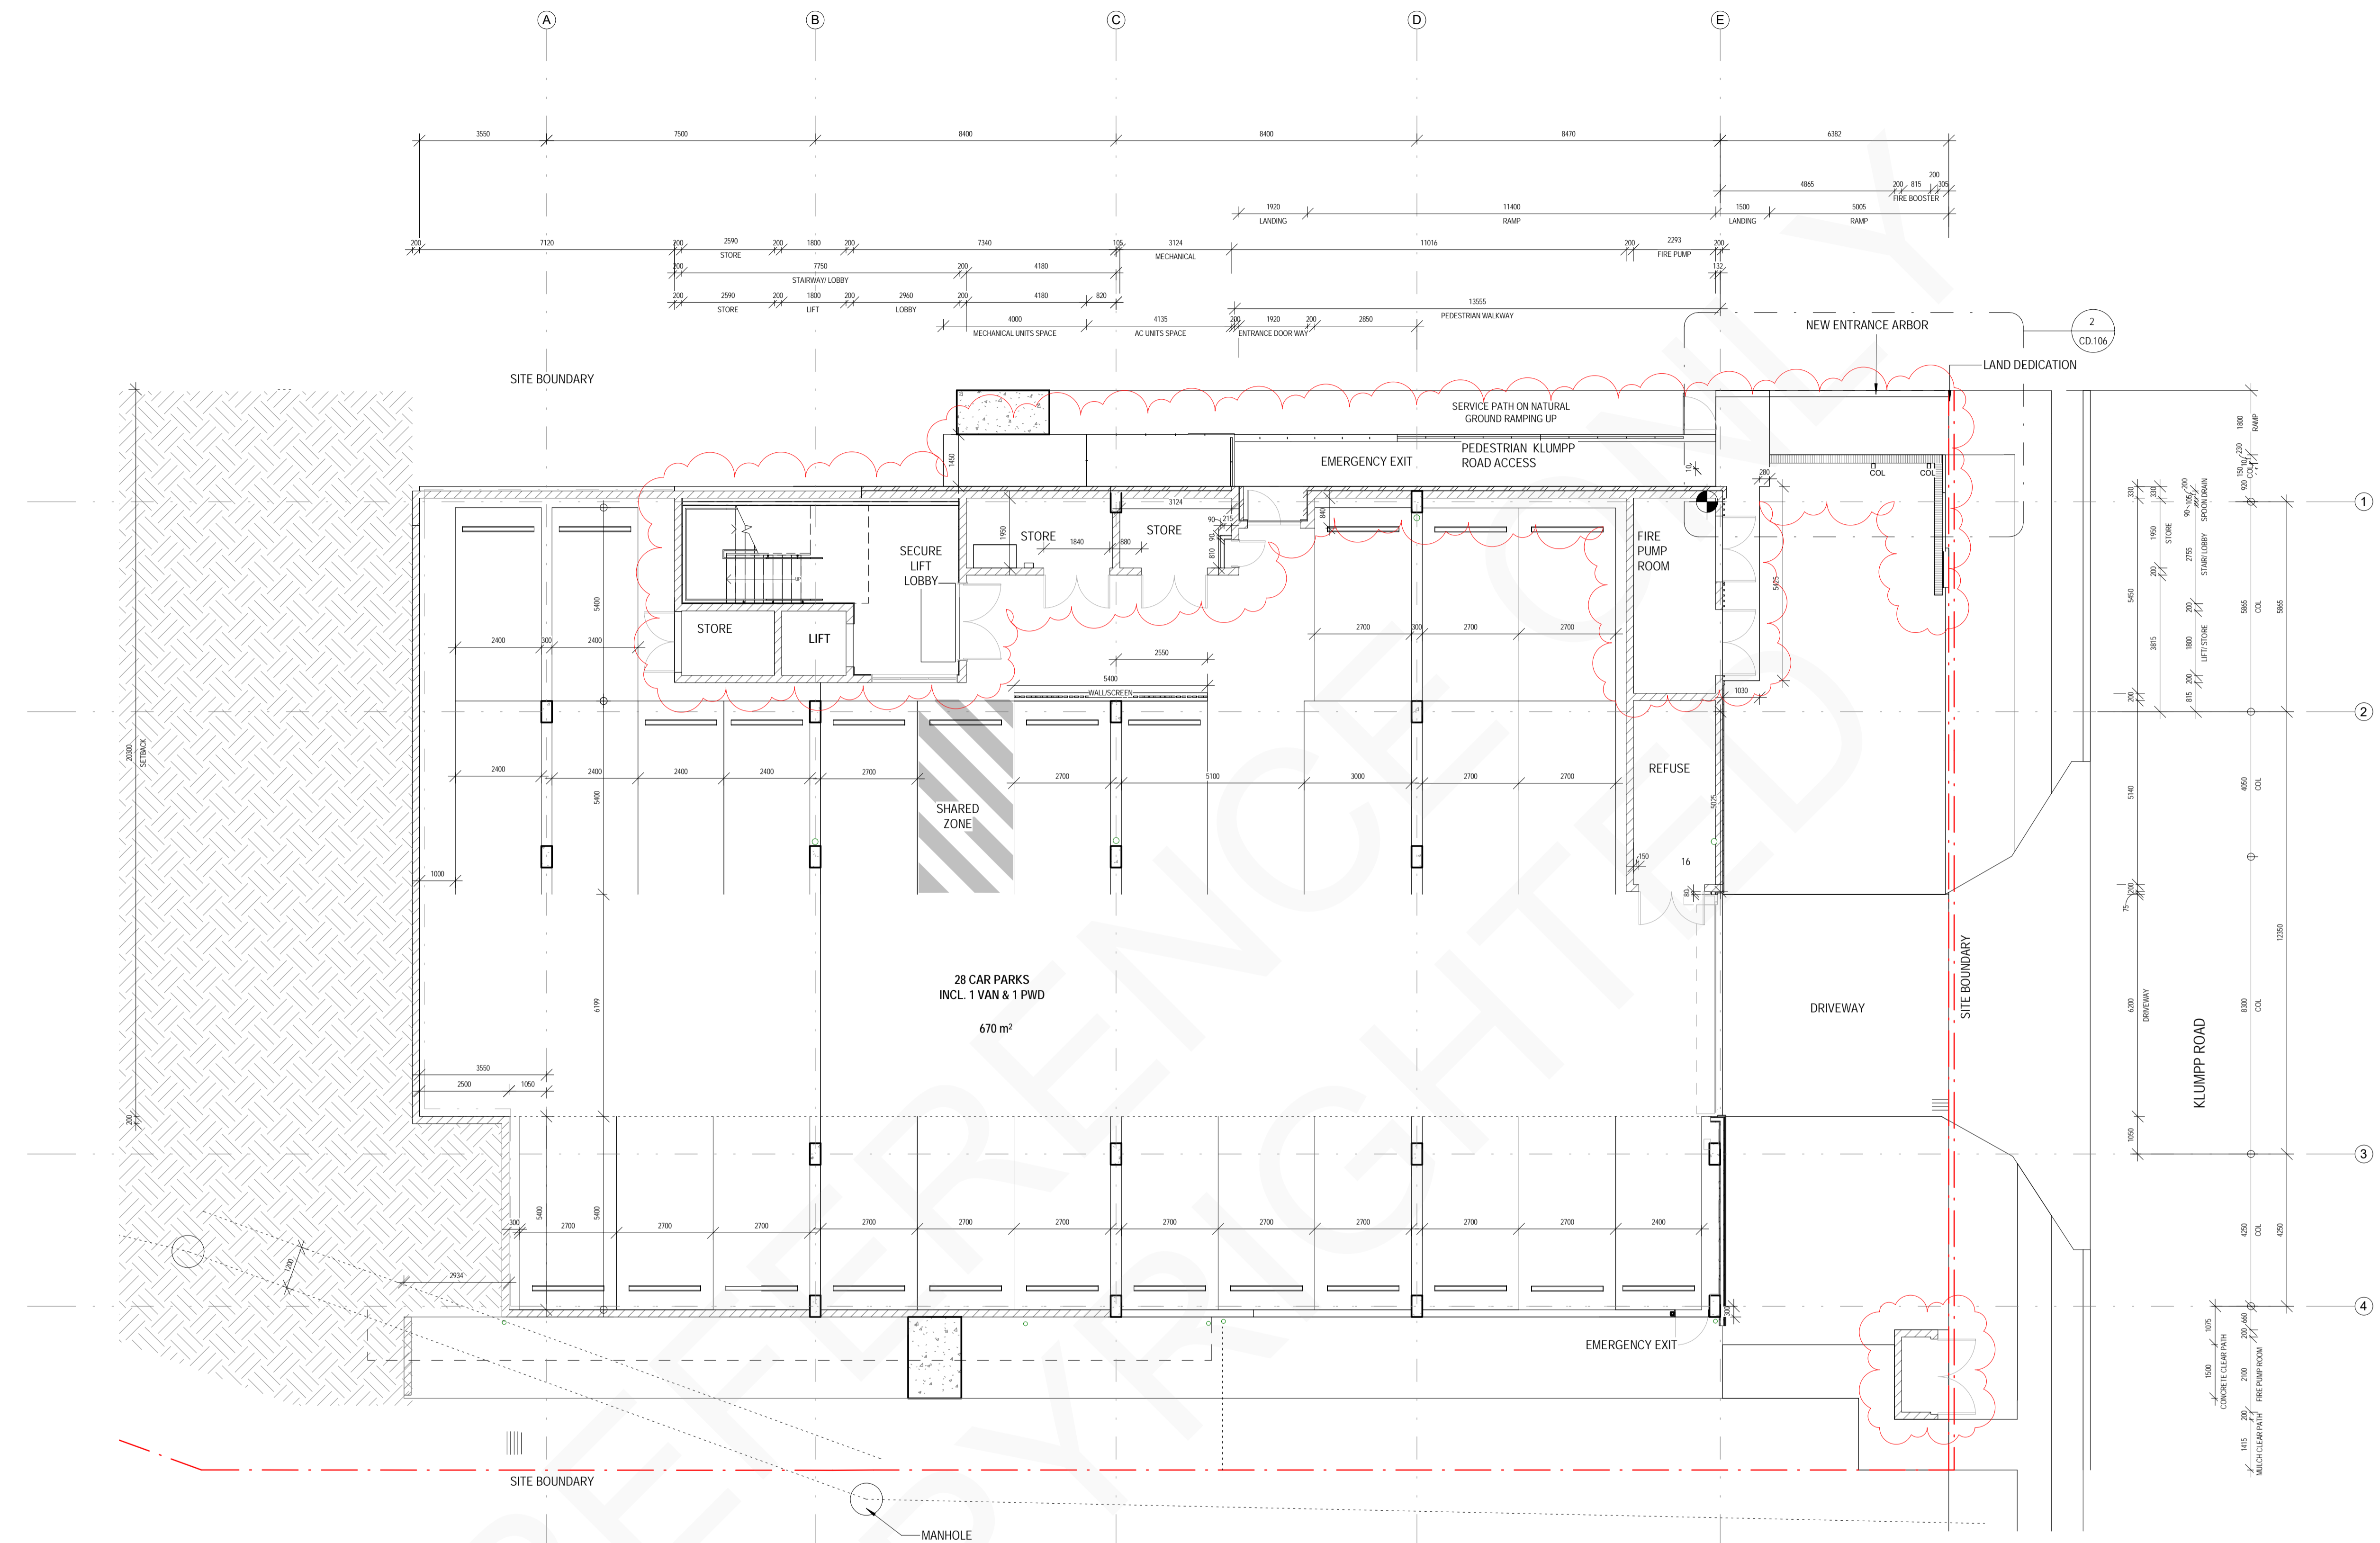


AG	AGRICULTURAL PIPE LINE
BAL-01	BALUSTRADE
BAL-02	BALUSTRADE
BAT-03	BALUSTRADE
BD	BOLLARD
BG	BOX GUTTER
BRK-01	BRICK FACADE
BV	BRICK VENEER
COL	COLUMN
DP	DOWN PIPE
EG	EAVES GUTTER
FEN-02	FENCING
FEN-021	FENCING
FHR	FIRE HOSE REEL
FLR CON-1	CONCRETE FINISH
FWG	FLOOR WASTE GUTTER
GD	GRADED DRAIN SEWAGE
GR-01	GULLY
GR-02	GUARDRAIL 1200MM HIGH
GR-03	GUARDRAIL 1500MM HIGH
INL	GUARDRAIL 1800mm HIGH
J	INTAKE LOUVER
JO	JOINERY
LIN-01	HORIZONTAL CLADDING
LO	LOCKER
MH	MANHOLE
OHF	OVERHEAD FLASHING
PLD	PLANTING DRAIN
PNT-01	PAINT EXTERIOR
PNT-03	PAINT EXTERIOR OVER CONCRETE
PNT-04	ROOF PAINT
RF-01	METAL ROOF STRUCTURE
RF-02	SOLARSPAN SANDWICH PANEL
RM	RECESSED ENTRY MAT
RP	REFRIGERANT PIPES
TGSI	TACTILE INDICATORS TO AS 1428
TR	TROUGH
TS	TIMBERLOOK ALUMINIUM BATTEN SCREEN
TWH	TWIN HYDRANT
VL	WALL LIGHT ABOVE 1500MM FROM STAIR
WS	WHEEL STOP

REFER TO SCHEDULES

PROPOSED SETOUT - CARPARK FLOOR PLAN
1:100

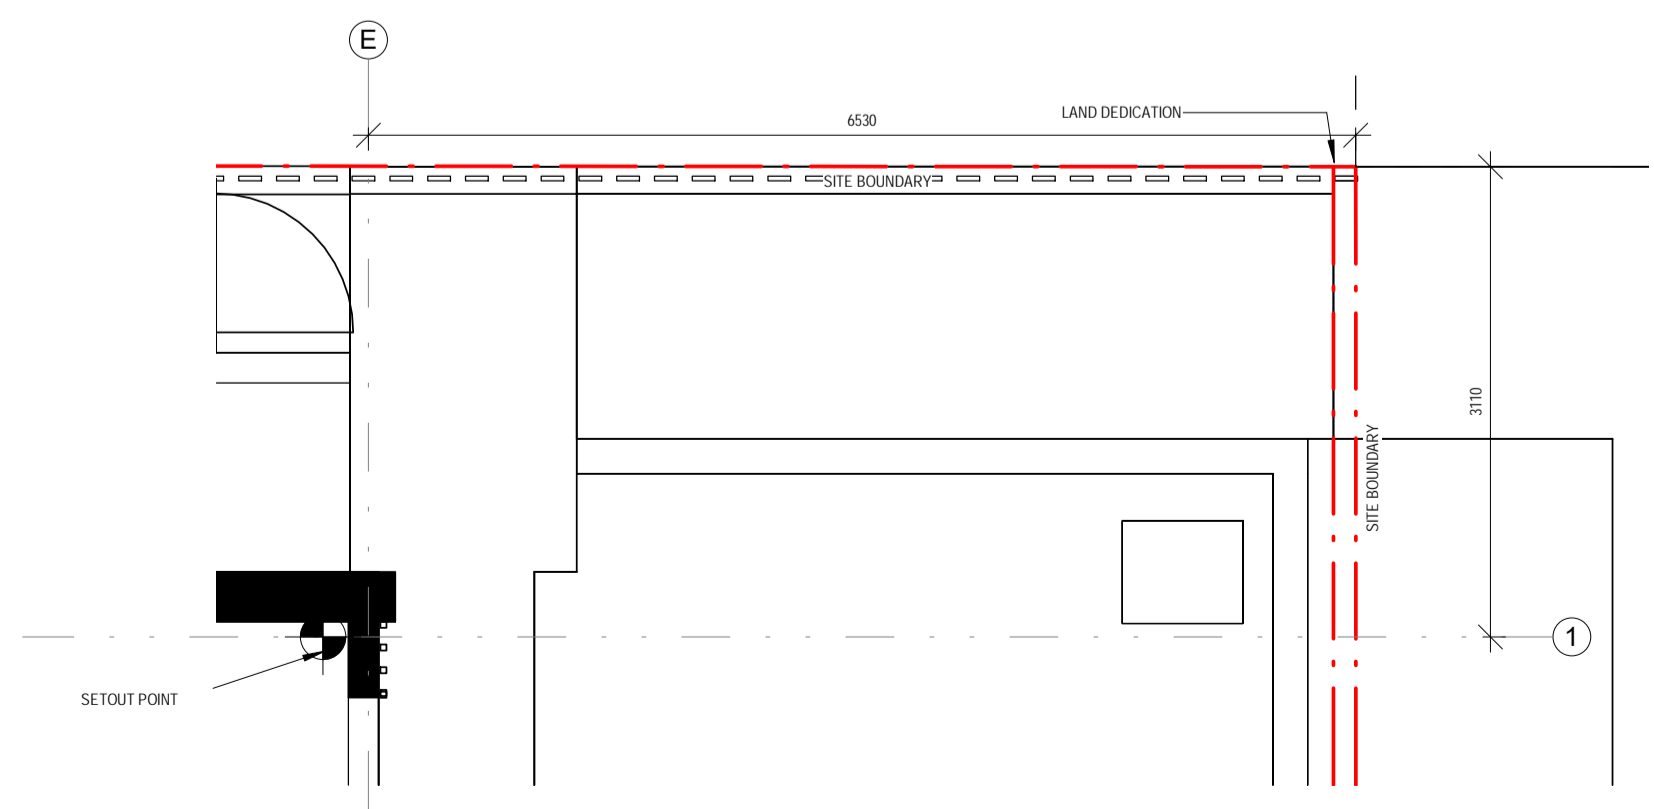

SETOUT POINT DETAIL
1:50 REFER 2 - CD-106

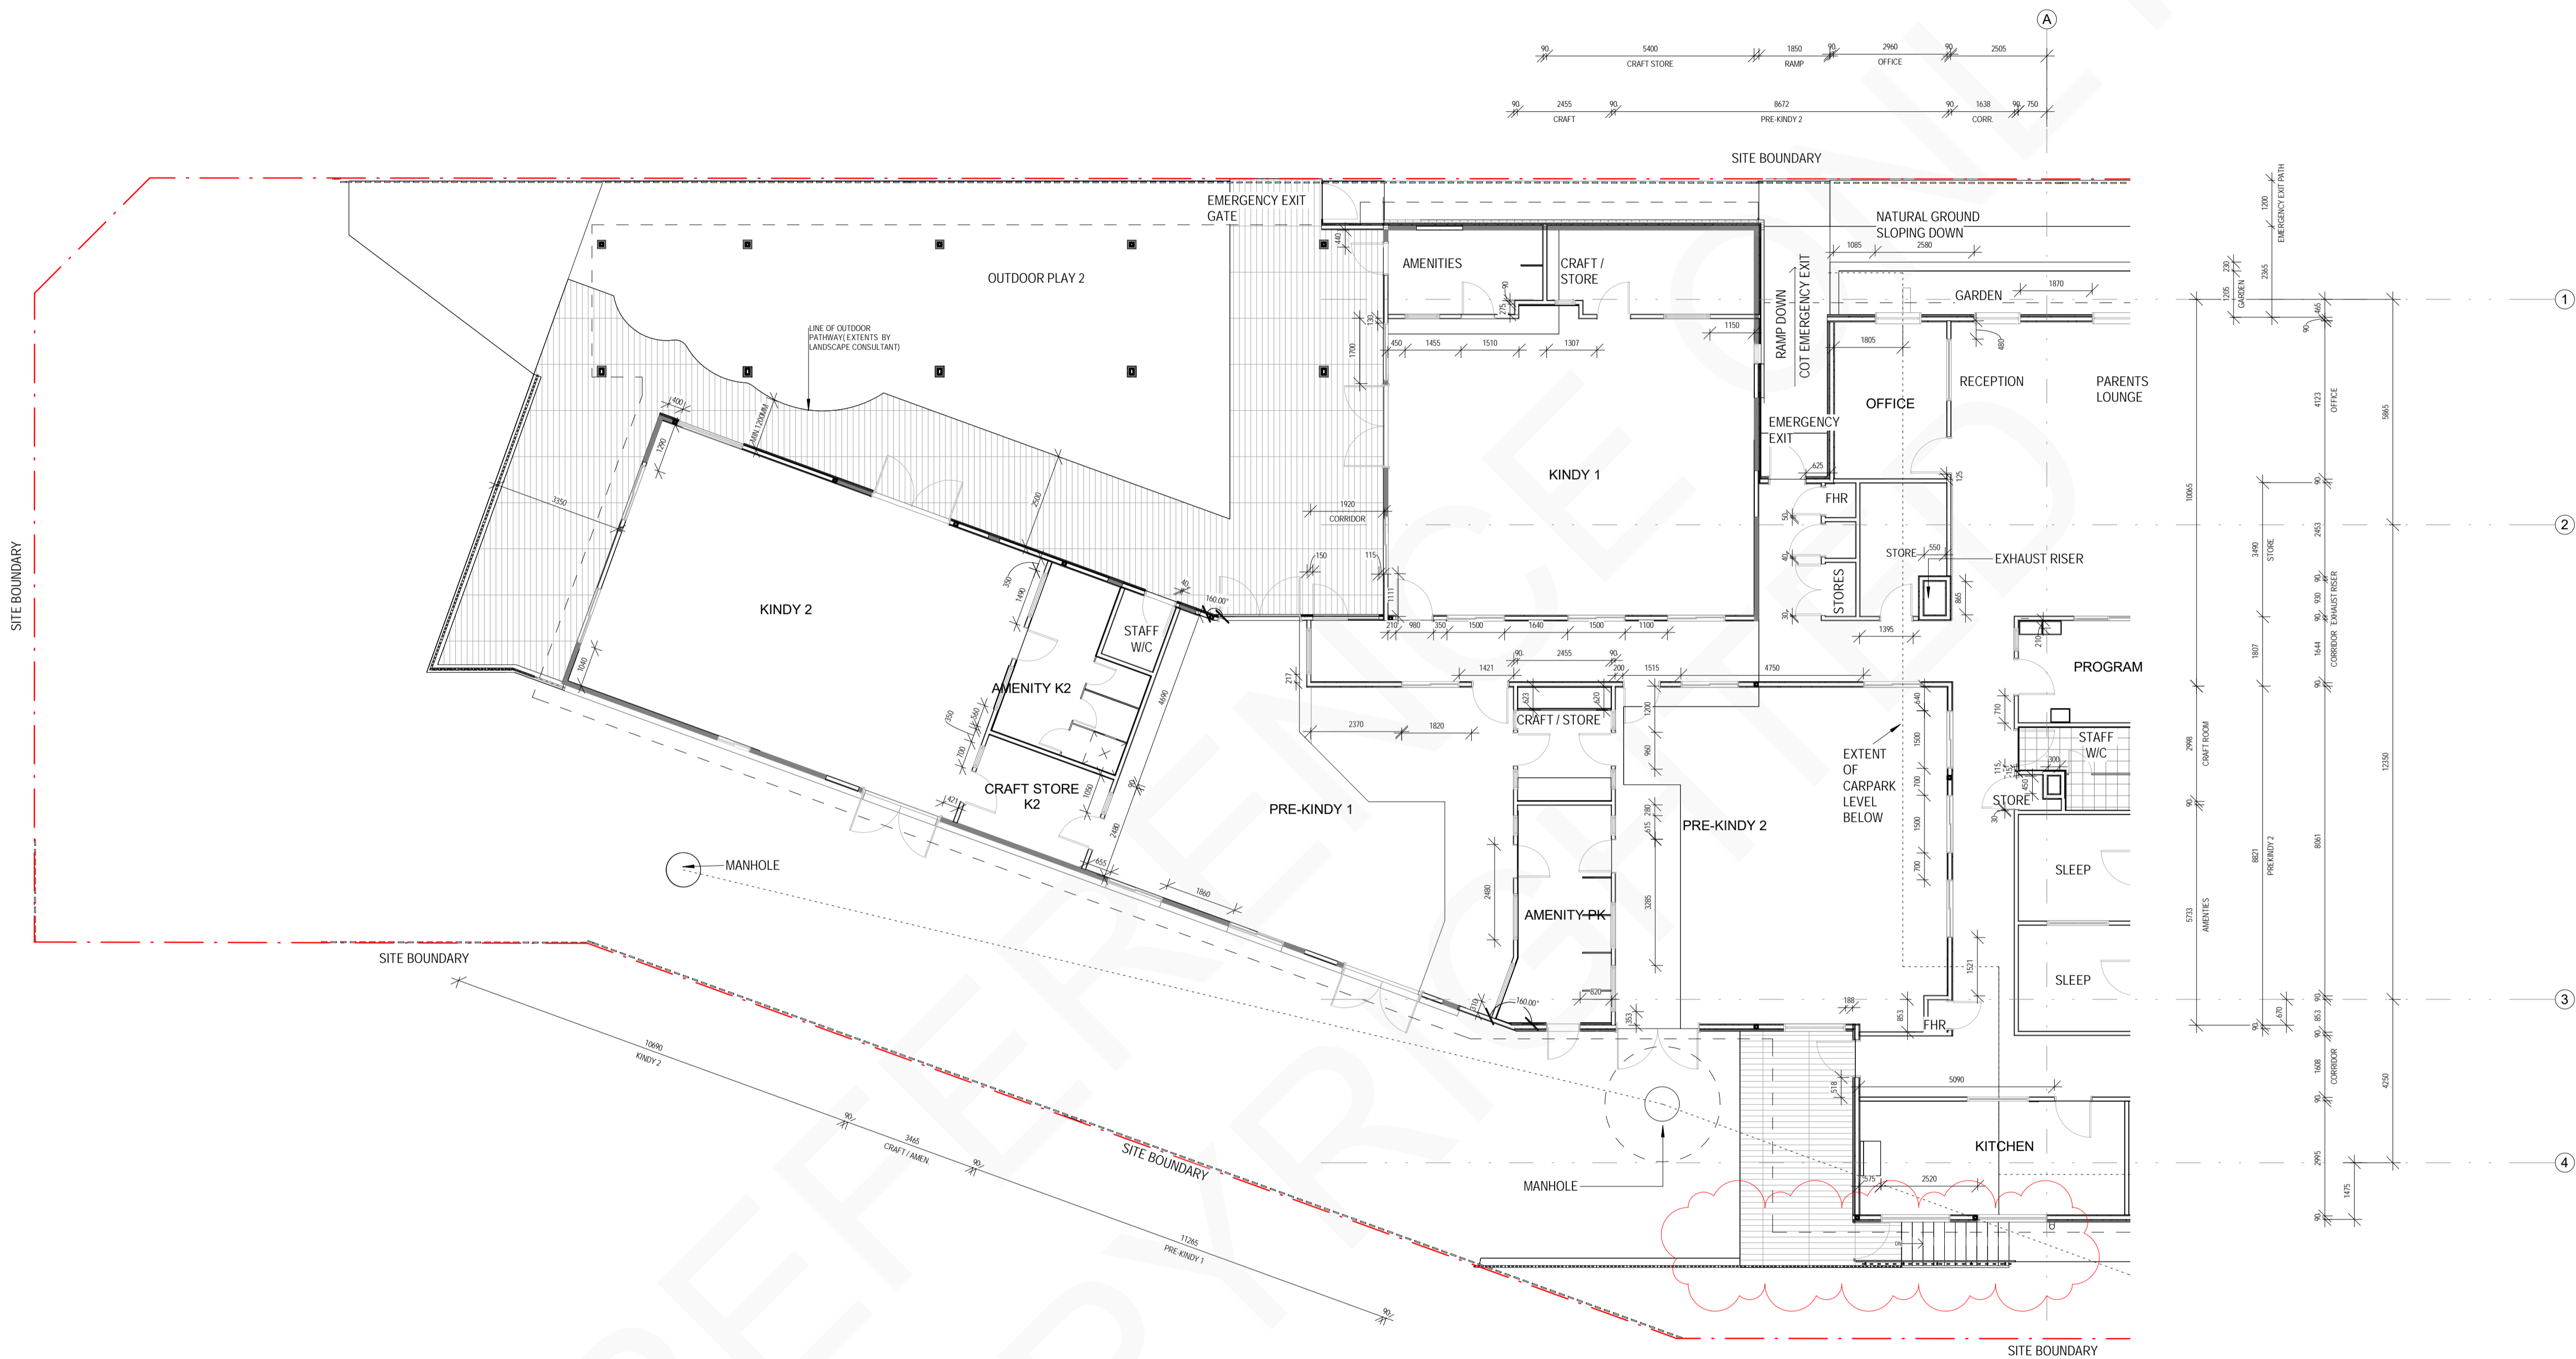


AG	AGRICULTURAL PIPE LINE
BAL-01	BALUSTRADE
BAL-02	BALUSTRADE
BAT-03	BALUSTRADE
BD	BOLLARD
BG	BOX GUTTER
BRK-01	BRICK FACADE
BV	BRICK VENEER
COL	COLUMN
DP	DOWN PIPE
EG	EAVES GUTTER
FEN-02	FENCING
FEN-02/1	FENCING
FHR	FIRE HOSE REEL
FLR CON-1	CONCRETE FINISH
FWG	FLOOR WASTE GUTTER
GD	GRADED DRAIN SEWAGE
GR-01	GULLY
GR-02	GUARDRAIL 1200MM HIGH
GR-03	GUARDRAIL 1500MM HIGH
GR-03	GUARDRAIL 1800mm HIGH
INL	INTAKE LOUVER
J	JOINERY
LIN-01	HORIZONTAL CLADDING
LO	LOCKER
MH	MANHOLE
OHF	OVERHEAD FLASHING
PLD	PLANTING DRAIN
PNT-01	PAINT EXTERIOR
PNT-03	PAINT EXTERIOR OVER CONCRETE
PNT-04	ROOF PAINT
RF-001	METAL ROOF STRUCTURE
RF-002	SOLARSPAN SANDWICH PANEL
RM	RECESSED ENTRY MAT
RP	REFRIGERANT PIPES
TGSI	TACTILE INDICATORS TO AS 1428
TR	TROUGH
TS	TIMBERLOOK ALUMINIUM BATTEN SCREEN
TWH	TWIN HYDRANT
WL	WALL LIGHT ABOVE 1500MM FROM STAIR
WS	WHEEL STOP

REFER TO SCHEDULES



PROPOSED SETOUT PLAN - GROUND FLOOR PLAN PART A

1:100 REFER 1 - CD.200

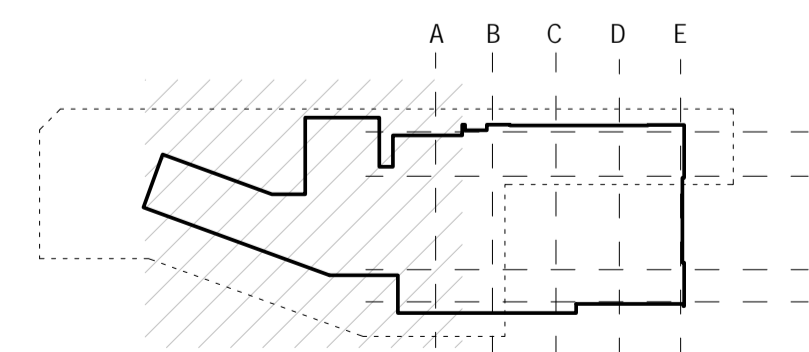


KEYPLAN PART A

1:1000

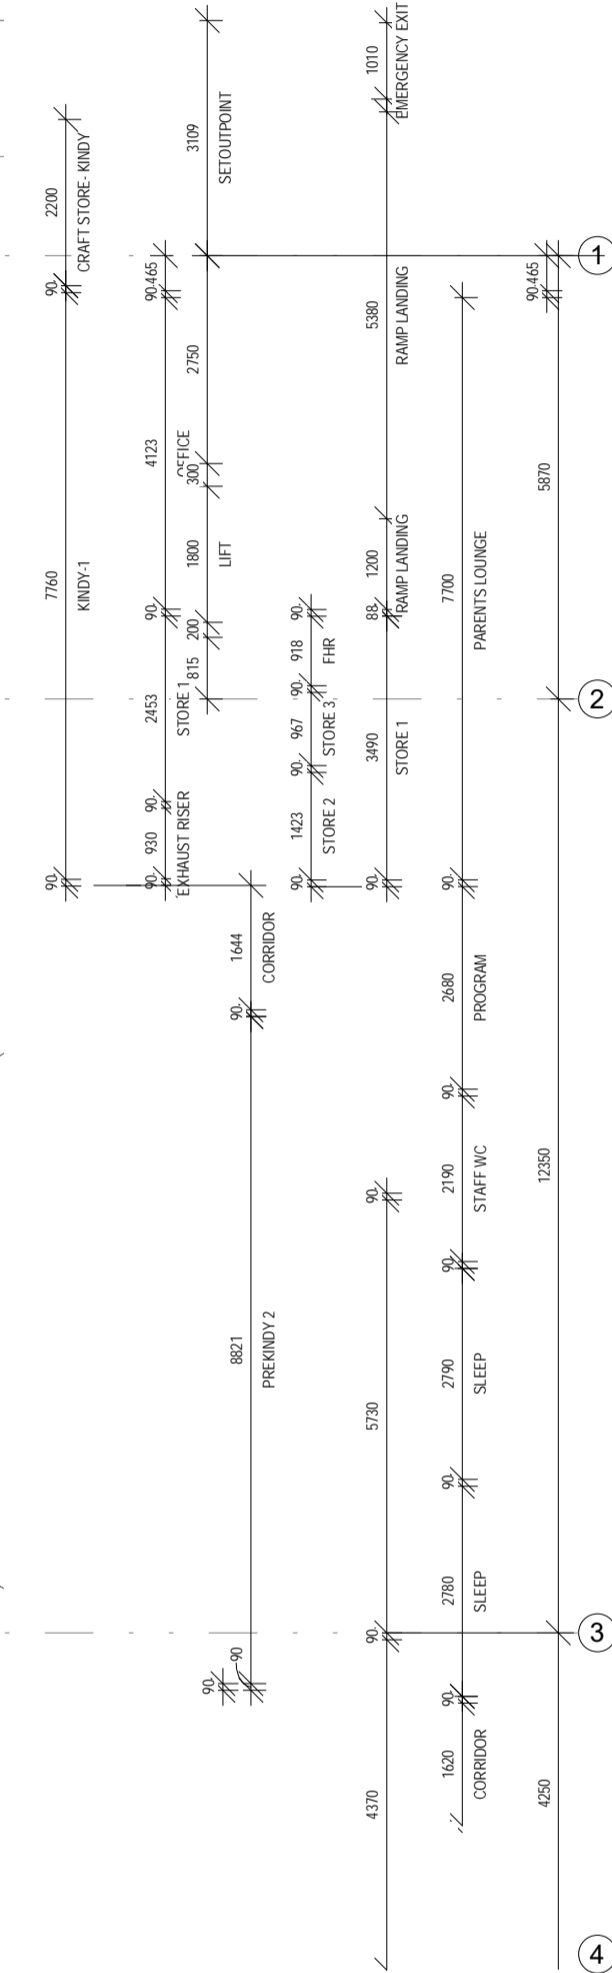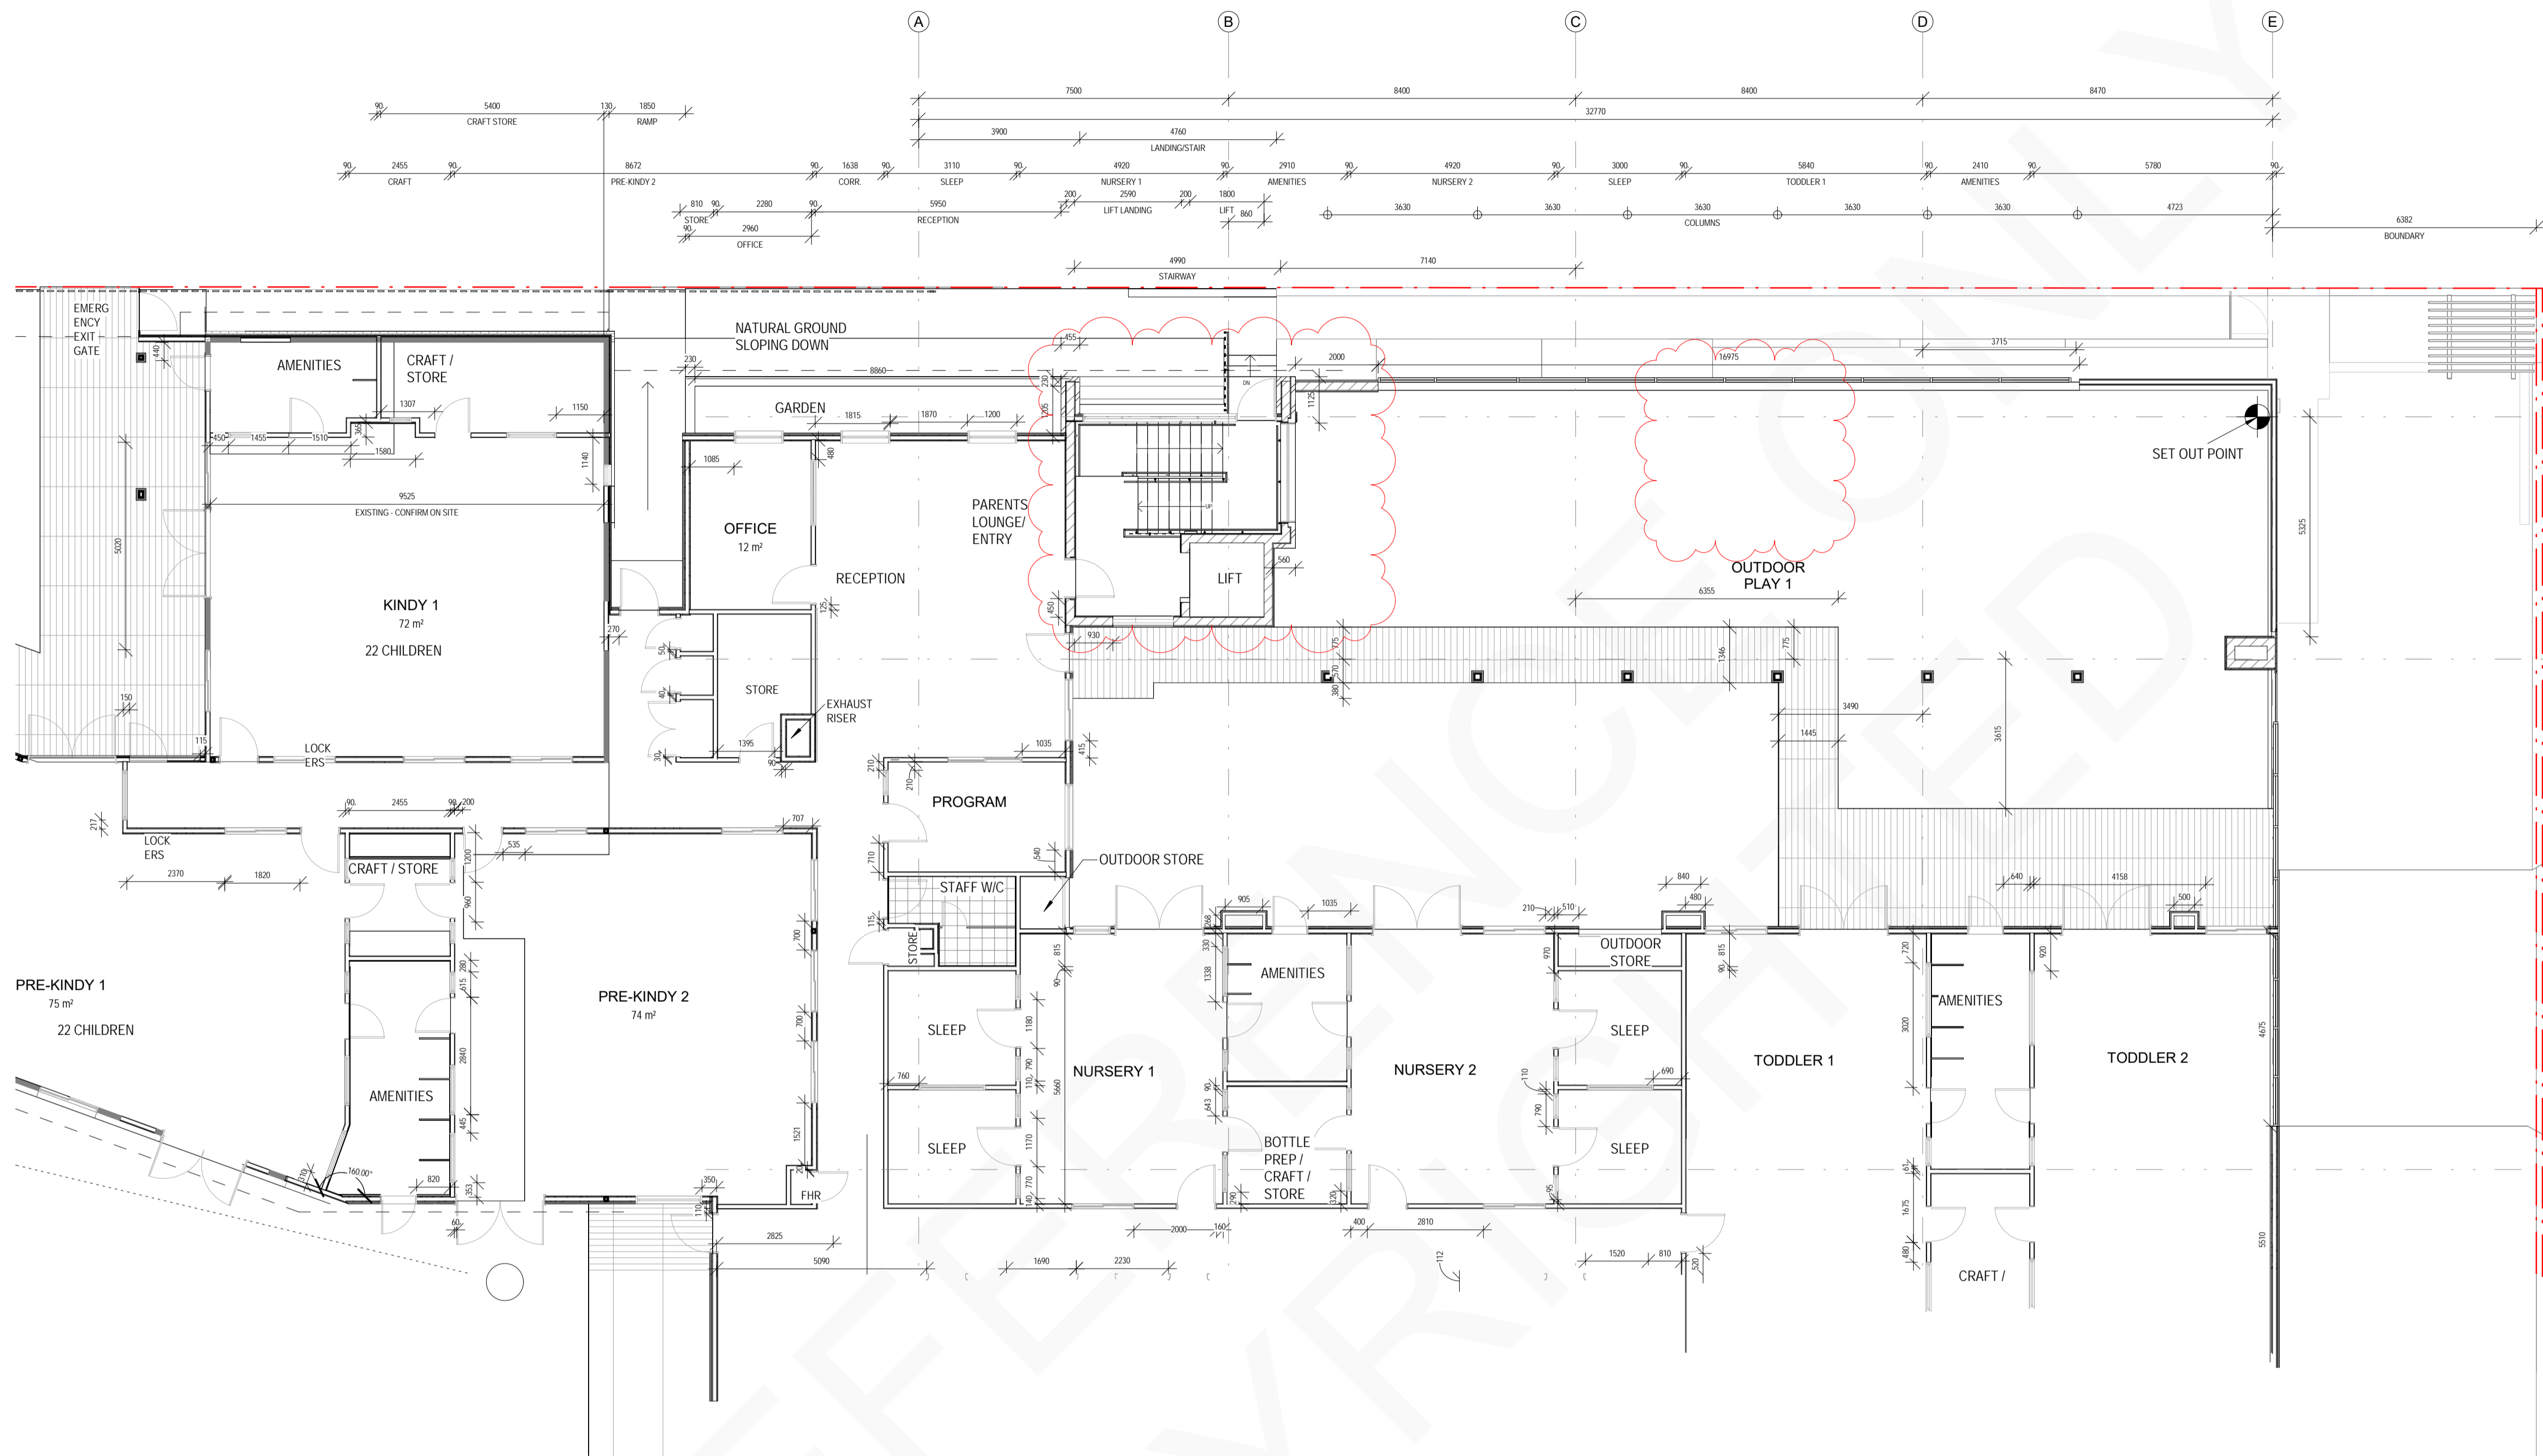



- | | |
|-----------|---|
| AG | AGRICULTURAL PIPE LINE |
| BAL-01 | BALUSTRADE |
| BAL-02 | BALUSTRADE |
| BAT-03 | BALUSTRADE |
| BD | BOLLARD |
| BG | BOX GUTTER |
| BRK-01 | BRICK FACADE |
| BV | BRICK VENEER |
| COL | COLUMN |
| DP | DOWN PIPE |
| EG | EAVES GUTTER |
| FEN-02 | FENCING |
| FEN-0271 | FIRE HOSE REEL |
| FHR | CONCRETE FINISH |
| FLR CON-1 | FLOOR WASTE GUTTER |
| FWG | GRADED DRAIN SEWAGE |
| GD | GULLY |
| GR-01 | GUARDRAIL 1200MM HIGH |
| GR-02 | GUARDRAIL 1500MM HIGH |
| GR-03 | GUARDRAIL 1800mm HIGH |
| INL | INTAKE LOUVER |
| J | JOINERY |
| LIN-01 | HORIZONTAL CLADDING |
| LO | LOCKER |
| MH | MANHOLE |
| OHF | OVERHEAD FLASHING |
| PLD | PLANTING DRAIN |
| PNT-01 | PAINT EXTERIOR |
| PNT-03 | PAINT EXTERIOR OVER CONCRETE |
| PNT-04 | ROOF PAINT |
| RF-01 | METAL ROOF STRUCTURE |
| RF-02 | SOLARSPAN SANDWICH PANEL |
| RM | RECESSED ENTRY MAT |
| RP | REFRIGERANT PIPES |
| TGSI | TACTICAL INDICATORS TO AS 1428 |
| TR | TROUGH |
| TS | TIMBERLOOK ALUMINIUM |
| TWH | BATTEN SCREEN |
| WL | TWIN HYDRANT |
| WS | WALL LIGHT ABOVE 1500MM FROM STAIR THREAD FFL |
| | WHEEL STOP |

REFER TO SCHEDULES

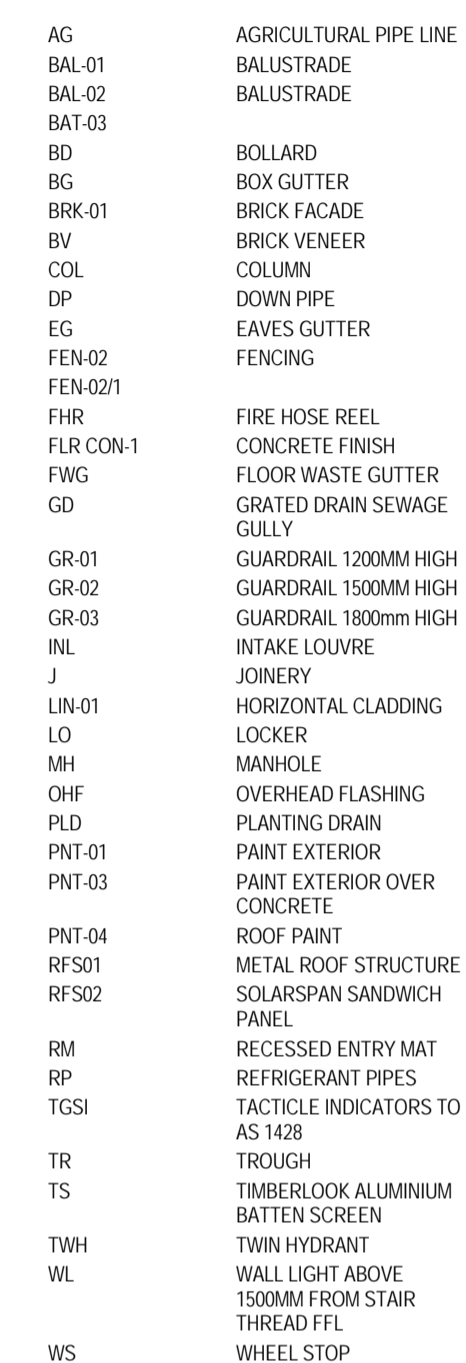


1 : 100

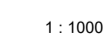

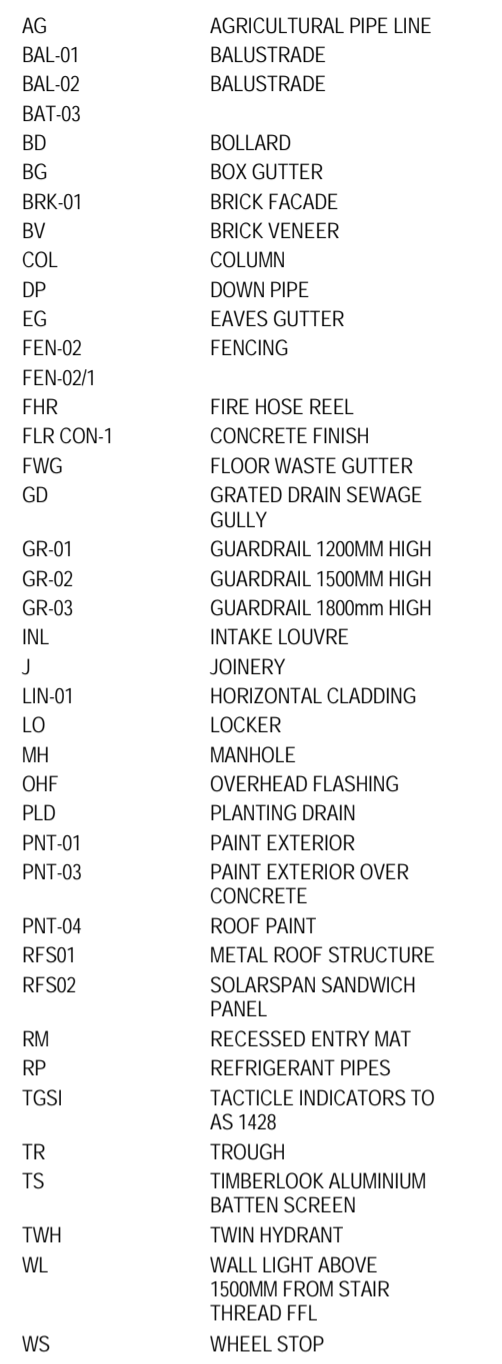

③

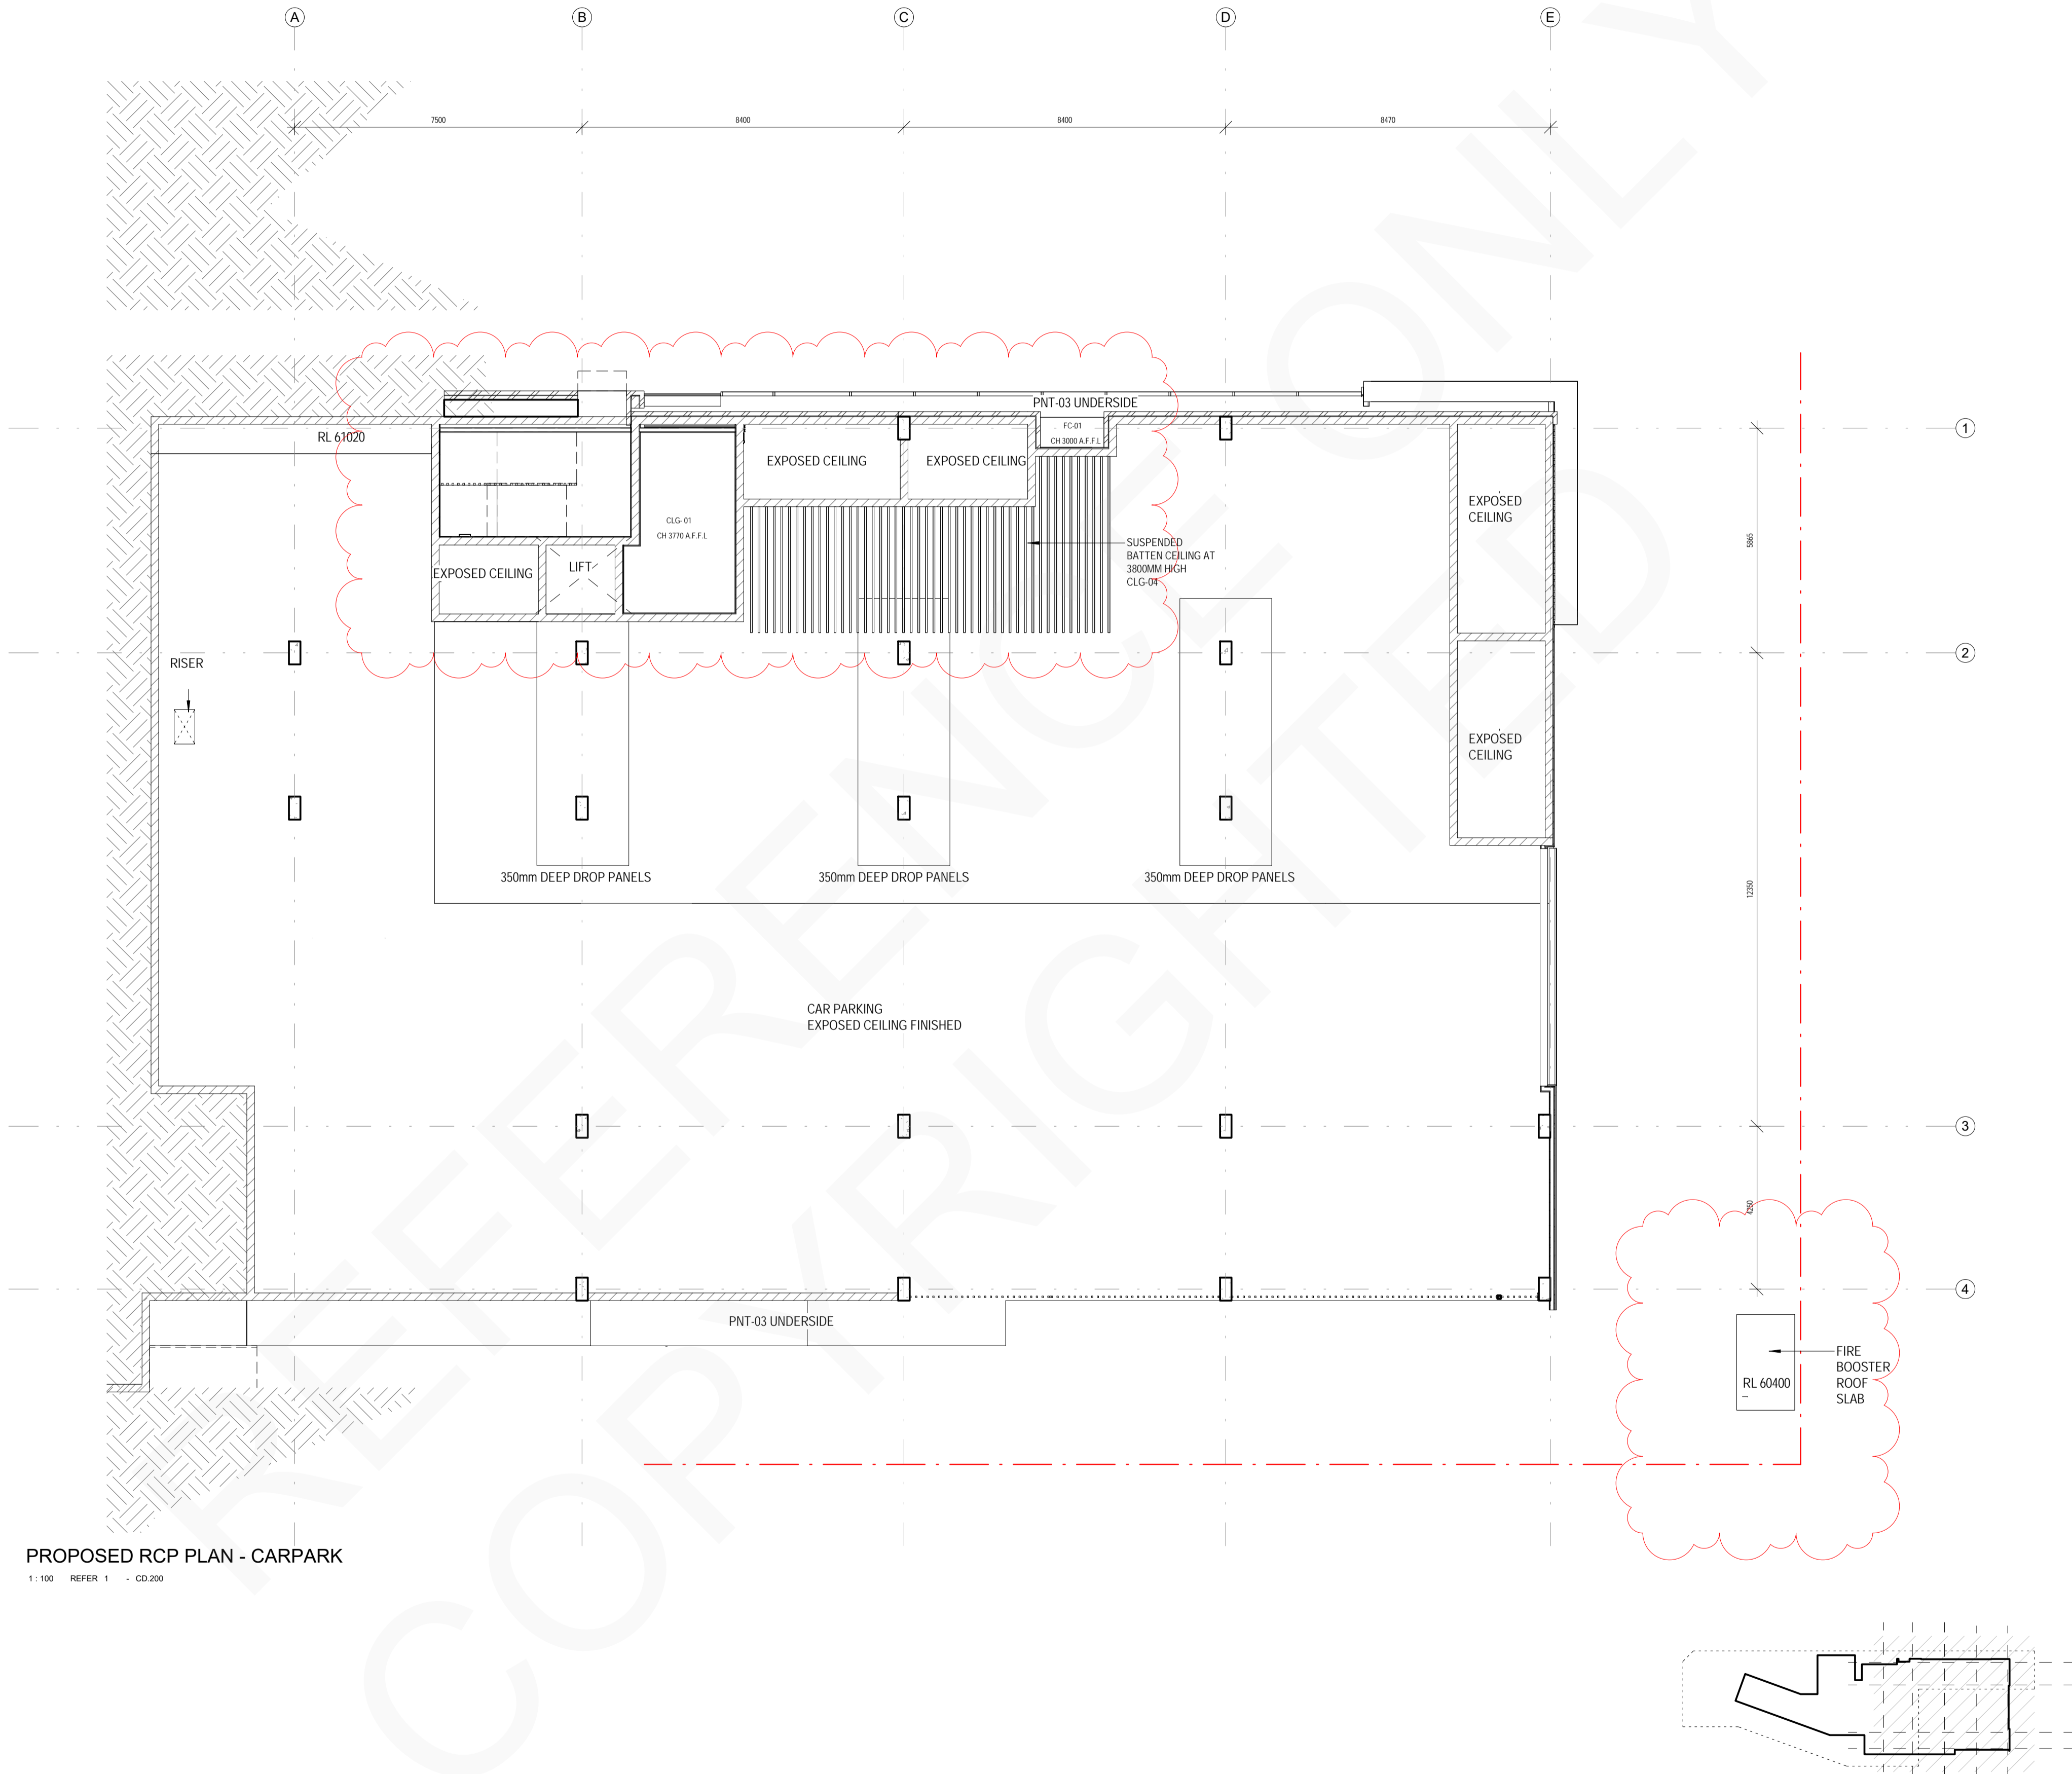

PROPOSED RCP PLAN - CARPARK
1:100 REFER 1 - CD-200

RCP LEGEND

DOUBLE CEILING THROUGH-OUT NEW BUILDING.
AREAS WITHIN DASHED RED LINE REQUIRED
1. HIGH LEVEL FIRE RATED 12mm RESCOM CEILING on FURRING CHANNELS DIRECTLY UNDER STRUCTURE TO ACHIEVE NOMINATED FIRE RATING.
INSTALL OF FUNCTION CEILING BELOW AND STRUCTURE PENETRATING FIRE RATED CEILING TO BE FIRE STOPPED AS PER MANUFACTURER'S SPECIFICATION
2. FUNCTIONAL CEILING AS NOTED ON RCP'S


MV	MECH VENT
AP	ACCESS S. PANELS - TBC
CLG-01	CONCEALED GRID SUSPENDED PAINTED FLUSH JOINTED PLASTERBOARD CEILING
CLG-02	CONCEALED GRID SUSPENDED PAINTED MOISTURE RESISTANT FLUSH JOINTED PLASTERBOARD CEILING
CLG-03	CONCEALED GRID SUSPENDED PAINTED FLUSH JOINTED PLASTERBOARD ACOUSTIC CEILING
CLG-04	SUSPENDED ALUMINIUM BATTEN CEILING
FC-01	FLUSH JOINTED PAINTED FIBRE CEMENT SHEETING TYPICALLY TO SOFFIT RAKING WHERE NOTED
S	FIXED SKYDOME SKYLIGHTS
CH	CEILING HEIGHTS

ELECTRICAL LEGEND
REFER TO ELECTRICAL ENGINEER'S DOCUMENTATION SHOWN FOR COORDINATION PURPOSES ONLY


[Symbol]	LIGHTING
[Symbol]	EMERGENCY LIGHTING
[Symbol]	EMERGENCY EXIT SIGN
[Symbol]	MOTION SENSOR

MECHANICAL LEGEND
REFER TO MECHANICAL ENGINEER'S DOCUMENTATION SHOWN FOR COORDINATION PURPOSES ONLY

[Symbol]	DIFFUSER
[Symbol]	RETURN AIR
[Symbol]	ACCESS PANEL

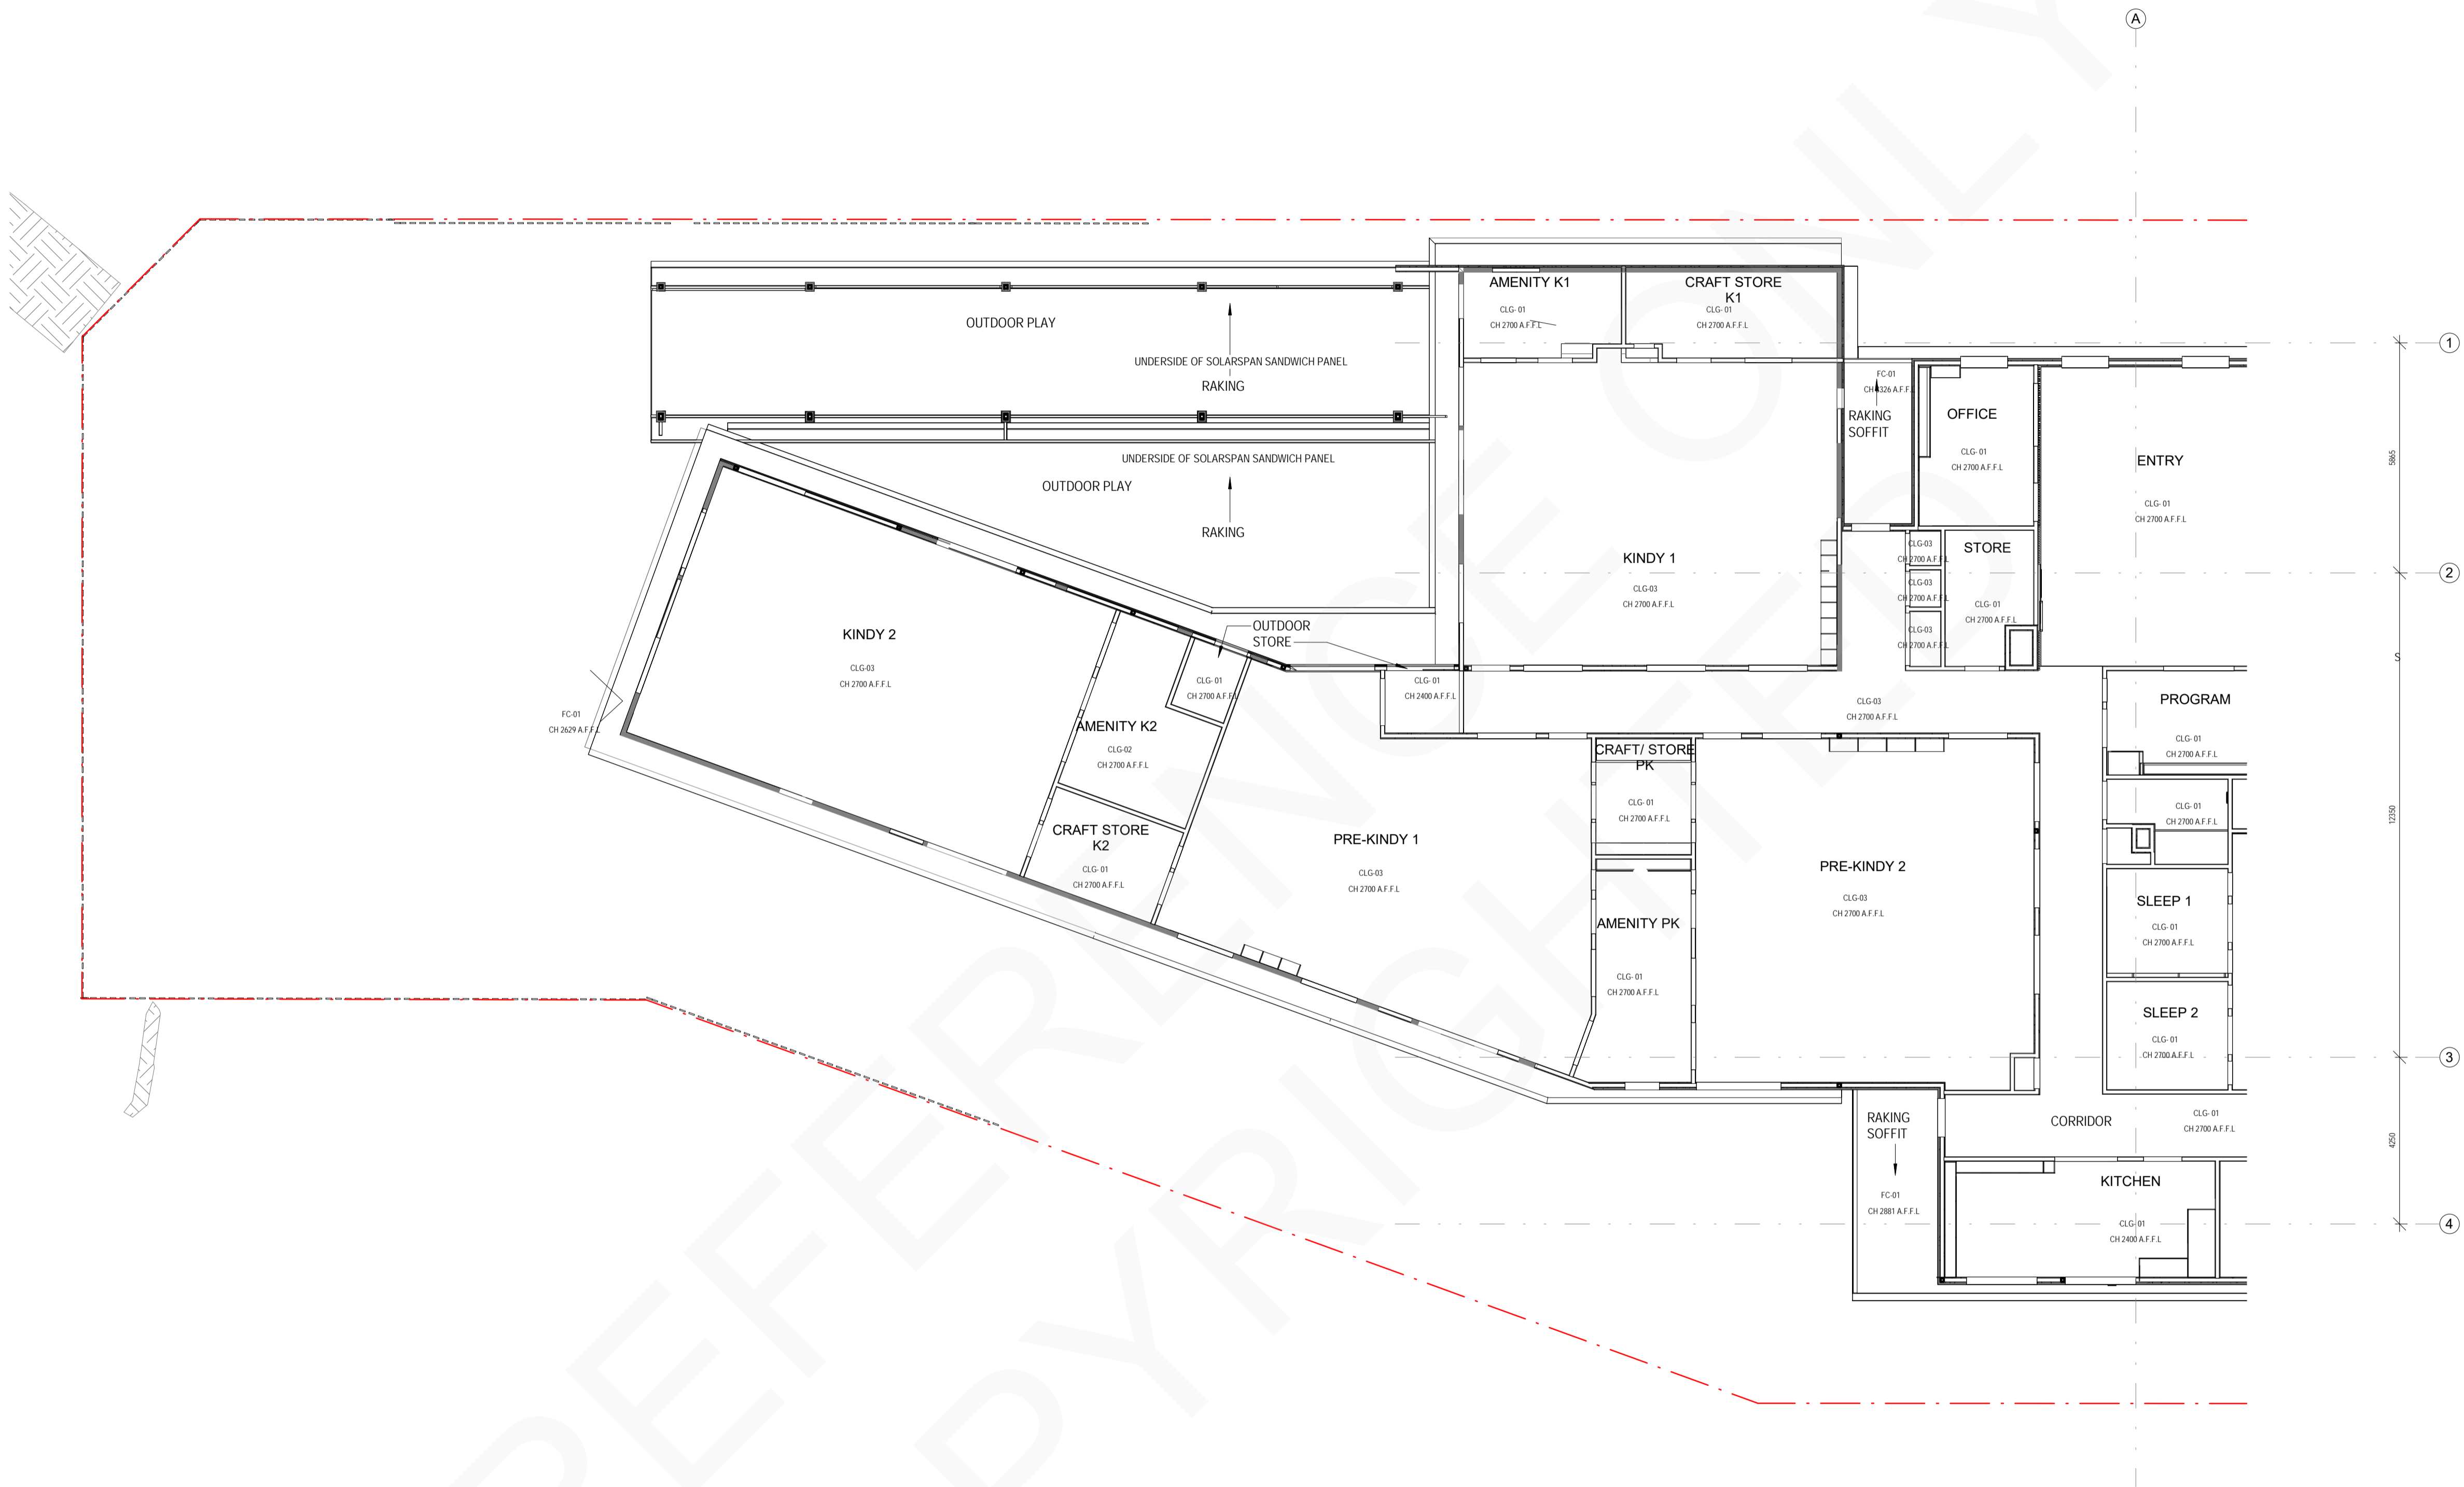

PROPOSED RCP PLAN - GROUND - PART A
1:100 REFER 1 - CD 200

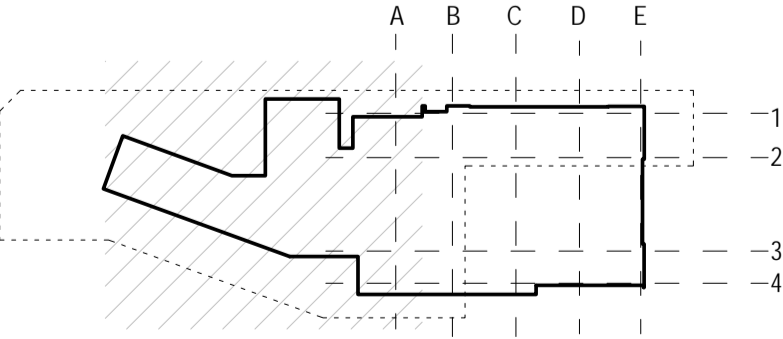

KEYPLAN PART A
1:1000

RCP LEGEND	
DOUBLE CEILING THROUGH-OUT NEW BUILDING. AREAS WITHIN DASHED RED LINE REQUIRED	
1. HIGH LEVEL FIRE RATED 12mm RESCOM CEILING on FURRING CHANNELS DIRECTLY UNDER STRUCTURE TO ACHIEVE NOMINATED FIRE RATING. INSTALL OF FUNCTION CEILING BELOW AND STRUCTURE PENETRATING FIRE RATED CEILING TO BE FIRE STOPPED AS PER MANUFACTURER'S SPECIFICATION	
2. FUNCTIONAL CEILING AS NOTED ON RCP'S	
MV	MECH VENT
AP	ACCESS PANELS - TBC
CLG-01	CONCEALED GRID SUSPENDED PAINTED FLUSH JOINTED PLASTERBOARD CEILING
CLG-02	CONCEALED GRID SUSPENDED PAINTED MOISTURE RESISTANT FLUSH JOINTED PLASTERBOARD CEILING
CLG-03	CONCEALED GRID SUSPENDED PAINTED FLUSH JOINTED PLASTERBOARD ACUSTIC CEILING
CLG-04	SUSPENDED ALUMINUM BATTEN CEILING
FC-01	FLUSH JOINTED PAINTED FIBRE CEMENT SHEETING TYPICALLY TO 500mm RAKING WHERE NOTED
S	FIXED SKYLINE SKYLIGHTS
CH	CEILING HEIGHTS
ELECTRICAL LEGEND	
REFER TO ELECTRICAL ENGINEER'S DOCUMENTATION SHOWN FOR COORDINATION PURPOSES ONLY	
	LIGHTING
	EMERGENCY LIGHTING
	EMERGENCY EXIT SIGN
	MOTION SENSOR
MECHANICAL LEGEND	
REFER TO MECHANICAL ENGINEER'S DOCUMENTATION SHOWN FOR COORDINATION PURPOSES ONLY	
	DIFFUSER
	RETURN AIR
	ACCESS PANEL



RCP LEGEND

DOUBLE CEILING THROUGH-OUT NEW BUILDING.
AREAS WITHIN DASHED RED LINE REQUIRED

1. HIGH LEVEL FIRE RATED 12mm RESCOM CEILING
on FURRING CHANNELS DIRECTLY UNDER
STRUCTURE TO ACHIEVE NOMINATED FIRE RATING.
INSTALL OF FUNCTION CEILING BELOW AND
STRUCTURE PENETRATING FIRE RATED CEILING TO
BE FIRE STOPPED AS PER MANUFACTURER'S
SPECIFICATION

2. FUNCTIONAL CEILING AS NOTED ON RCP'S

MV MECH VENT
AP ACCESS PANELS - TBC
CLG-01 CONCEALED GRID SUSPENDED PAINTED FLUSH JOINTED
PLASTERBOARD CEILING
CLG-02 CONCEALED GRID SUSPENDED PAINTED MOISTURE
RESISTANT FLUSH JOINTED PLASTERBOARD CEILING
CLG-03 CONCEALED GRID SUSPENDED PAINTED FLUSH JOINTED
PLASTERBOARD ACUSTIC CEILING
CLG-04 SUSPENDED ALUMINUM BATTEN CEILING
FC-01 FLUSH JOINTED PAINTED FIBRE CEMENT SHEETING
TYPICALLY TO SOFFIT RAKING WHERE NOTED
S FIXED SKYDOME SKYLIGHTS
CH CEILING HEIGHTS

ELECTRICAL LEGEND

REFER TO ELECTRICAL ENGINEERS DOCUMENTATION
SHOWN FOR COORDINATION PURPOSES ONLY


LIGHTING
EMERGENCY LIGHTING
EMERGENCY EXIT SIGN
MOTION SENSOR

MECHANICAL LEGEND


REFER TO MECHANICAL ENGINEERS DOCUMENTATION
SHOWN FOR COORDINATION PURPOSES ONLY

DIFFUSER
RETURN AIR
ACCESS PANEL

PROPOSED RCP PLAN - GROUND -PART B
1:100 REFER 1 - CD-200

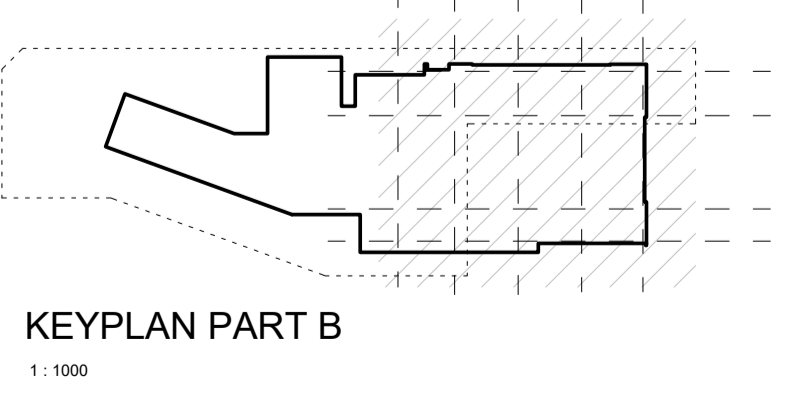


KEYPLAN PART B
1:1000

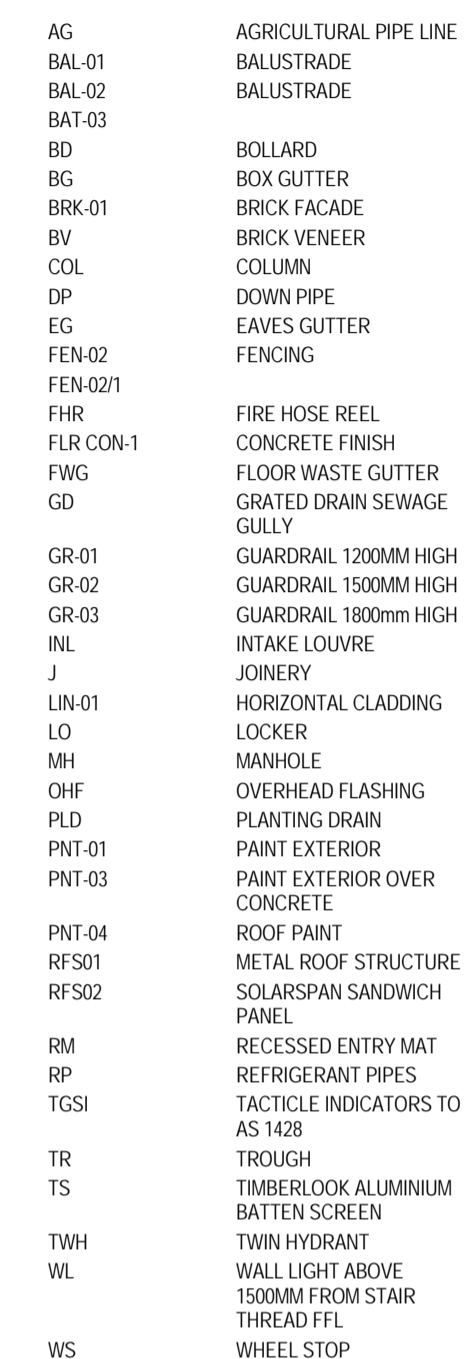


1 : 100 REFER 1 - CD.200



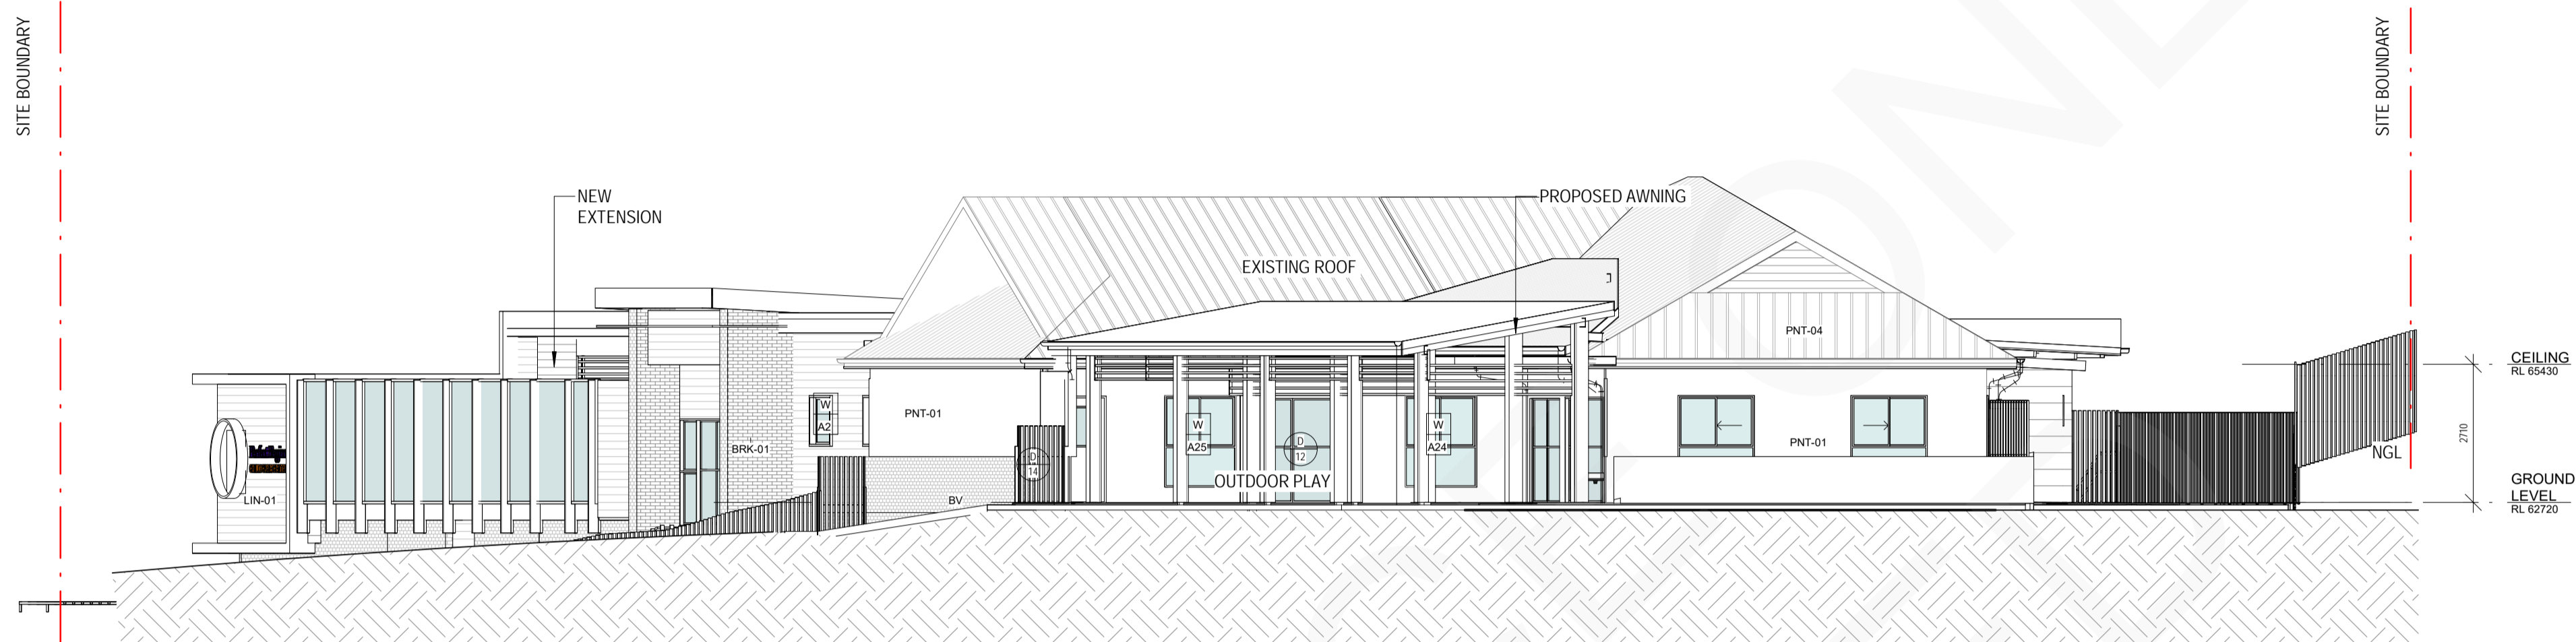


PROPOSED NORTH ELEVATION
1:100 REFER 2 - CD.104A

AG	AGRICULTURAL PIPE LINE
BAL-01	BALUSTRADE
BAL-02	BALUSTRADE
BAT-03	BALUSTRADE
BD	BOLLARD
BG	BOX GUTTER
BRK-01	BRICK FACADE
BV	BRICK VENEER
COL	COLUMN
DP	DOWN PIPE
EG	EAVES GUTTER
FEN-02	FENCING
FHR	FIRE HOSE REEL
FLR CON-1	CONCRETE FINISH
FWG	FLOOR WASTE GUTTER
GD	GRATED DRAIN SEWAGE GULLY
GR-01	GUARDRAIL 1200mm HIGH
GR-02	GUARDRAIL 1500mm HIGH
GR-03	GUARDRAIL 1800mm HIGH
INL	INTAKE LOUVER
J	JOINERY
LIN-01	HORIZONTAL CLADDING
LO	LOCKER
MH	MANHOLE
OHF	OVERHEAD FLASHING
PLD	PLANTING DRAIN
PNT-01	PAINT EXTERIOR
PNT-03	PAINT EXTERIOR OVER CONCRETE
PNT-04	ROOF PAINT
RFS01	METAL ROOF STRUCTURE
RFS02	SOLARSPAN SANDWICH PANEL
RM	RECESSED ENTRY MAT
RP	REFRIGERANT PIPES
TGSI	TACTILE INDICATORS TO AS 1428
TR	TROUGH
TS	TIMBERLOOK ALUMINIUM BATTEN SCREEN
TWH	TWIN HYDRANT
WL	WALL LIGHT ABOVE 1500mm FROM STAIR THREAD FFL
WS	WHEEL STOP

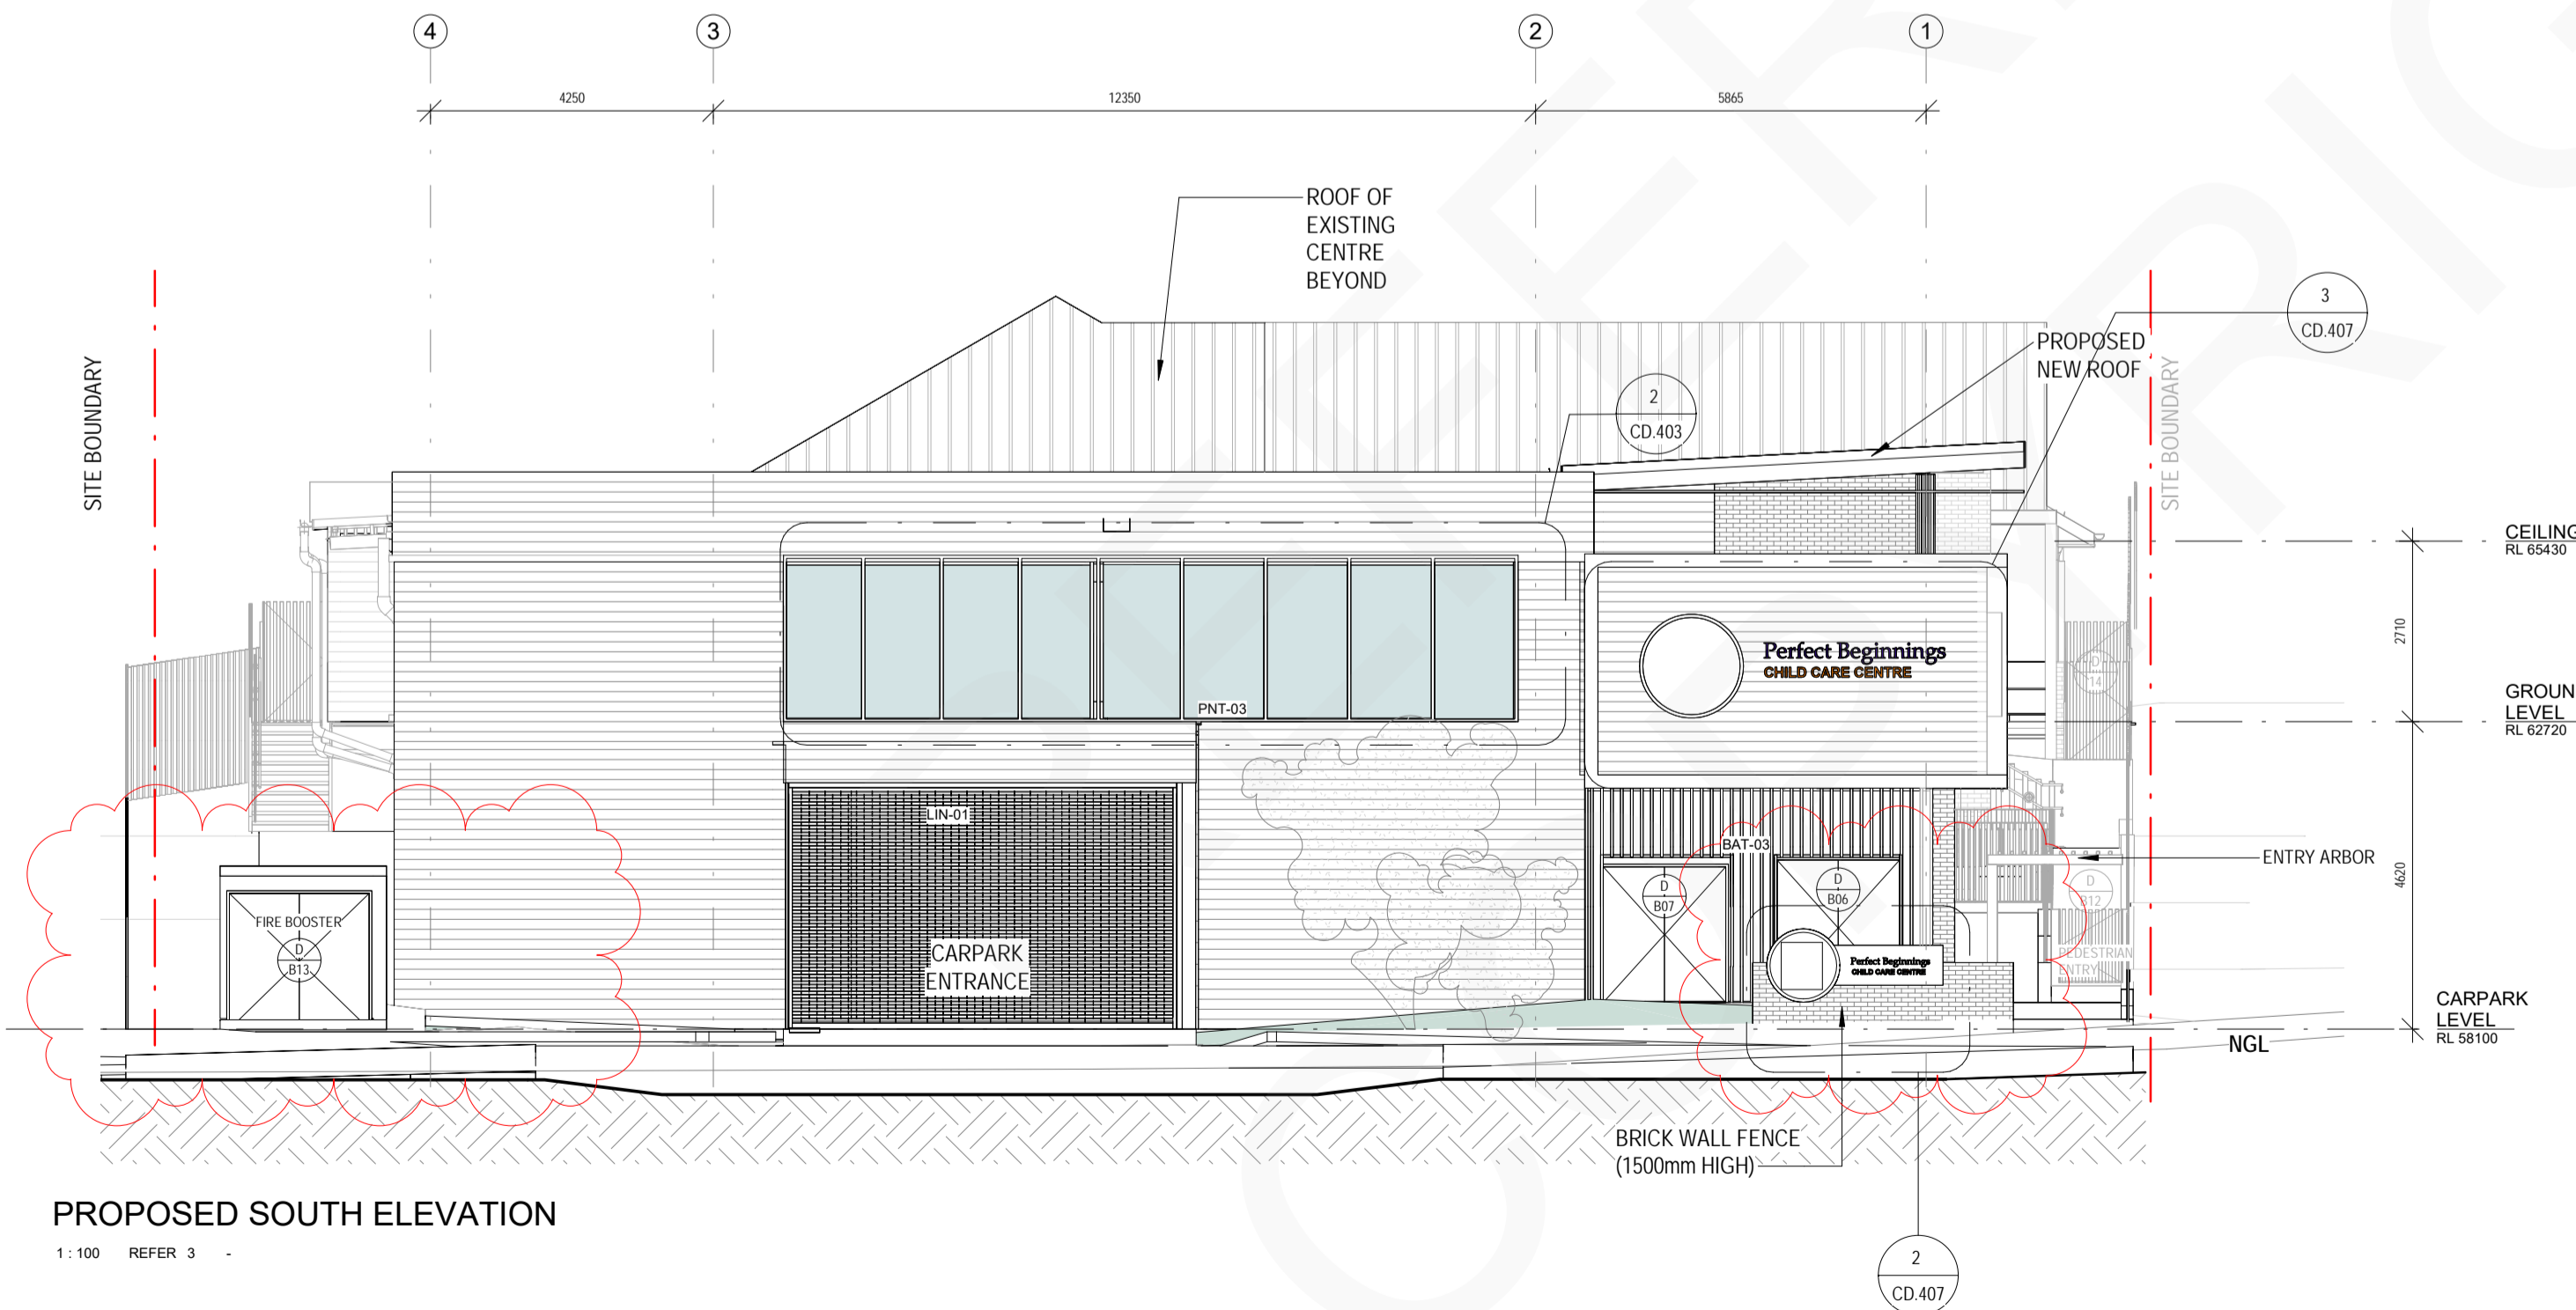


PROPOSED SOUTH ELEVATION
1:100 REFER 3 - CD.104B

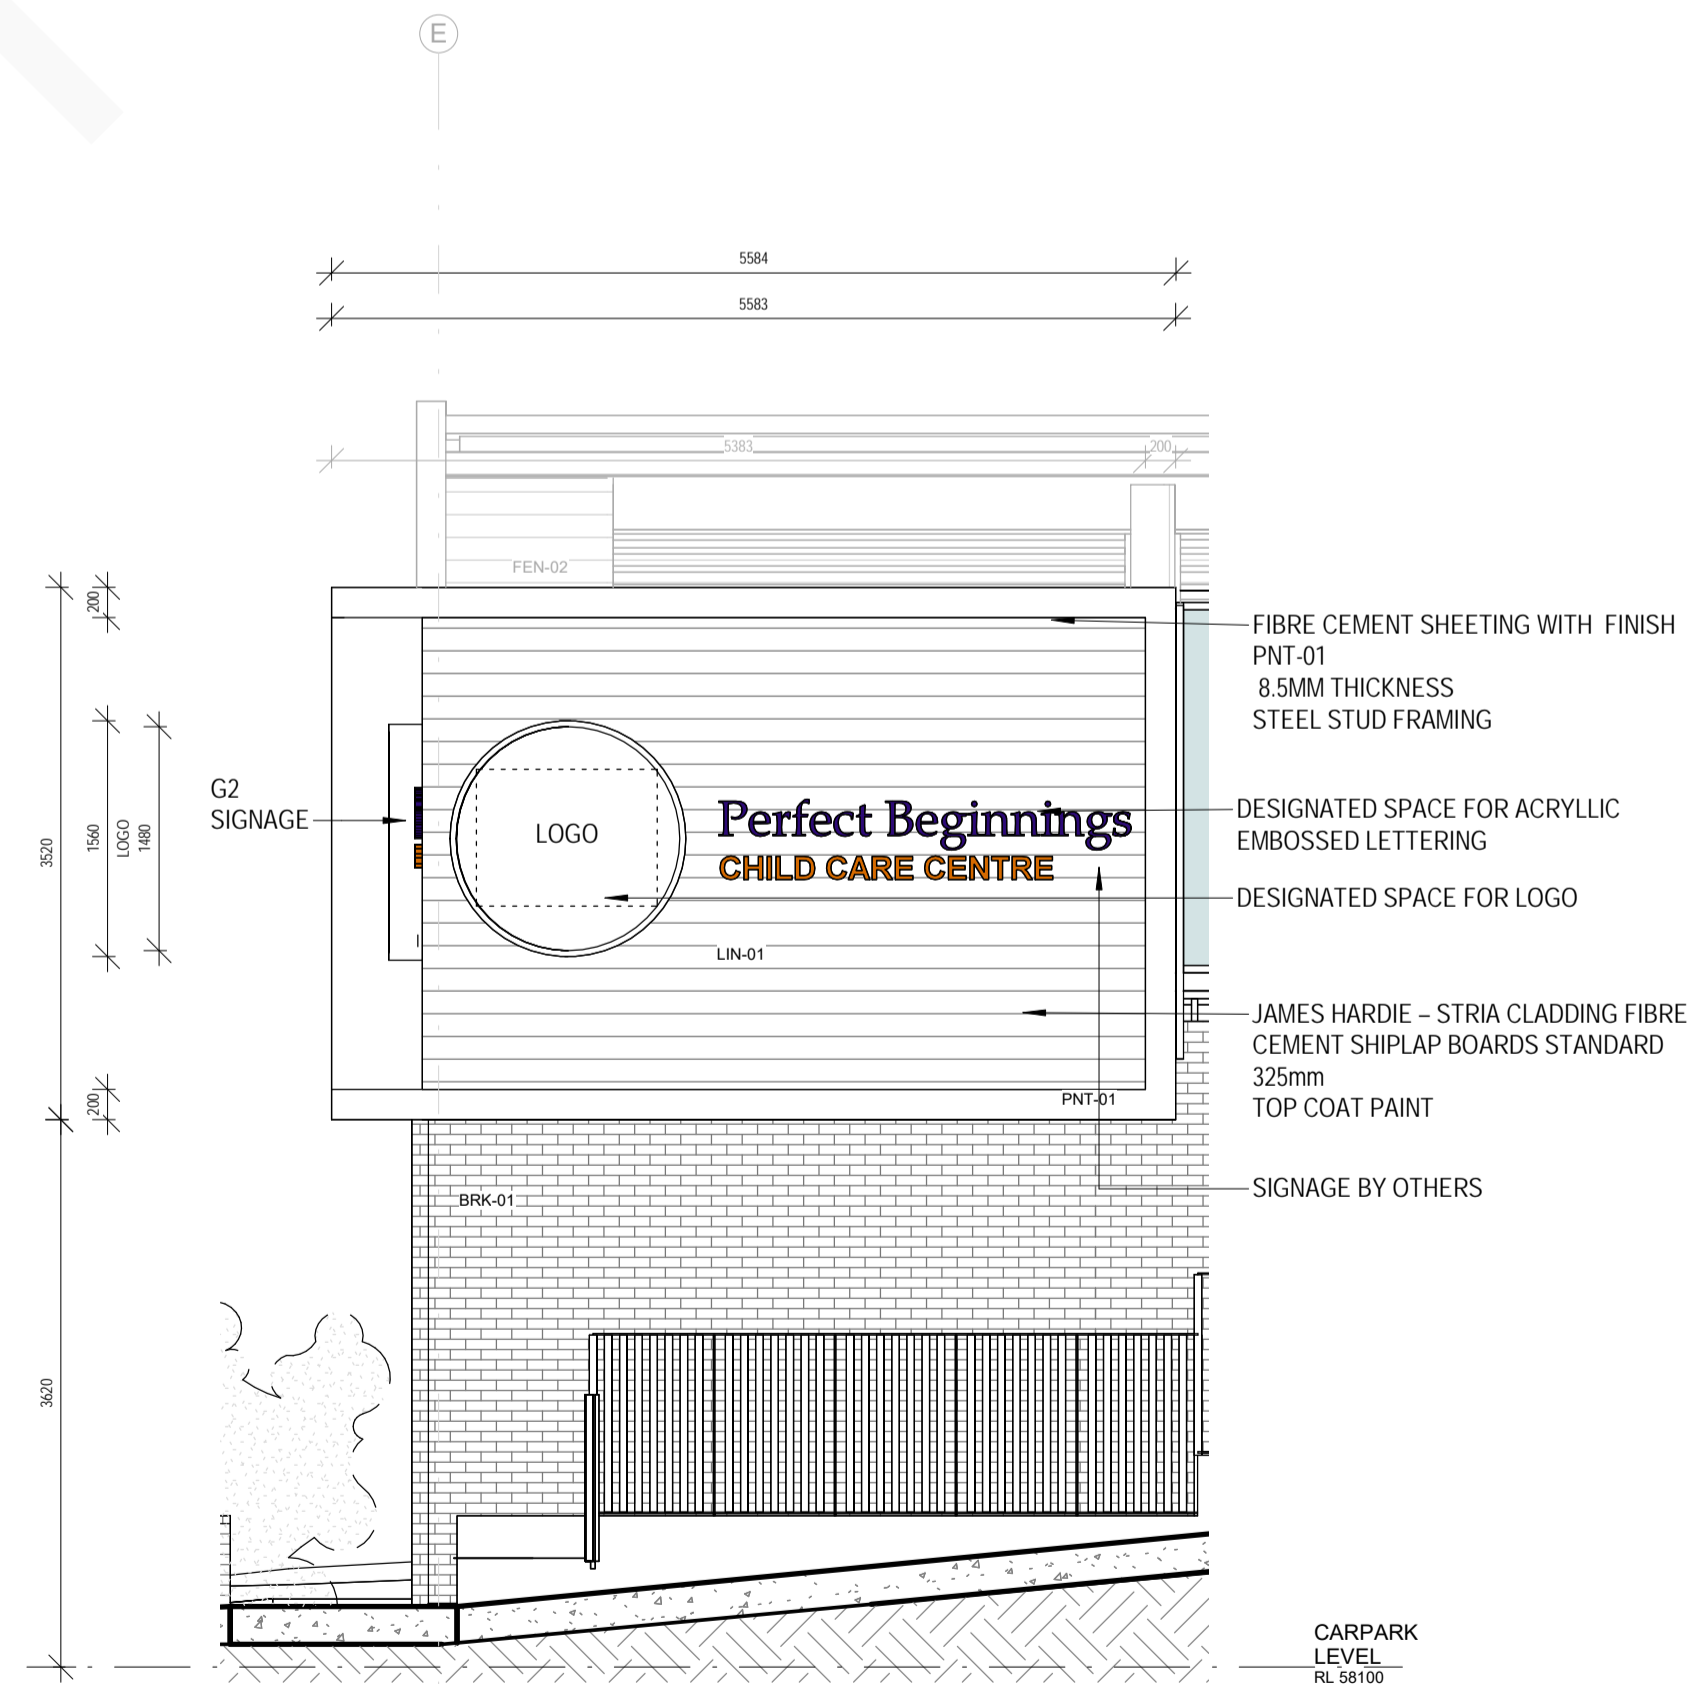

G3 SIGNAGE FRAMING DETAIL
1:50 REFER 1 - CD.104B


NOTE:
REFER TO SCHEDULES
ALL MATERIALS TO BE NON-COMBUSTABLE
AS PER AS1530.1

Amendments		
No.	DATE	DESCRIPTION
A	01/12/2021	CONSTRUCTION DOCUMENTATION
B	31/01/2022	TO URBAN PLANNER
C	09/02/2022	CONSTRUCTION DOCUMENTATION REVISION

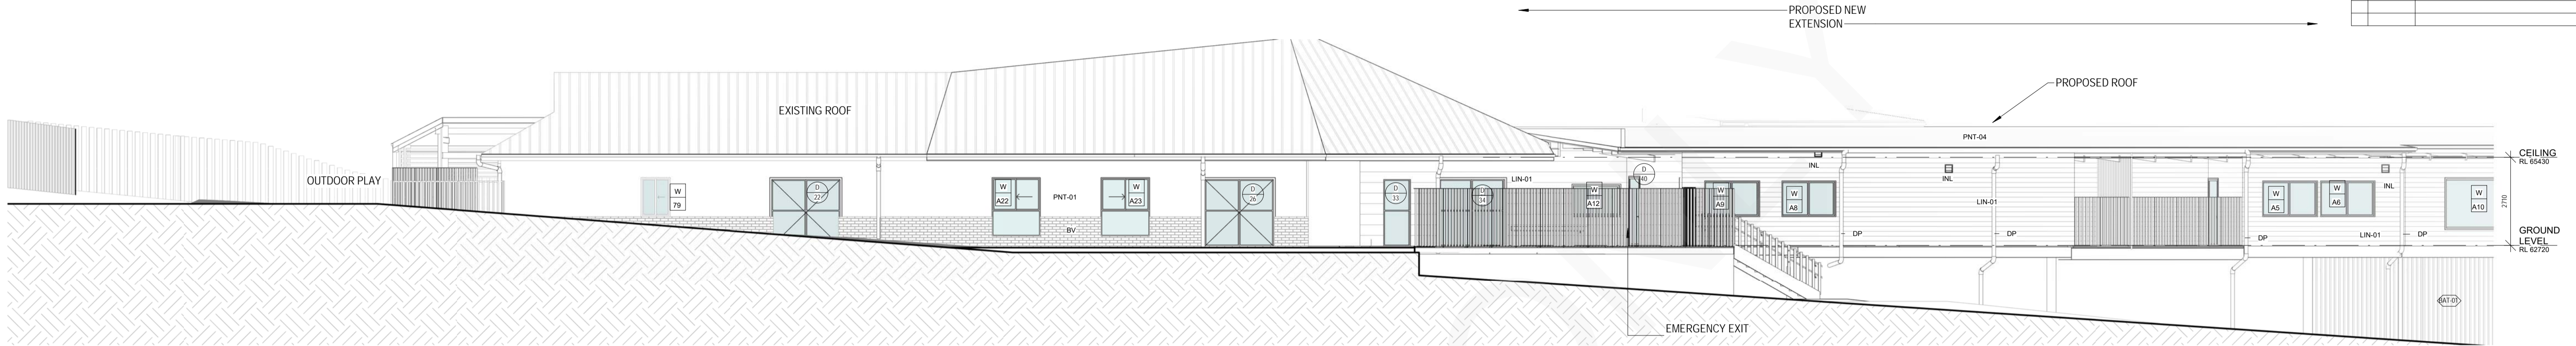


PROPOSED WEST ELEVATION

1:100 REFER 3 - CD.104E

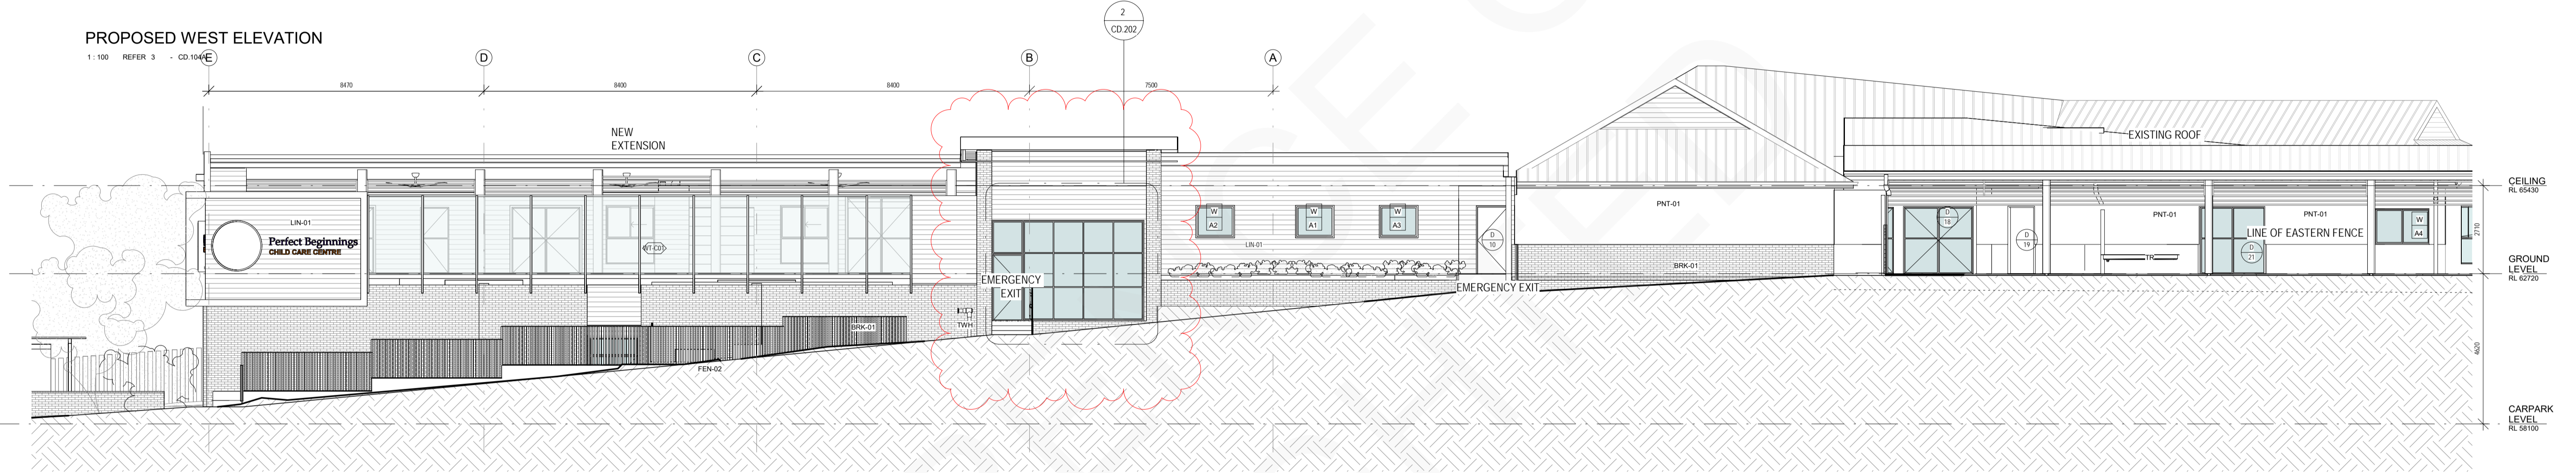


PROPOSED EAST ELEVATION

1:100 REFER 4 - CD.104A

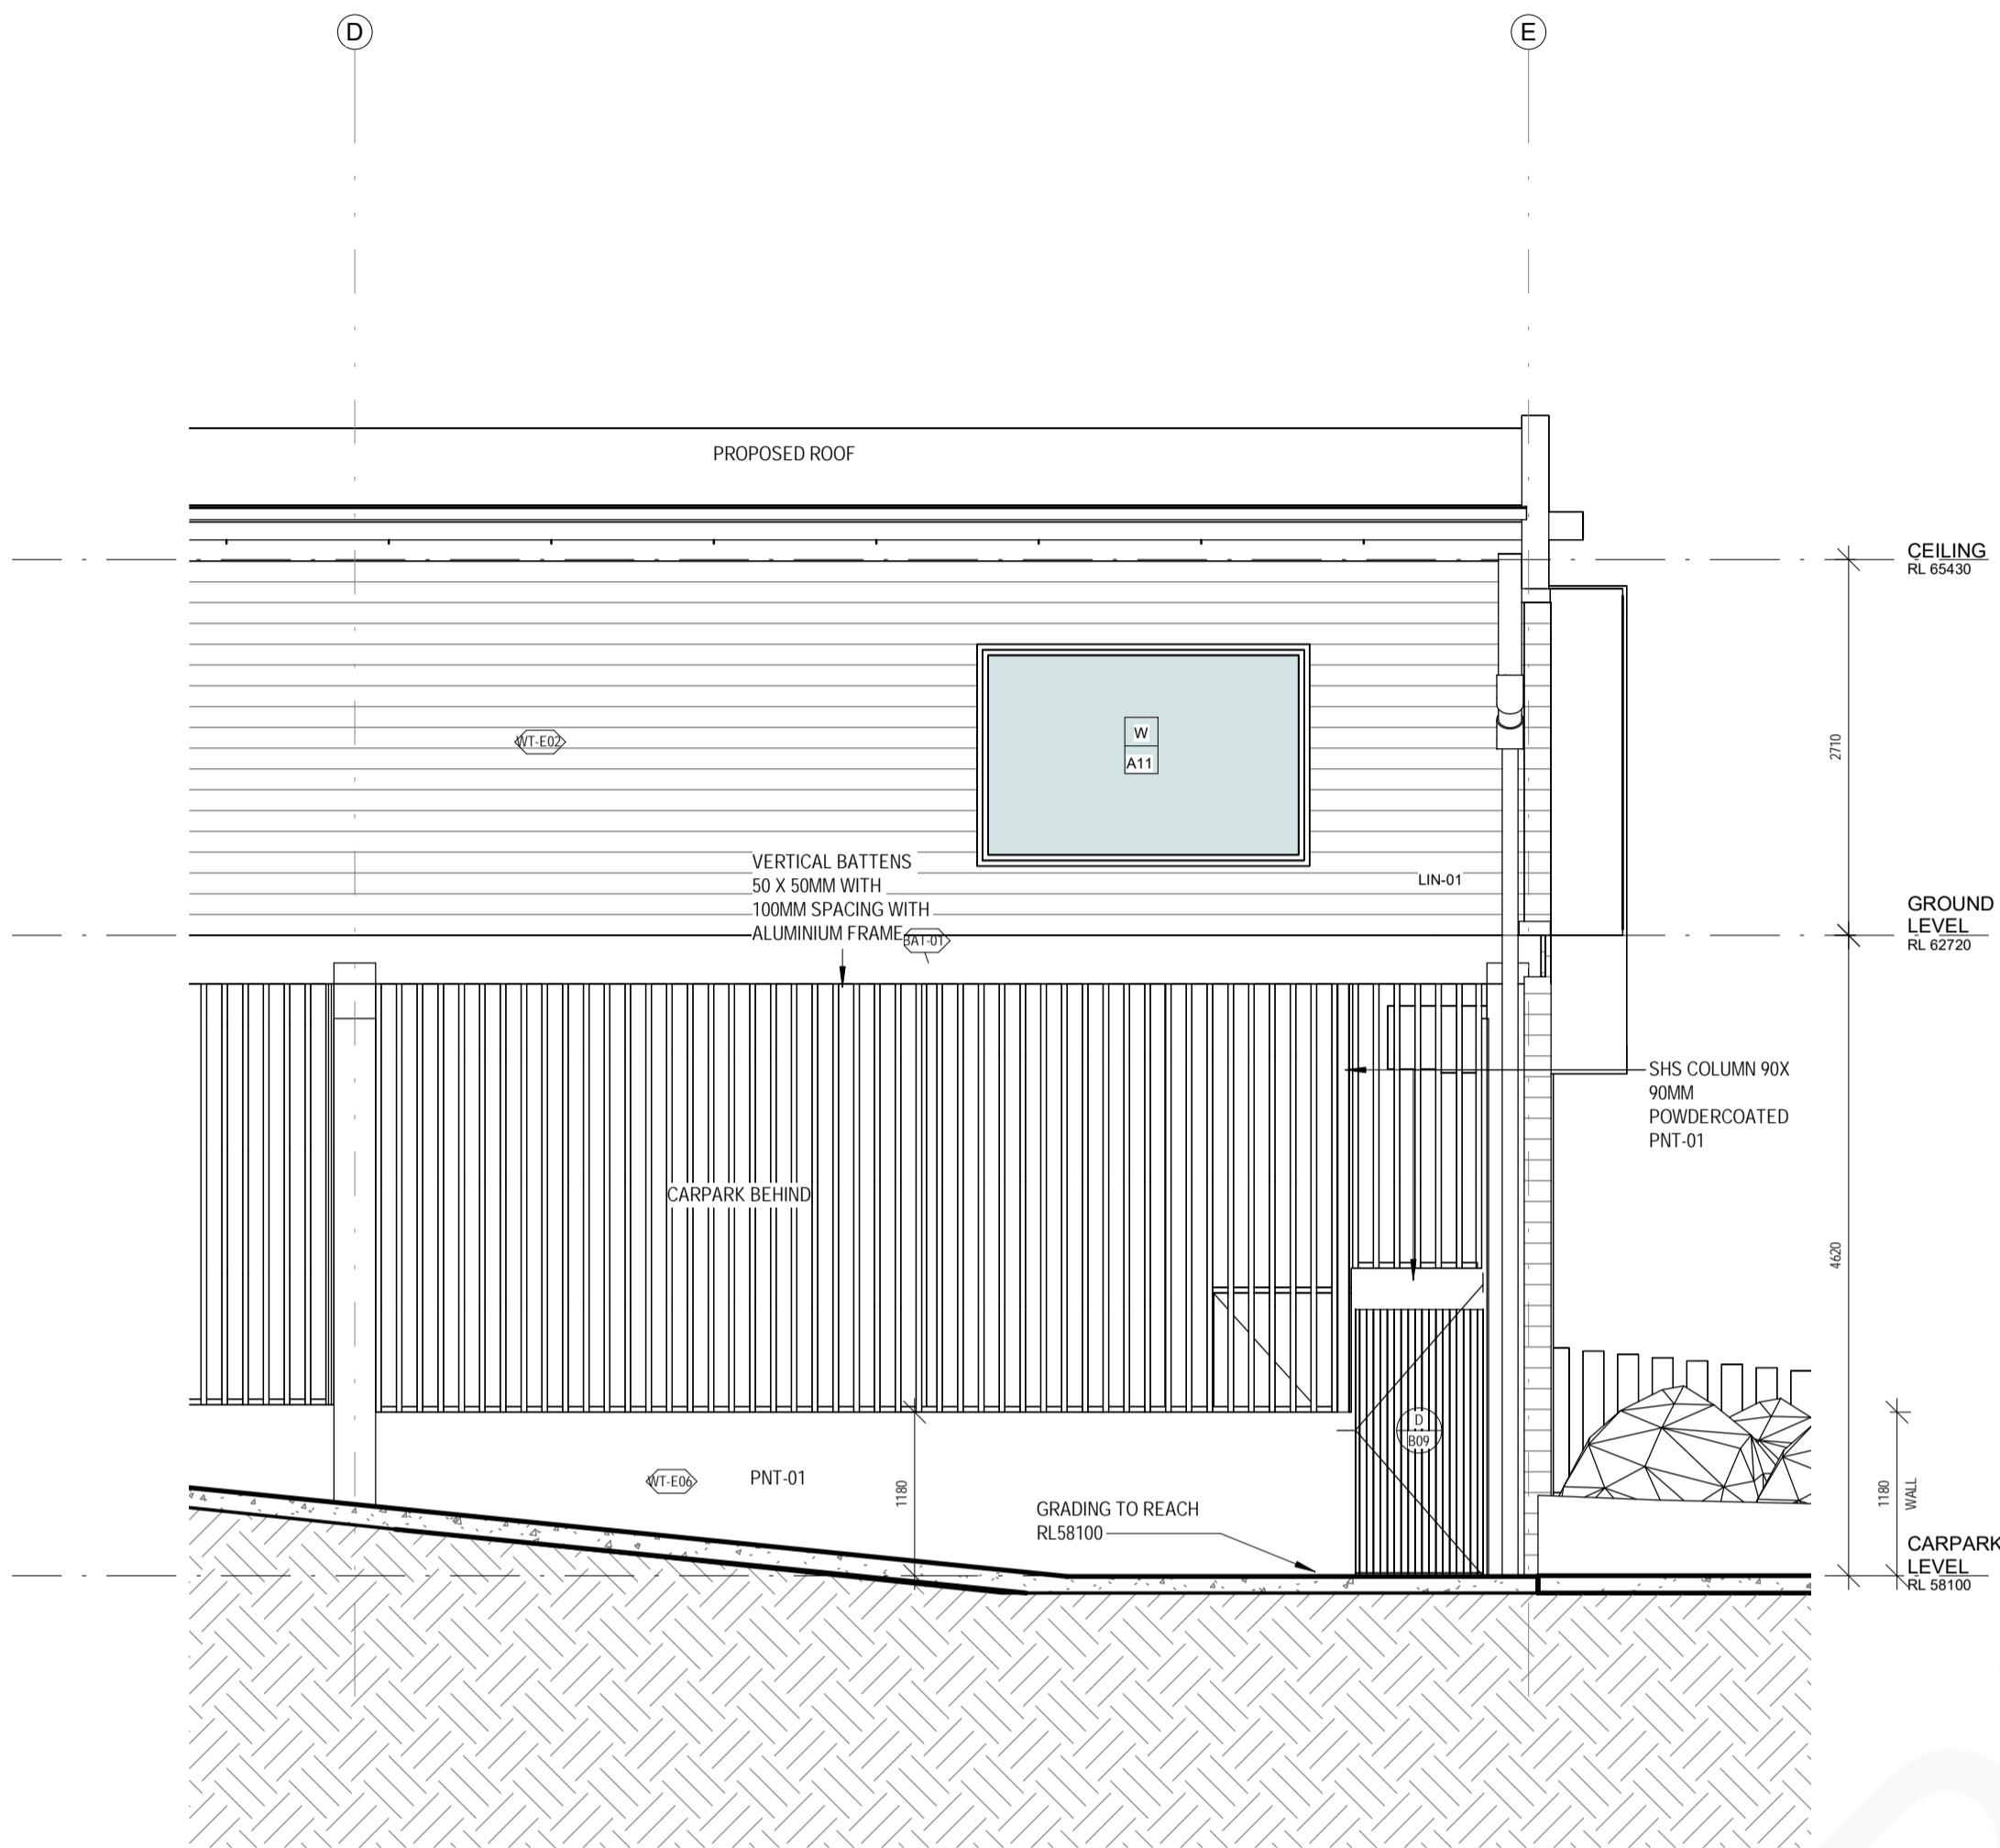

CARPARK ELEVATION
1: 50

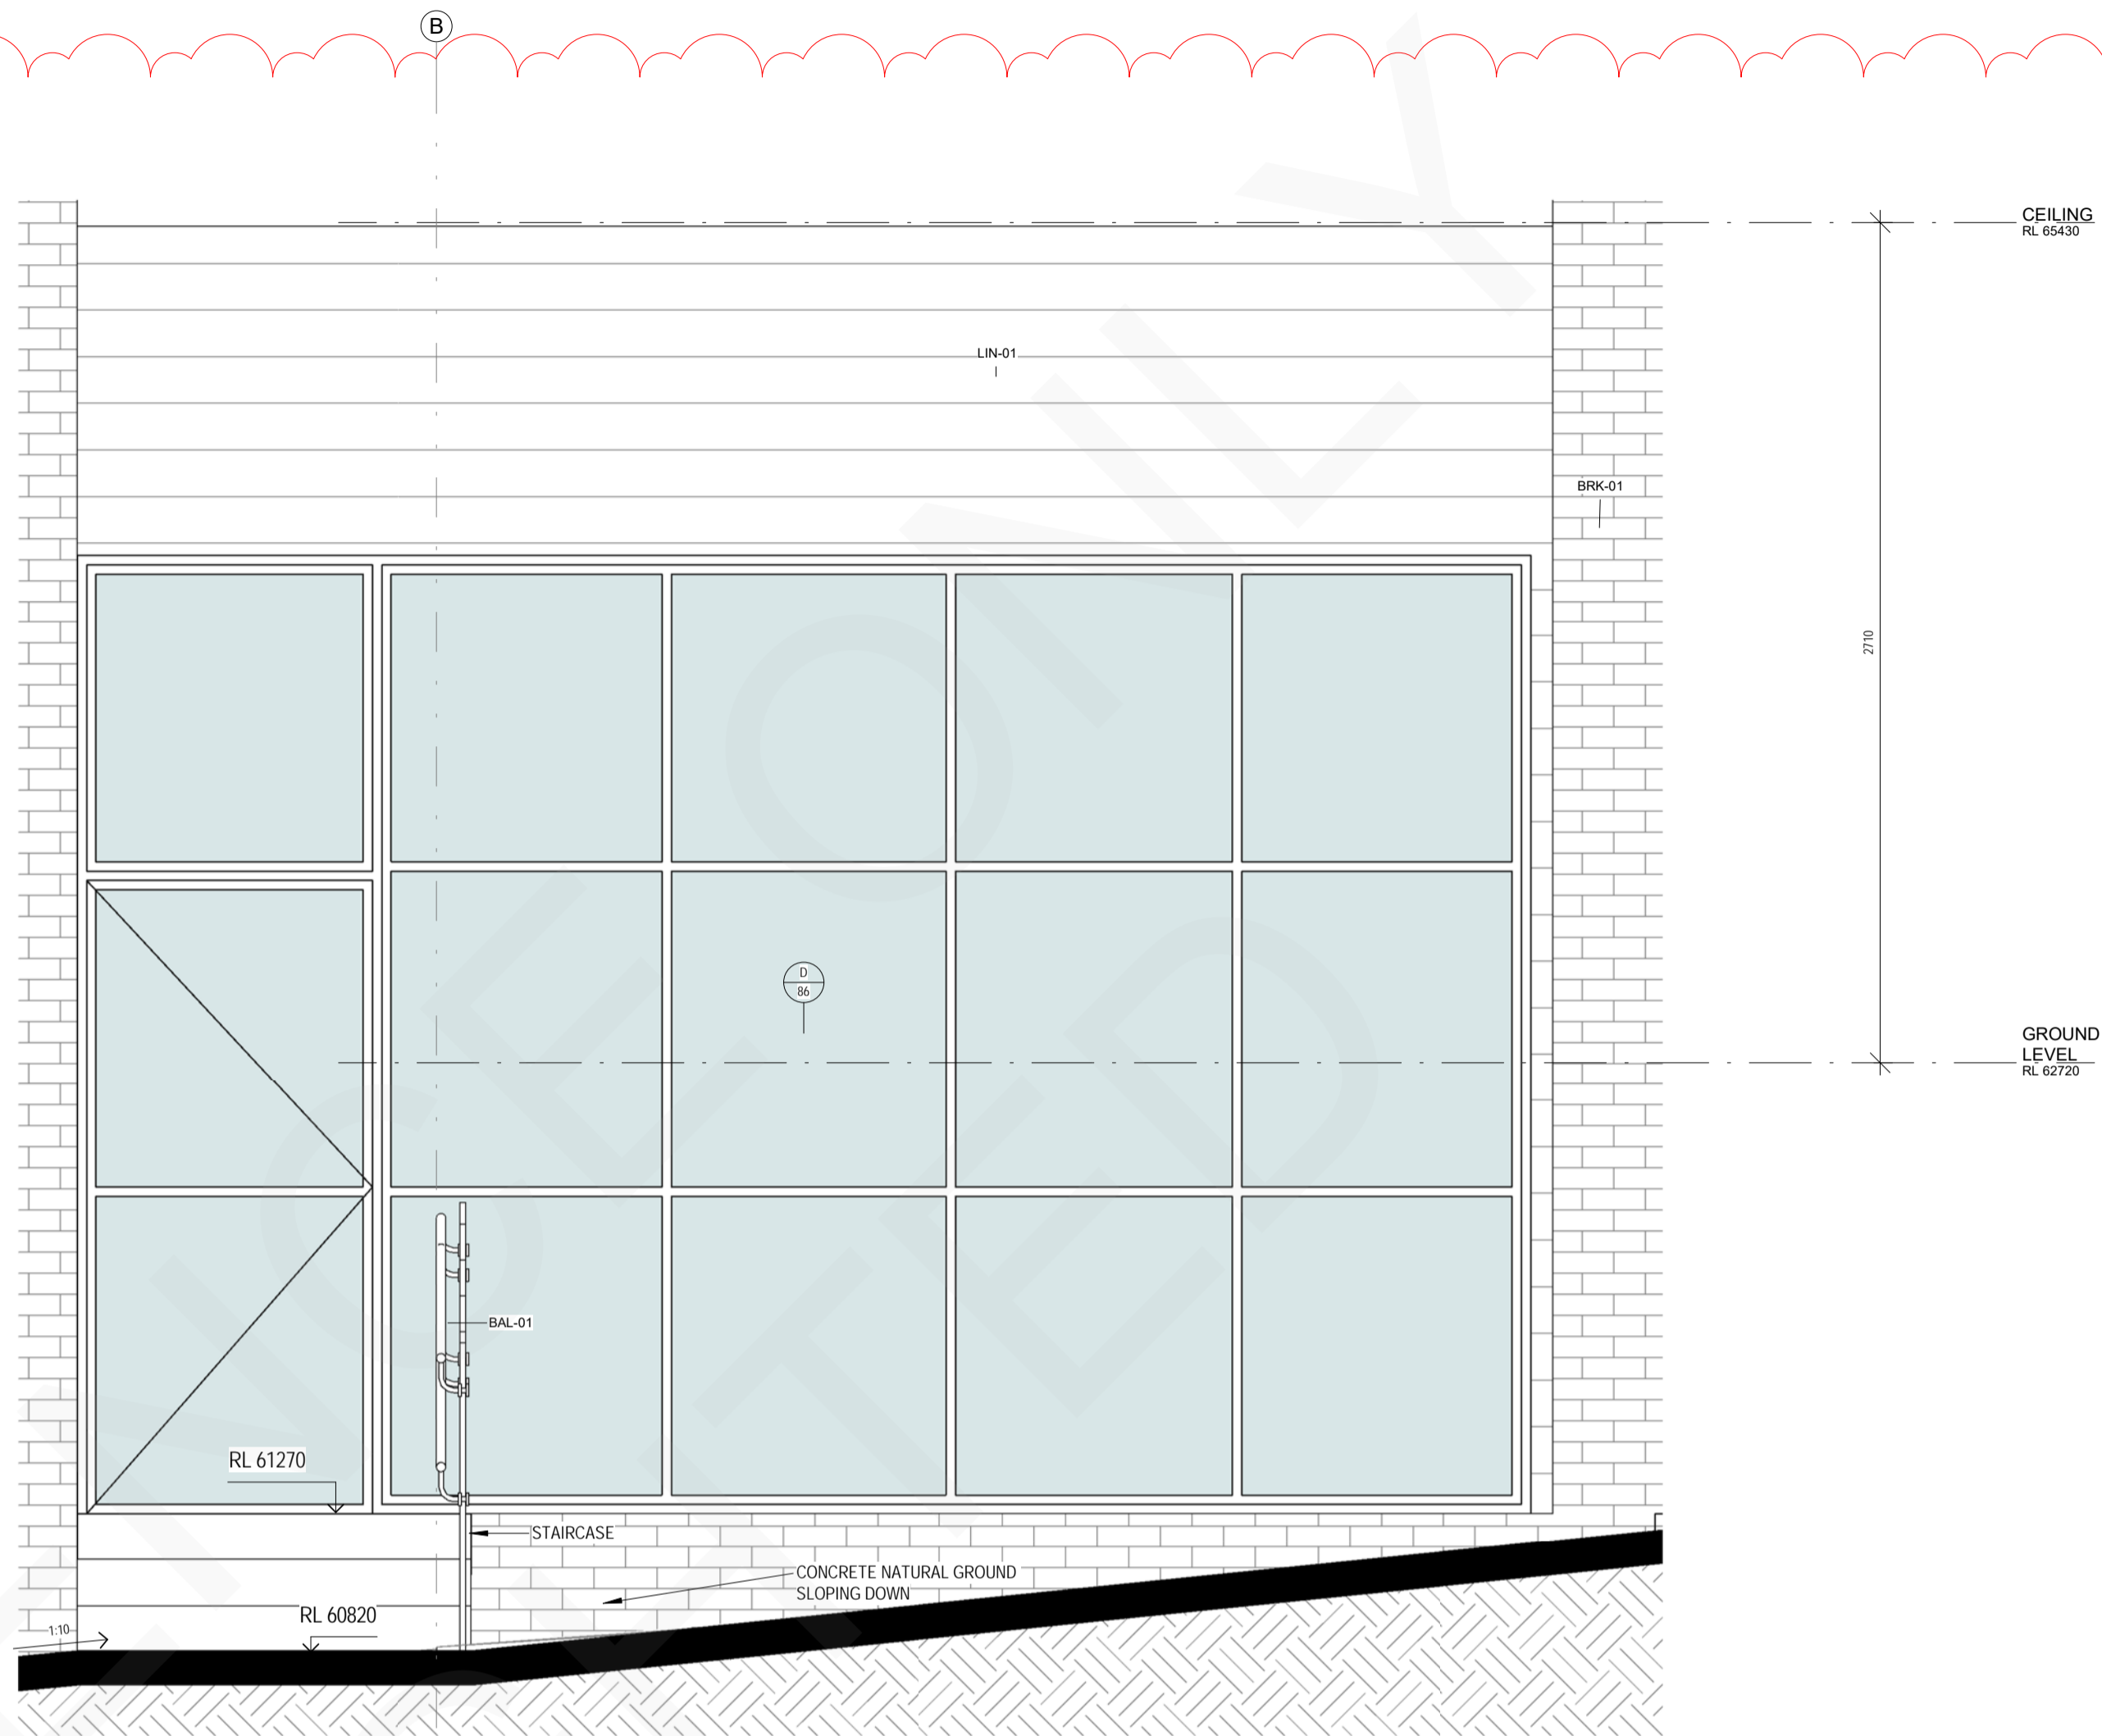

STAIRWAY CURTAIN WALL ELEVATION
1: 20 REFER 2 - CD.201

AG	AGRICULTURAL PIPE LINE
BAL-01	BALUSTRADE
BAL-02	BALUSTRADE
BAT-03	BAT-03
BD	BOLLARD
BG	BOX GUTTER
BRK-01	BRICK FACADE
BV	BRICK VENEER
COL	COLUMN
DP	DOWN PIPE
EG	EAVES GUTTER
FEN-02	FENCING
FEN-02/1	FENCING
FHR	FIRE HOSE REEL
FLR CON-1	CONCRETE FINISH
FWG	FLOOR WASTE GUTTER
GD	GRADED DRAIN SEWAGE GULLY
GR-01	GUARDRAIL 1200MM HIGH
GR-02	GUARDRAIL 1500MM HIGH
GR-03	GUARDRAIL 1800mm HIGH
INL	INTAKE LOUVER
J	JOINERY
LN-01	HORIZONTAL CLADDING
LO	LOCKER
MH	MANHOLE
OHF	OVERHEAD FLASHING
PLD	PLANTING DRAIN
PNT-01	PAINT EXTERIOR
PNT-03	PAINT EXTERIOR OVER CONCRETE
PNT-04	ROOF PAINT
RF501	METAL ROOF STRUCTURE
RF502	SOLARSPAN SANDWICH PANEL
RM	RECESSED ENTRY MAT
RP	REFRIGERANT PIPES
TGSI	TACTICLE INDICATORS TO AS 1428
TR	TROUGH
TS	TIMBERLOOK ALUMINIUM BATTEN SCREEN
TWH	TWIN HYDRANT
WL	WALL LIGHT ABOVE 1500MM FROM STAIR THREAD FFL
WS	WHEEL STOP





AG	AGRICULTURAL PIPE LINE
BAL-01	BALUSTRADE
BAL-02	BALUSTRADE
BAT-03	
BO	BOLLARD
BG	BOX GUTTER
BRI-01	BRICK FACADE
BV	BRICK VENEER
COL	COLUMN
DP	DOWN PIPE
EG	EAVES GUTTER
FEN-02	FENCING
FEN-02/1	
FIR	FIRE HOSE REEL
FLR CON-1	CONCRETE FINISH
FWR	FLOOR WASTE GUTTER
GD	GRADED DRAIN SEWAGE GULLY
GR-01	GUARDRAIL 1200MM HIGH
GR-02	GUARDRAIL 1500MM HIGH
GR-03	GUARDRAIL 1800mm HIGH
INL	INTAKE LOUVRE
J	JOINERY
LIN-01	HORIZONTAL CLADDING
LO	LOCKER
MI	MANHOLE
OR	OVERHEAD FLASHING
PLD	PLASTIC DRAIN
PNT-01	PAINT EXTERIOR
PNT-03	PAINT EXTERIOR OVER CONCRETE
PNT-04	ROOF PAINT
RF501	METAL ROOF STRUCTURE
RF502	SOLARPAN SANDWICH PANEL
RM	RECESSED ENTRY MAT
RP	REFRIGERANT PIPES
TGSI	TACTILE INDICATORS TO A123
TR	TROUGH
TS	TIMBERLOOK ALUMINUM BATTEN SCREEN
TW	TWIN HYDRANT
WLH	WALL LIGHT ABOVE 1500MM FROM STAIR
WF	THREADED FFL
WS	WHEEL STOP

KEY LEGEND

AG	AGRICULTURAL PIPE LINE
BAL-01	BALUSTRADE
BAL-02	BALUSTRADE
BAT-03	BOLLARD
BD	BOX GUTTER
BG	BRICK FACADE
BRK-01	BRICK VENEER
BV	COLUMN
COL	DOWN PIPE
DP	EAVES GUTTER
EG	FENCING
FEN-02	FIRE HOSE REEL
FEN-02/1	CONCRETE FINISH
FHR	FLOOR WASTE
FLR CON-1	GUTTER
FWG	GRATED DRAIN
GD	SEWAGE GULLY
GR-01	GUARDRAIL 1200MM HIGH
GR-02	GUARDRAIL 1500MM HIGH
GR-03	GUARDRAIL 1800mm HIGH















KEY LEGEND

INL	INTAKE LOUVRE
J	JOINERY
LIN-01	HORIZONTAL CLADDING
LO	LOCKER
MH	MANHOLE
OHF	OVERHEAD FLASHING
PLD	PLANTING DRAIN
PNT-01	PAINT EXTERIOR
PNT-03	PAINT EXTERIOR OVER CONCRETE
PNT-04	ROOF PAINT
RFS01	METAL ROOF STRUCTURE
RFS02	SOLARSPAN SANDWICH PANEL
RM	RECESSED ENTRY MAT
RP	REFRIGERANT PIPES
TGSI	TACTICLE INDICATORS TO AS 1428
TR	TROUGH
TS	TIMBERLOOK ALUMINIUM BATTEN SCREEN
TWH	TWIN HYDRANT
WL	WALL LIGHT ABOVE 1500MM FROM STAIR THREAD FFL
WS	WHEEL STOP

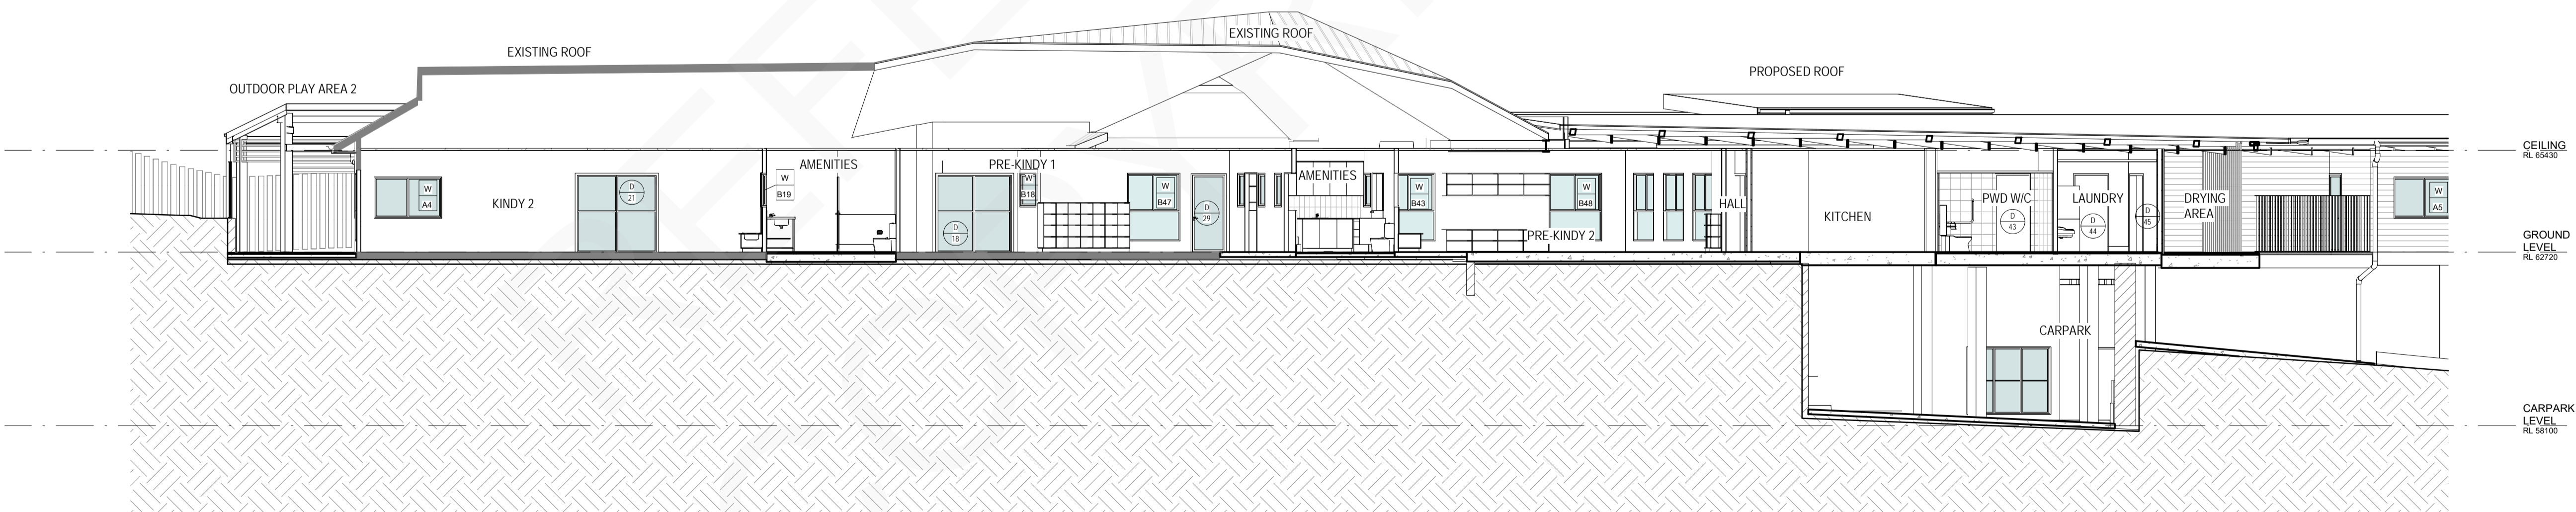
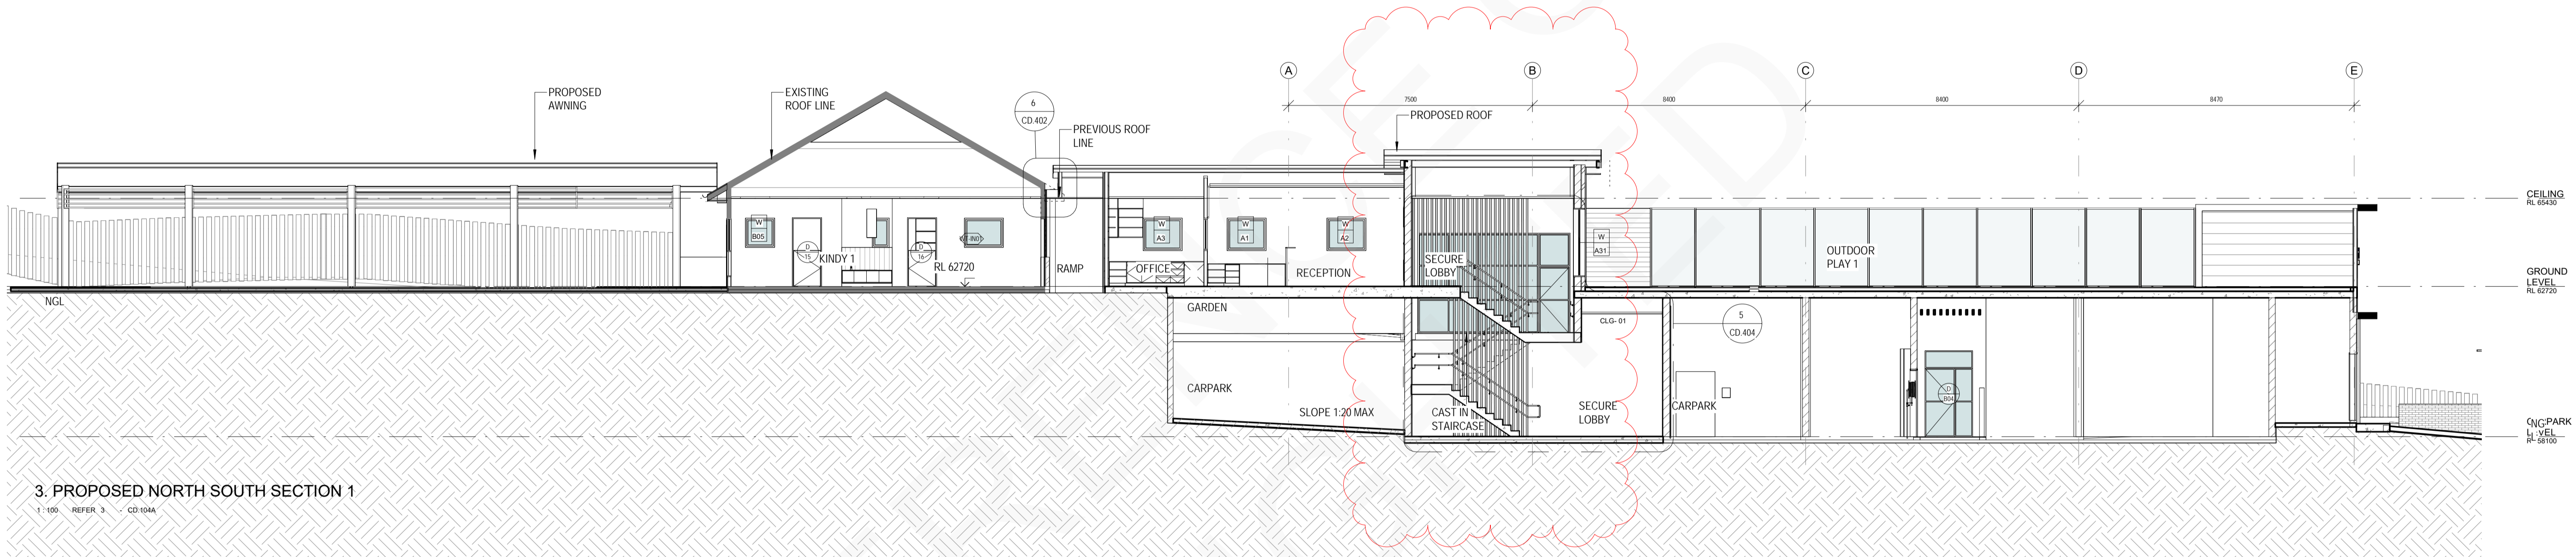


EXTERNAL WALL LEGEND

NOTE:
1. USE 13MM MR PLASTERBOARD FOR WET AREAS
2. ALL EXTERNAL WALLS TO BE NON COMBUSTABLE IN COMPLIANCE WITH AS 1530.1

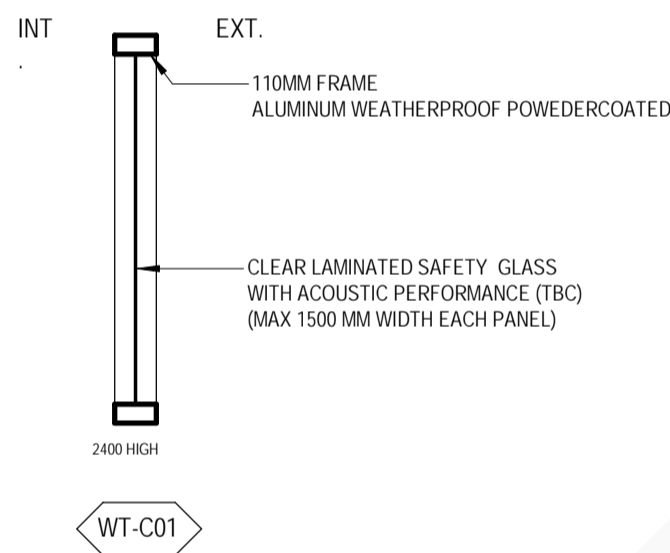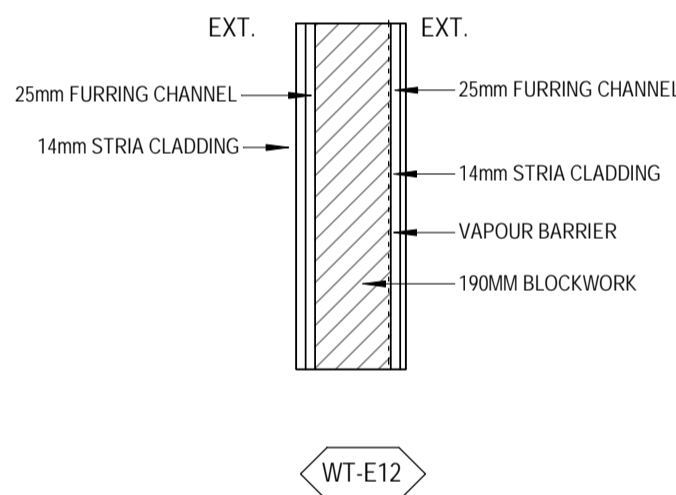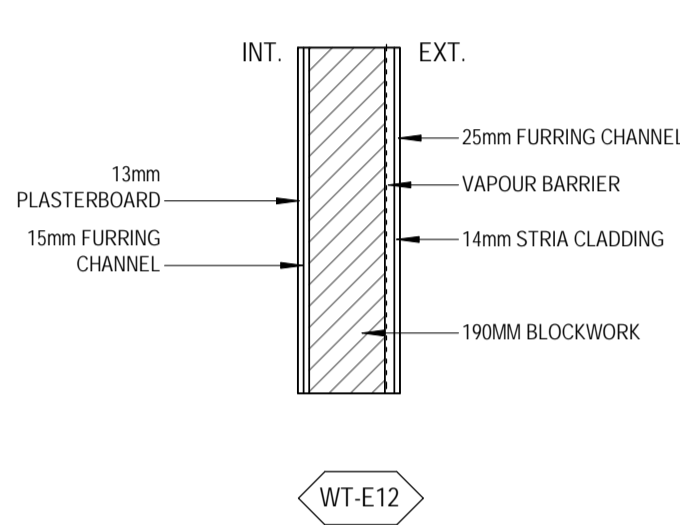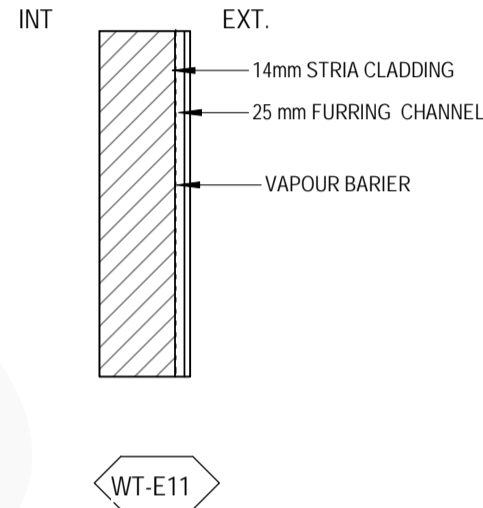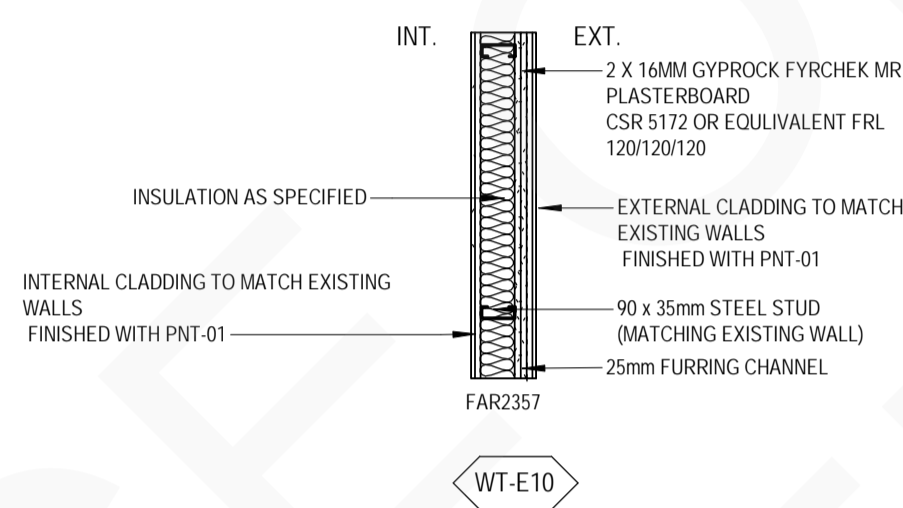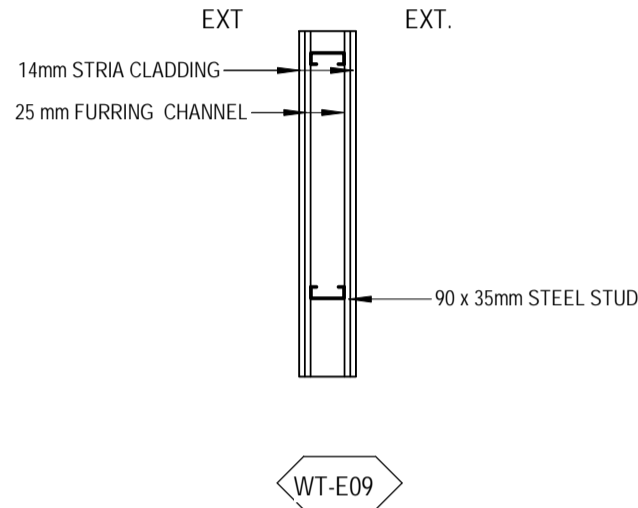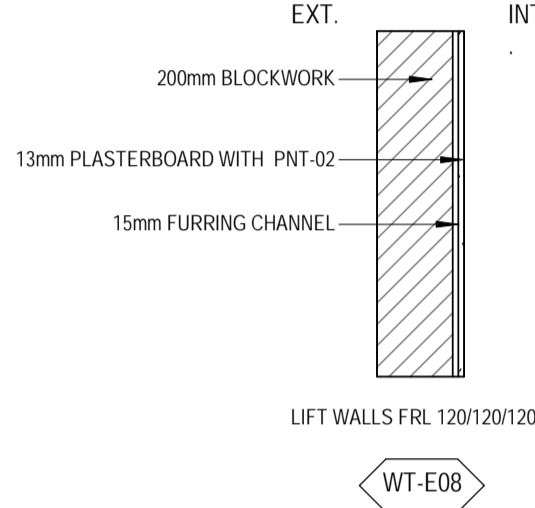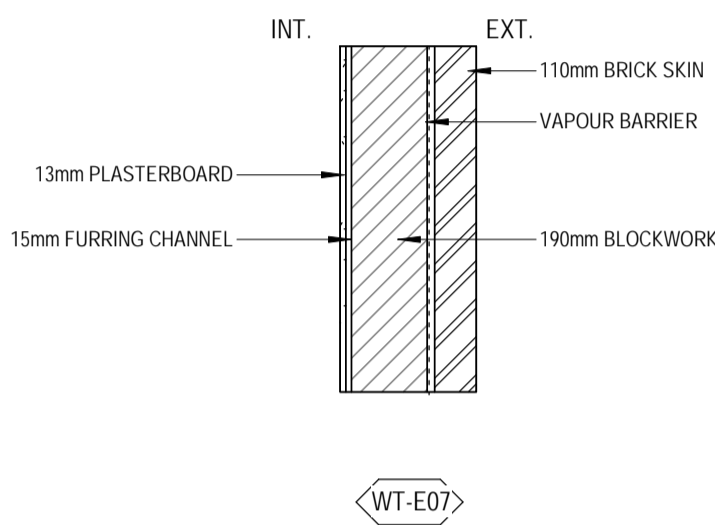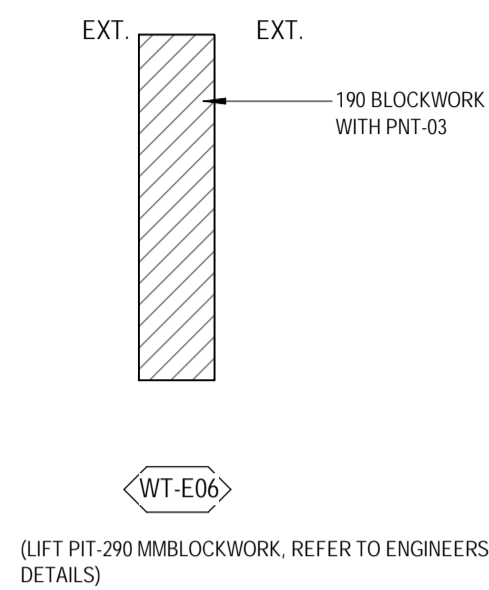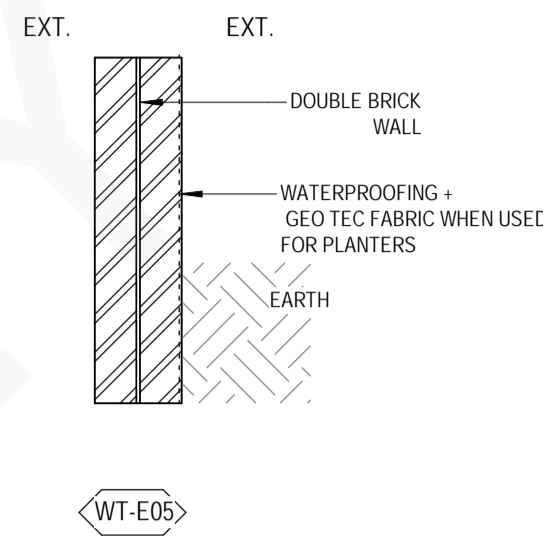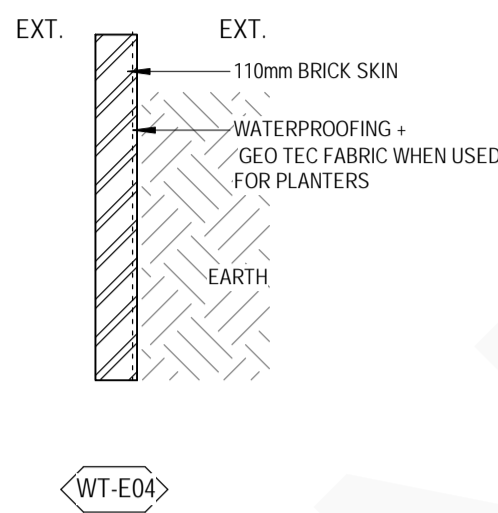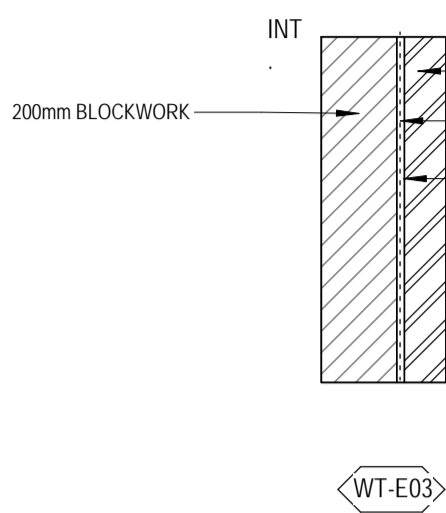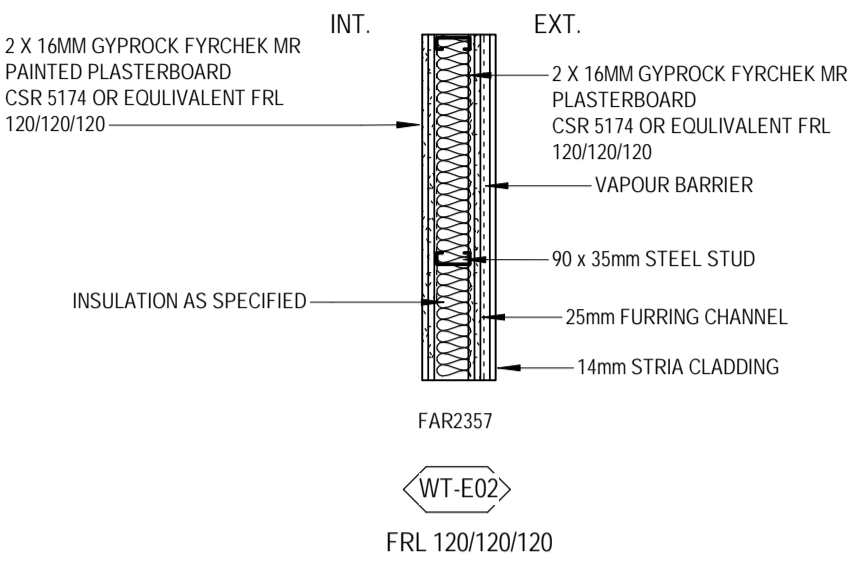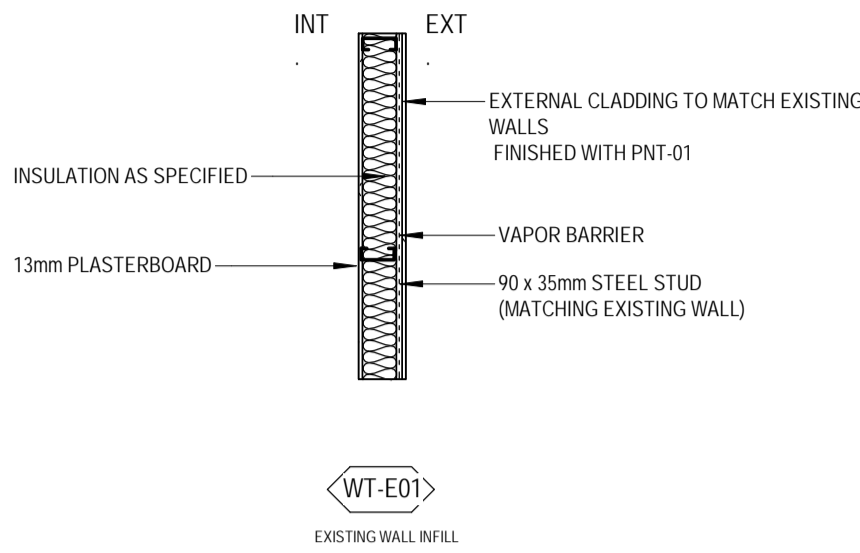


LININGS LEGEND

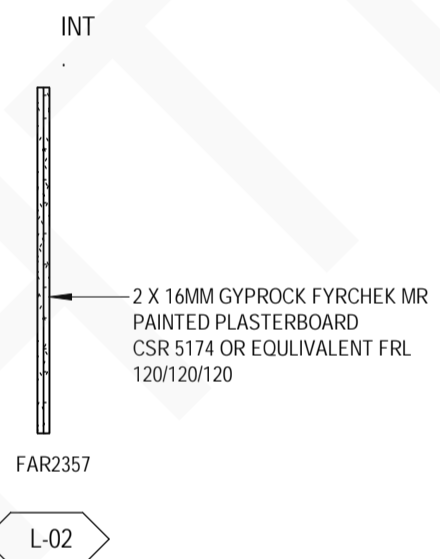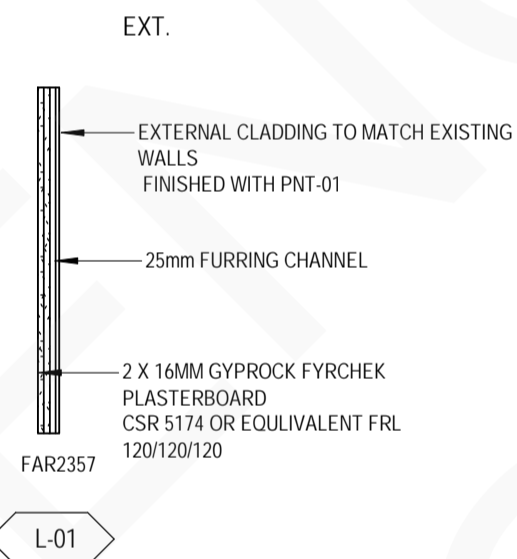


NOTE: EXTERNAL LINING ON EXISTING WALL AND INFILLS

NOTE: INTERNAL LINING ON EXISTING WALL AND INFILLS

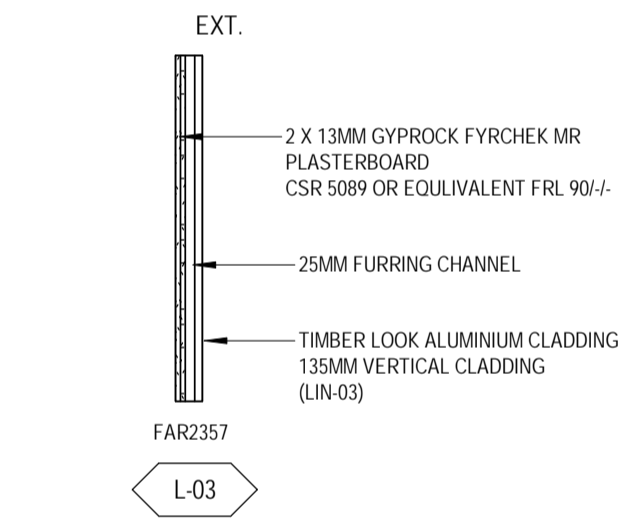





EXTERNAL LINING ON EXPOSED COLUMNS

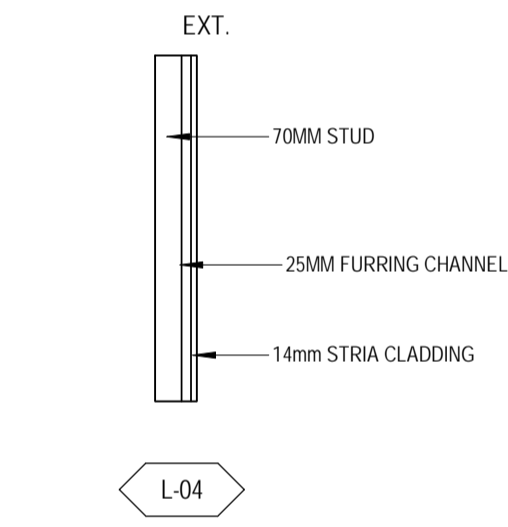




EXTERNAL LINING AROUND DOWNPIPES


INTERNAL WALL LEGEND

NOTE: USE 13MM MR PLASTERBOARD FOR WET AREAS

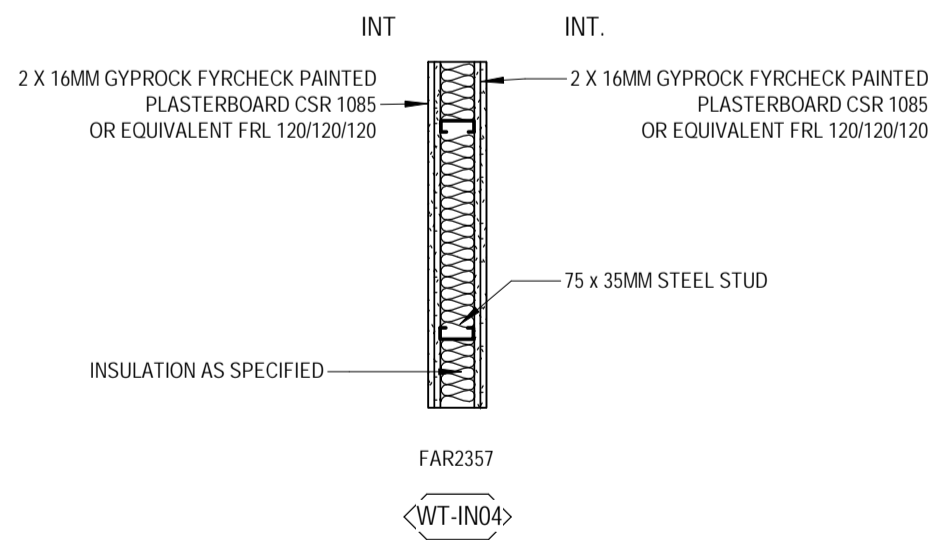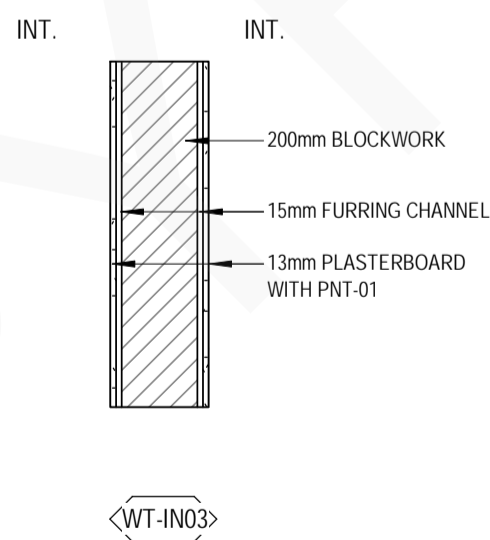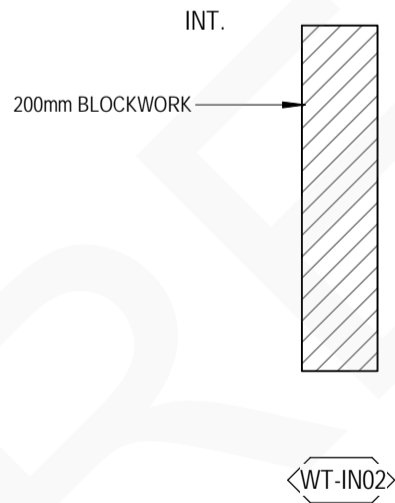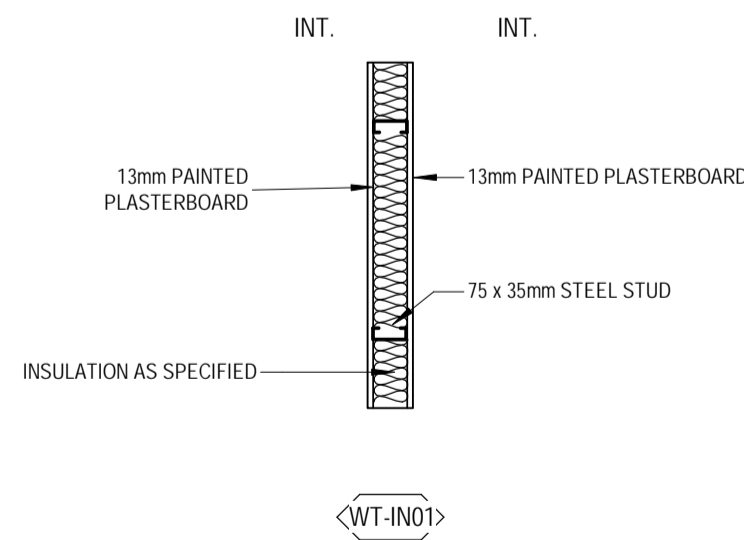


SCREEN LEGEND

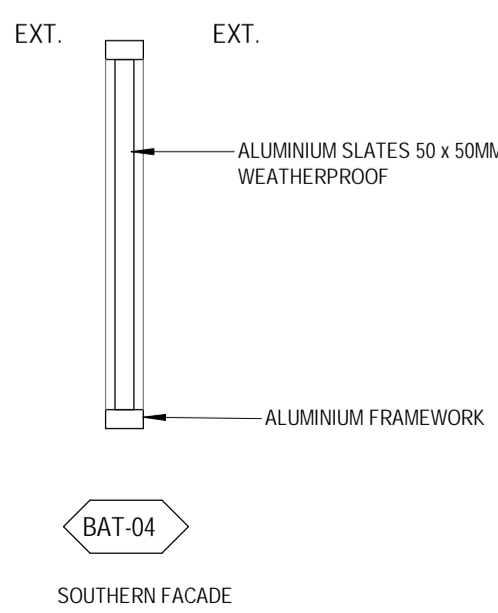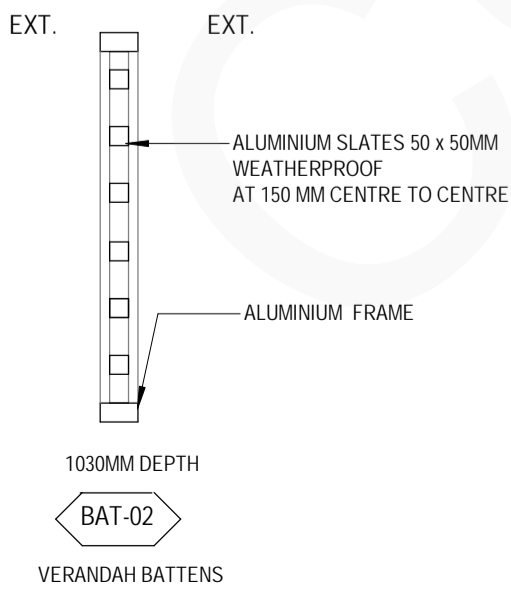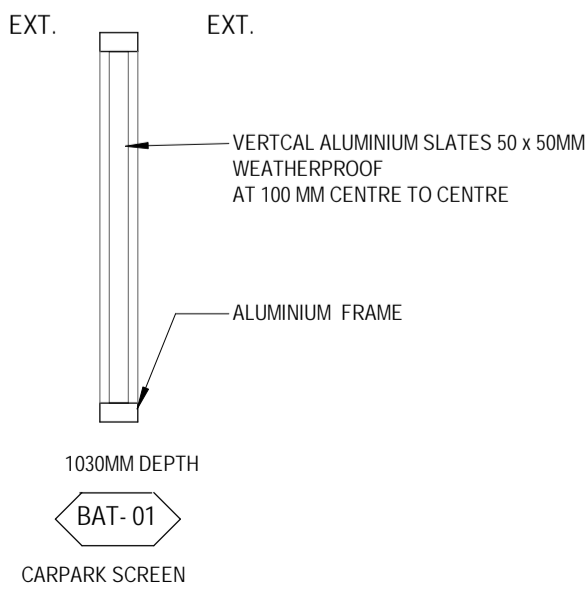

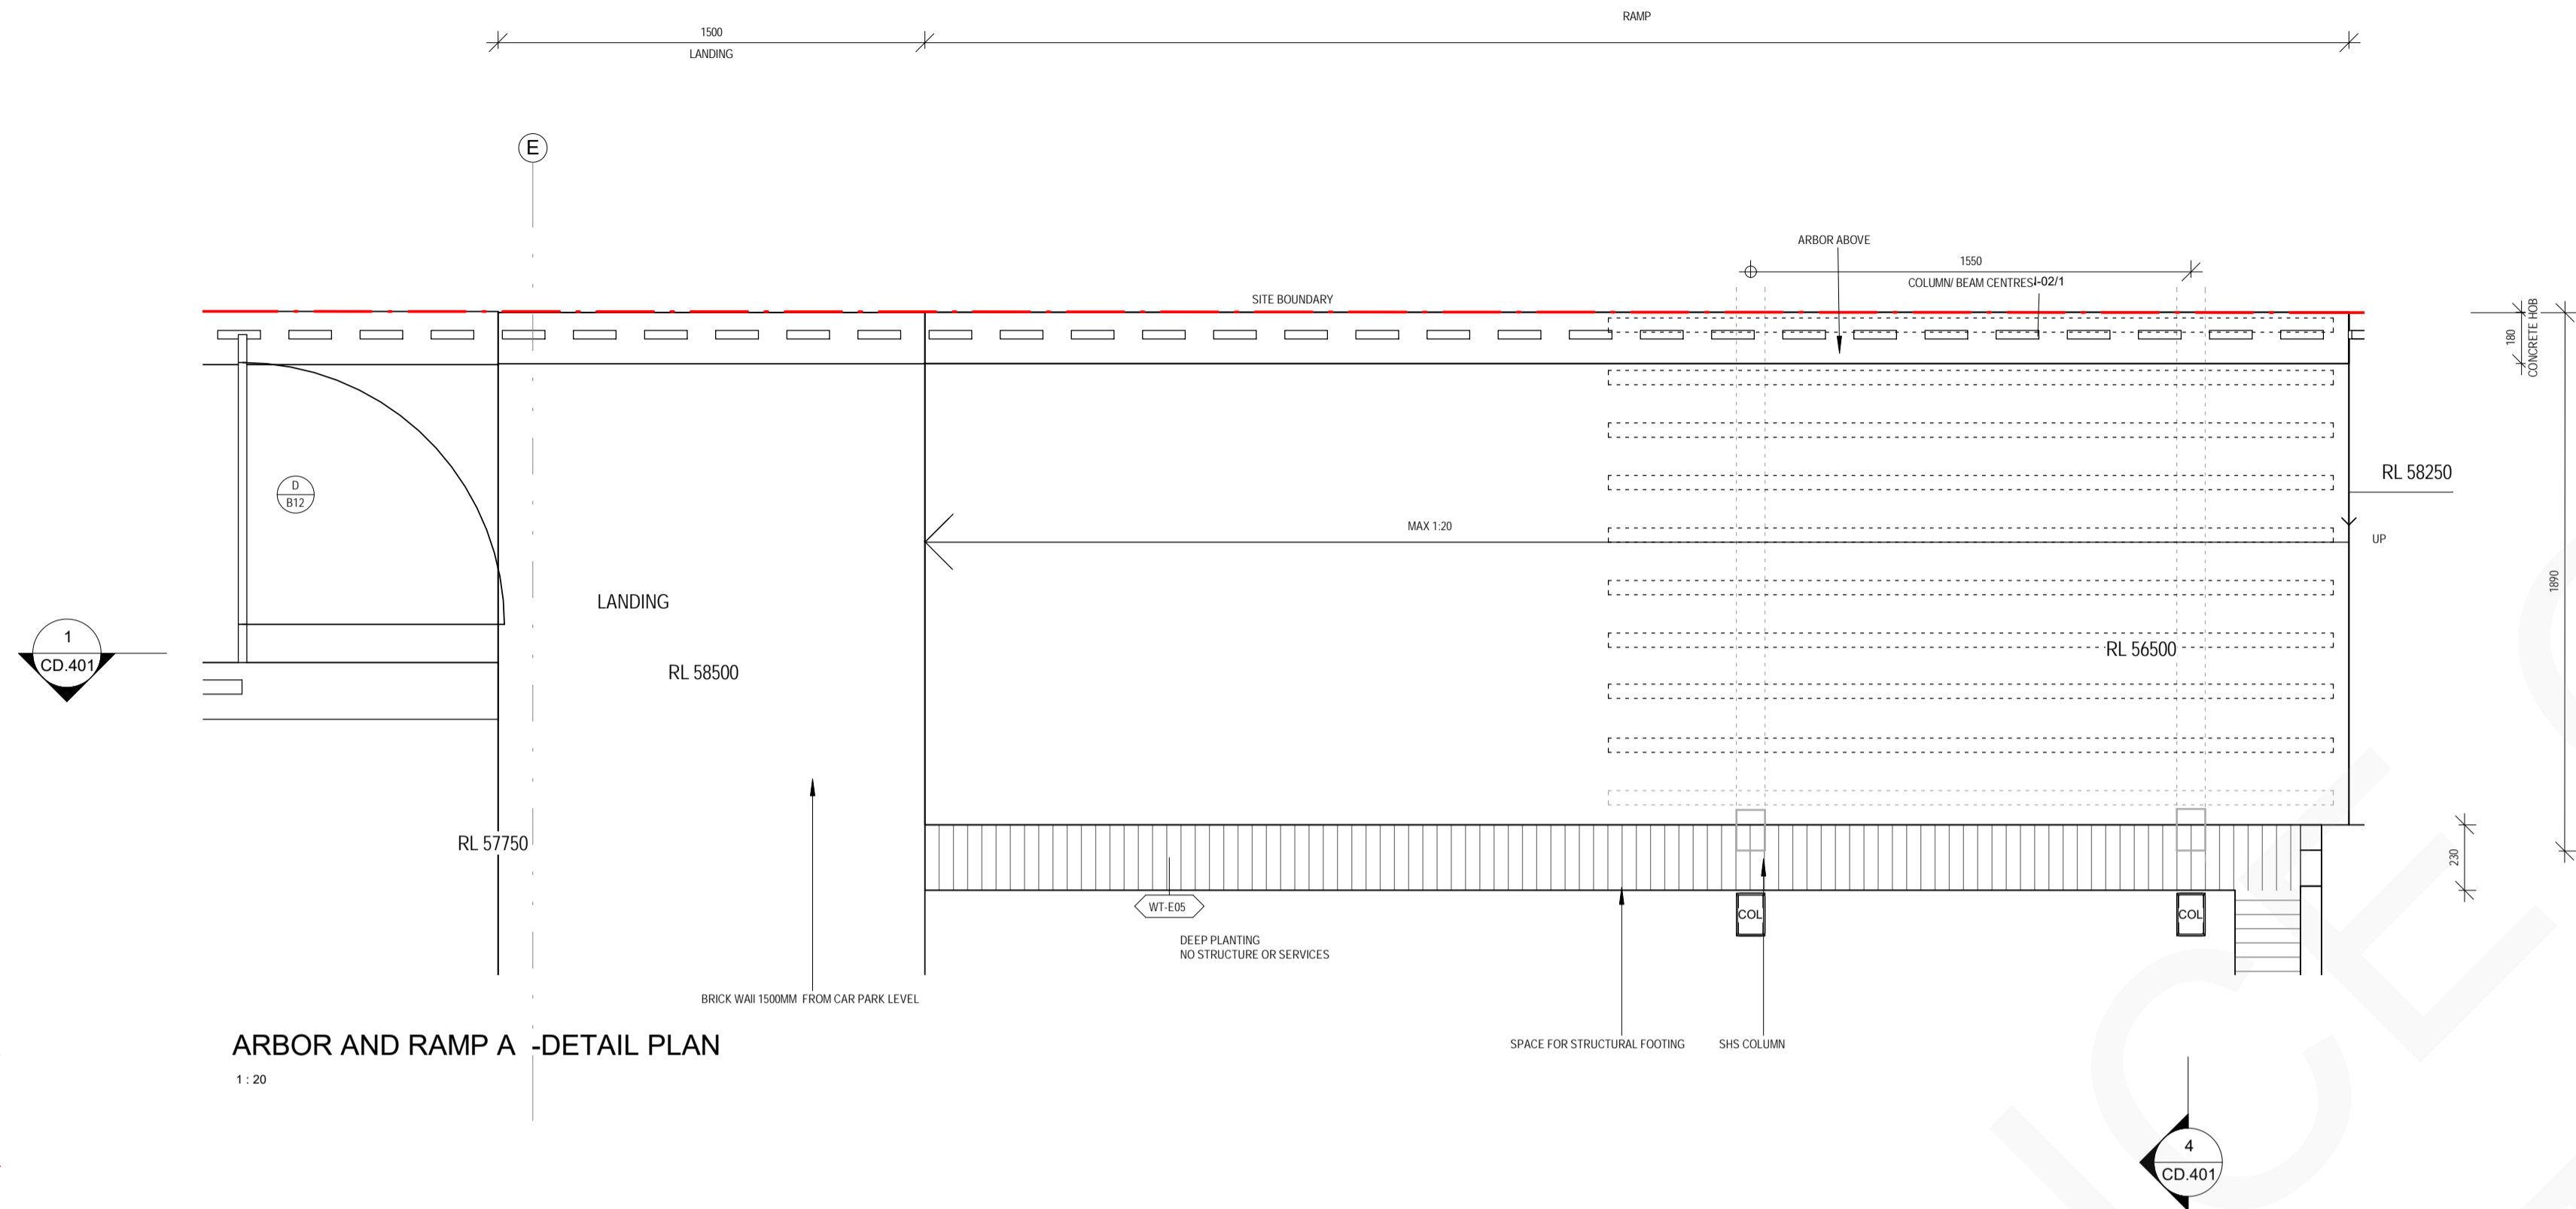


ARBOR AND RAMP A -DETAIL PLAN

1: 20

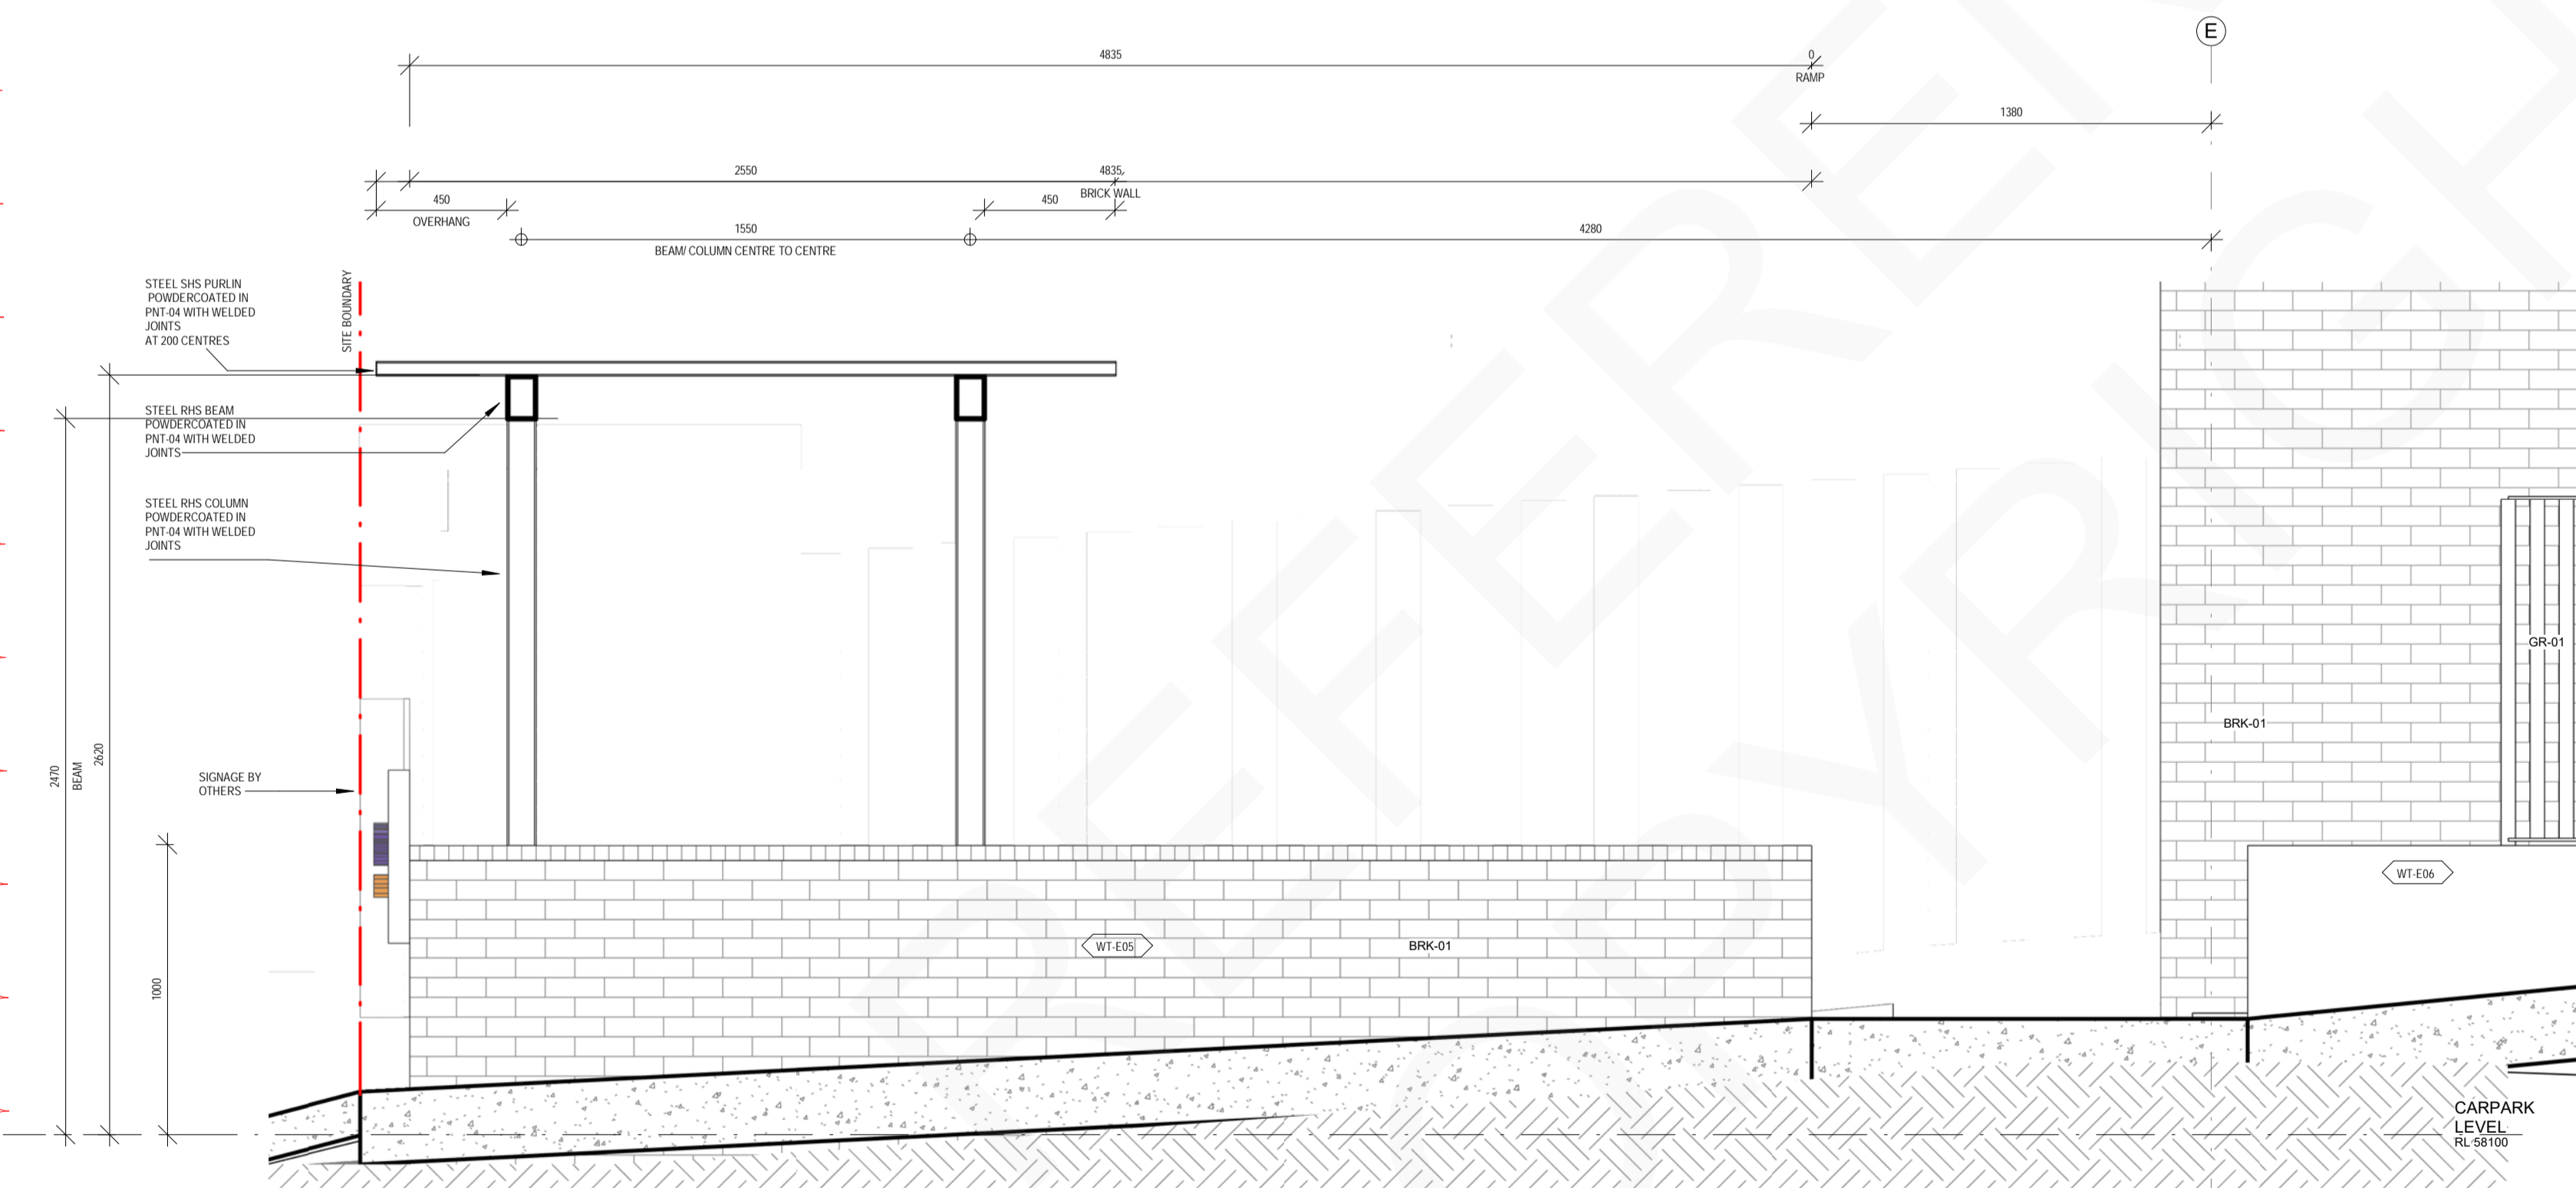


PROPOSED SECTION - ENTRANCE ARBOR

1: 20 REFER 1 - CD.401

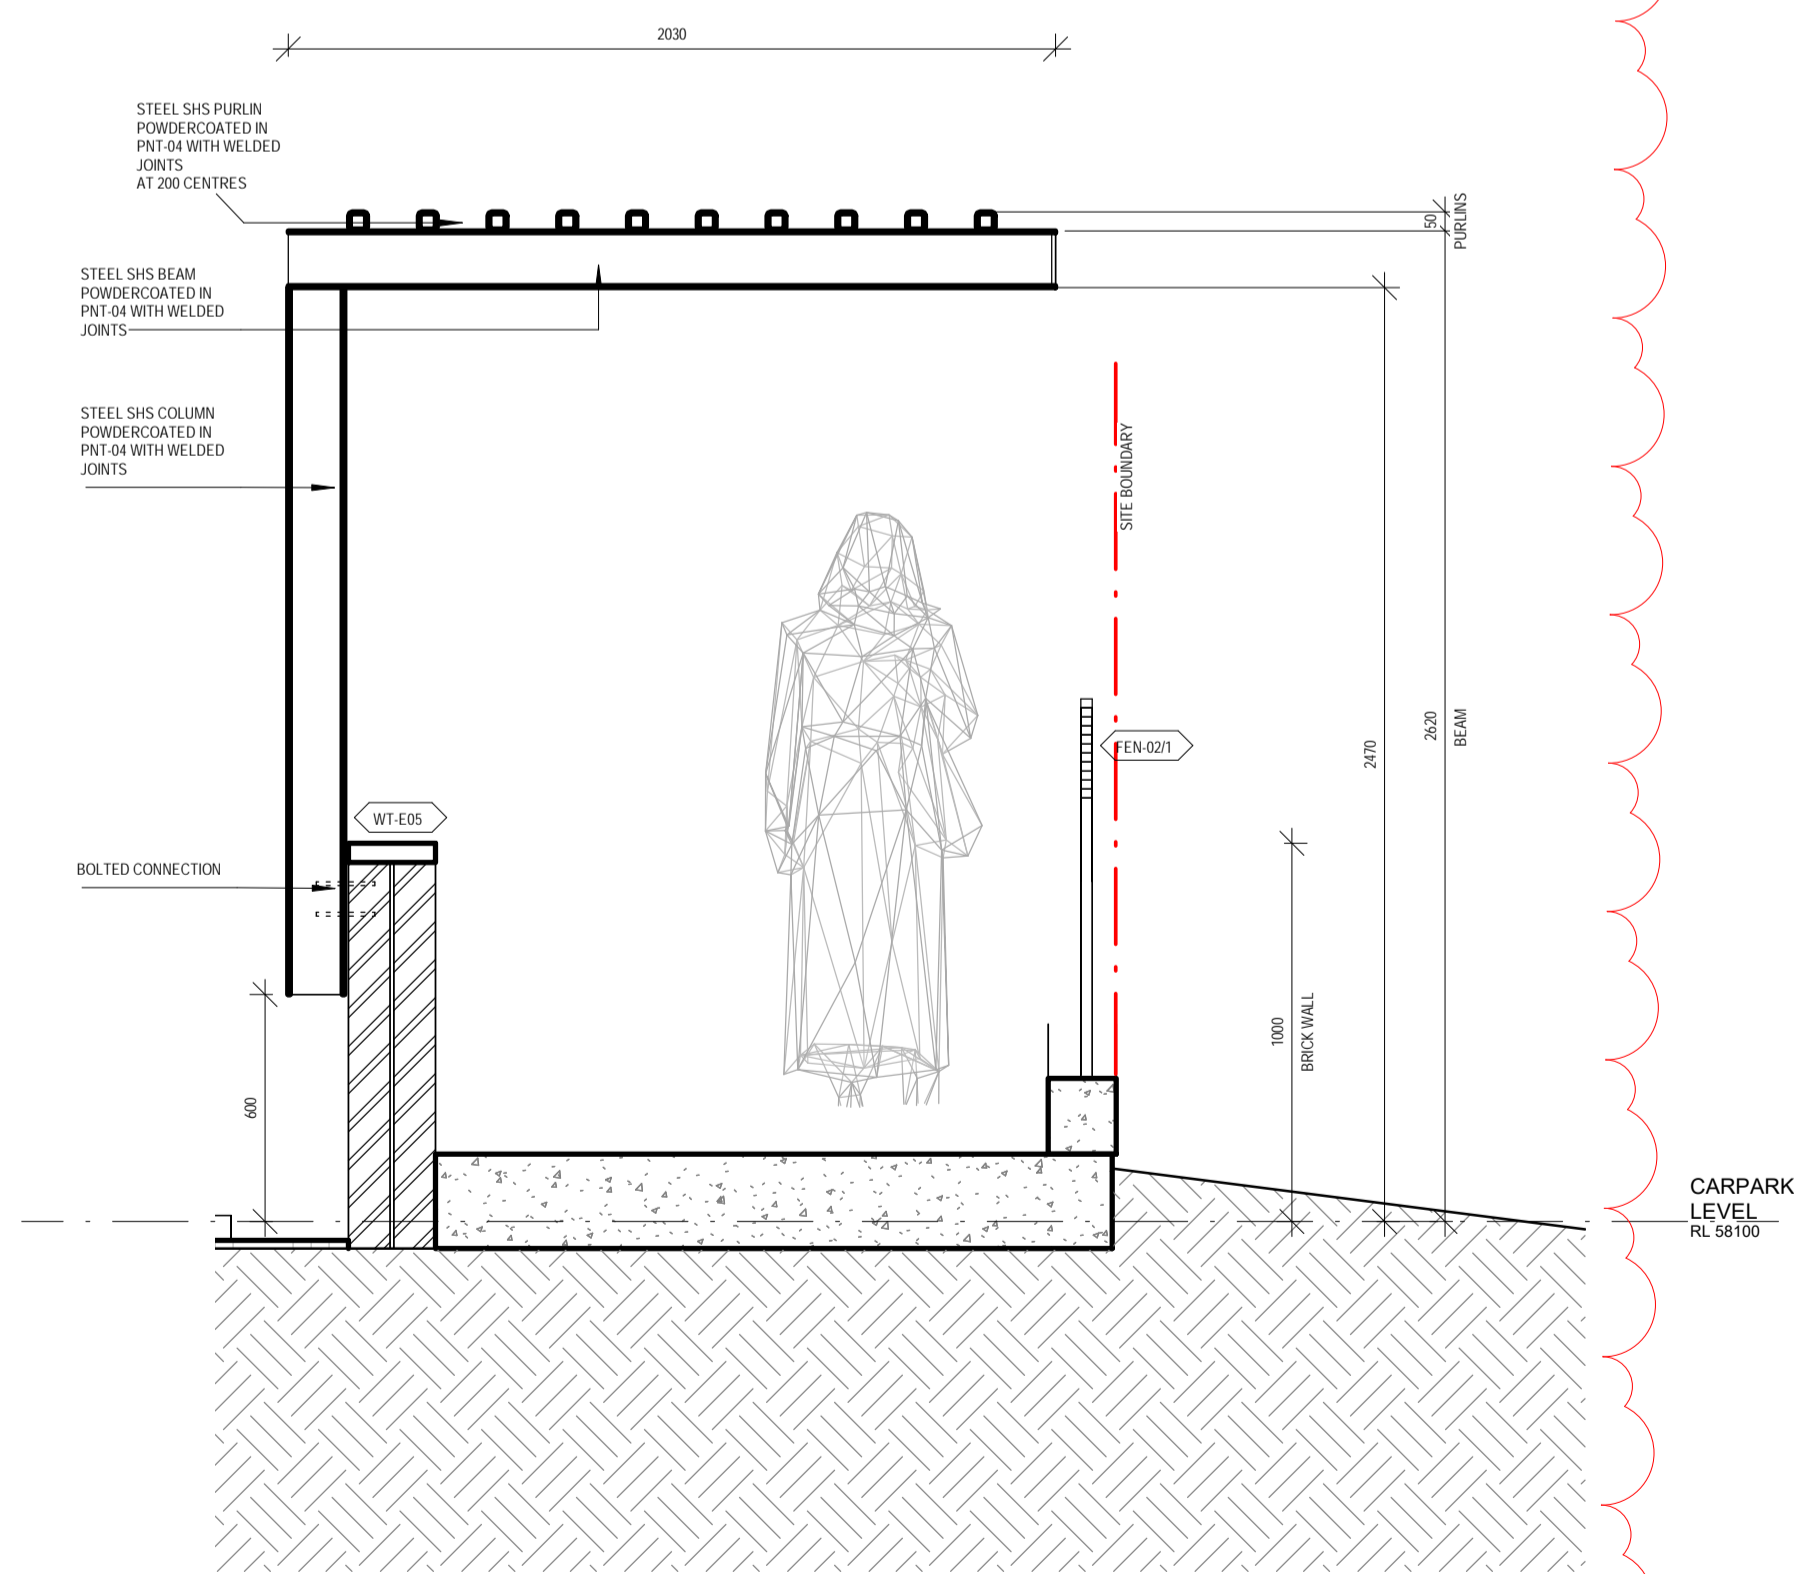


RAMP AND ARBOR- DETAIL SECTION

1: 20 REFER 4 - CD.401

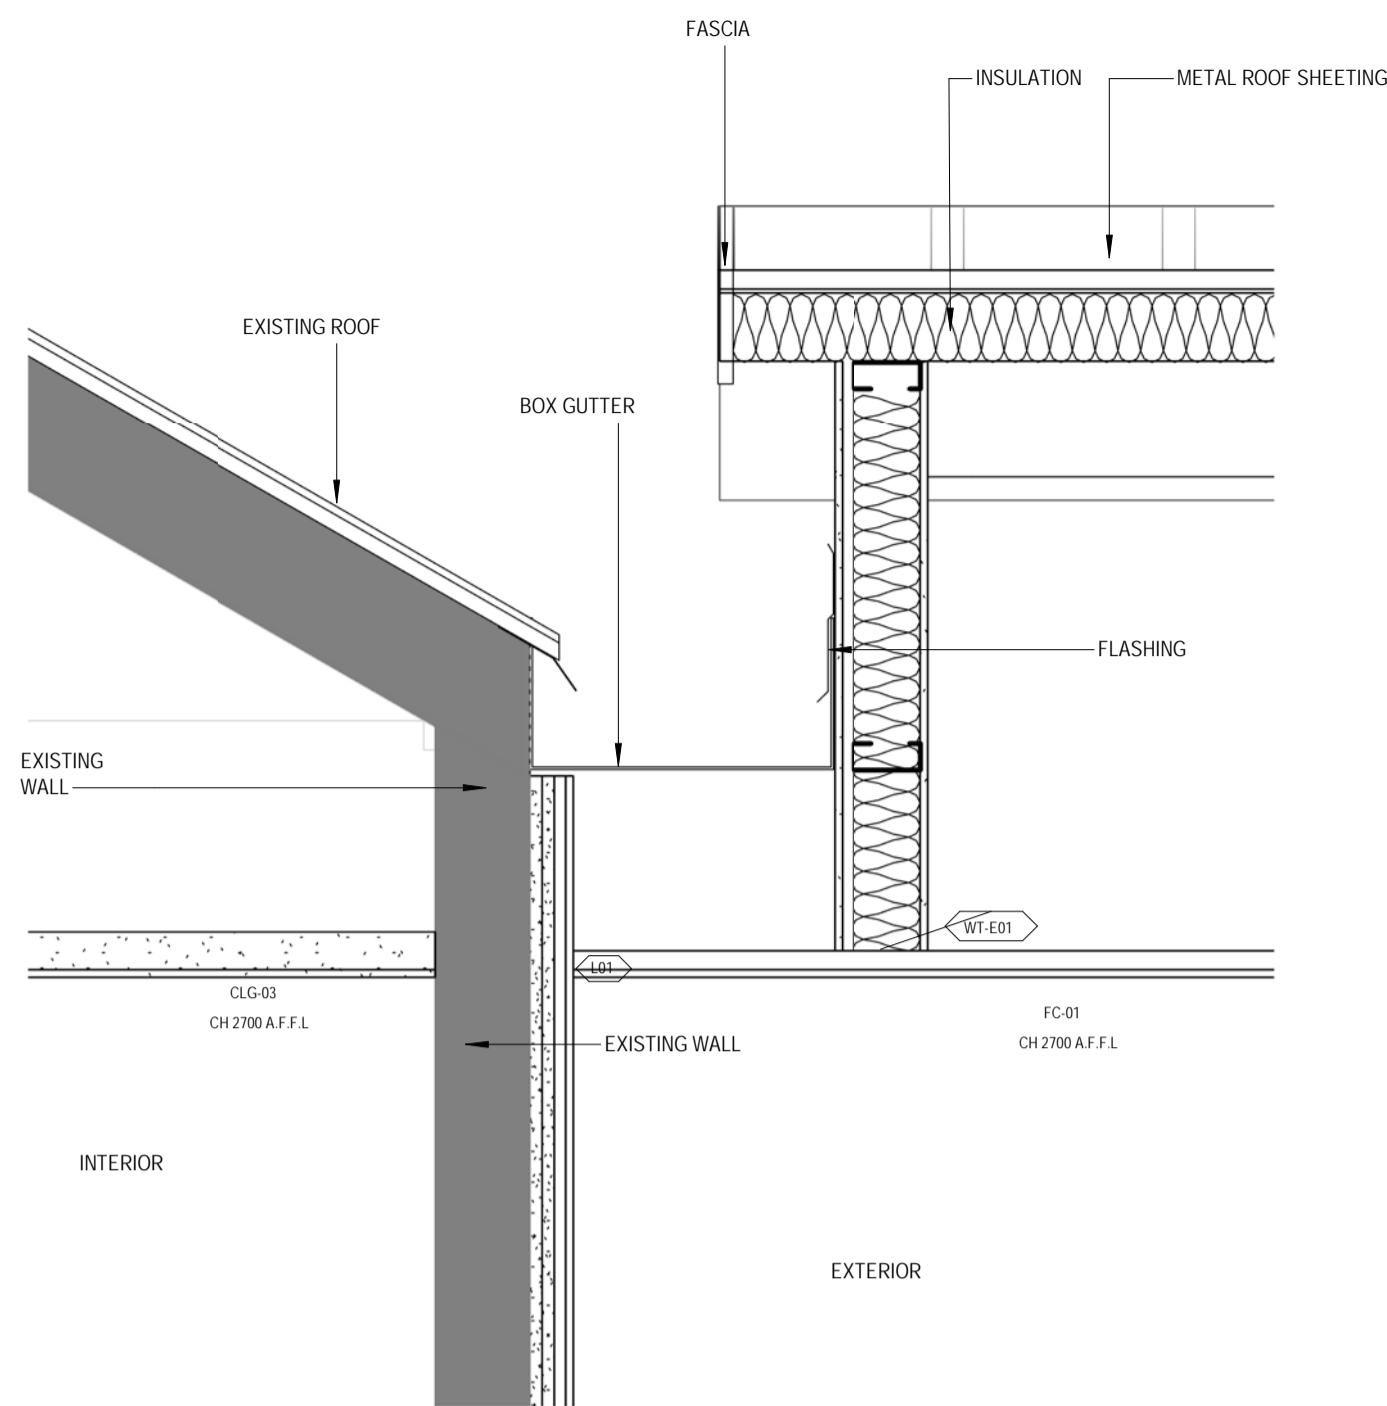


EXISTING AND NEW ROOF DETAIL 01

1:10 REFER 6 - CD-301

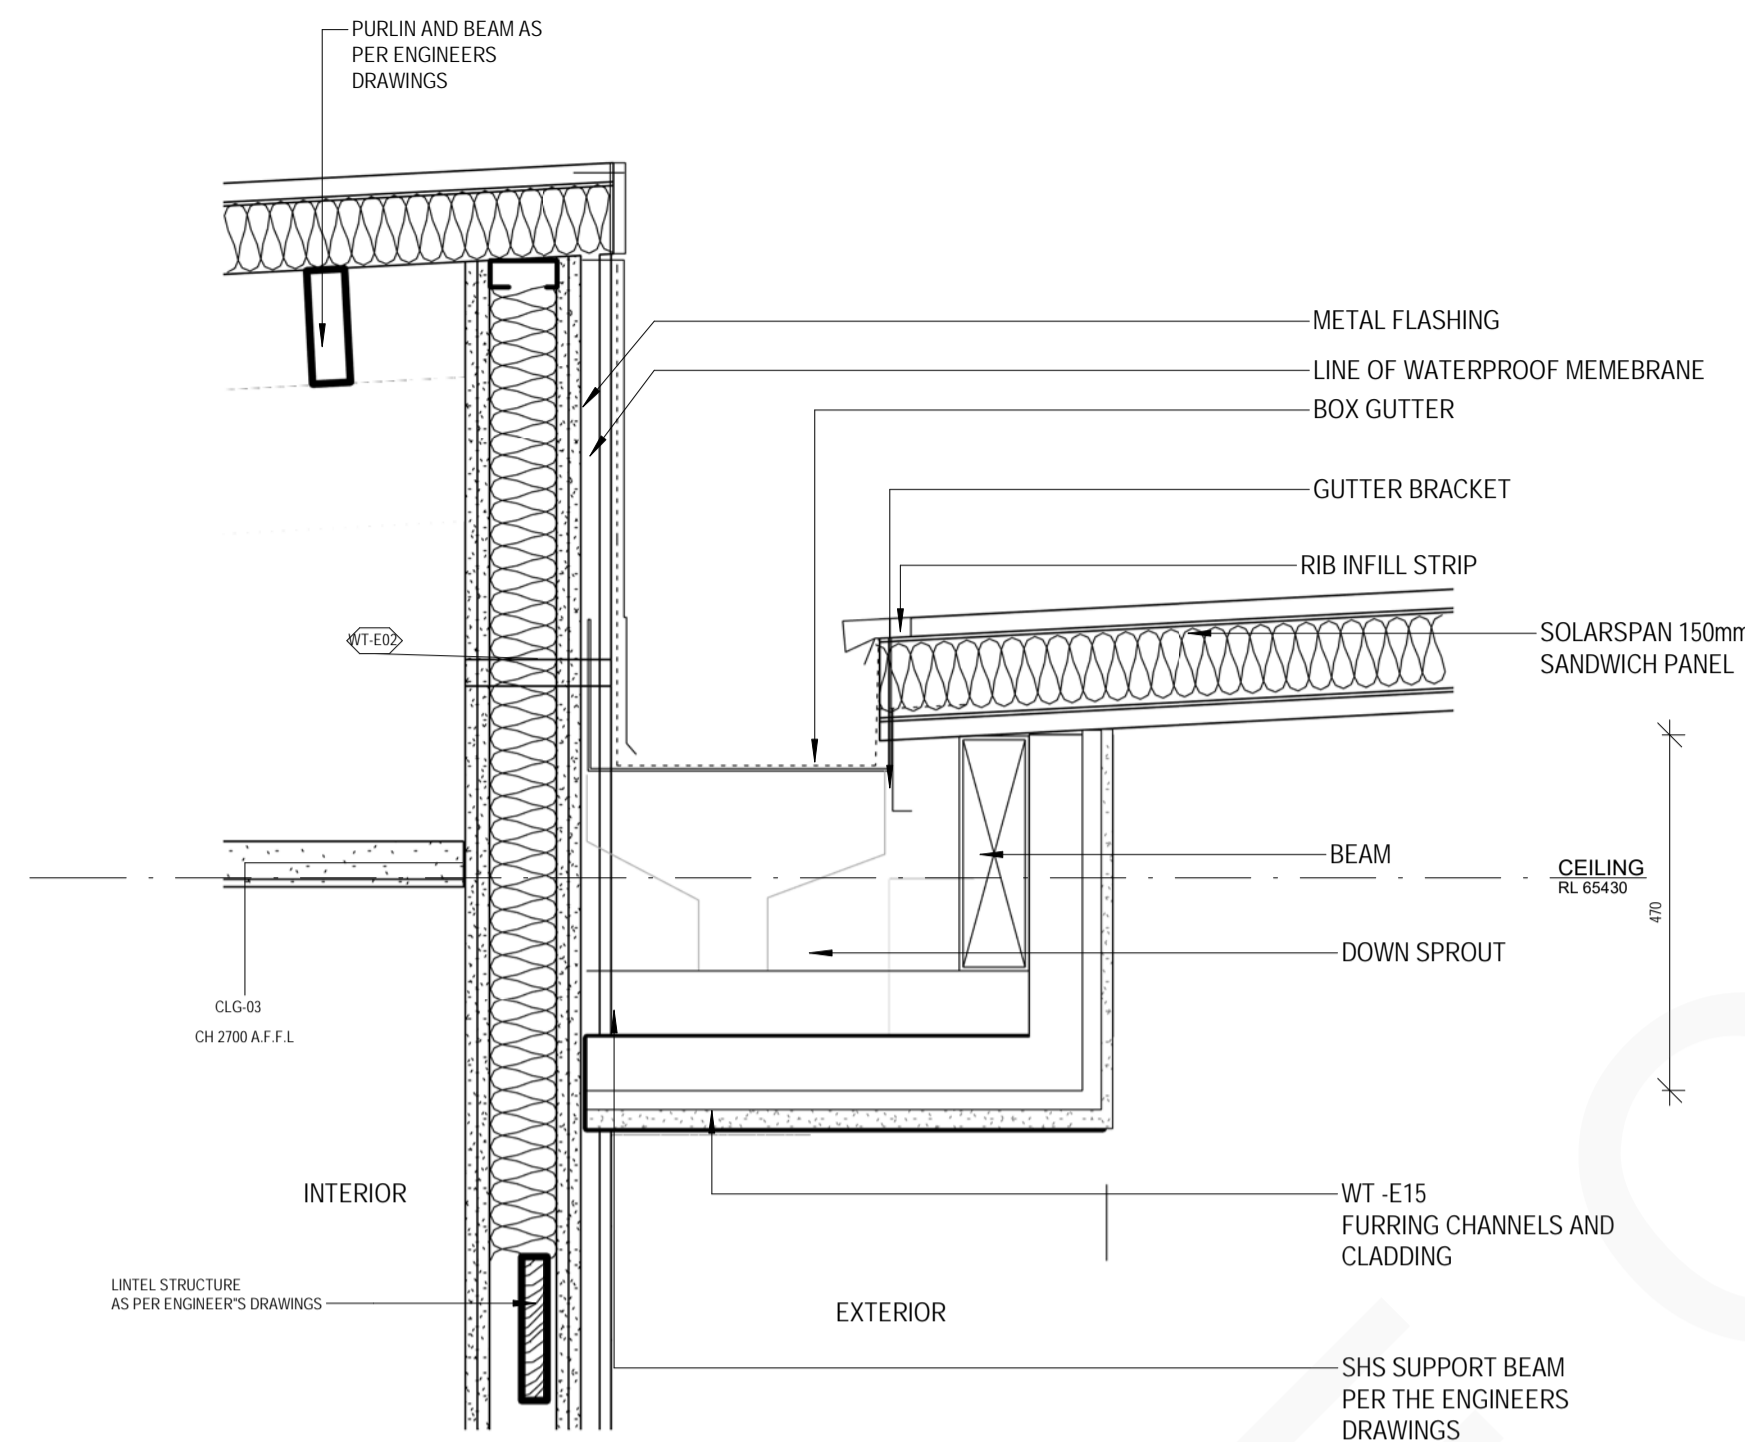


BULKHEAD DETAIL

1:10 REFER 2 - CD-300

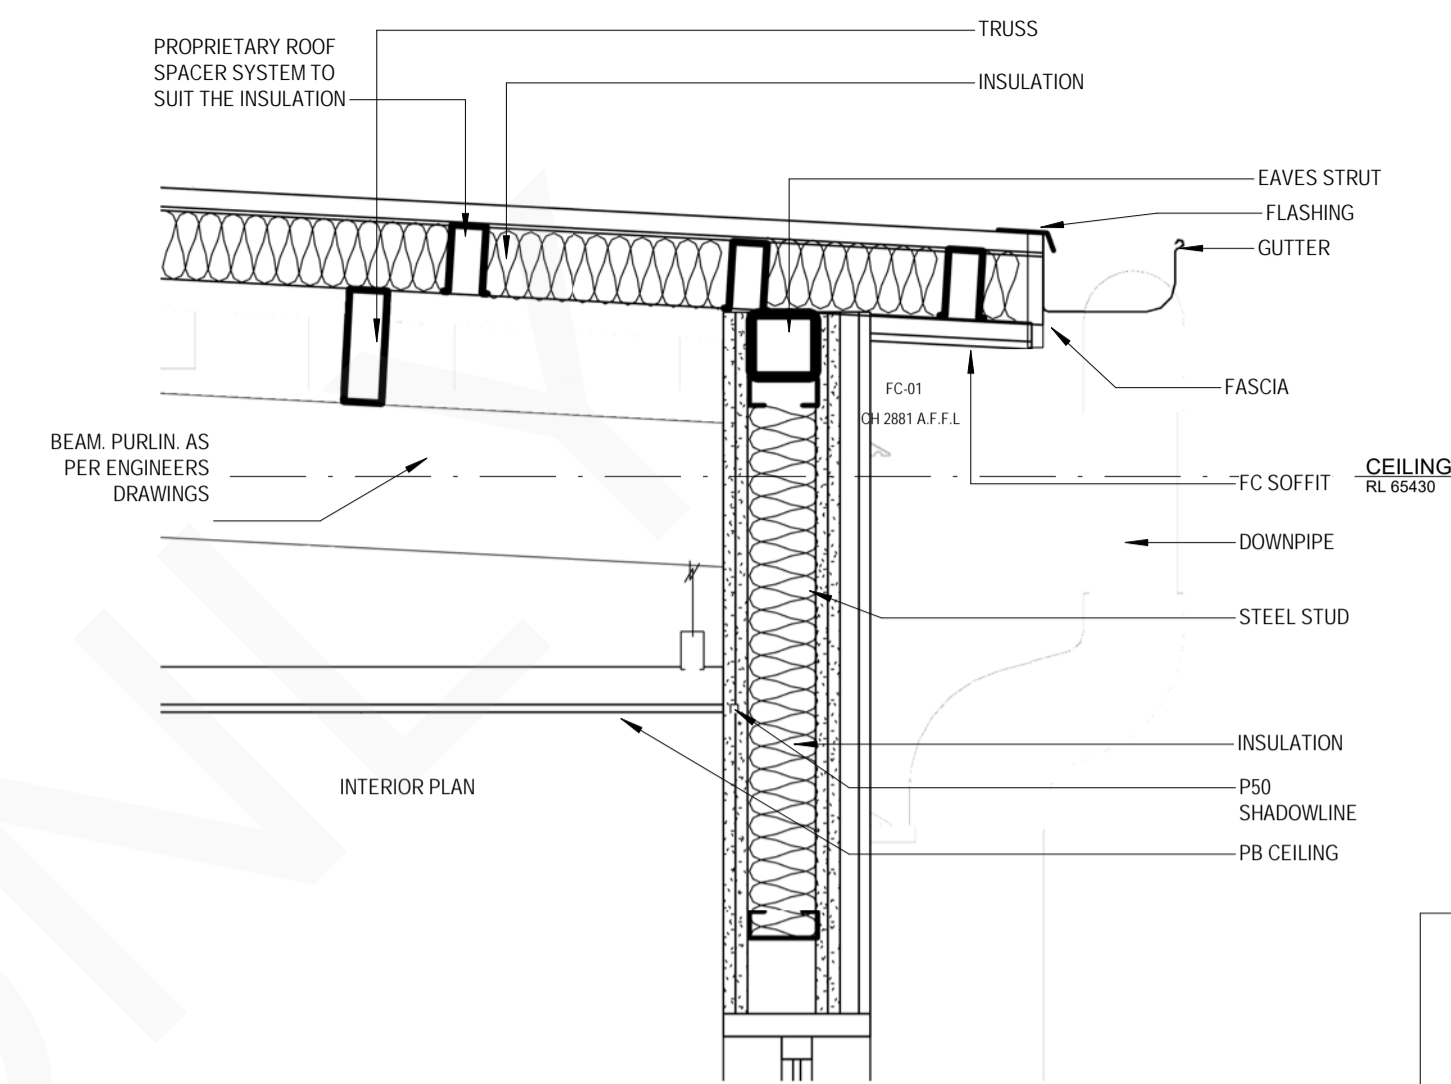


EAVES DETAIL

1:10 REFER 3 - CD-300

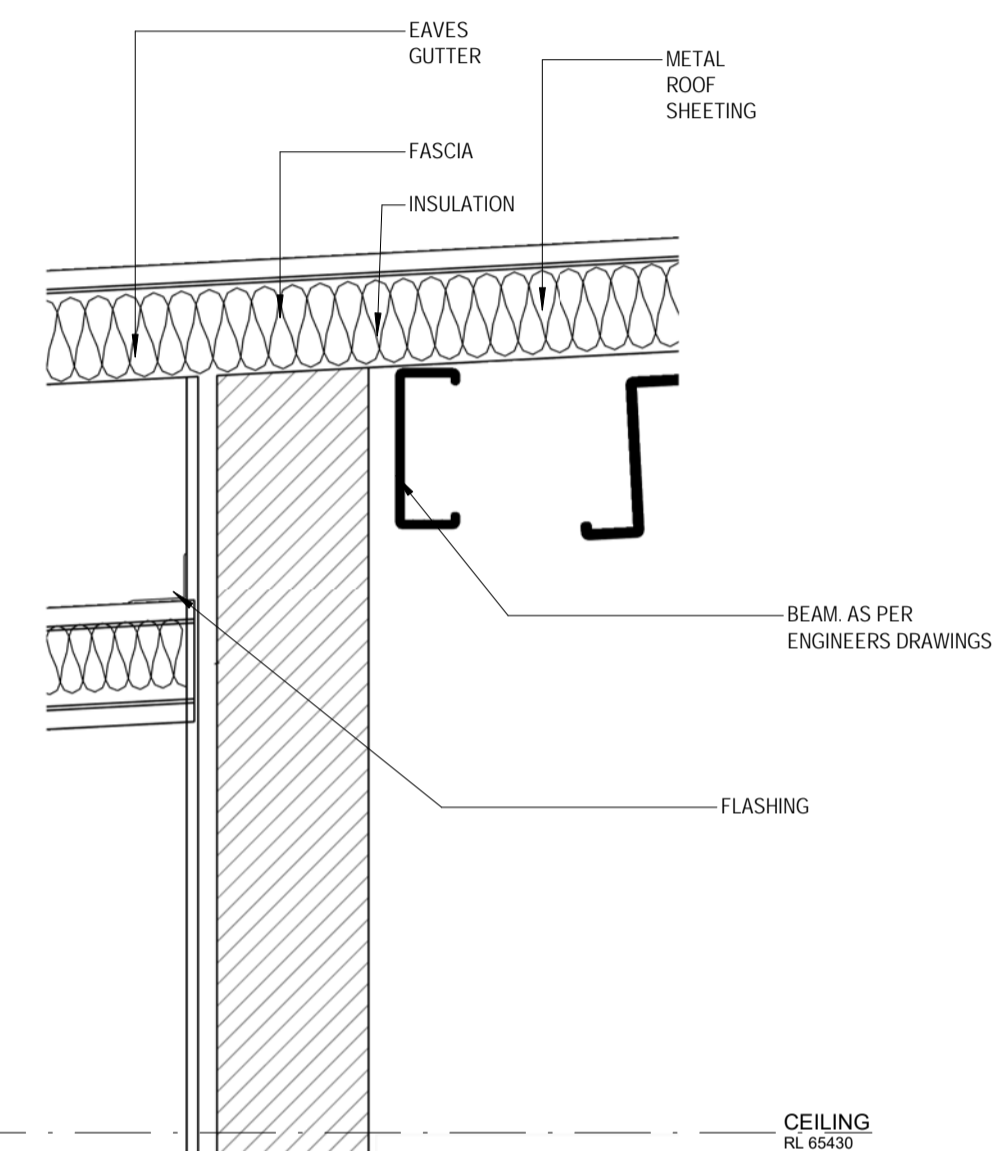


STAIRCASE ROOF AND AWNING DETAIL

1:10 REFER 4 - CD-404

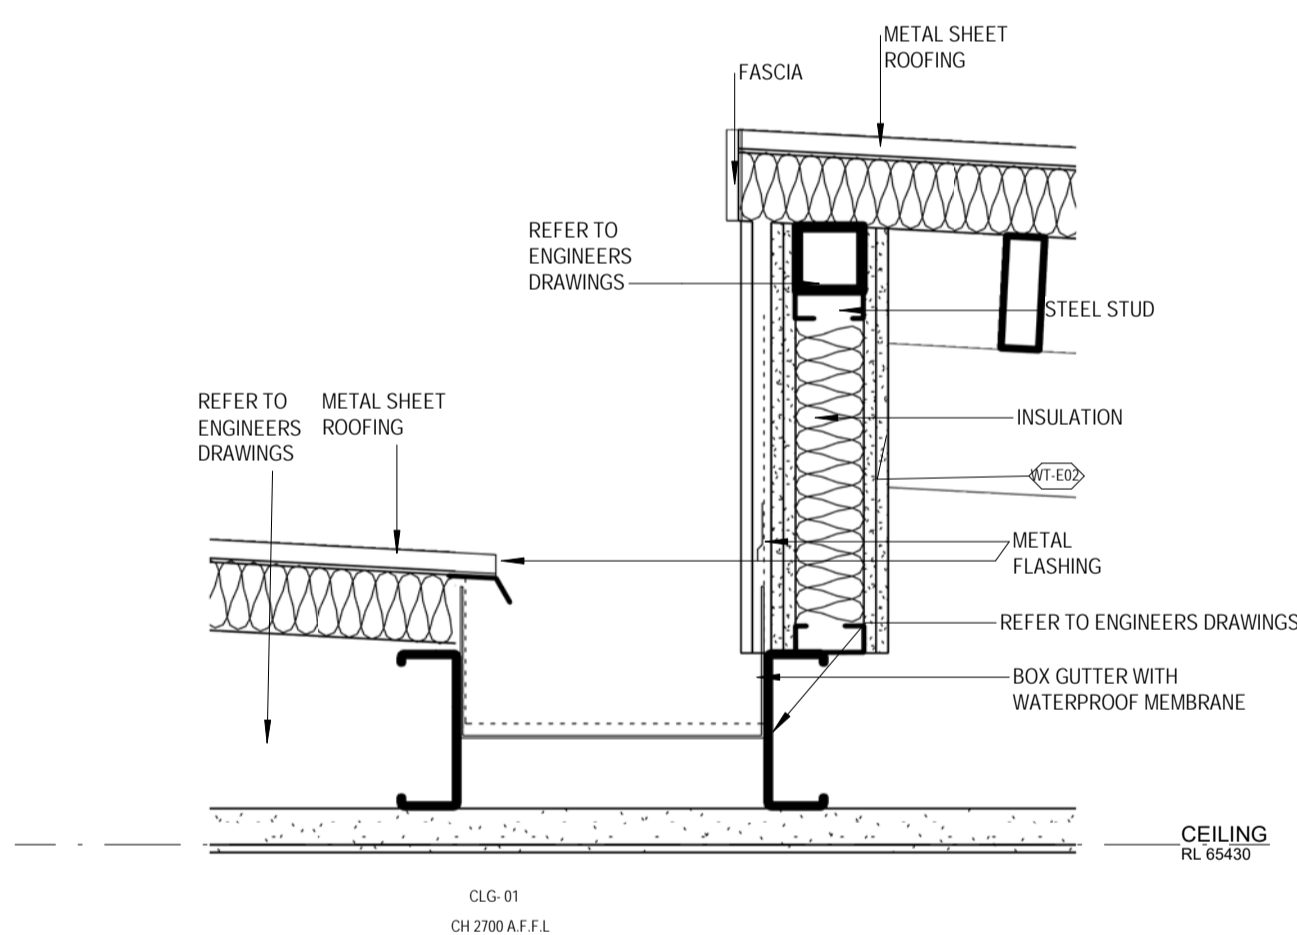


PROPOSED ROOFS DETAIL

REFER 1 - CD-300

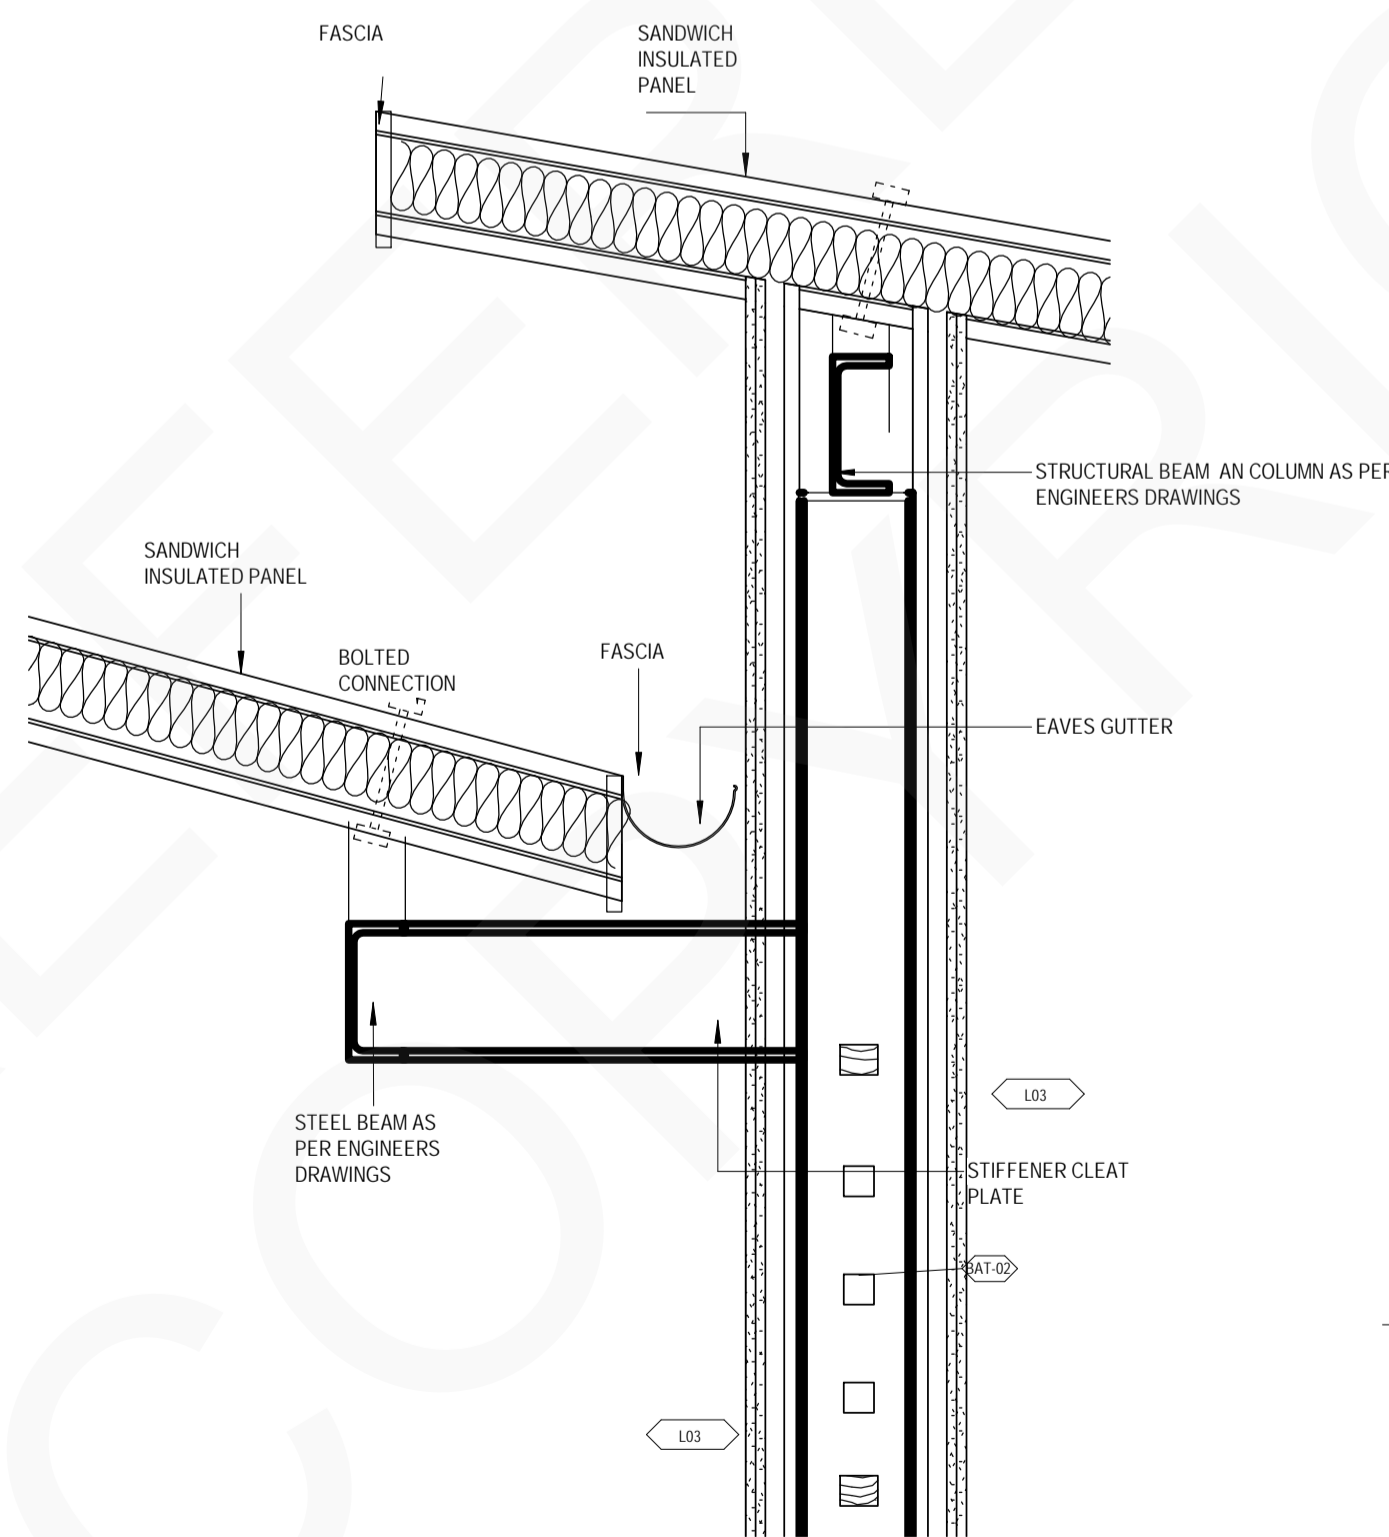


OUTDOOR AWNING CONNECTION DETAIL

1:10 REFER 8 - CD-105A

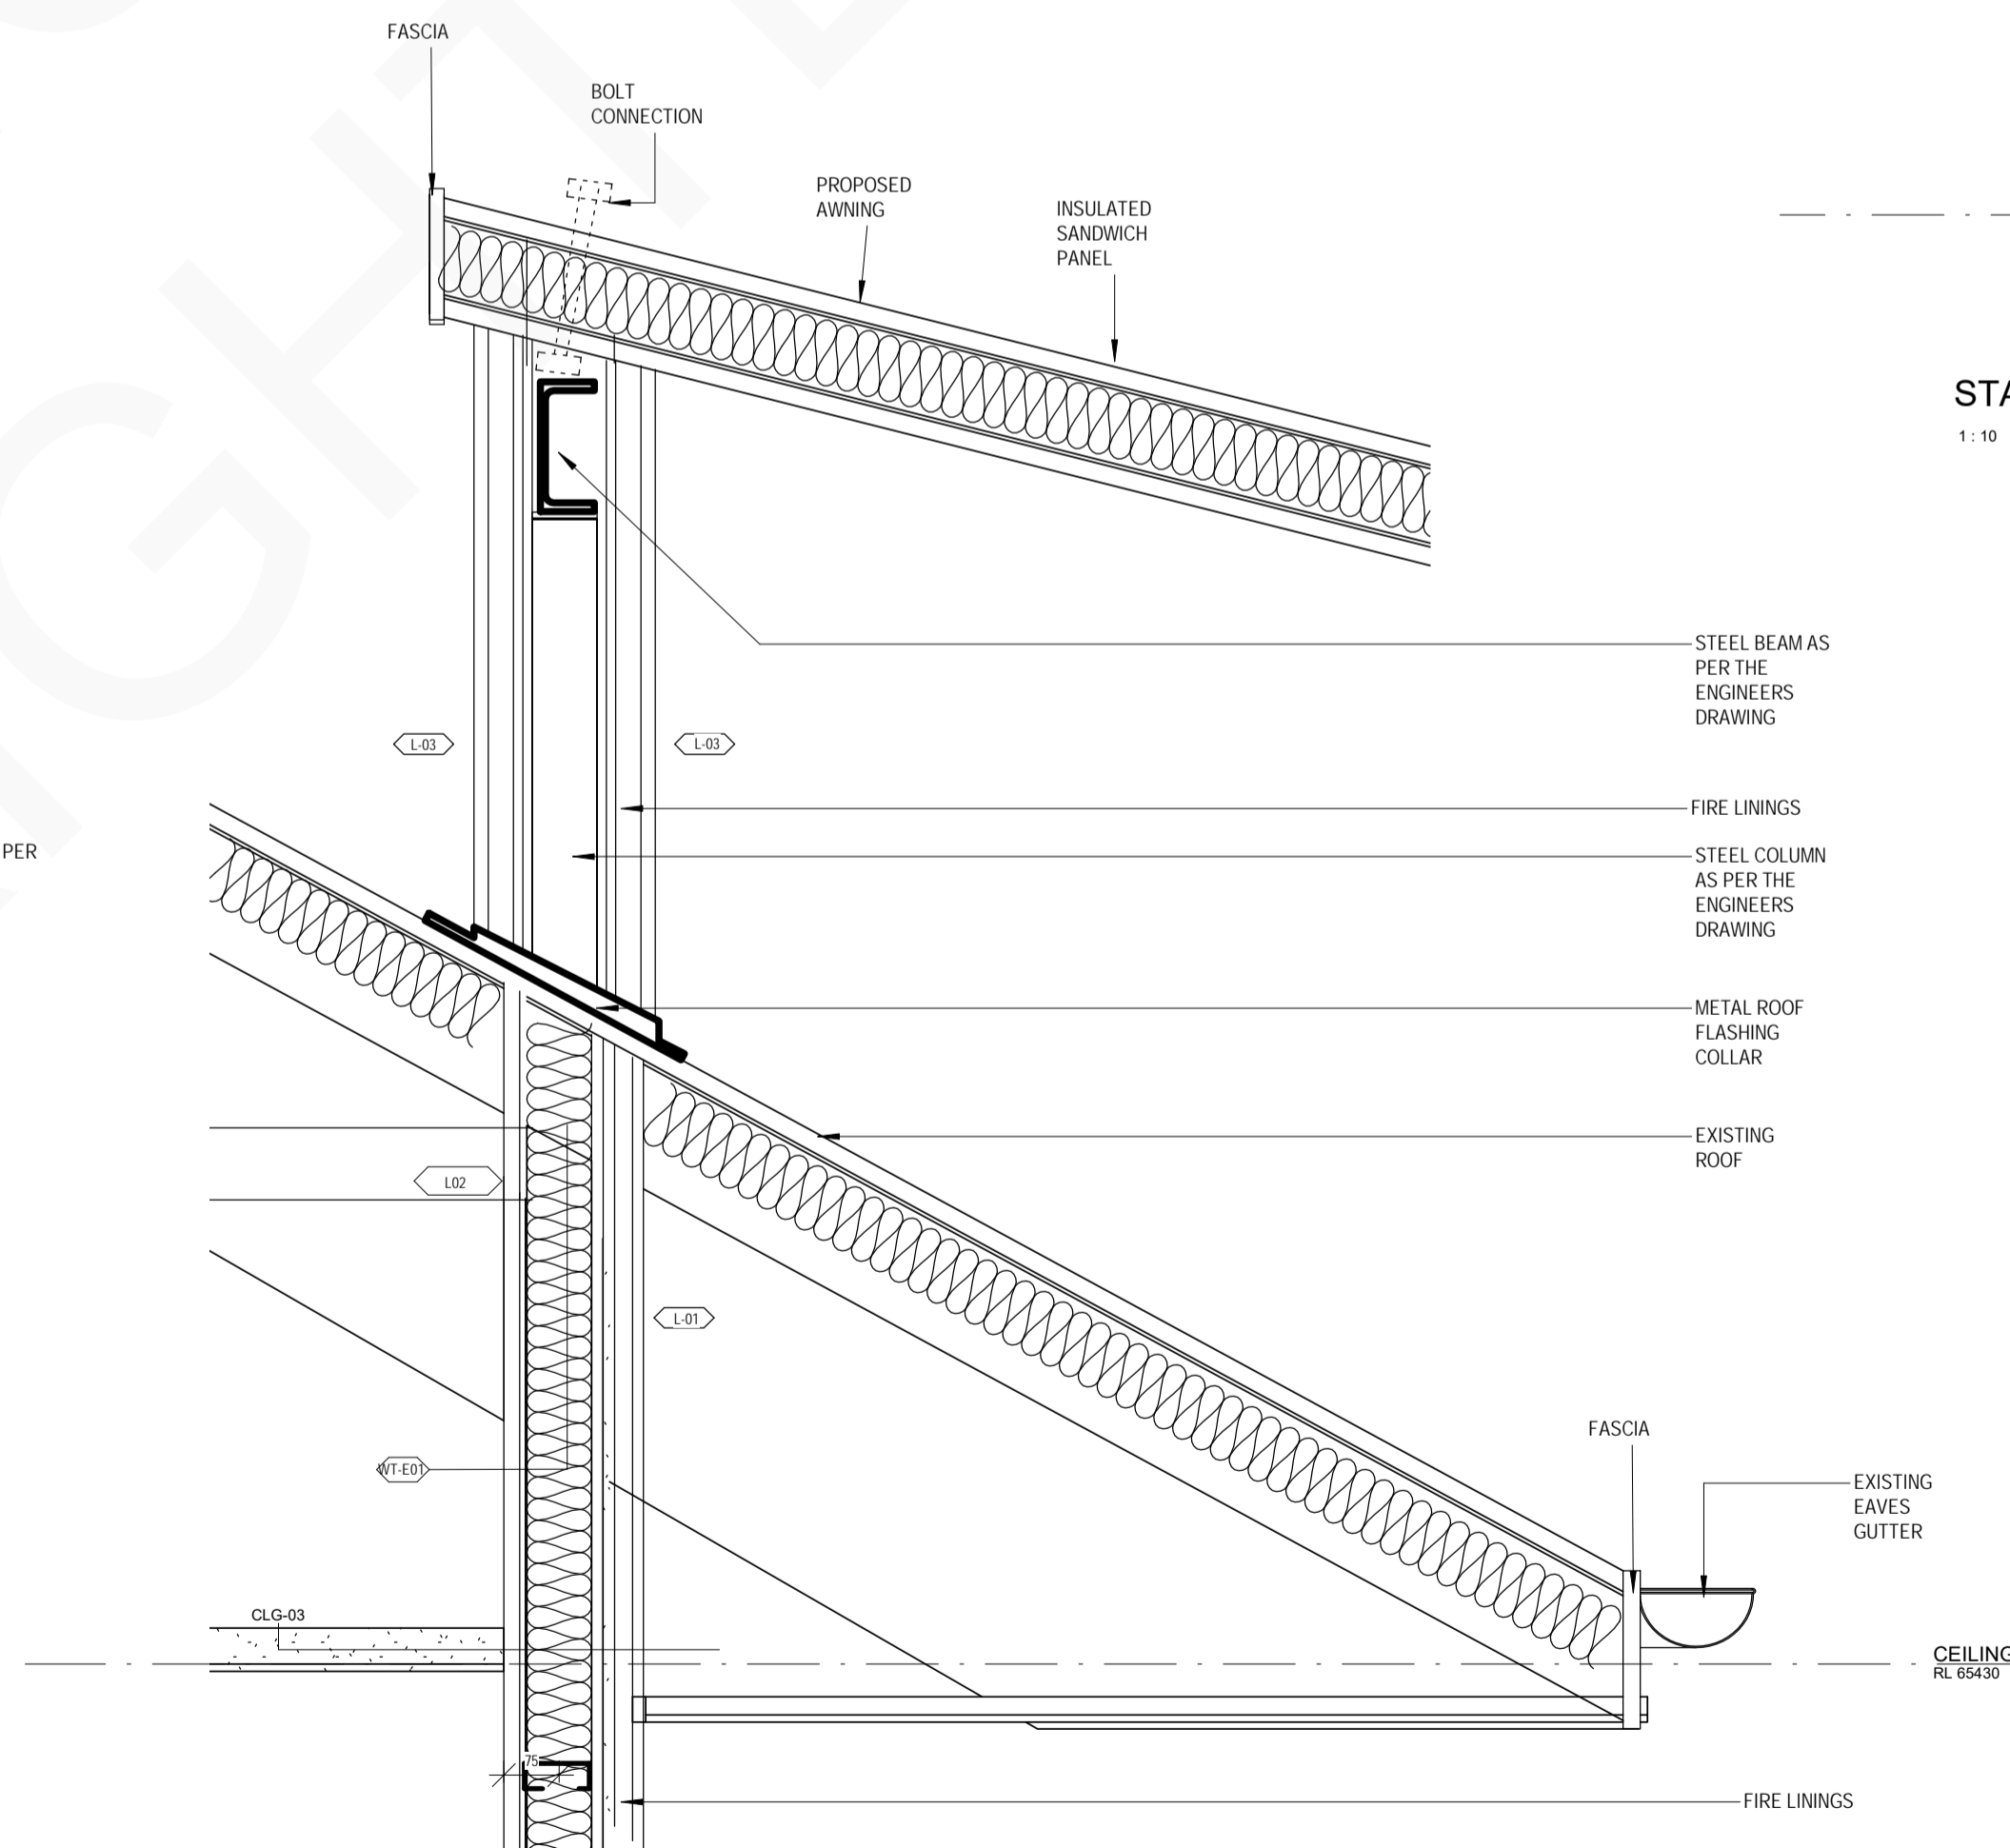


EXISTING ROOF TO AWNING CONNECTION

1:10 REFER 7 - CD-105A

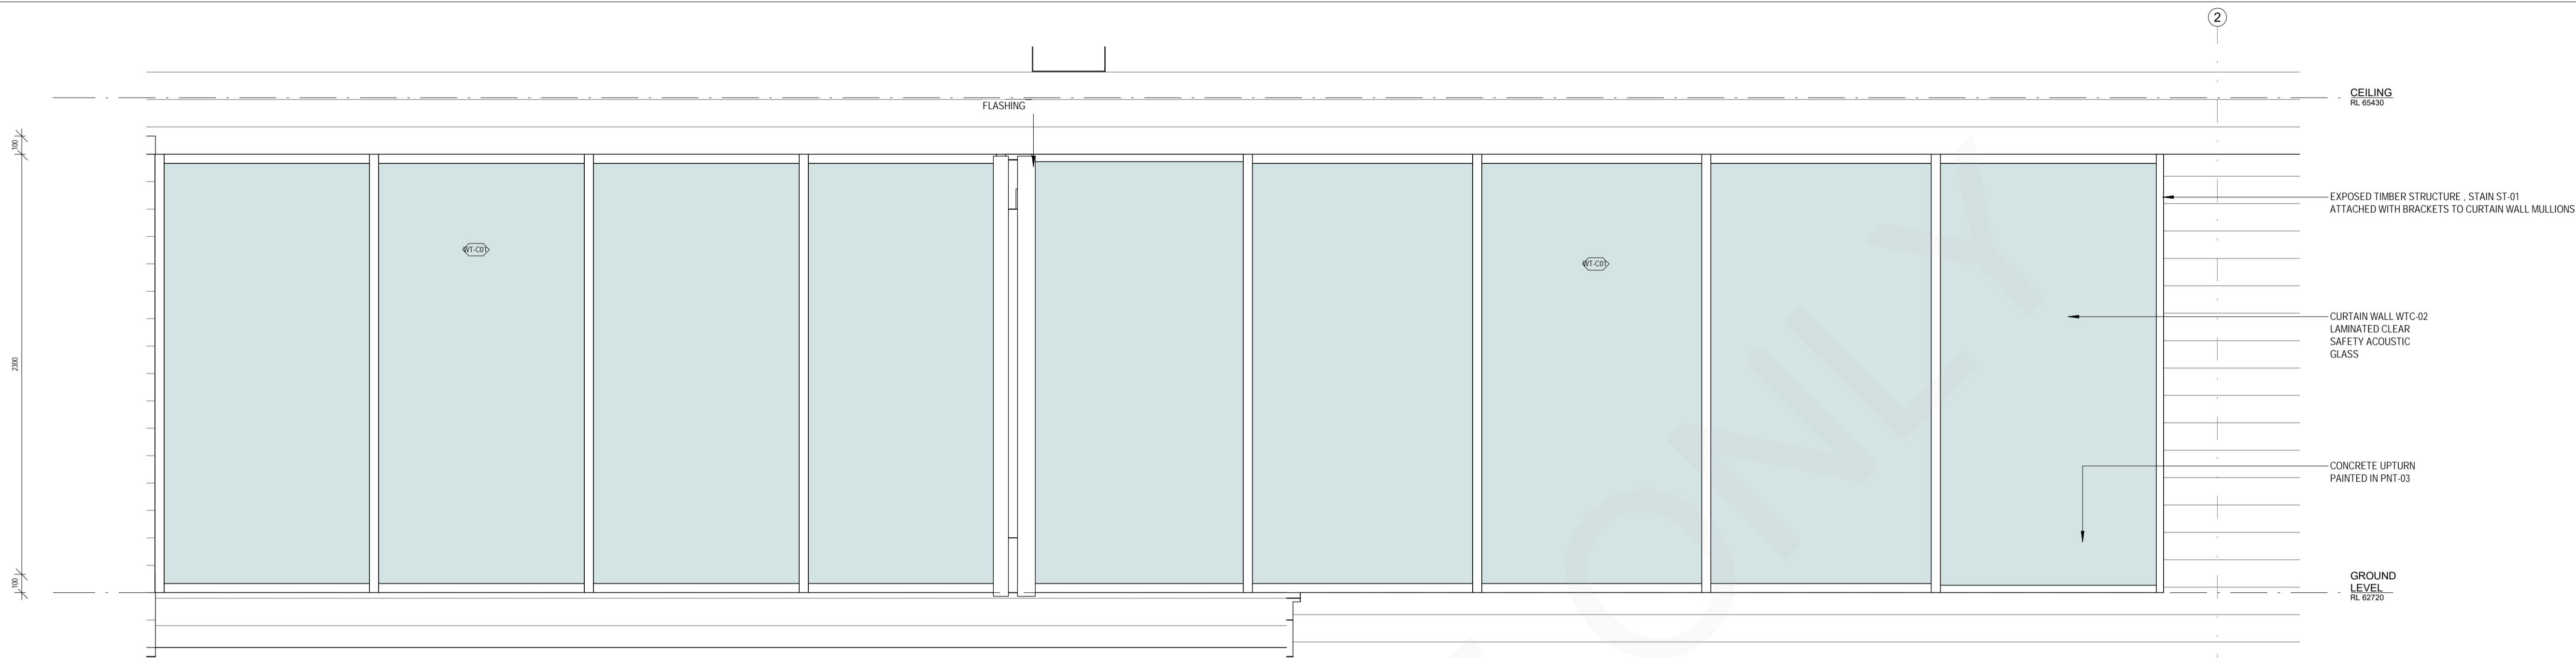


TIMBER FRAMING DETAIL

1:20 REFER 2 - CD-200

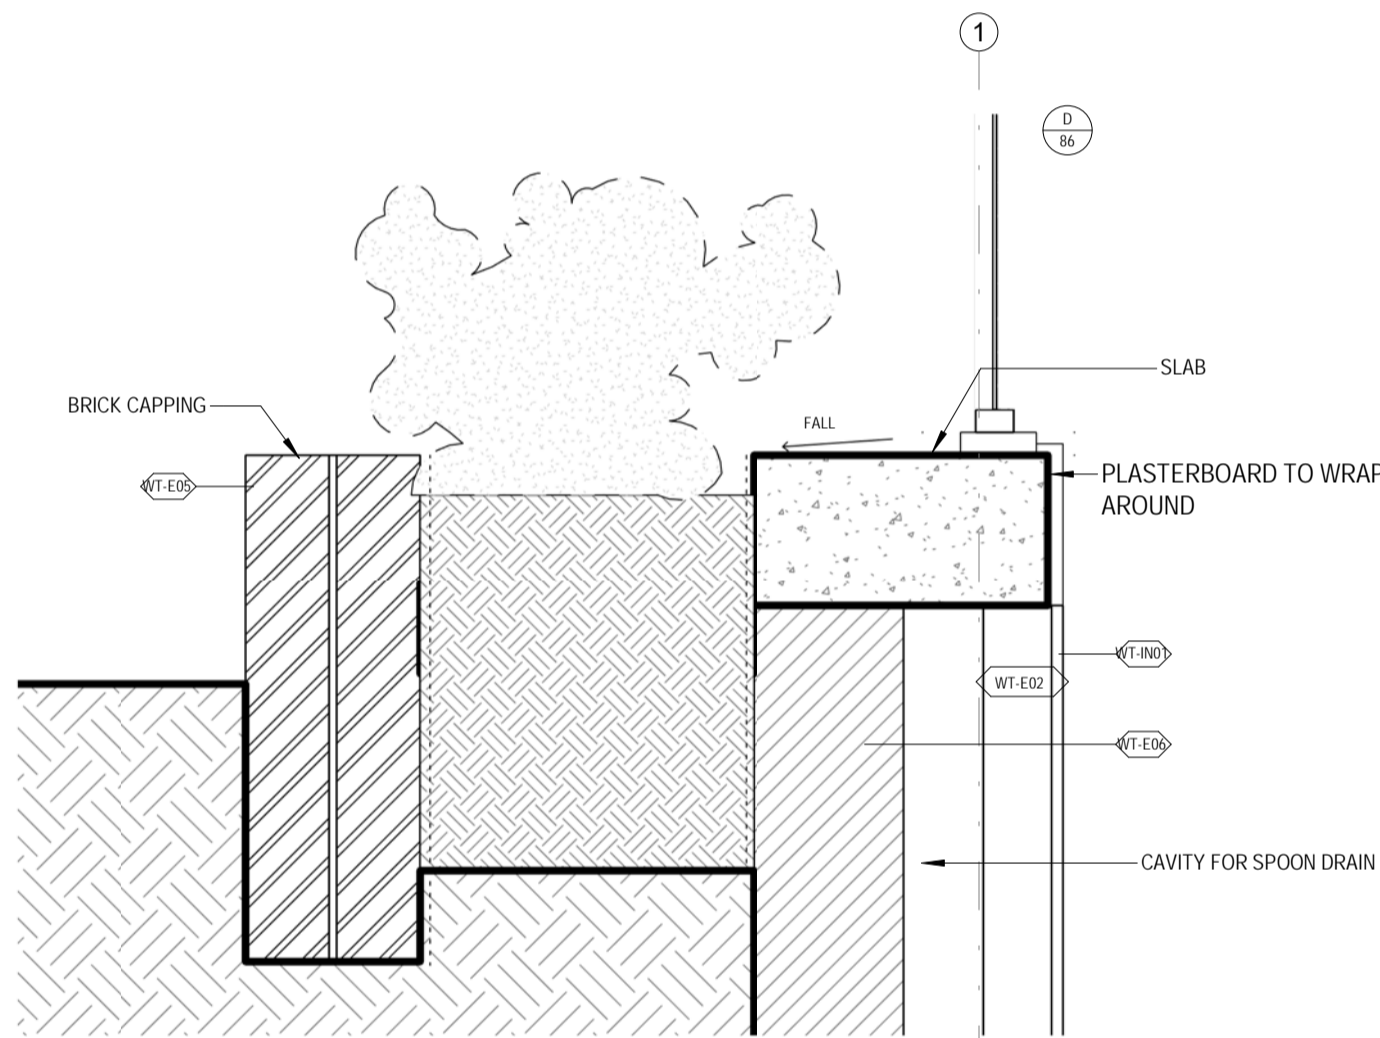


STAIRCASE PLANTER BOX DETAIL

1:10 REFER 4 - CD-404

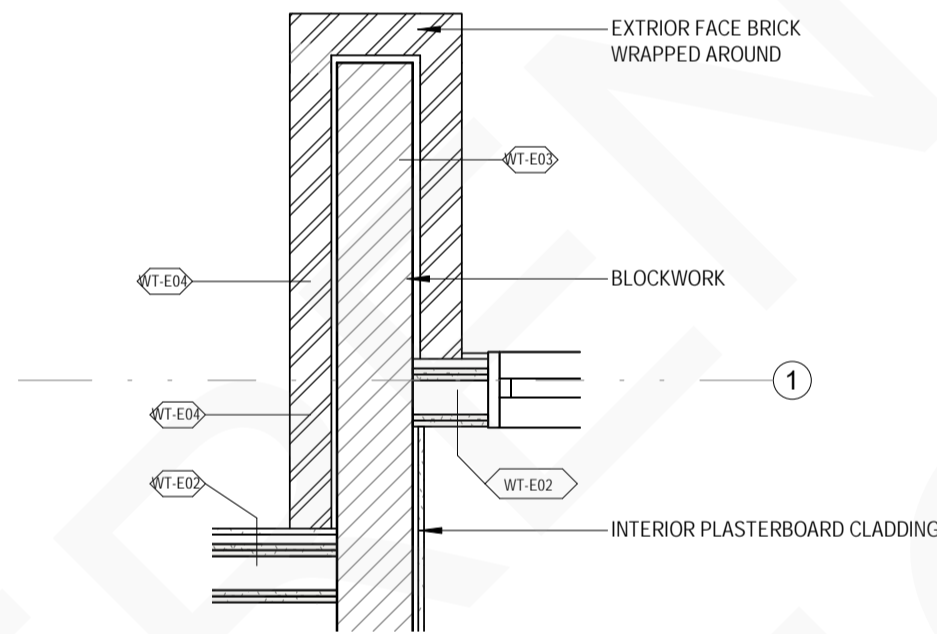


BRICK WALL JUNCTION PLAN

1:20 REFER 3 - CD-104B

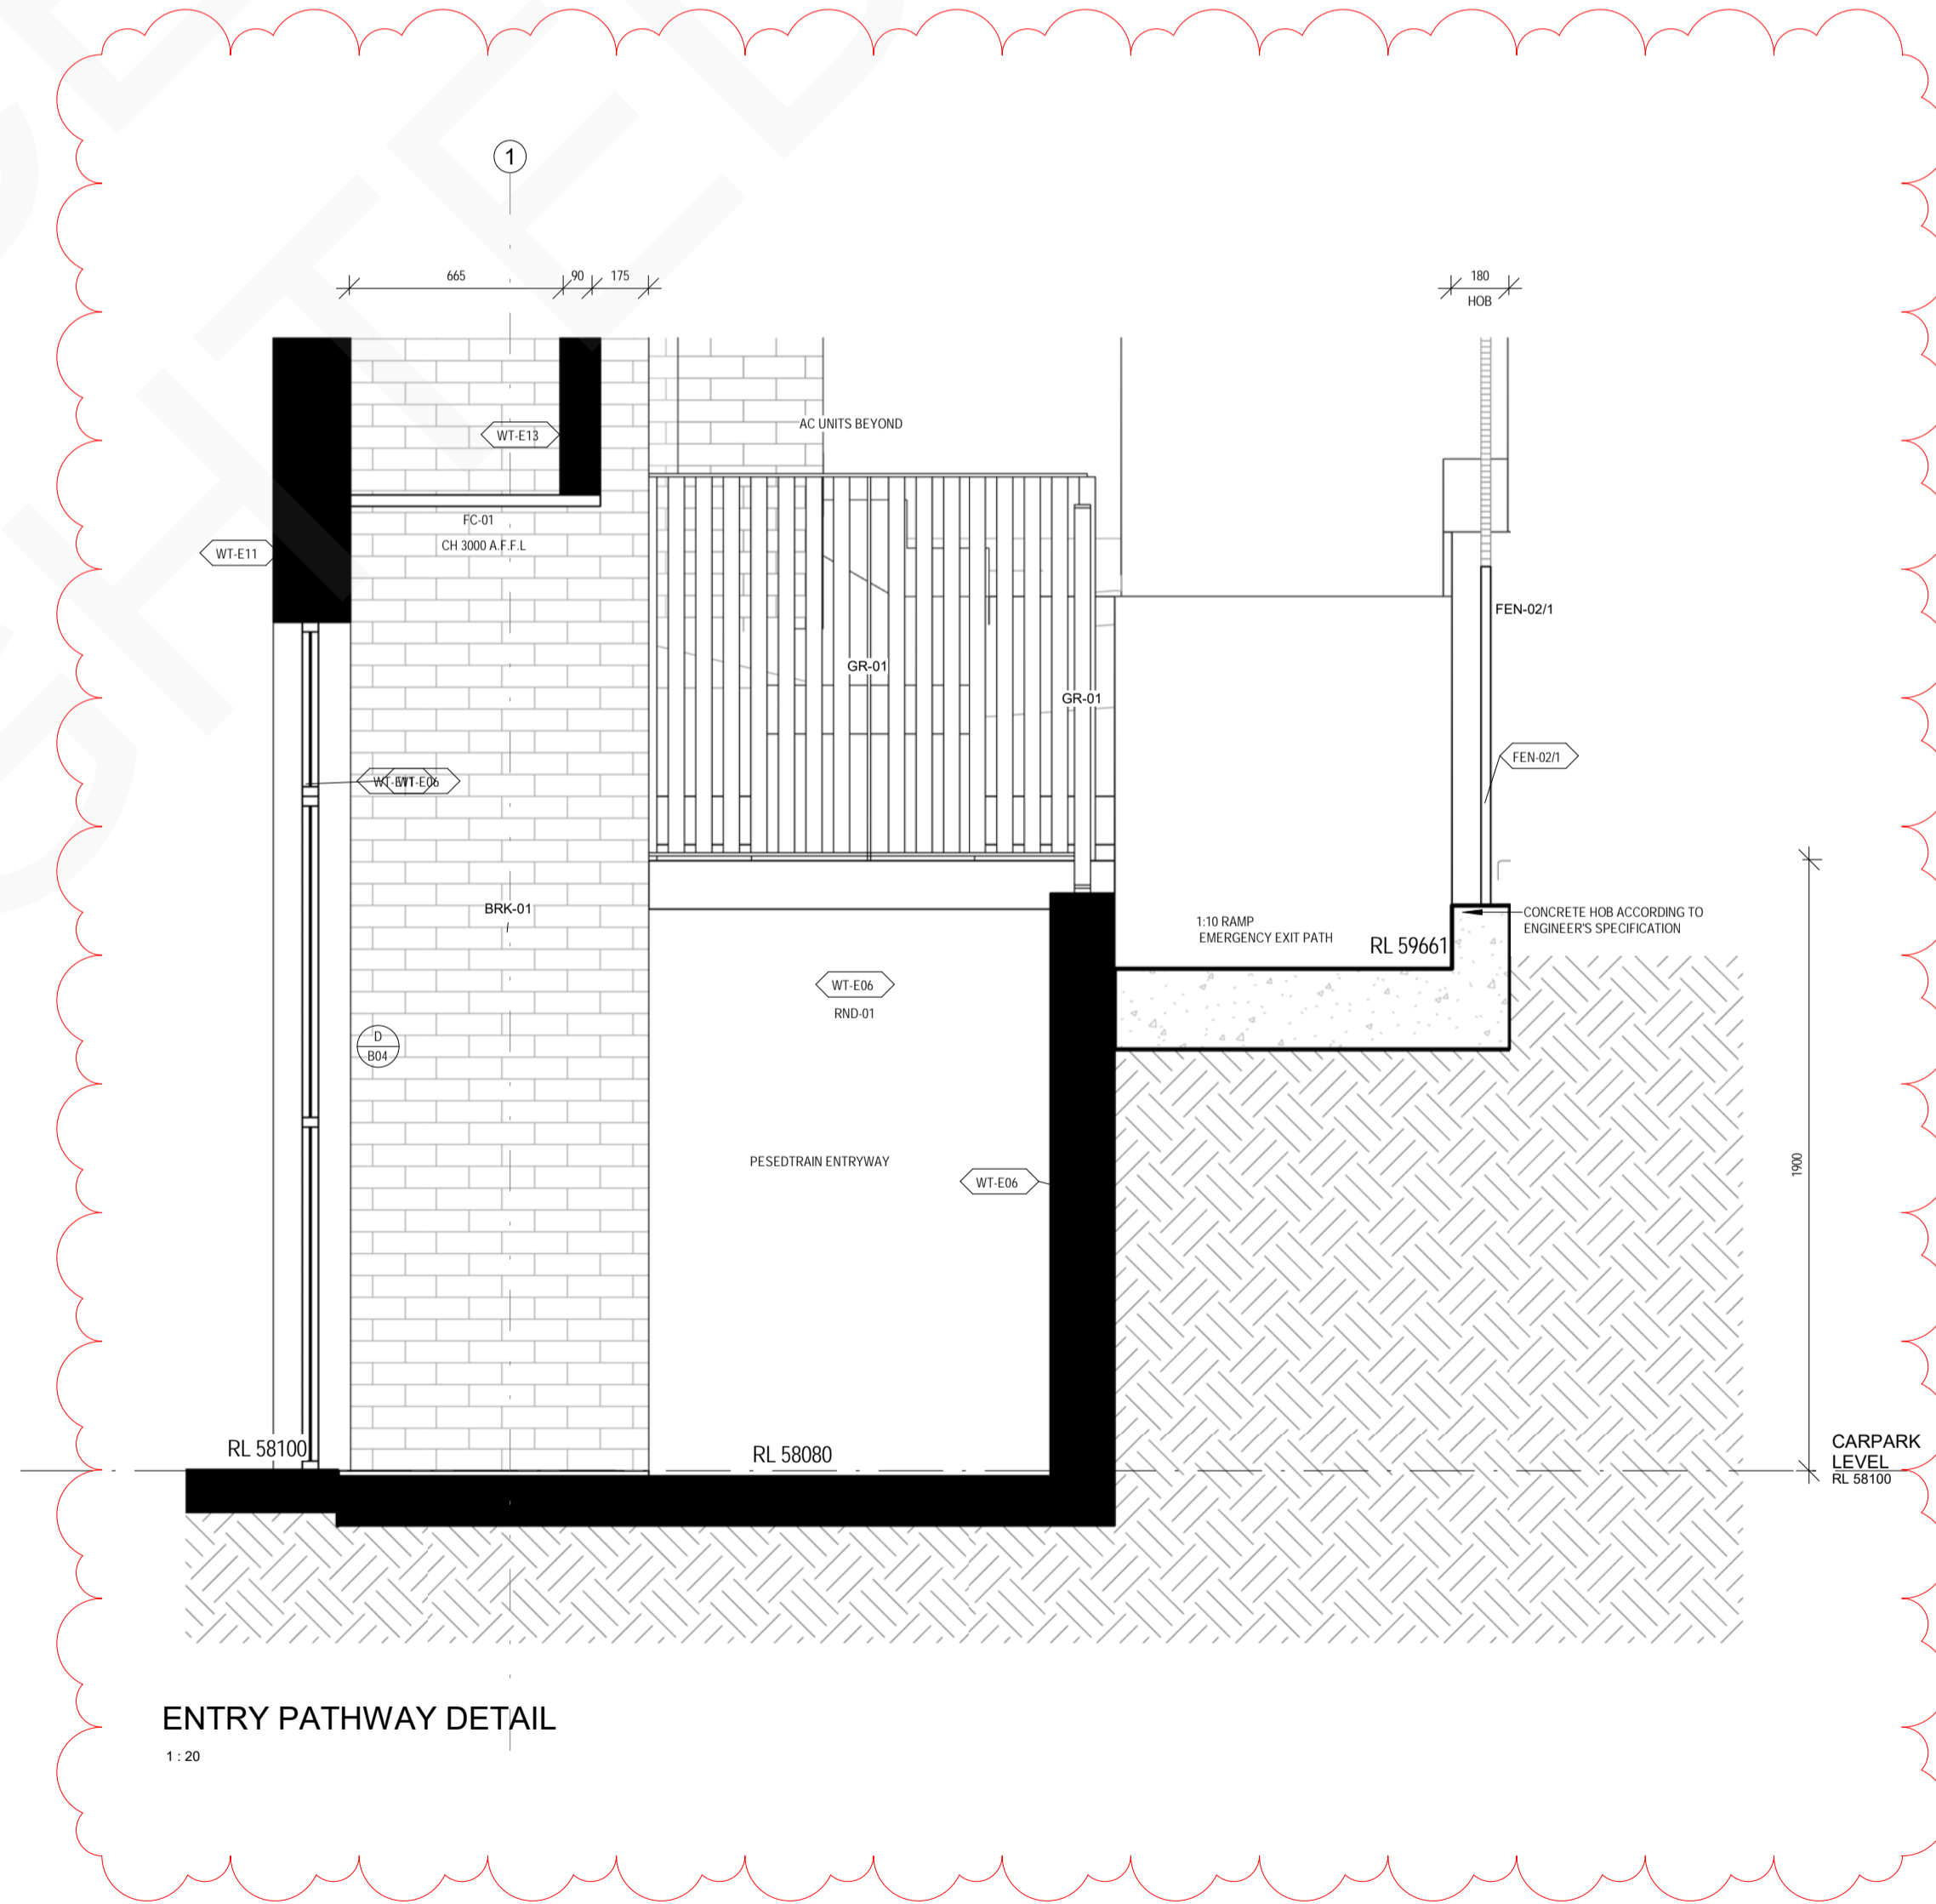

ENTRY PATHWAY DETAIL

1:20

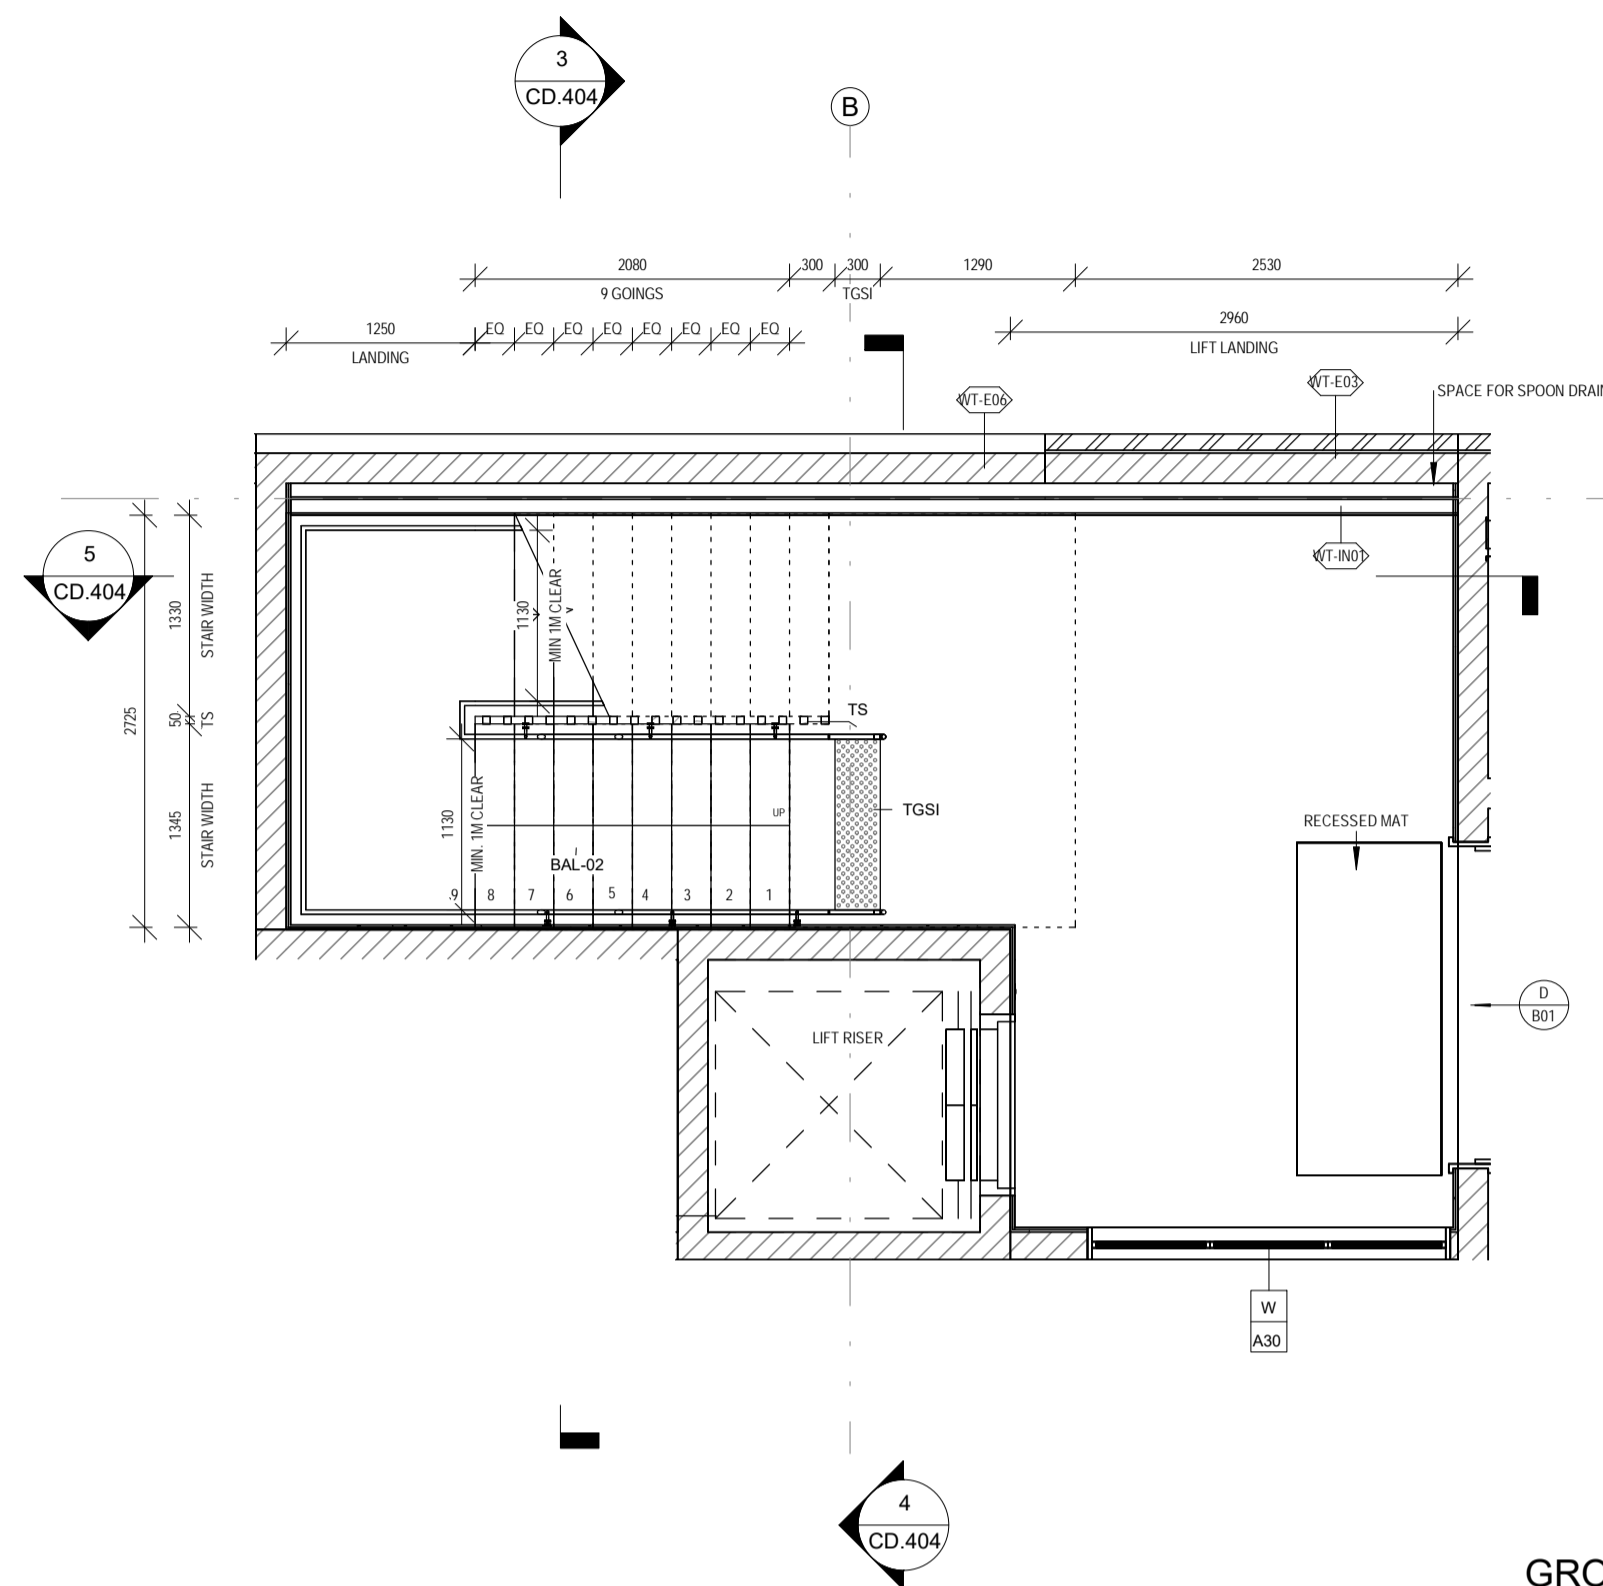


CAR PARK LEVEL- STAIRCASE DETAIL


1:50 REFER 1

GROUND FLOOR- STAIRCASE DETAIL

1:50 REFER 2 - CD.104B

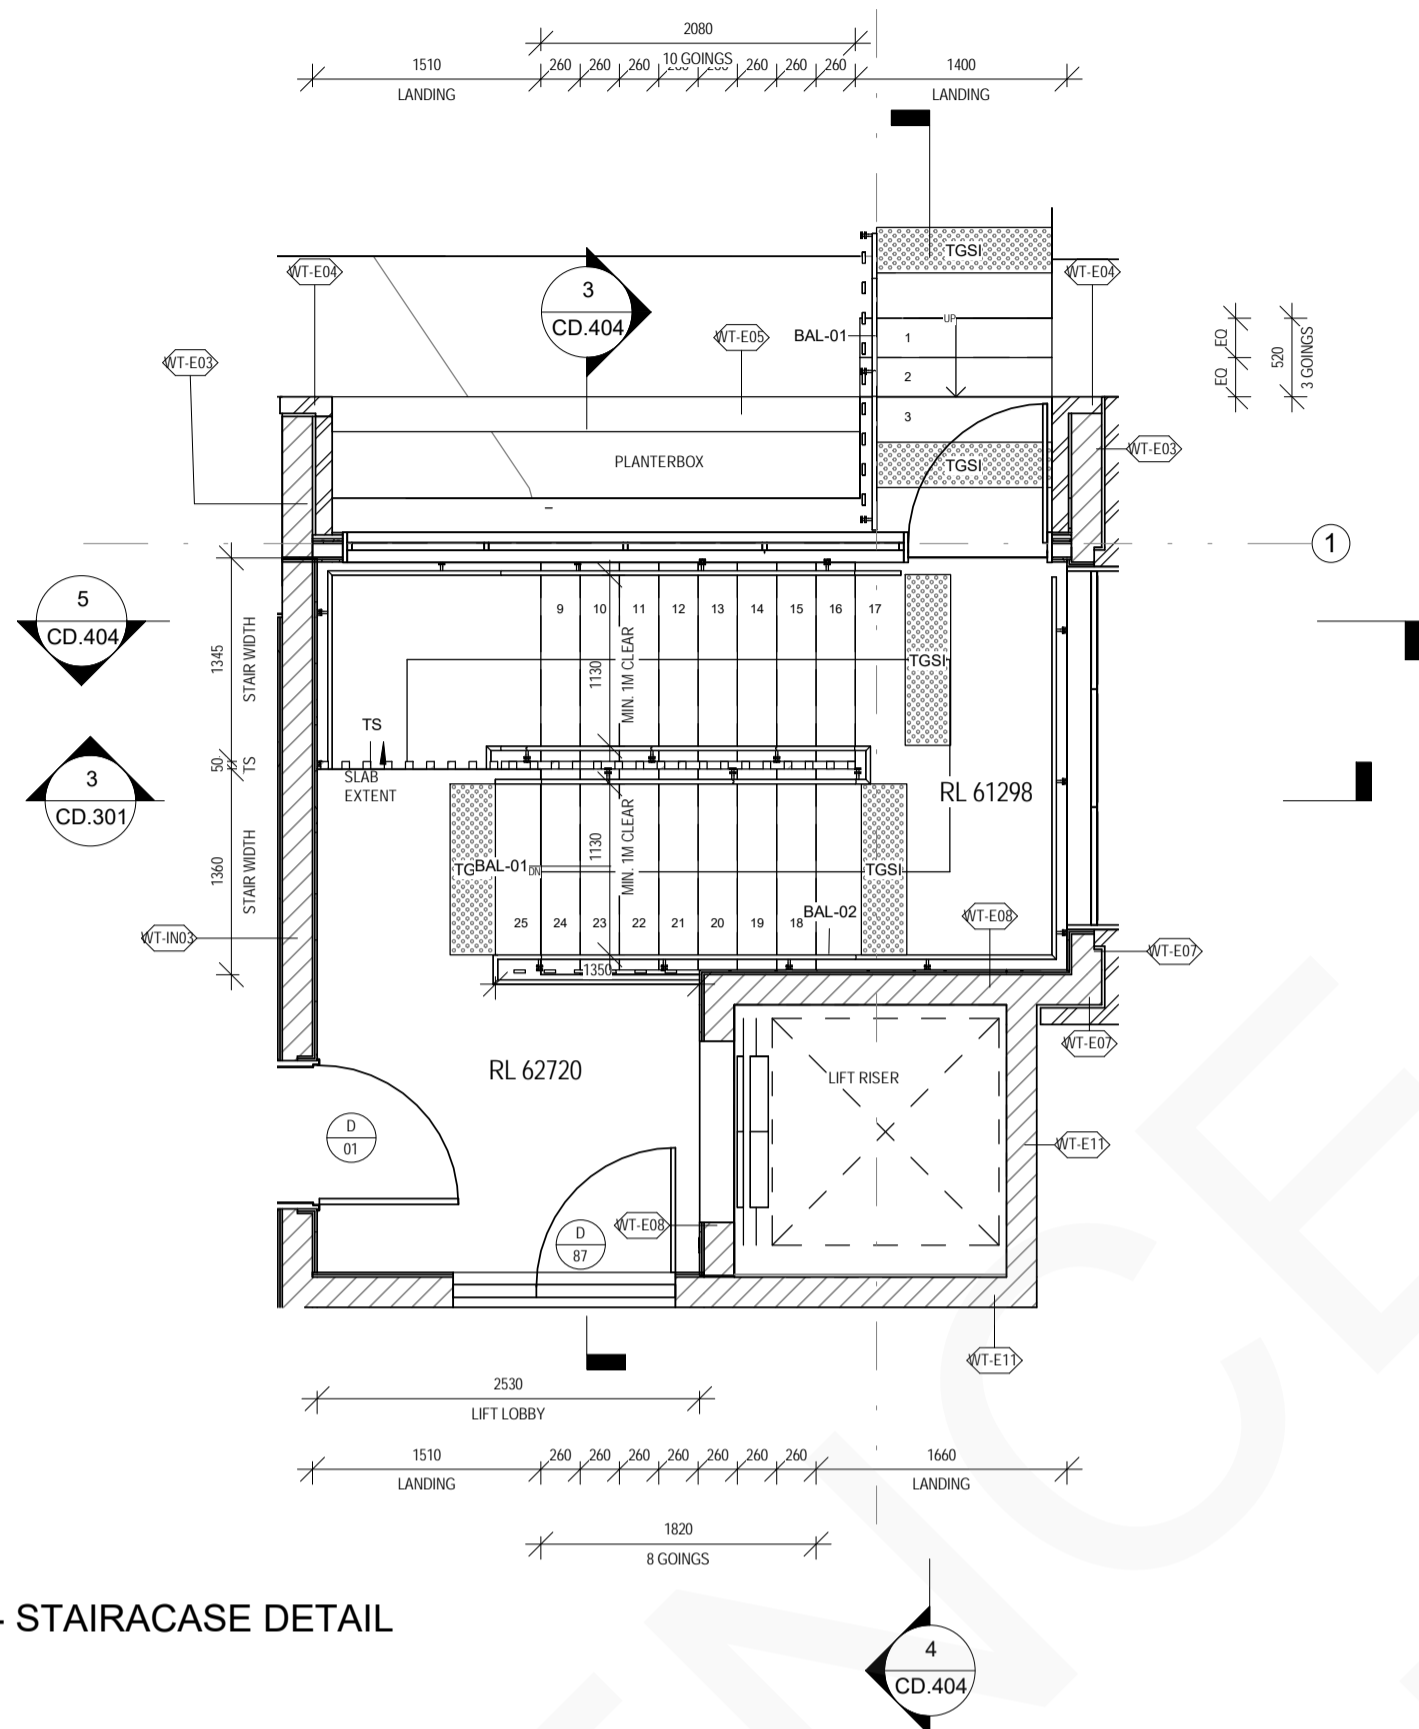


INTERNAL STAIRCASE PERSPECTIVE

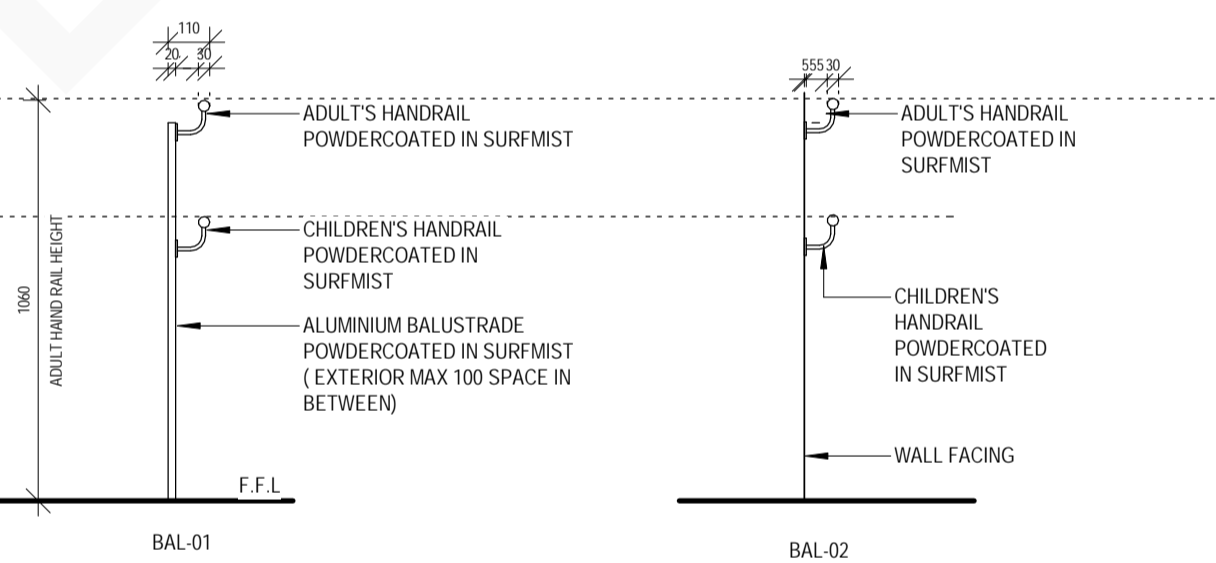


BALUSTRADES TYPES

1:20

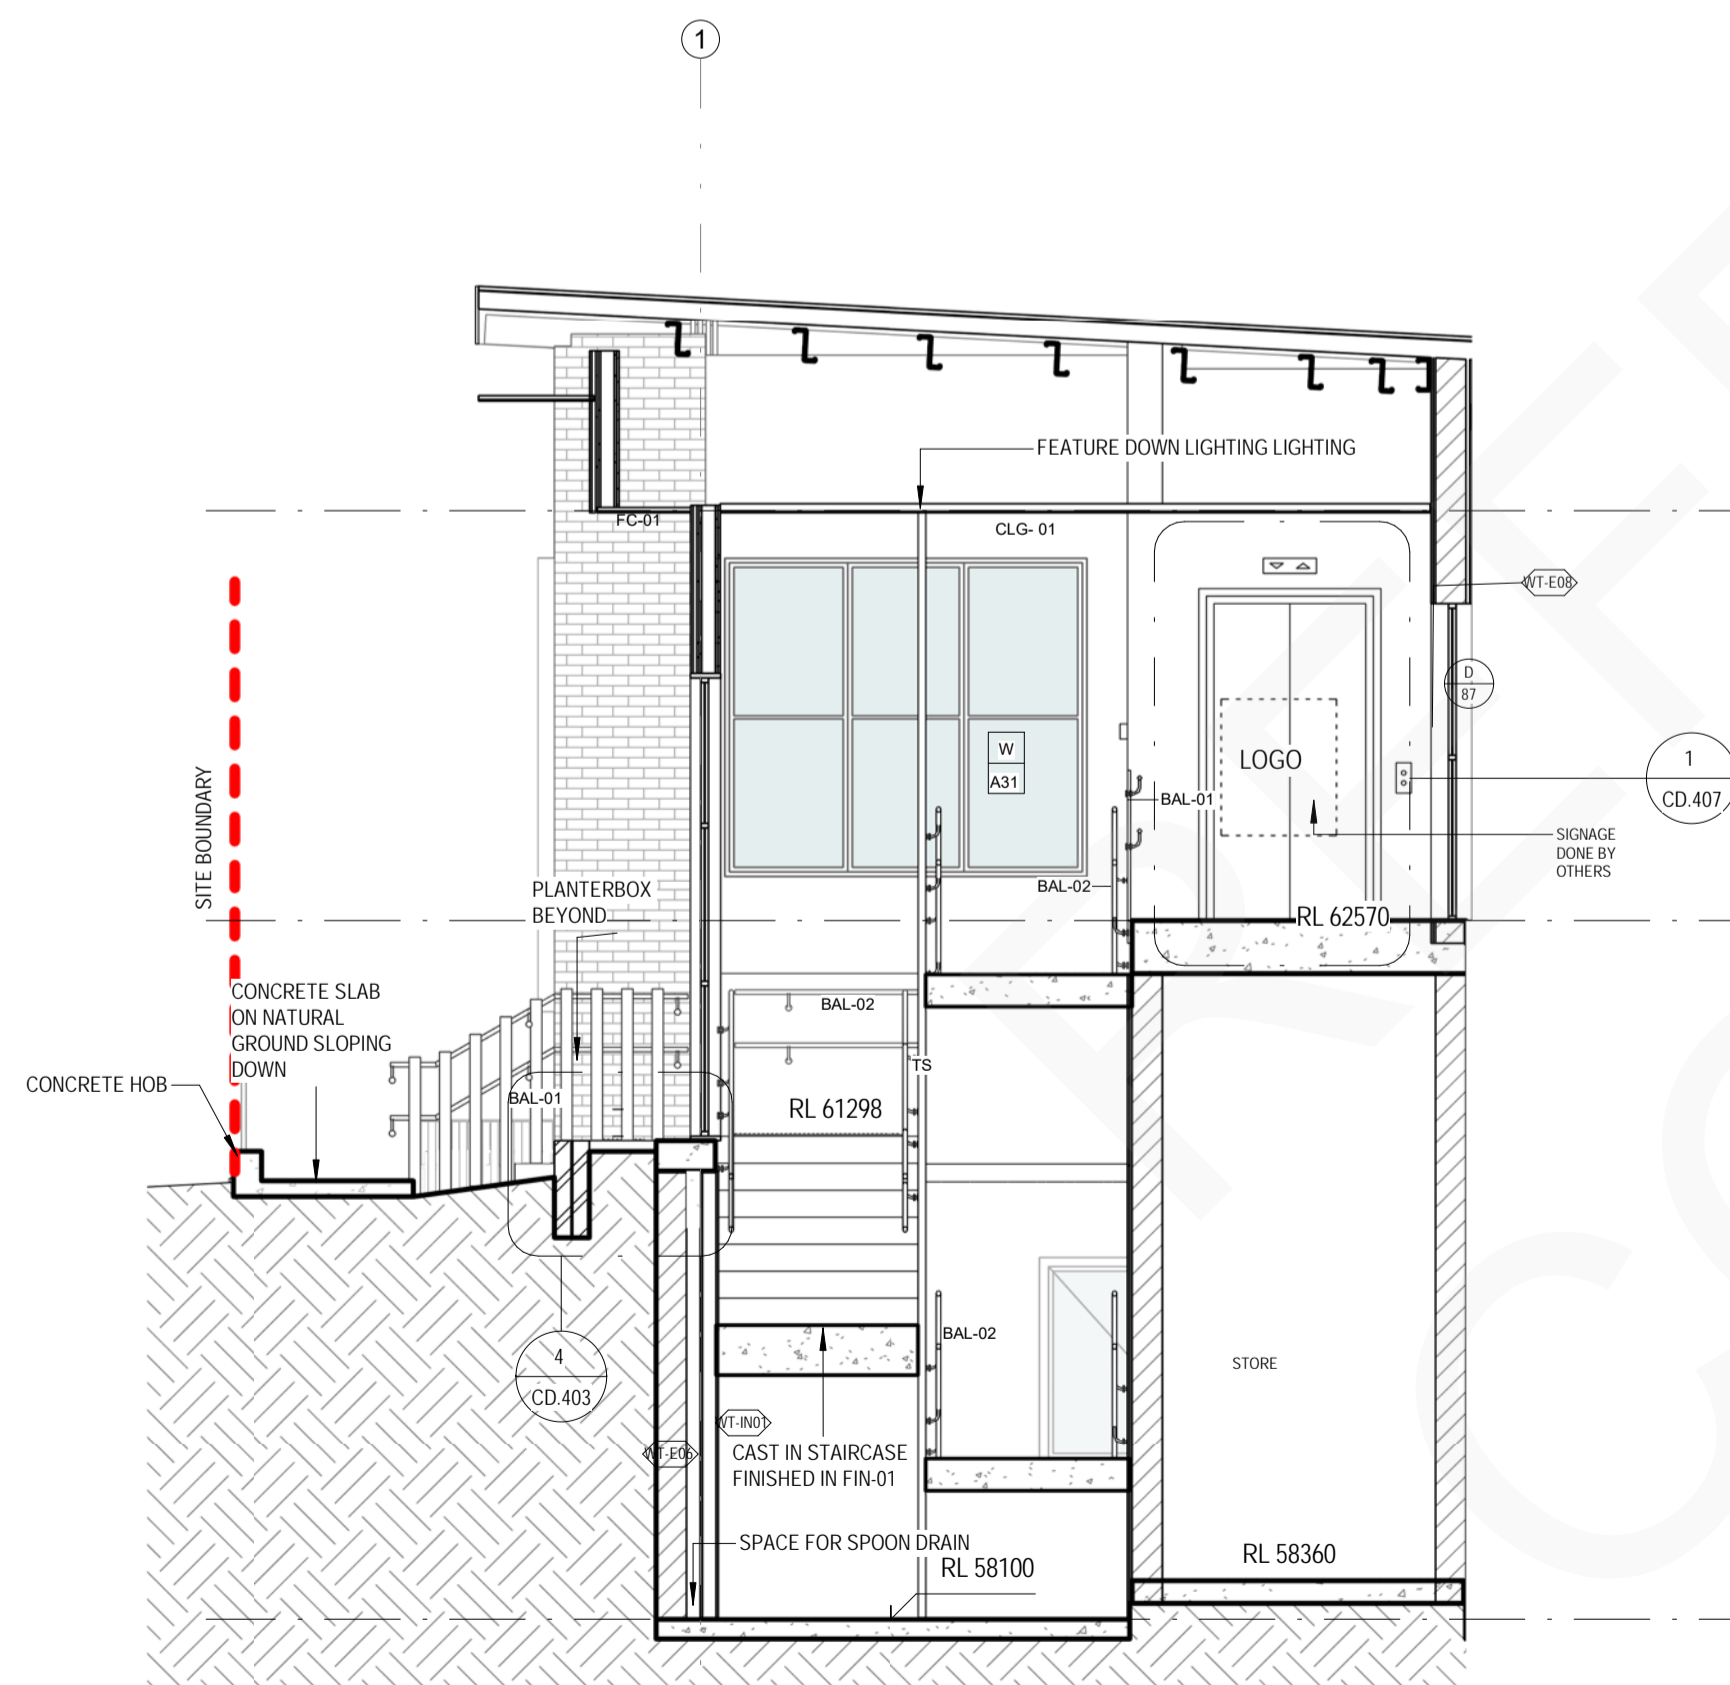


STAIRCASE SECTION 01

1:50 REFER 3 - CD.404

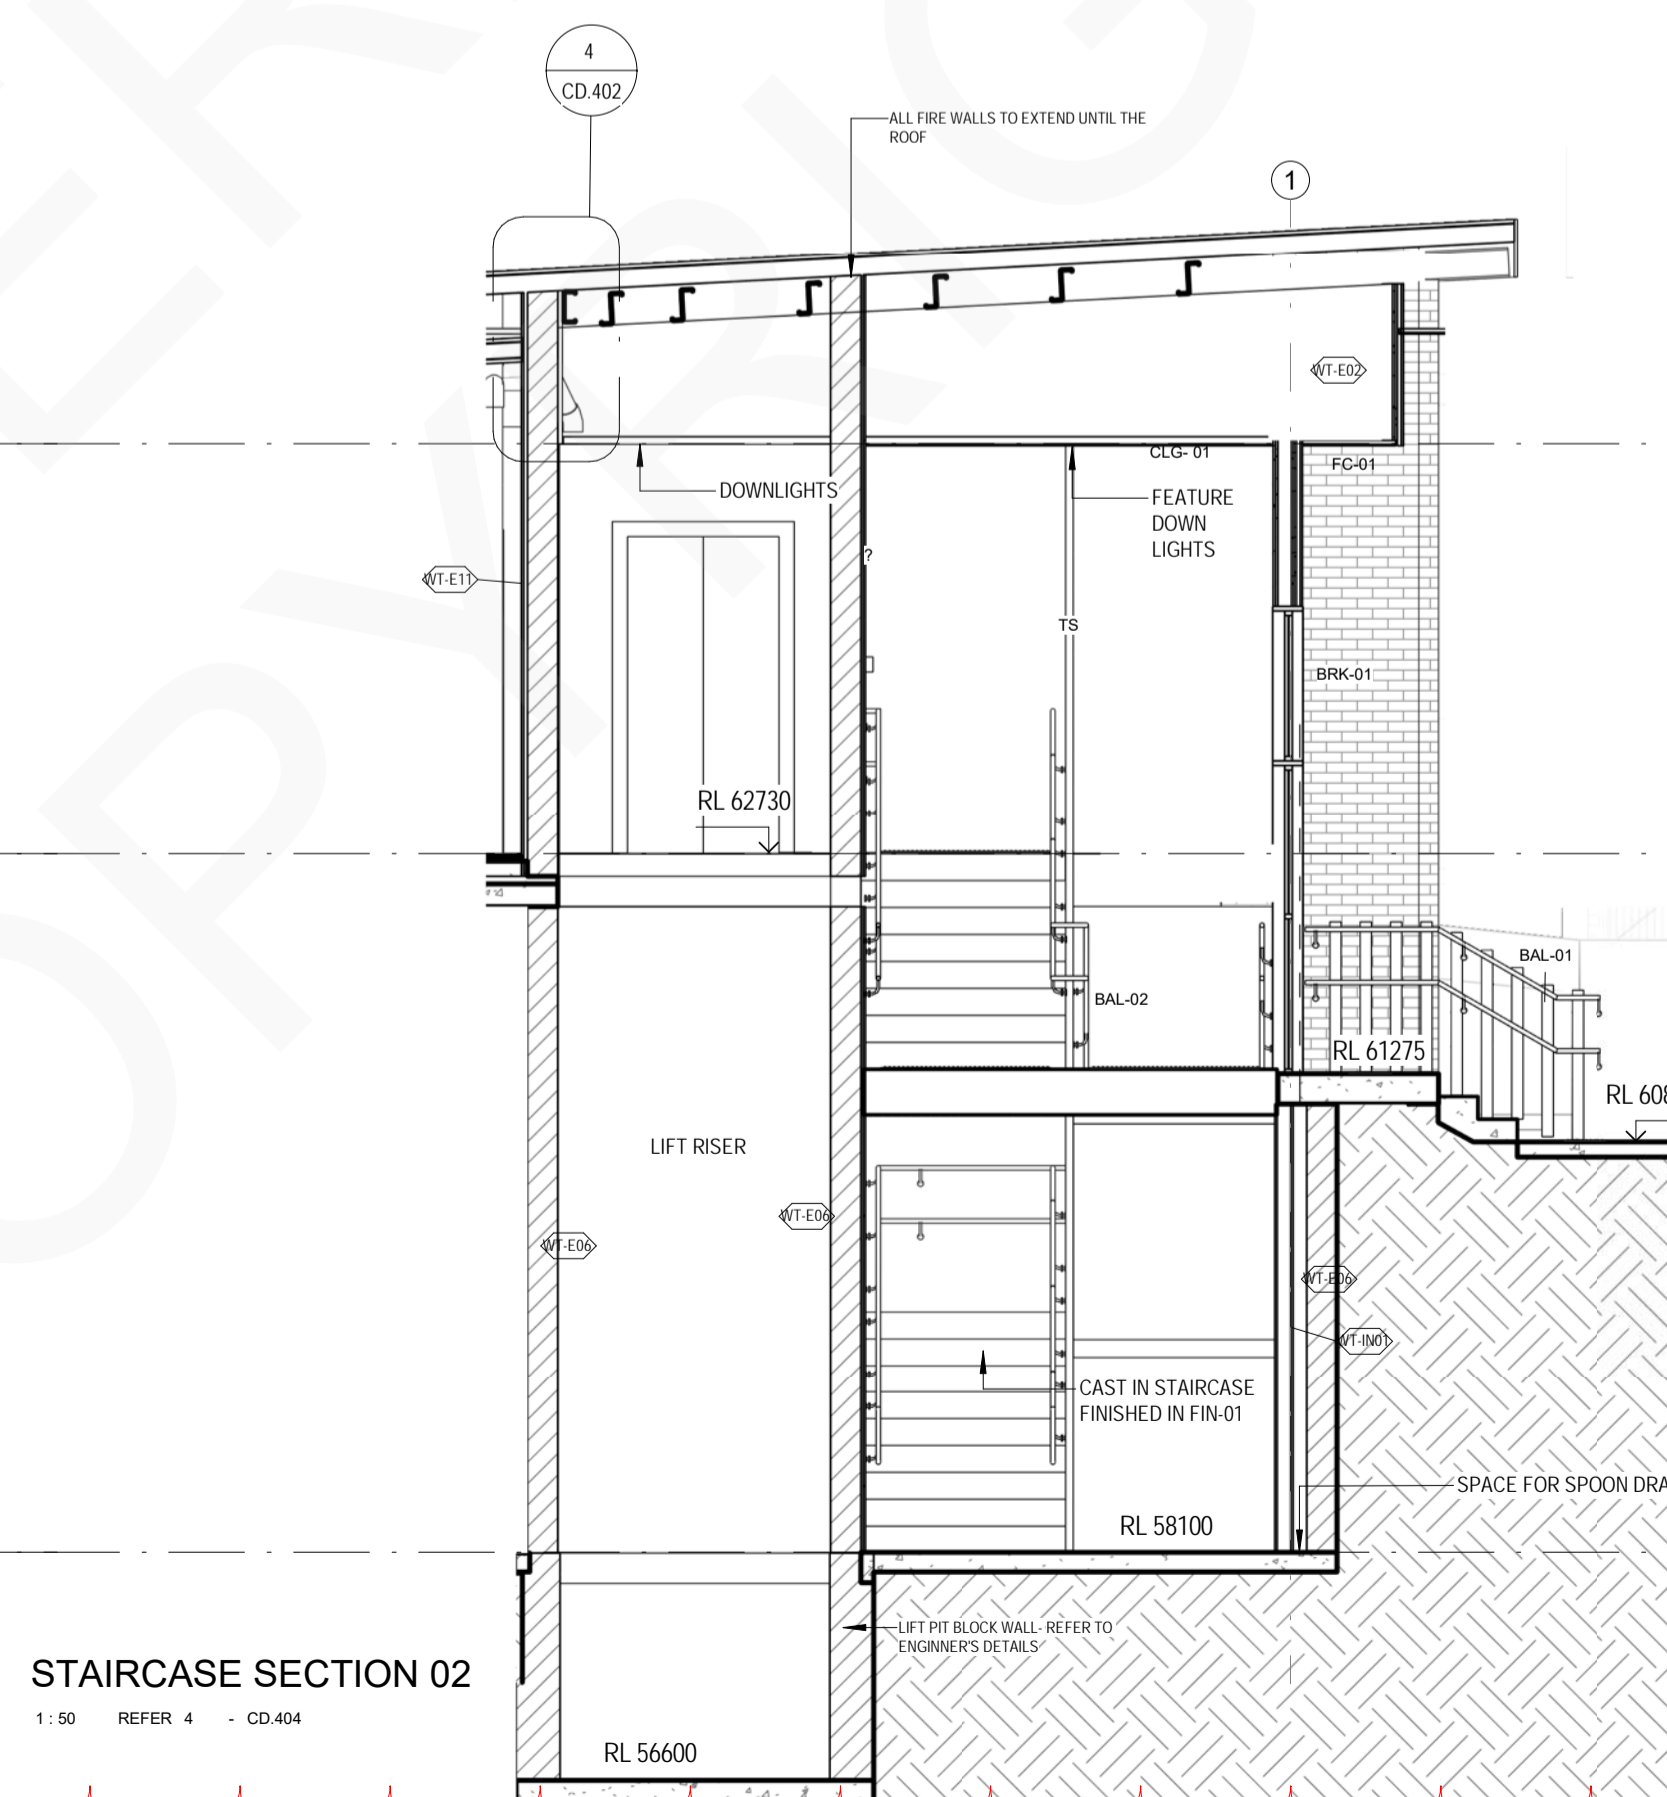

STAIRCASE SECTION 02


1:50 REFER 4 - CD.404

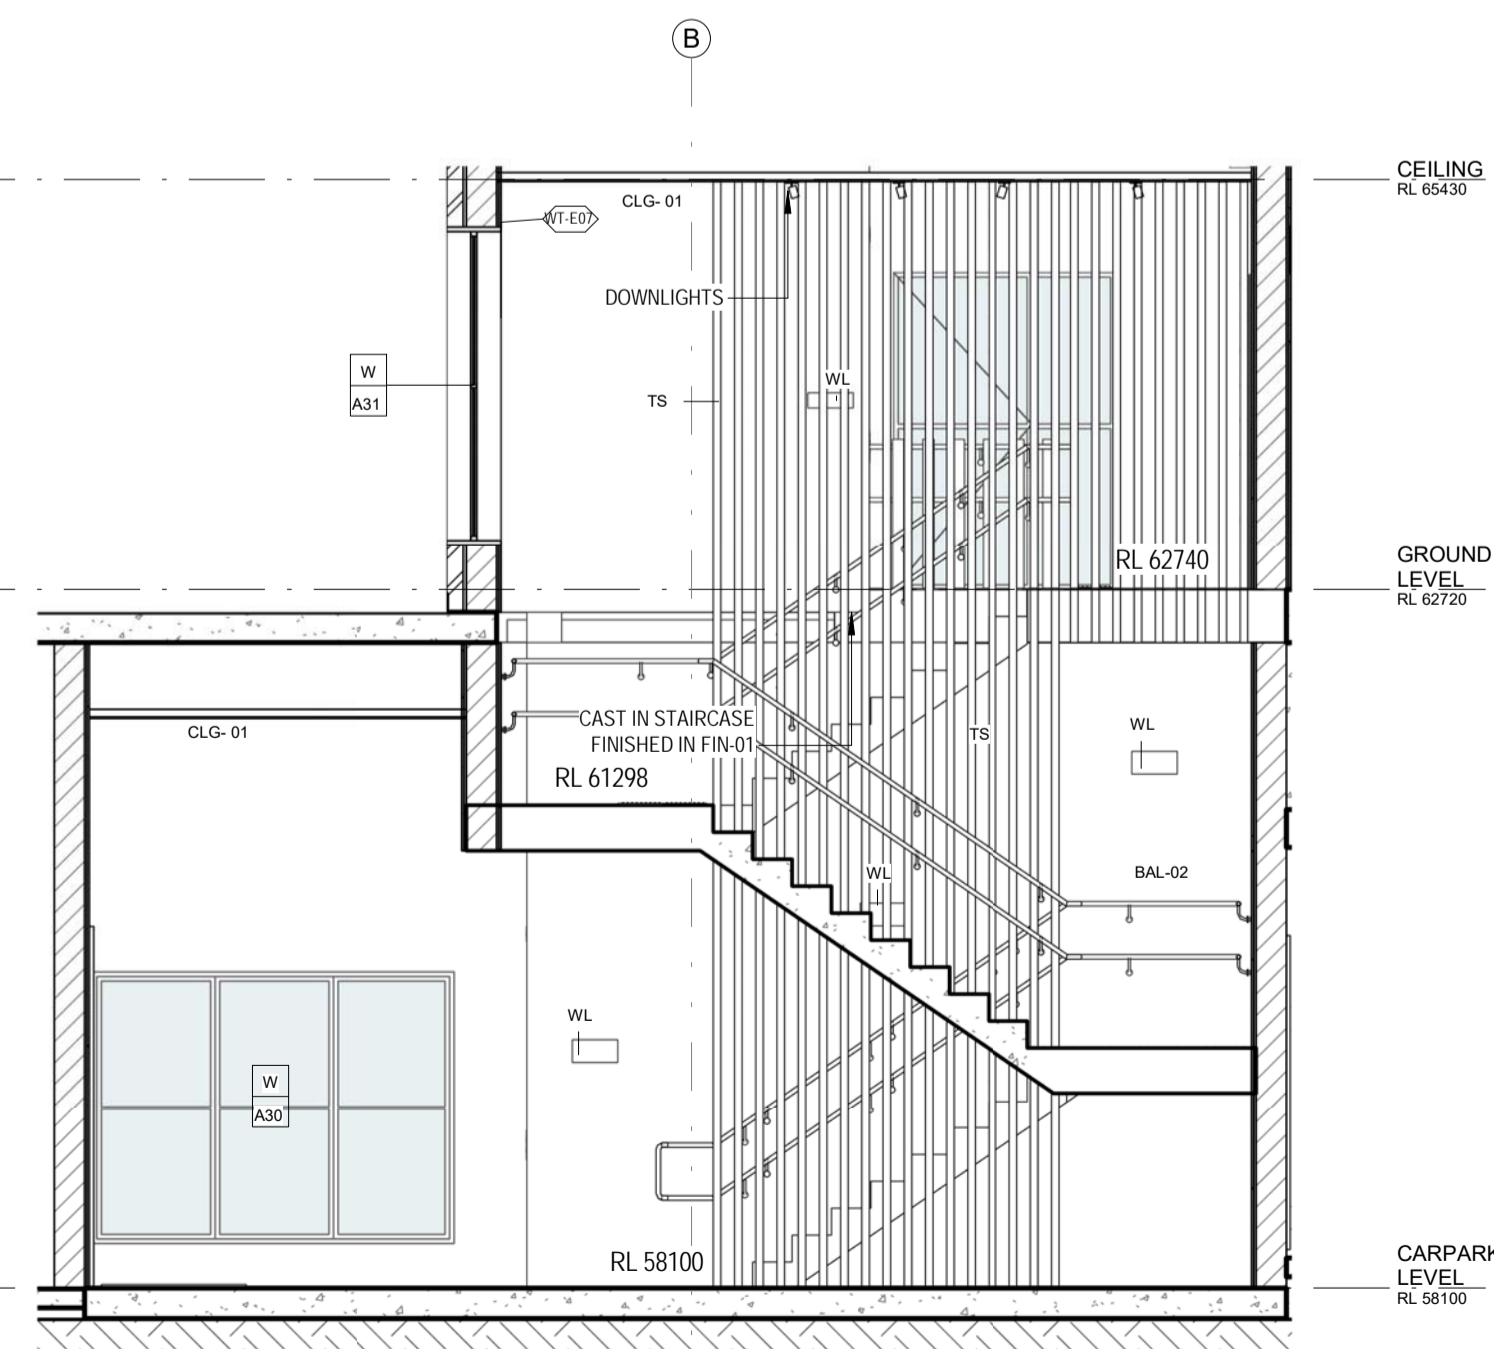

STAIRCASE SECTION 03


1:50 REFER 5 - CD.301

- | | |
|-----------|---|
| AG | AGRICULTURAL PIPE LINE |
| BAL-01 | BALUSTRADE |
| BAL-02 | BALUSTRADE |
| BD | BOLLARD |
| BG | BOX GUTTER |
| BRK-01 | BRICK FACADE |
| BV | BRICK VENEER |
| COL | COLUMN |
| DP | DOWN PIPE |
| EG | EAVES GUTTER |
| FEN-02 | FENCING |
| FEN-02/1 | FIRE HOSE REEL |
| FHR | CONCRETE FINISH |
| FLR CON-1 | FLOOR WASTE GUTTER |
| FWG | GRADED DRAIN SEWAGE |
| GD | GULLY |
| GR-01 | GUARDRAIL 1200MM HIGH |
| GR-02 | GUARDRAIL 1500MM HIGH |
| GR-03 | GUARDRAIL 1800mm HIGH |
| INL | INTAKE LOUVER |
| J | JOINERY |
| LO | HORIZONTAL CLADDING |
| LO | LOCKER |
| MH | MANHOLE |
| OHF | OVERHEAD FLASHING |
| PLD | PLANTING DRAIN |
| PNT-01 | PAINT EXTERIOR |
| PNT-03 | PAINT EXTERIOR OVER CONCRETE |
| PNT-04 | ROOF PAINT |
| RFS01 | METAL ROOF STRUCTURE |
| RFS02 | SOLARSPAN SANDWICH PANEL |
| RM | RECESSED ENTRY MAT |
| RP | REFRIGERANT PIPES |
| TGSI | TACTILE INDICATORS TO AS 1428 |
| TR | TROUGH |
| TS | TIMBERLOOK ALUMINIUM BATTEN SCREEN |
| TWH | TWIN HYDRANT |
| WL | WALL LIGHT ABOVE 1500MM FROM STAIR THREAD FFL |
| WS | WHEEL STOP |

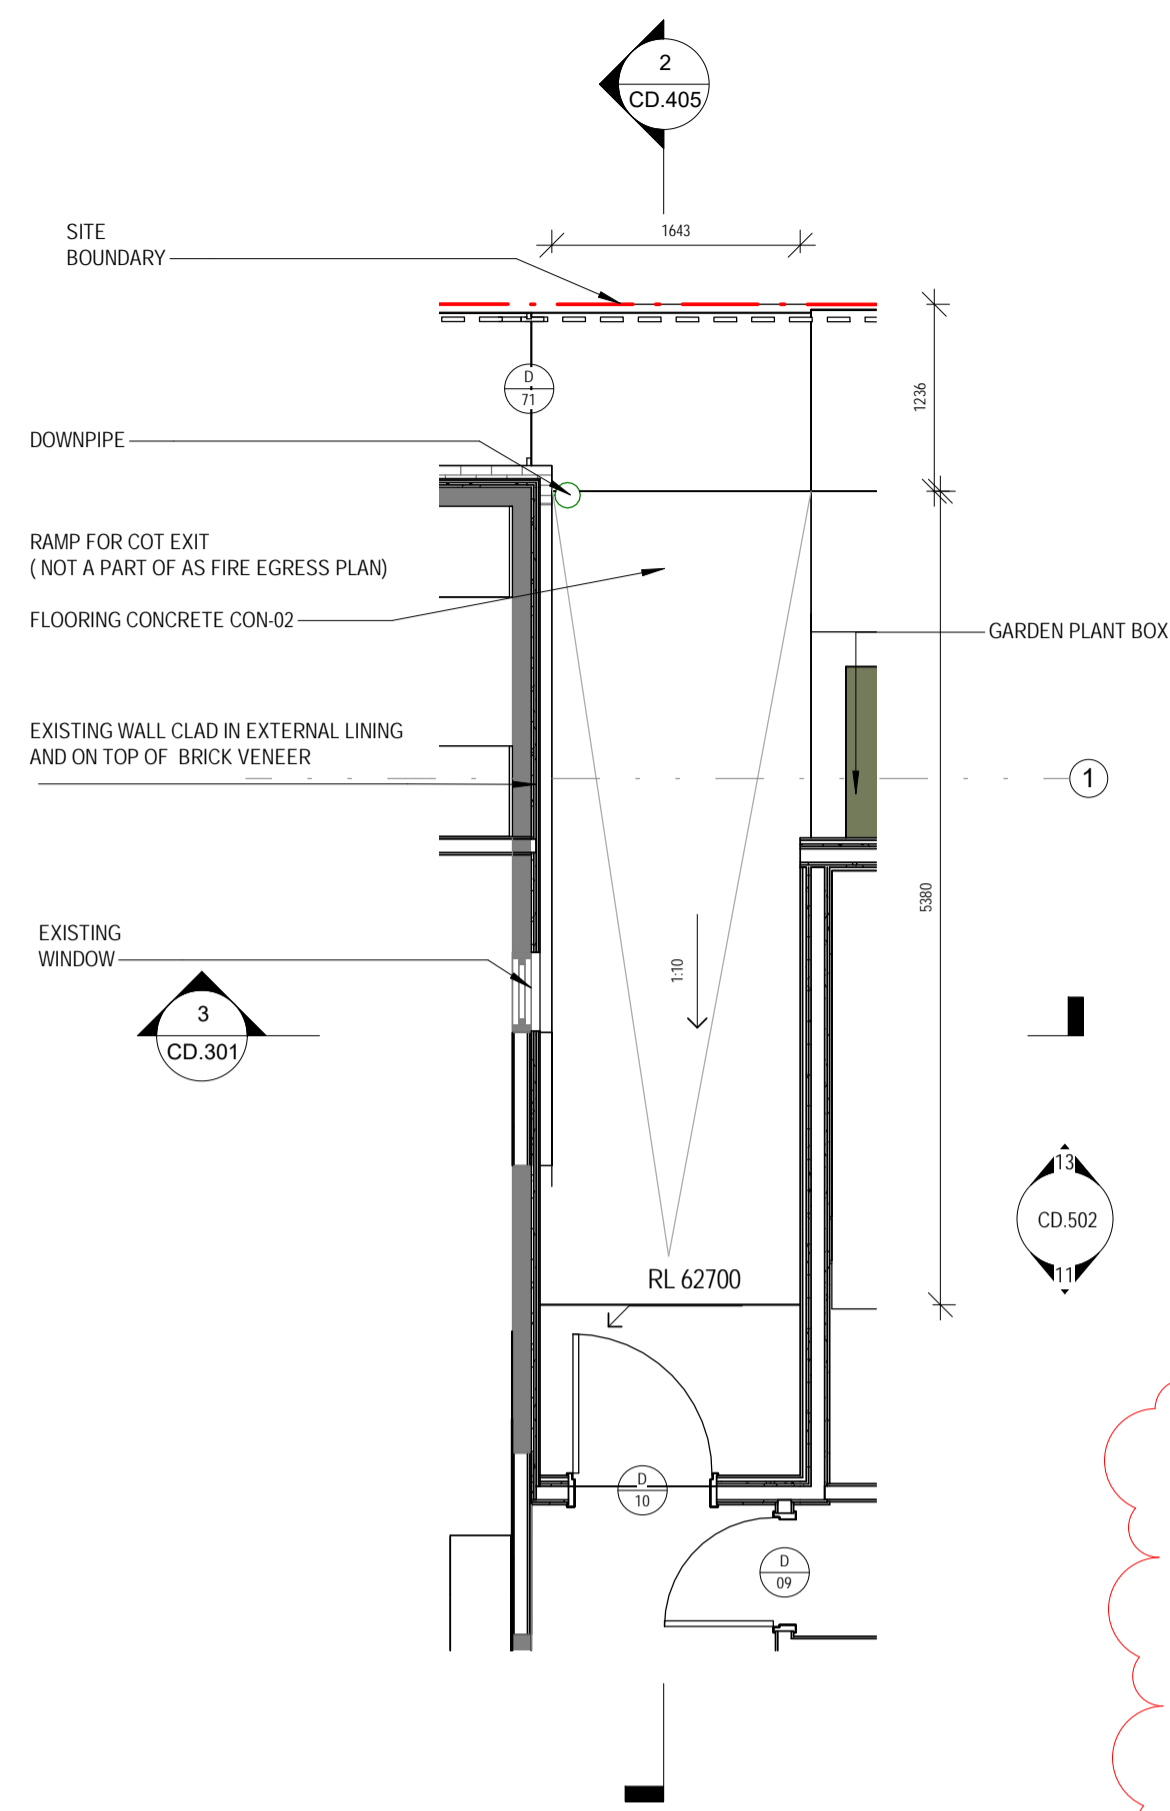


RAMP FLOOR PLAN

REFER 1 - CD 104A

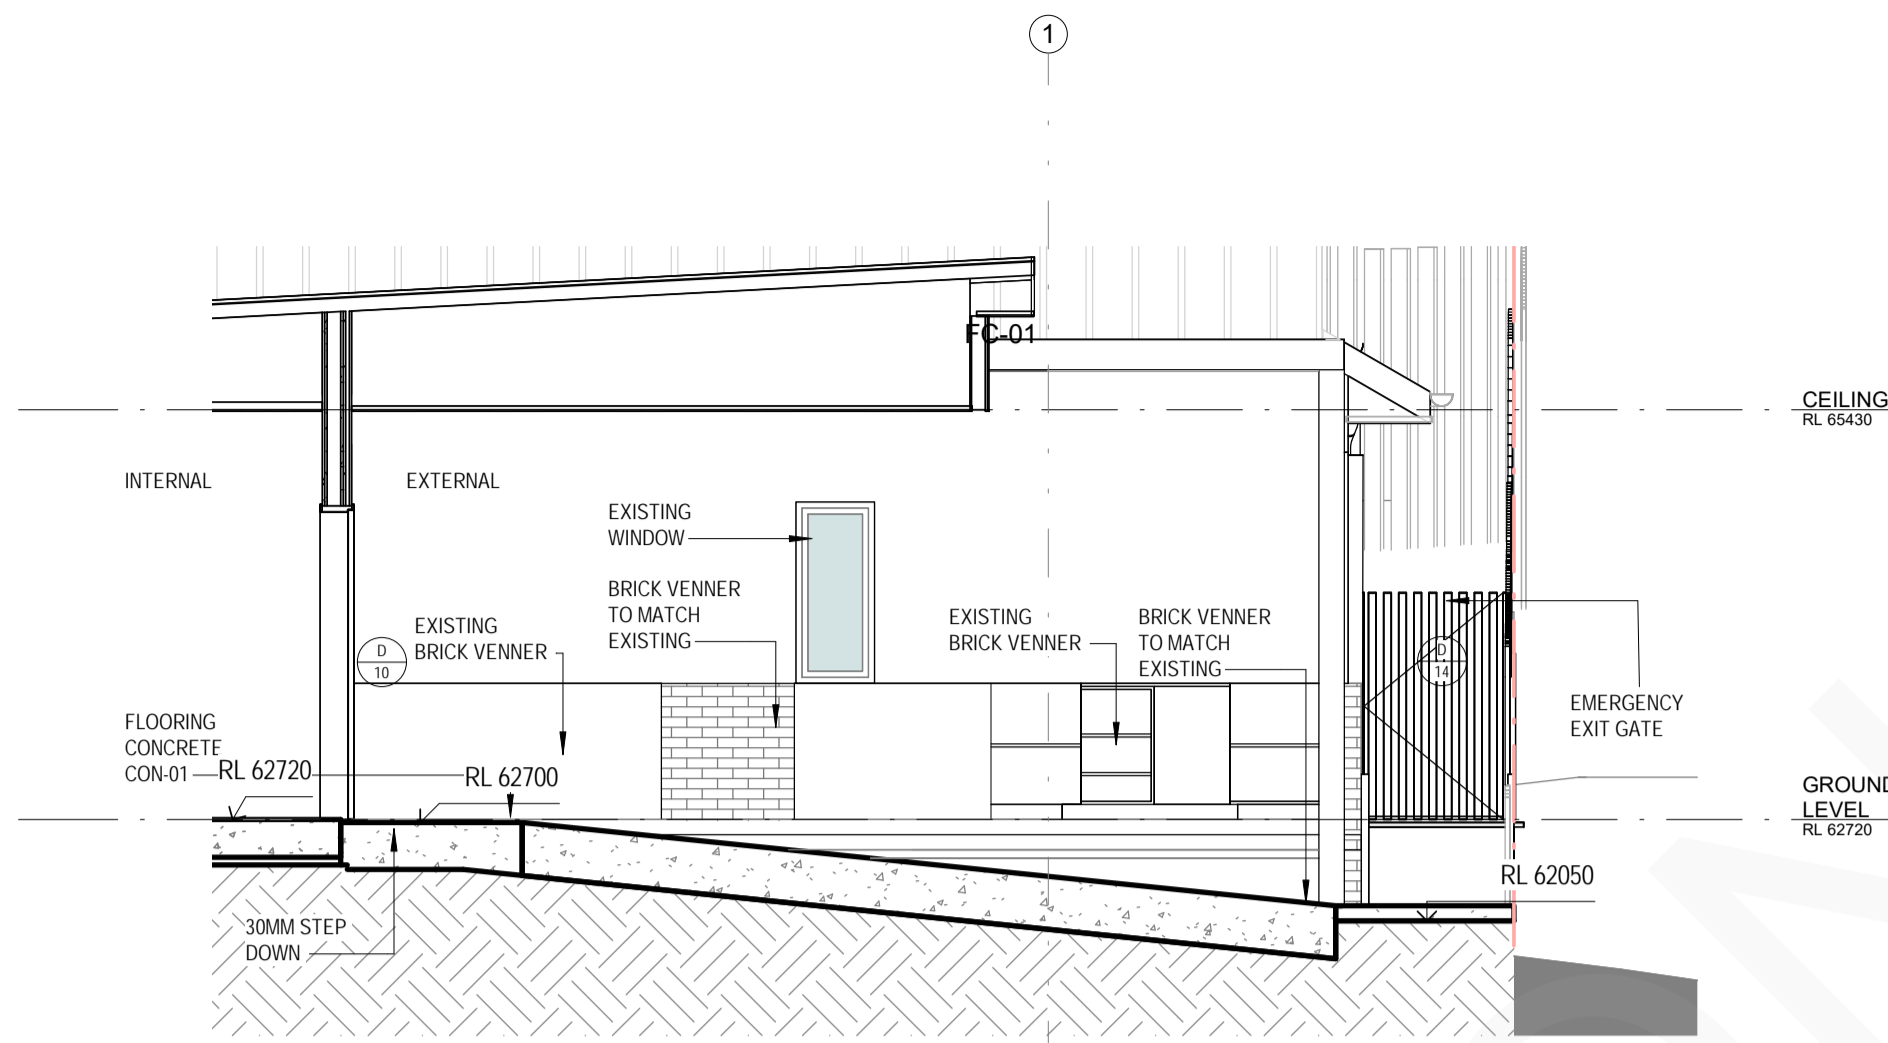


RAMP SECTION DETAIL

1:50 REFER 2 - CD 405

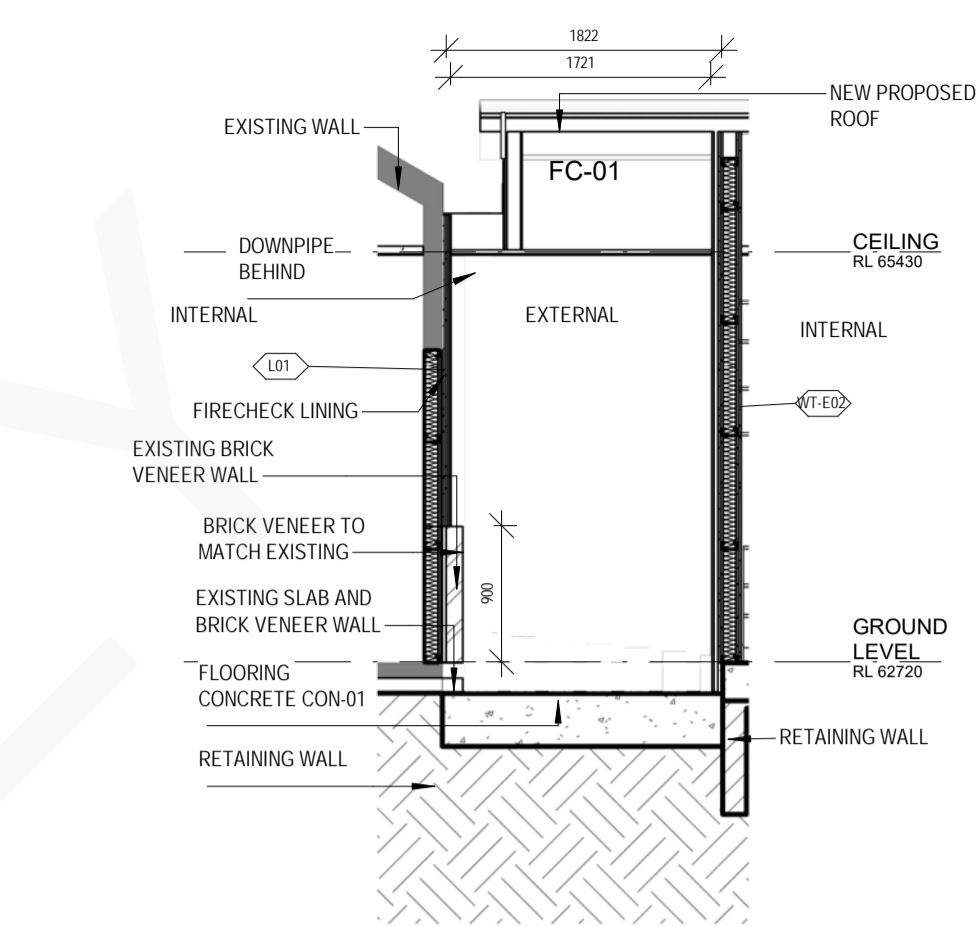


RAMP CROSS SECTION

REFER 3 -

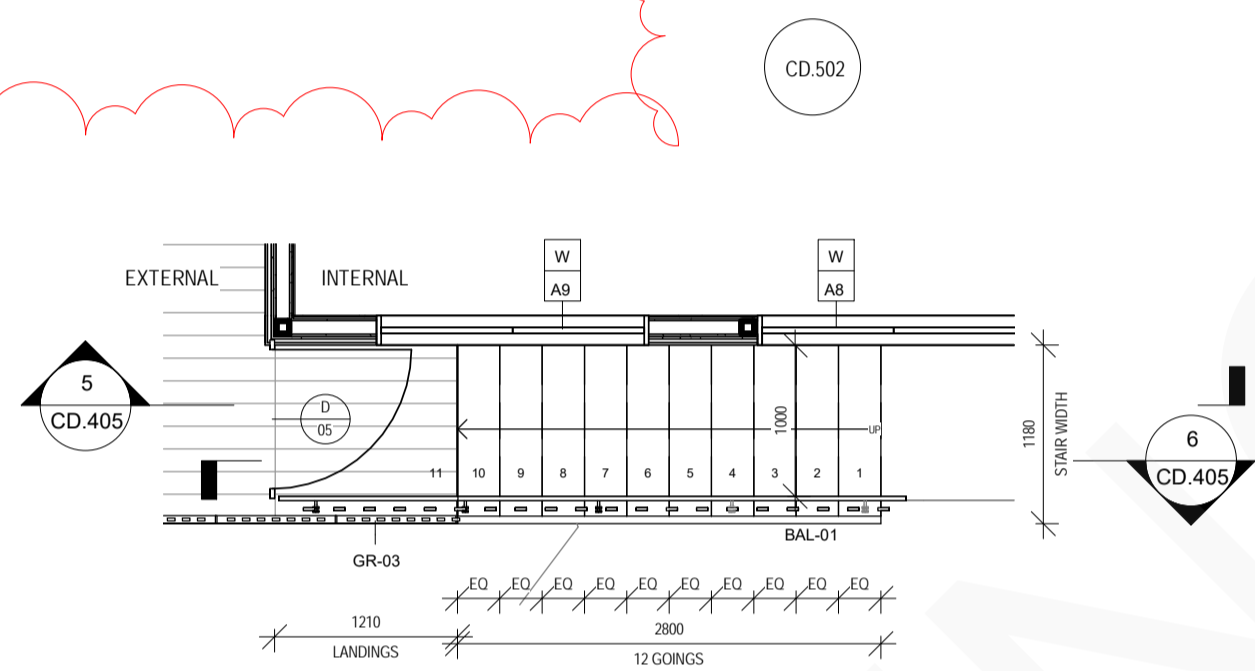


EXTERNAL STAIRCASE FLOOR PLAN

1:50 REFER 4 - CD 104B

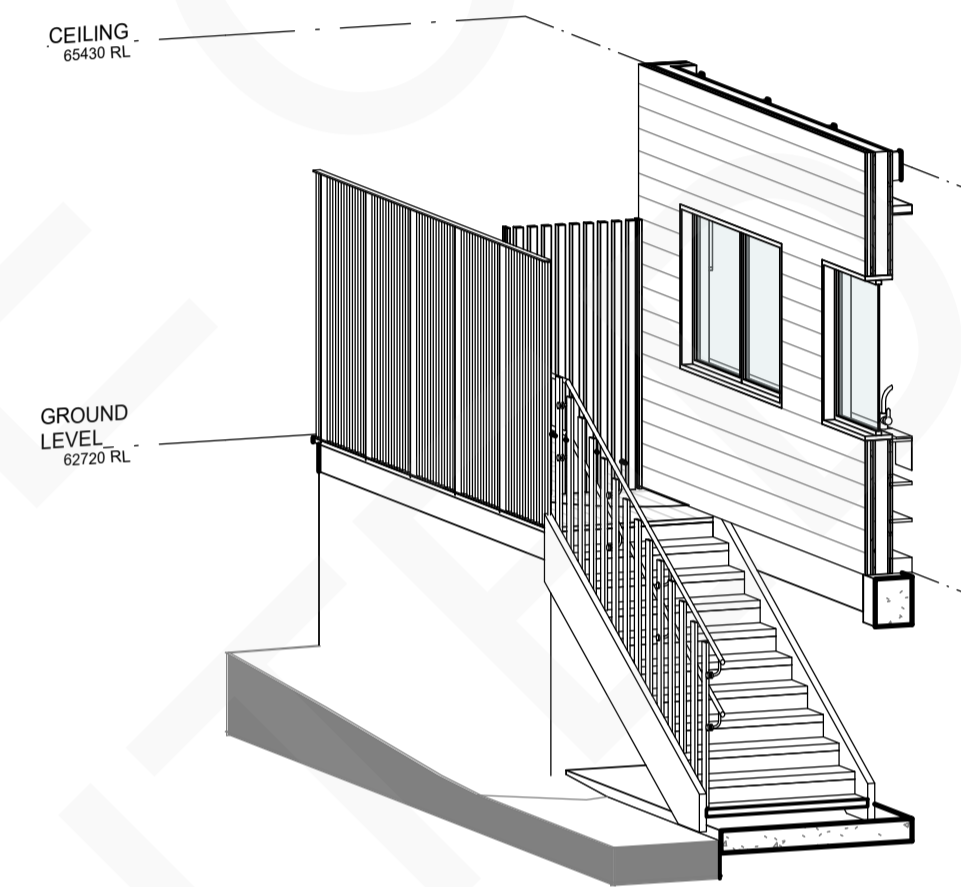


EXTERNAL STAIRCASE PERSPECTIVE

REFER 7 -

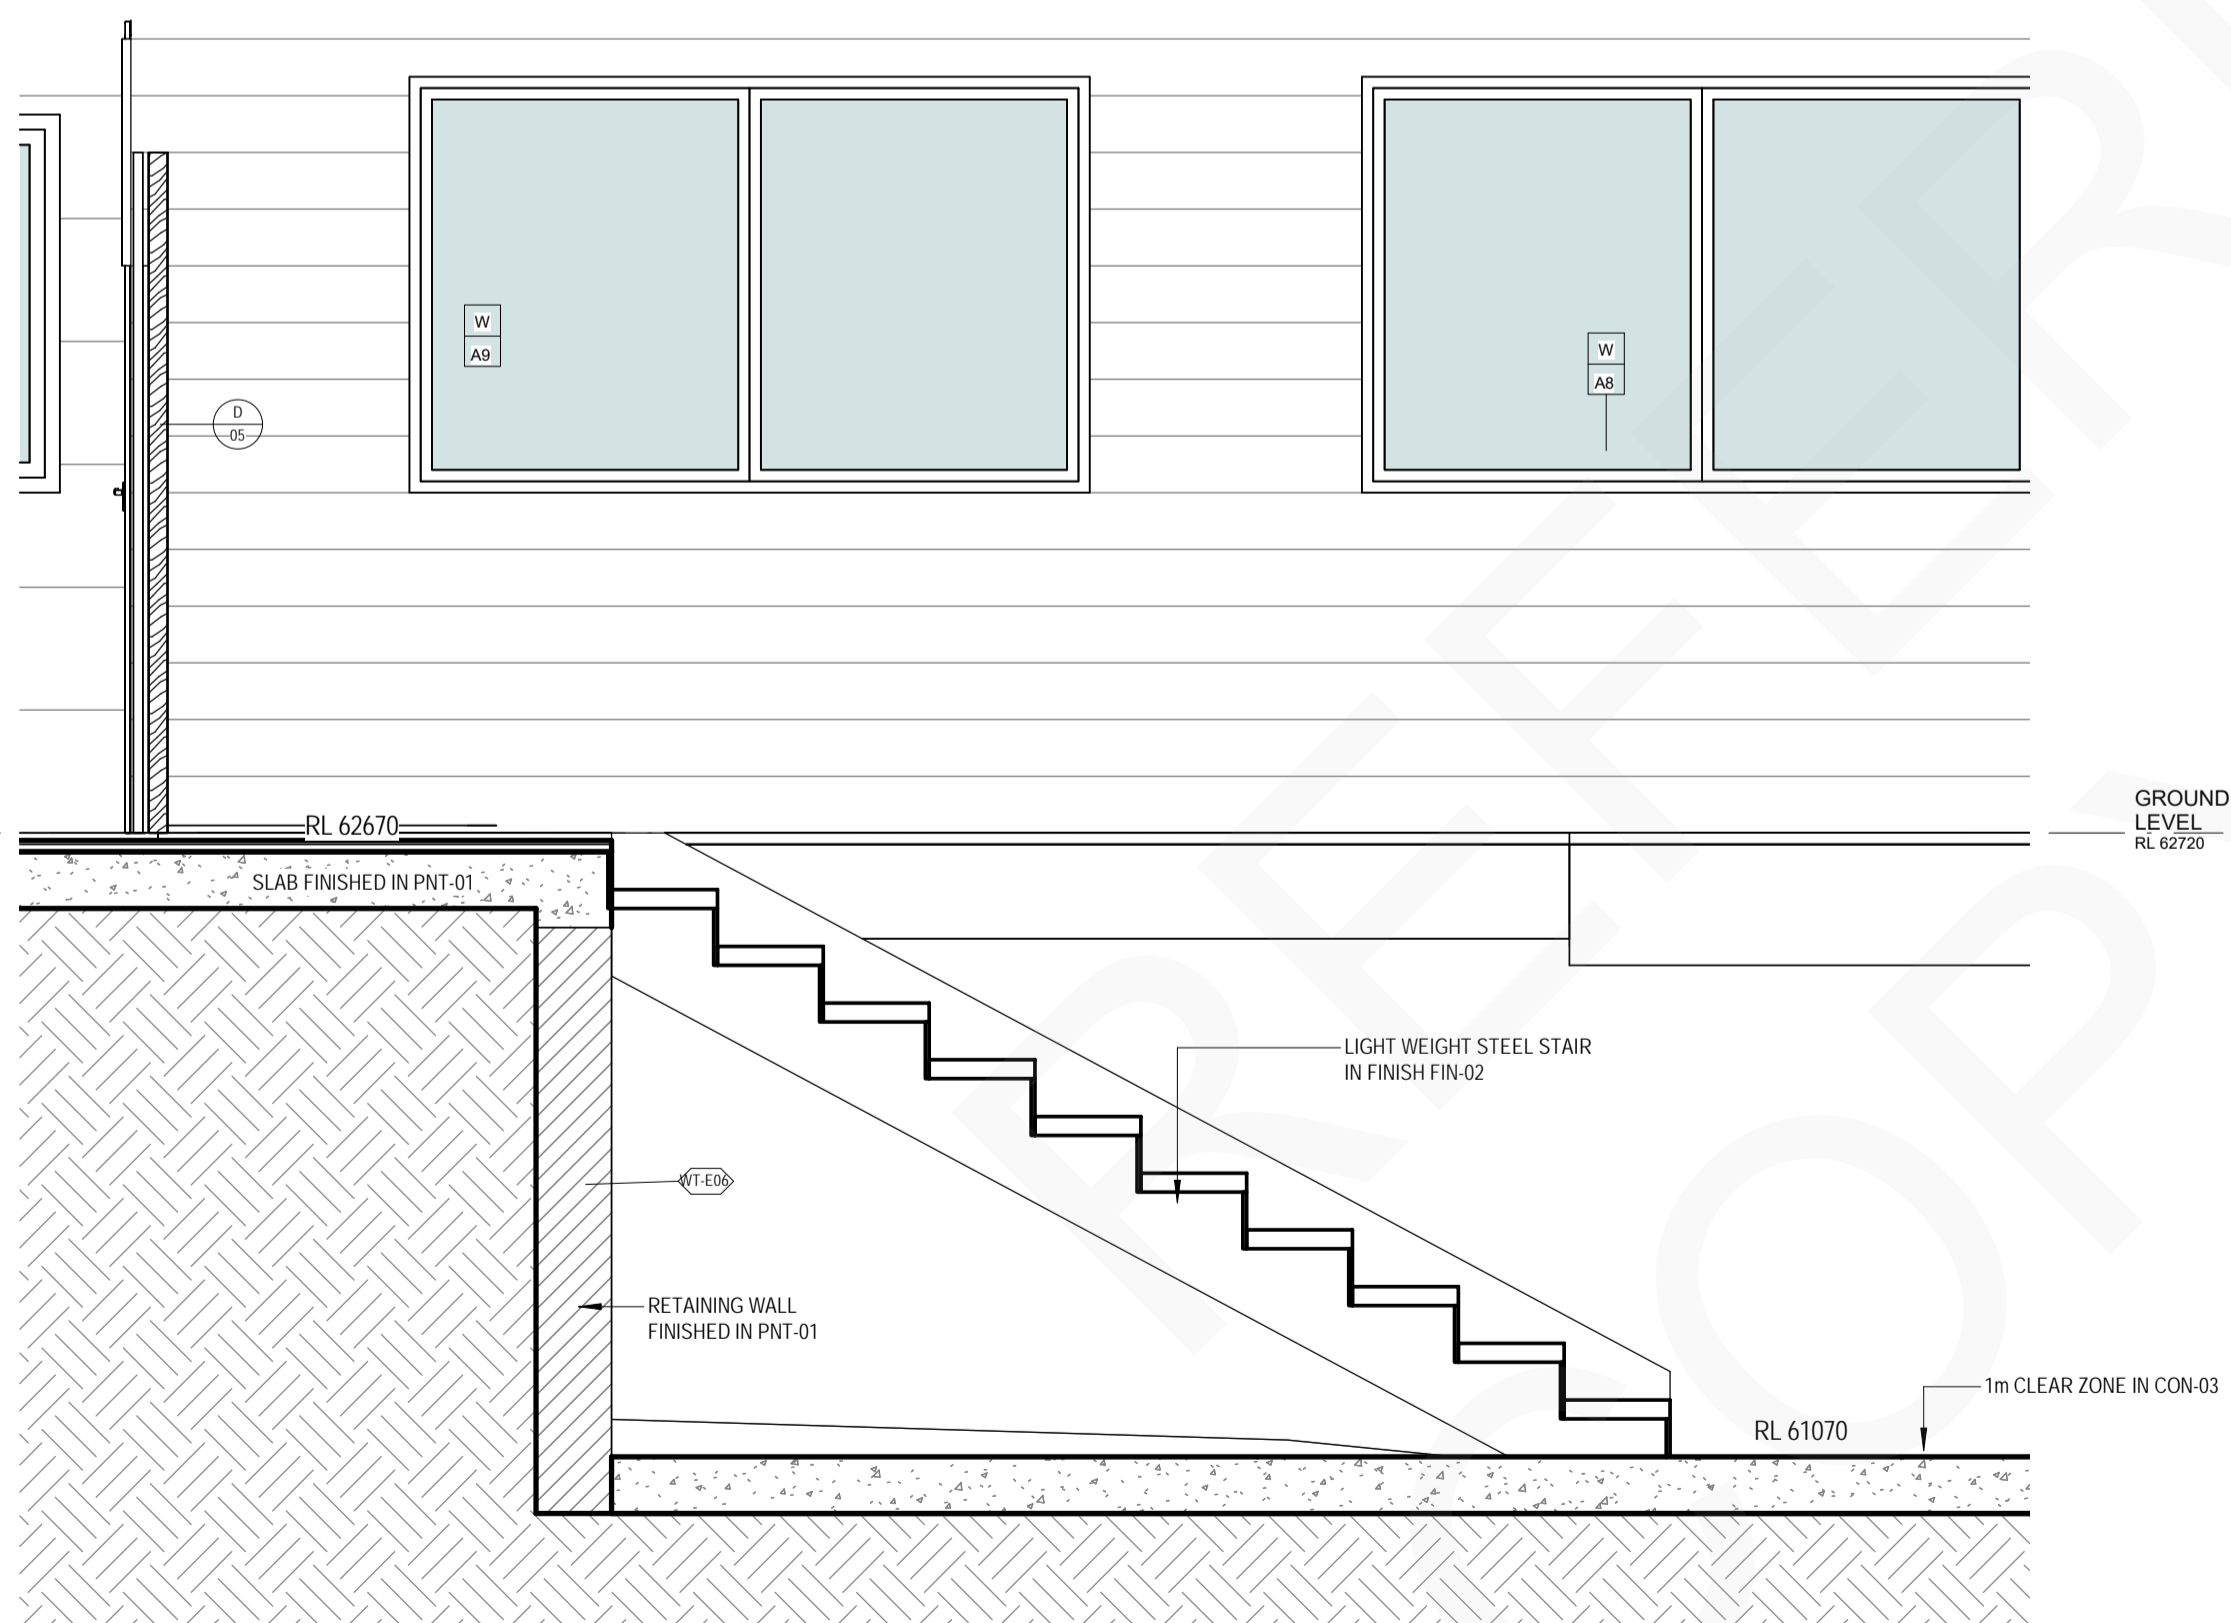

EXTERNAL STAIRCASE SECTION 1


1:20 REFER 5 - CD 405

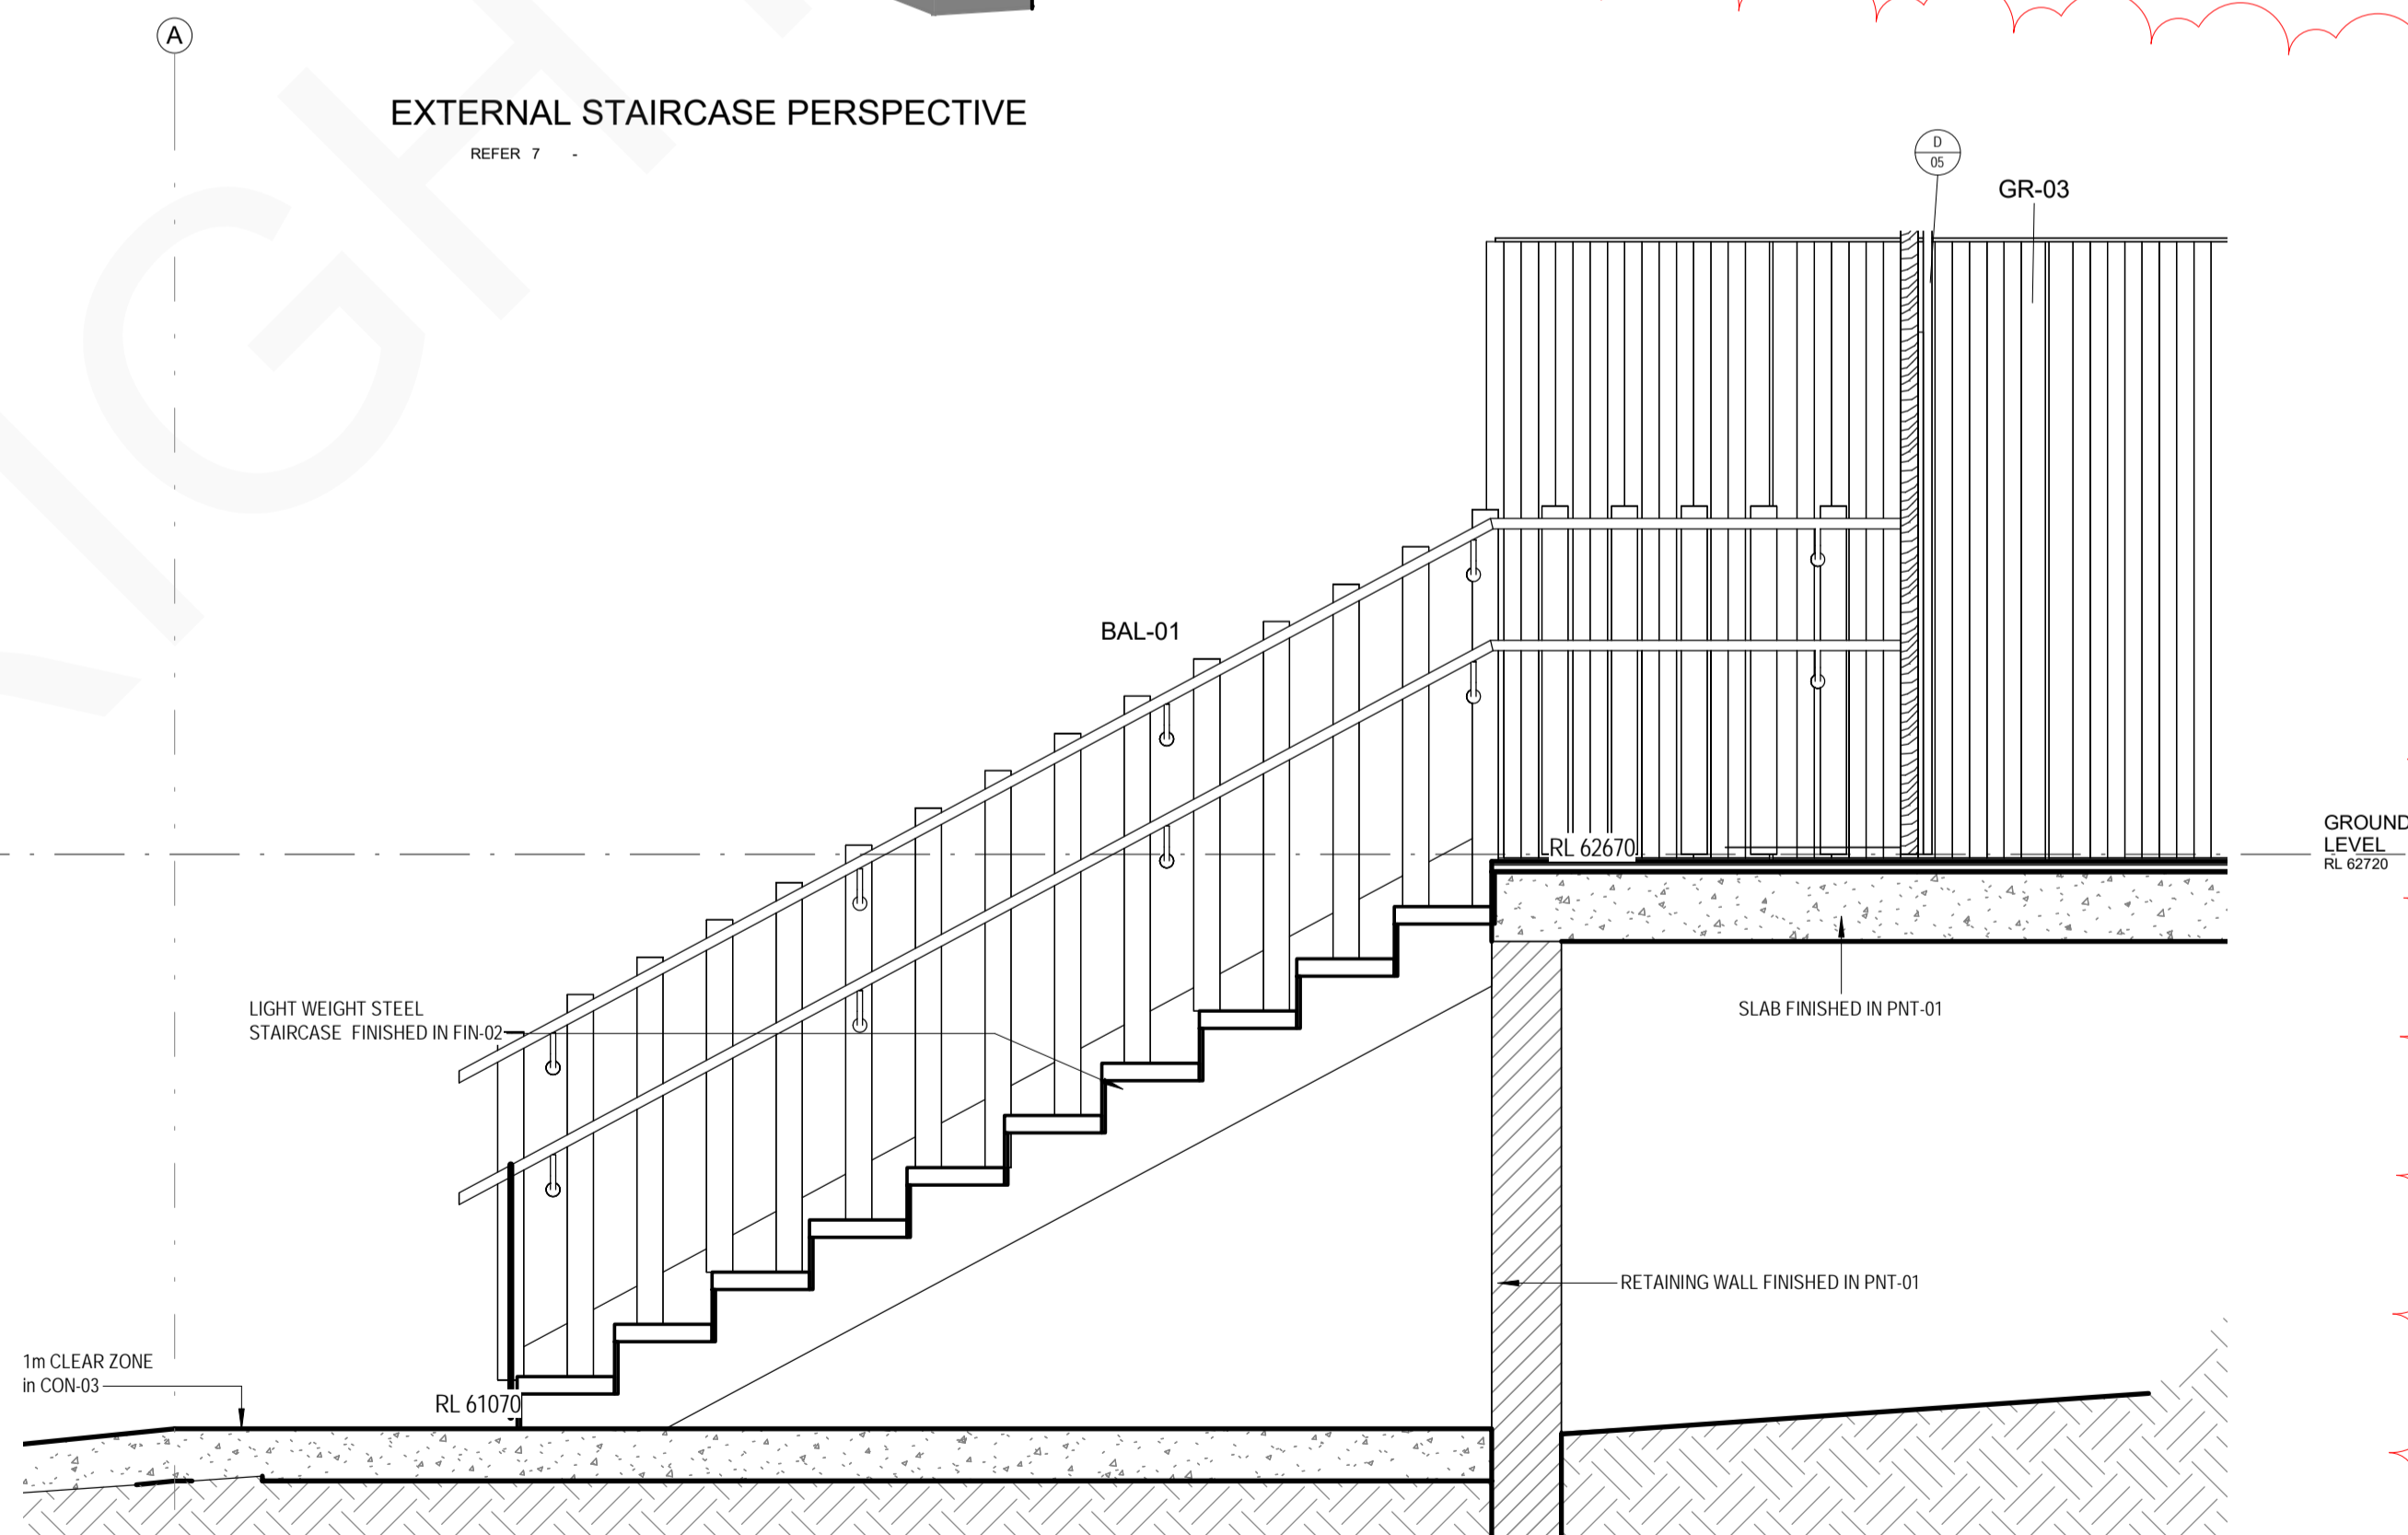

EXTERNAL STAIRCASE SECTION 2


1:20 REFER 6 - CD 405

AG	AGRICULTURAL PIPE LINE
BAL-01	BALUSTRADE
BAL-02	BALUSTRADE
BAT-03	BALUSTRADE
BD	BOLLARD
BG	BOX GUTTER
BRK-01	BRICK FACADE
BV	BRICK VENEER
COL	COLUMN
DP	DOWN PIPE
EG	EAVES GUTTER
FEN-02	FENCING
FEN-02/1	FENCING
FHR	FIRE HOSE REEL
FLR CON-1	CONCRETE FINISH
FWG	FLOOR WASTE GUTTER
GD	GRADED DRAIN SEWAGE GULLY
GR-01	GUARDRAIL 1200MM HIGH
GR-02	GUARDRAIL 1500MM HIGH
GR-03	GUARDRAIL 1800MM HIGH
INL	INTAKE LOUVRE
J	JOINERY
LN-01	HORIZONTAL CLADDING
LO	LOCKER
MH	MANHOLE
OHF	OVERHEAD FLASHING
PLD	PLANTING DRAIN
PNT-01	PAINT EXTERIOR
PNT-03	PAINT EXTERIOR OVER CONCRETE
PNT-04	ROOF PAINT
RFS01	METAL ROOF STRUCTURE
RFS02	SOLARSPAN SANDWICH PANEL
RM	RECESSED ENTRY MAT
RP	REFRIGERANT PIPES
TGSI	TACTILE INDICATORS TO AS 1428
TR	TROUGH
TS	TIMBERLOOK ALUMINIUM BATTEN SCREEN
TWH	TWIN HYDRANT
WL	WALL LIGHT ABOVE 1500MM FROM STAIR THREAD FFL
WS	WHEEL STOP

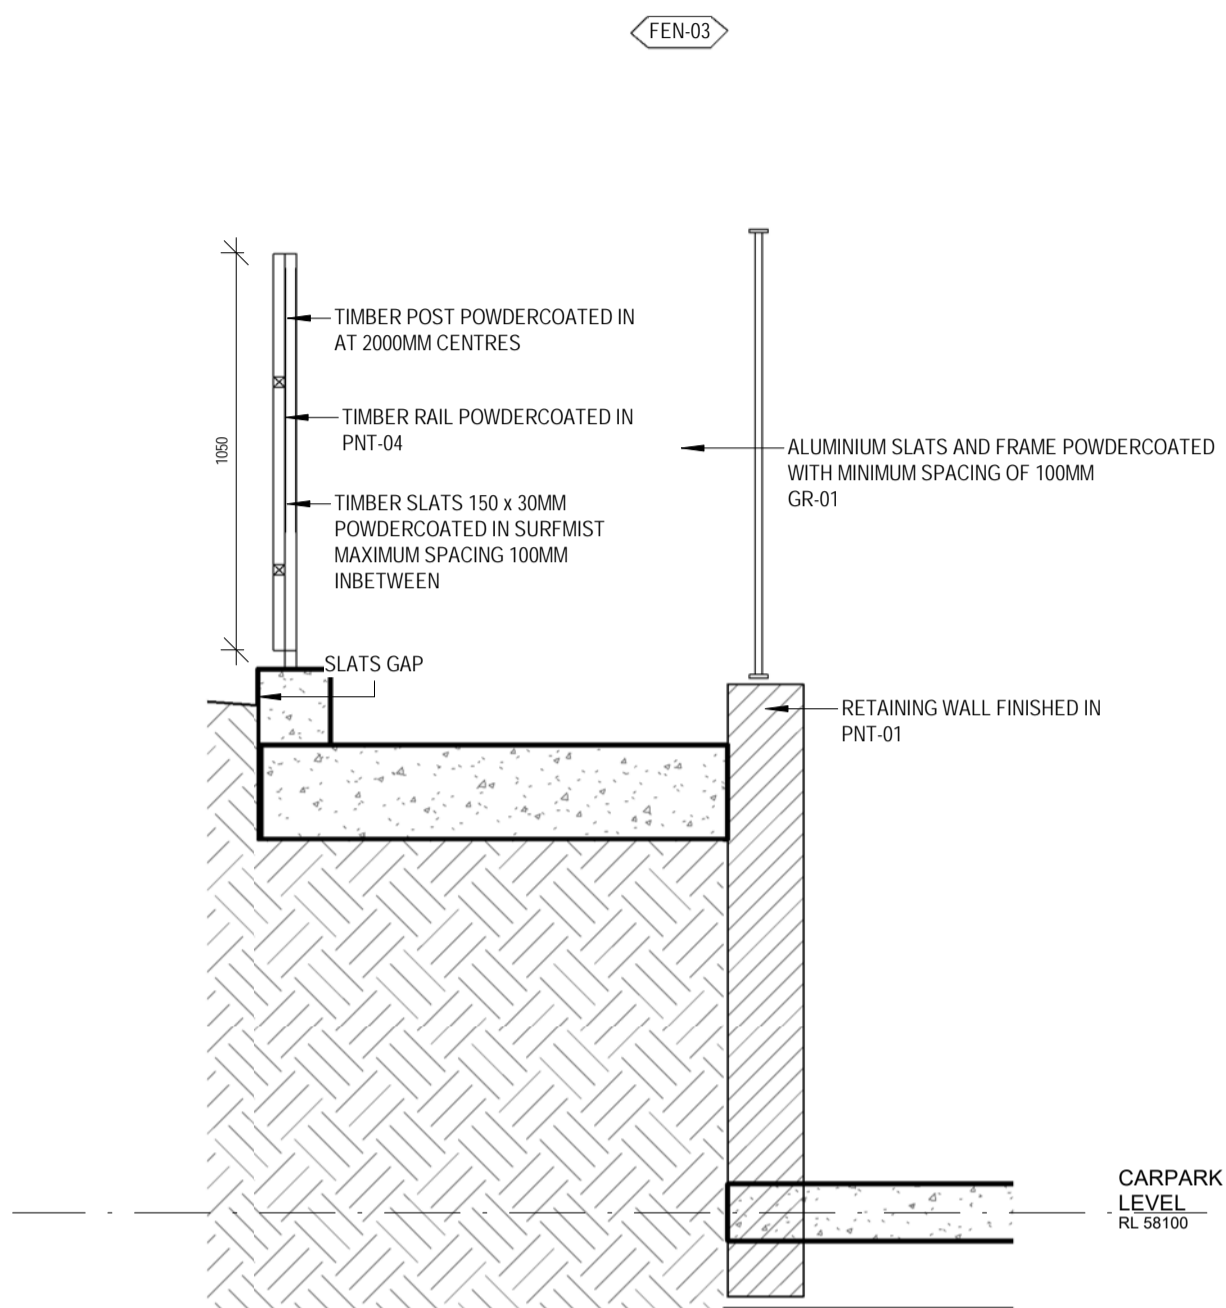


FENCE FEN-03 AND FENCE GR-01 SECTION

1:20 REFER 2 - CD.406

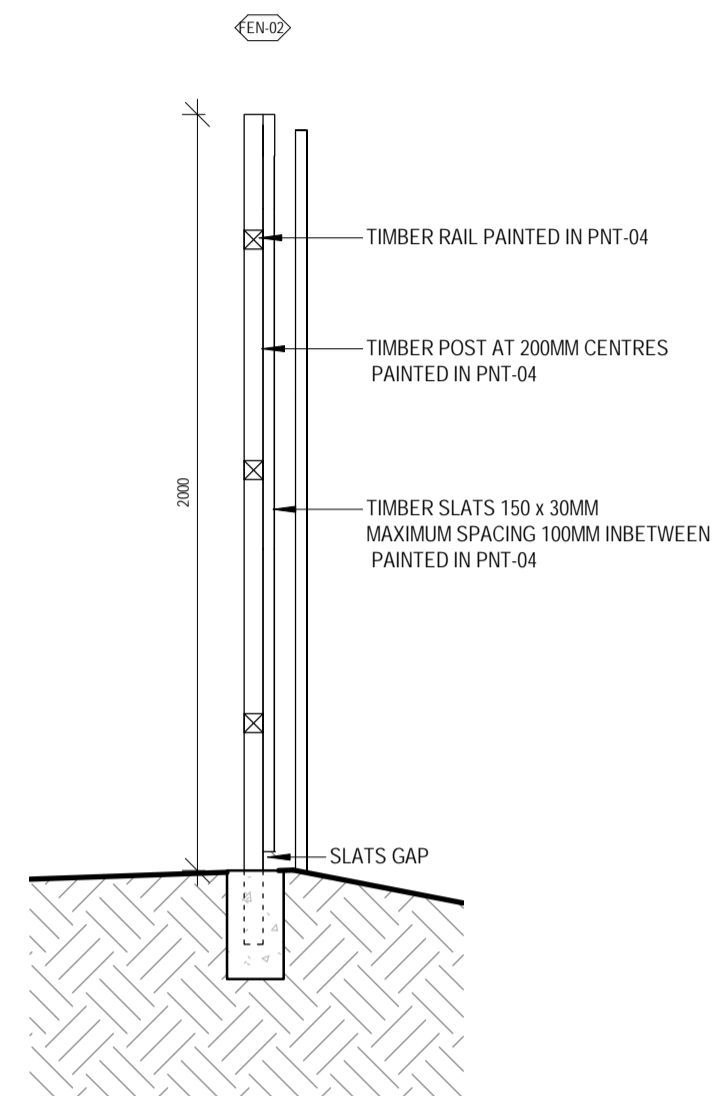


FENCE FEN-02 SECTION

1:20 REFER 4 - CD.406

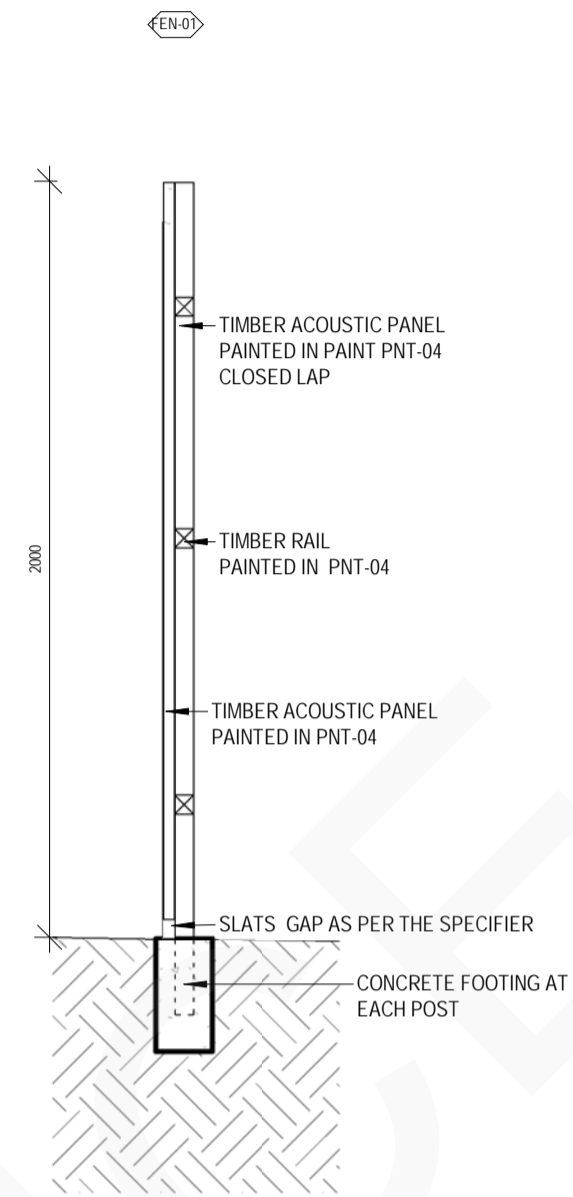


ACOUSTIC FENCE FEN-01 SECTION

1:20 REFER 3 - CD.406

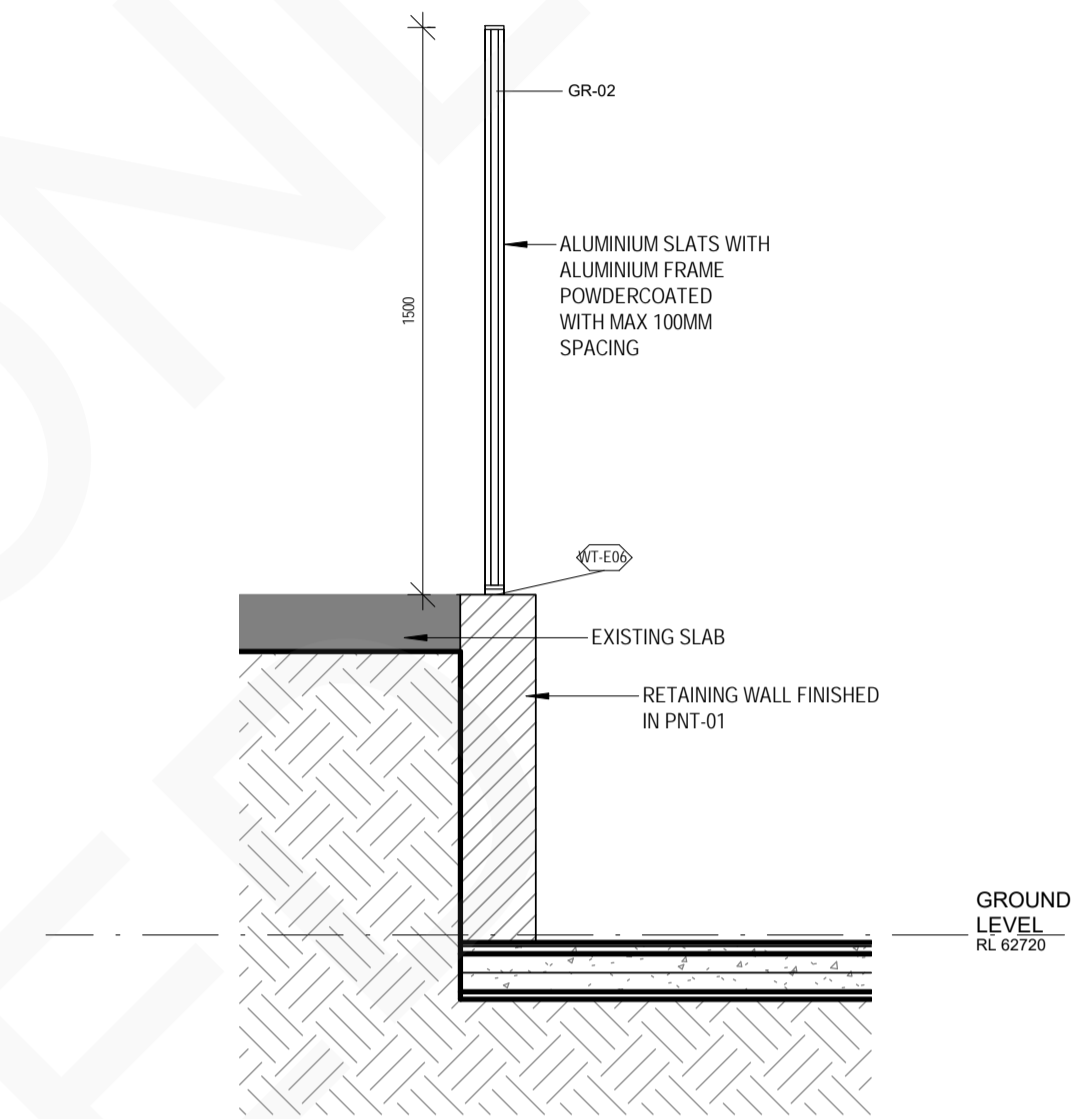


FENCE GR-02 SECTION

1:20 REFER 6 - CD.104A

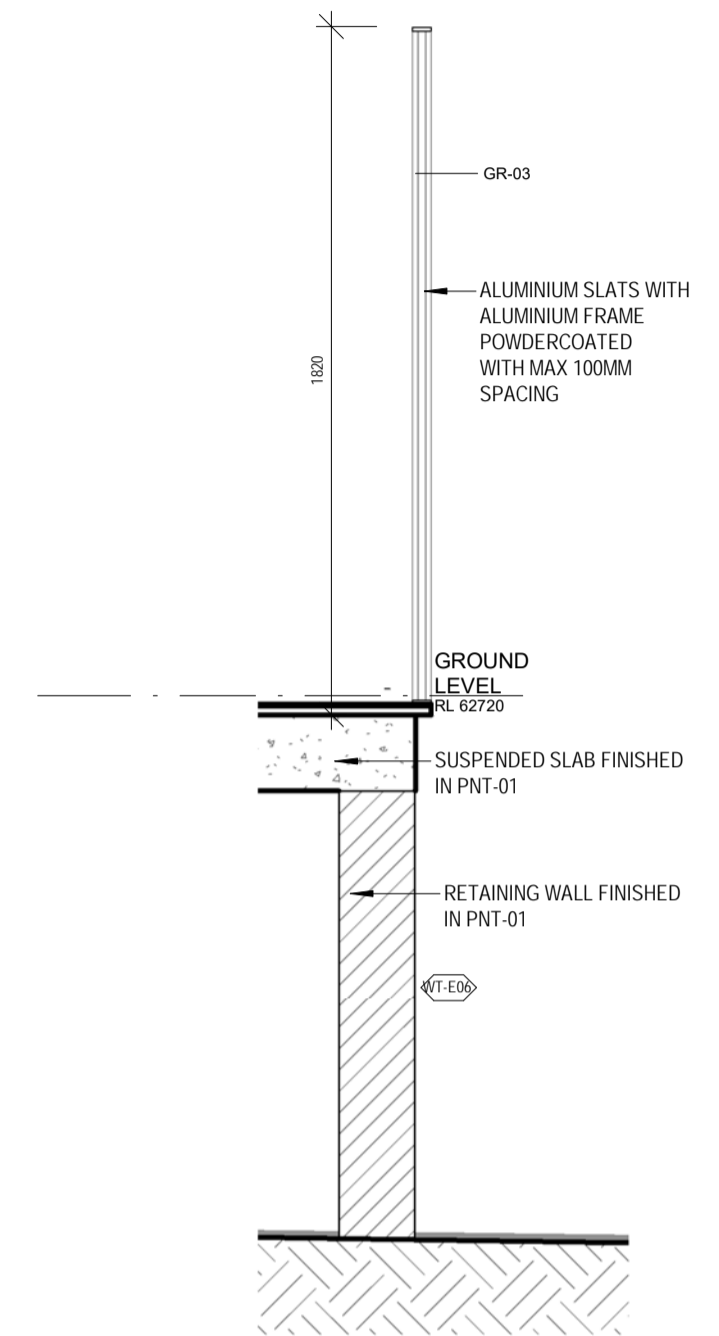






RAIL GR-03 SECTION

1:20 REFER 5 - CD.406

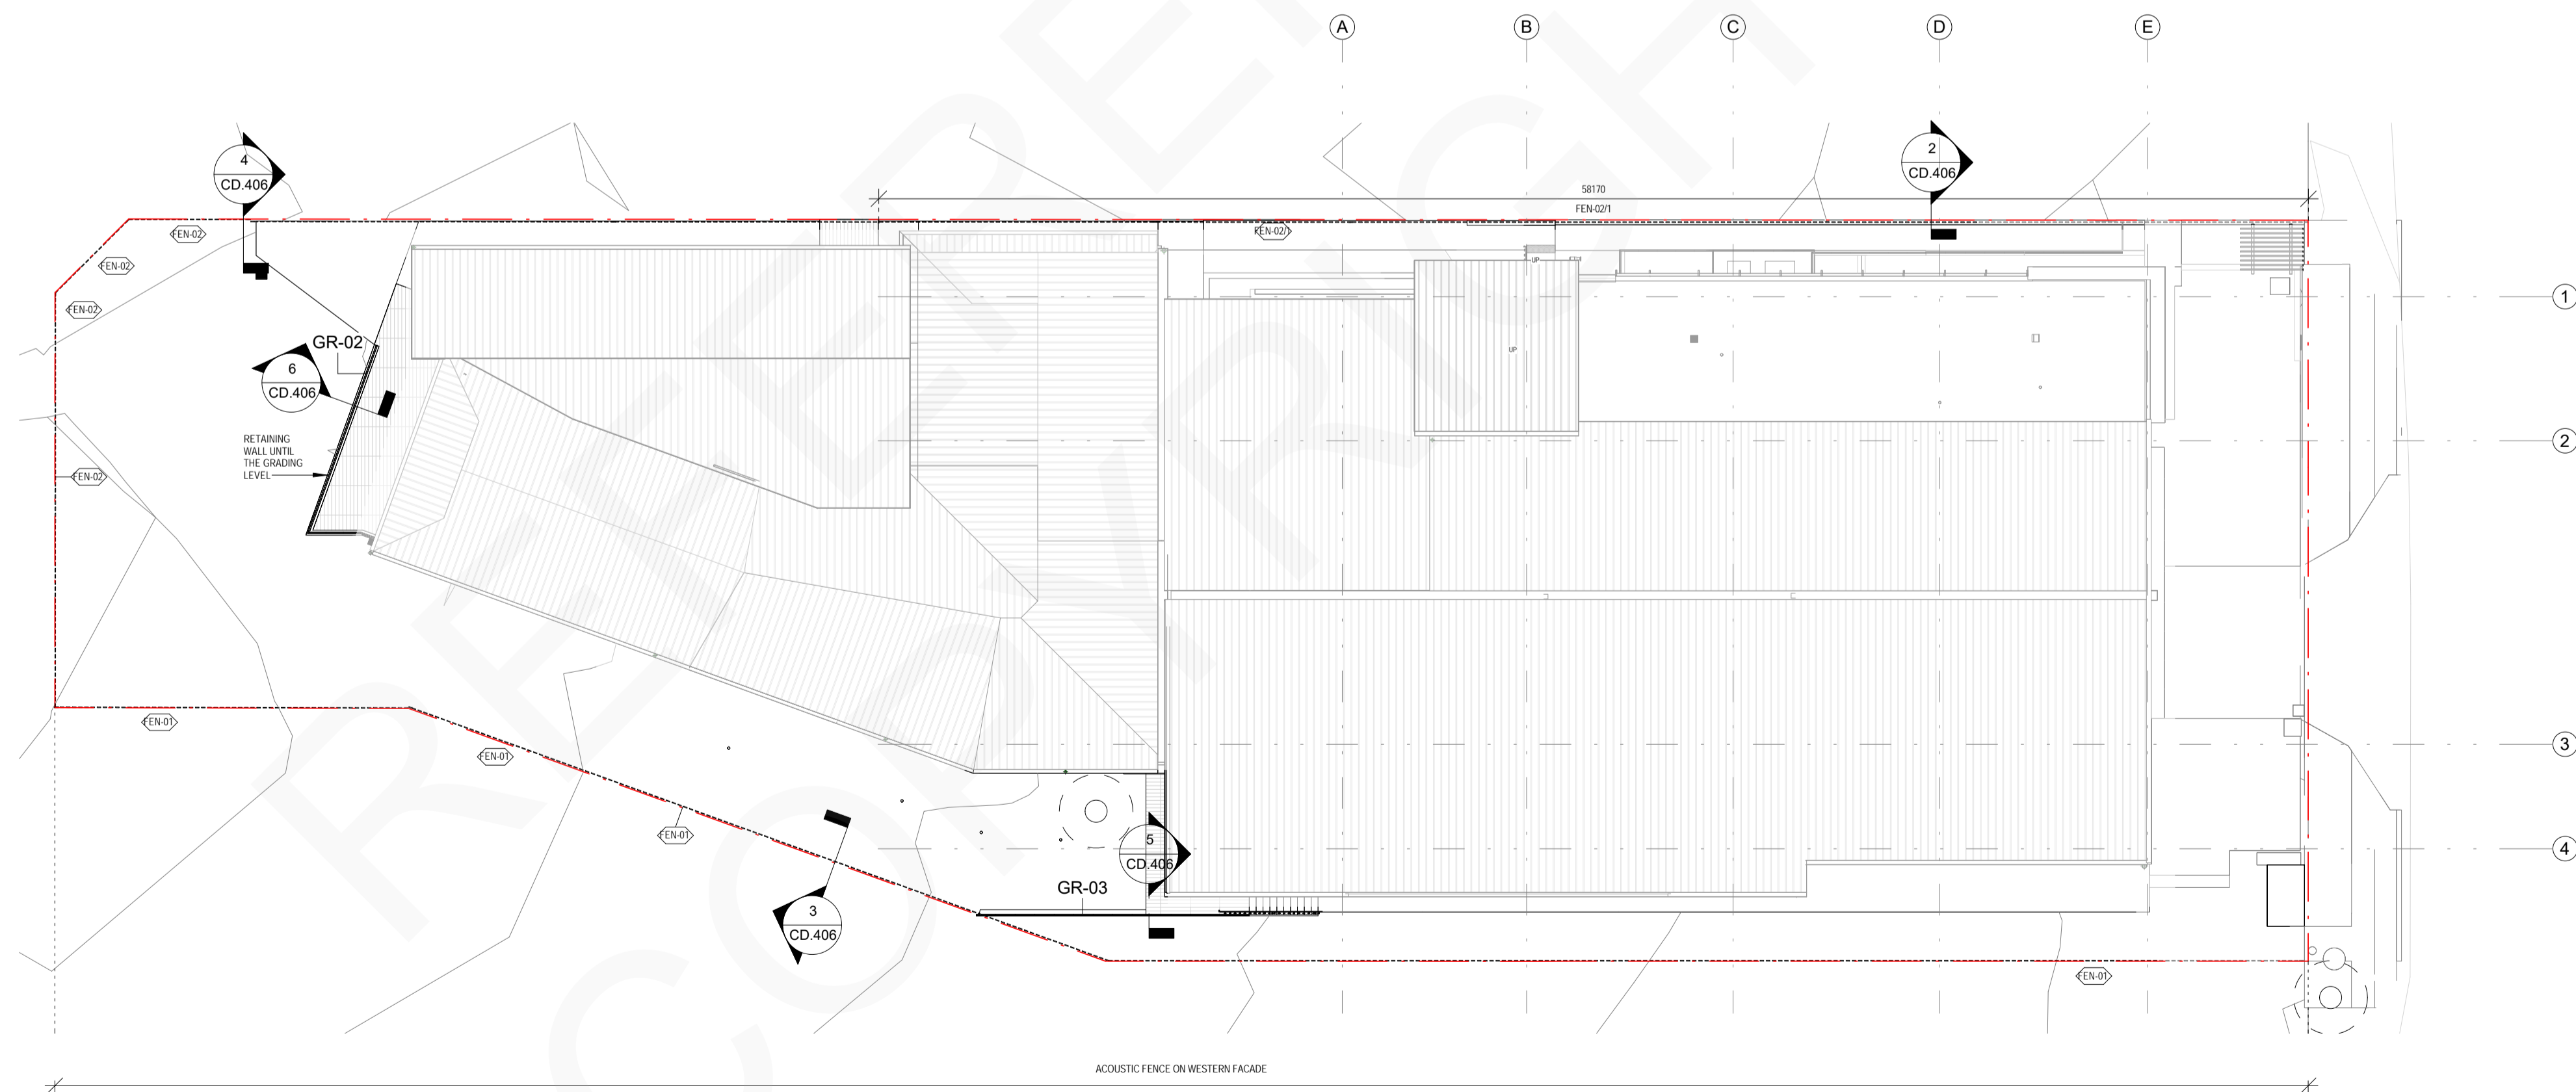


PROPOSED FENCE DETAIL PLAN


1:200

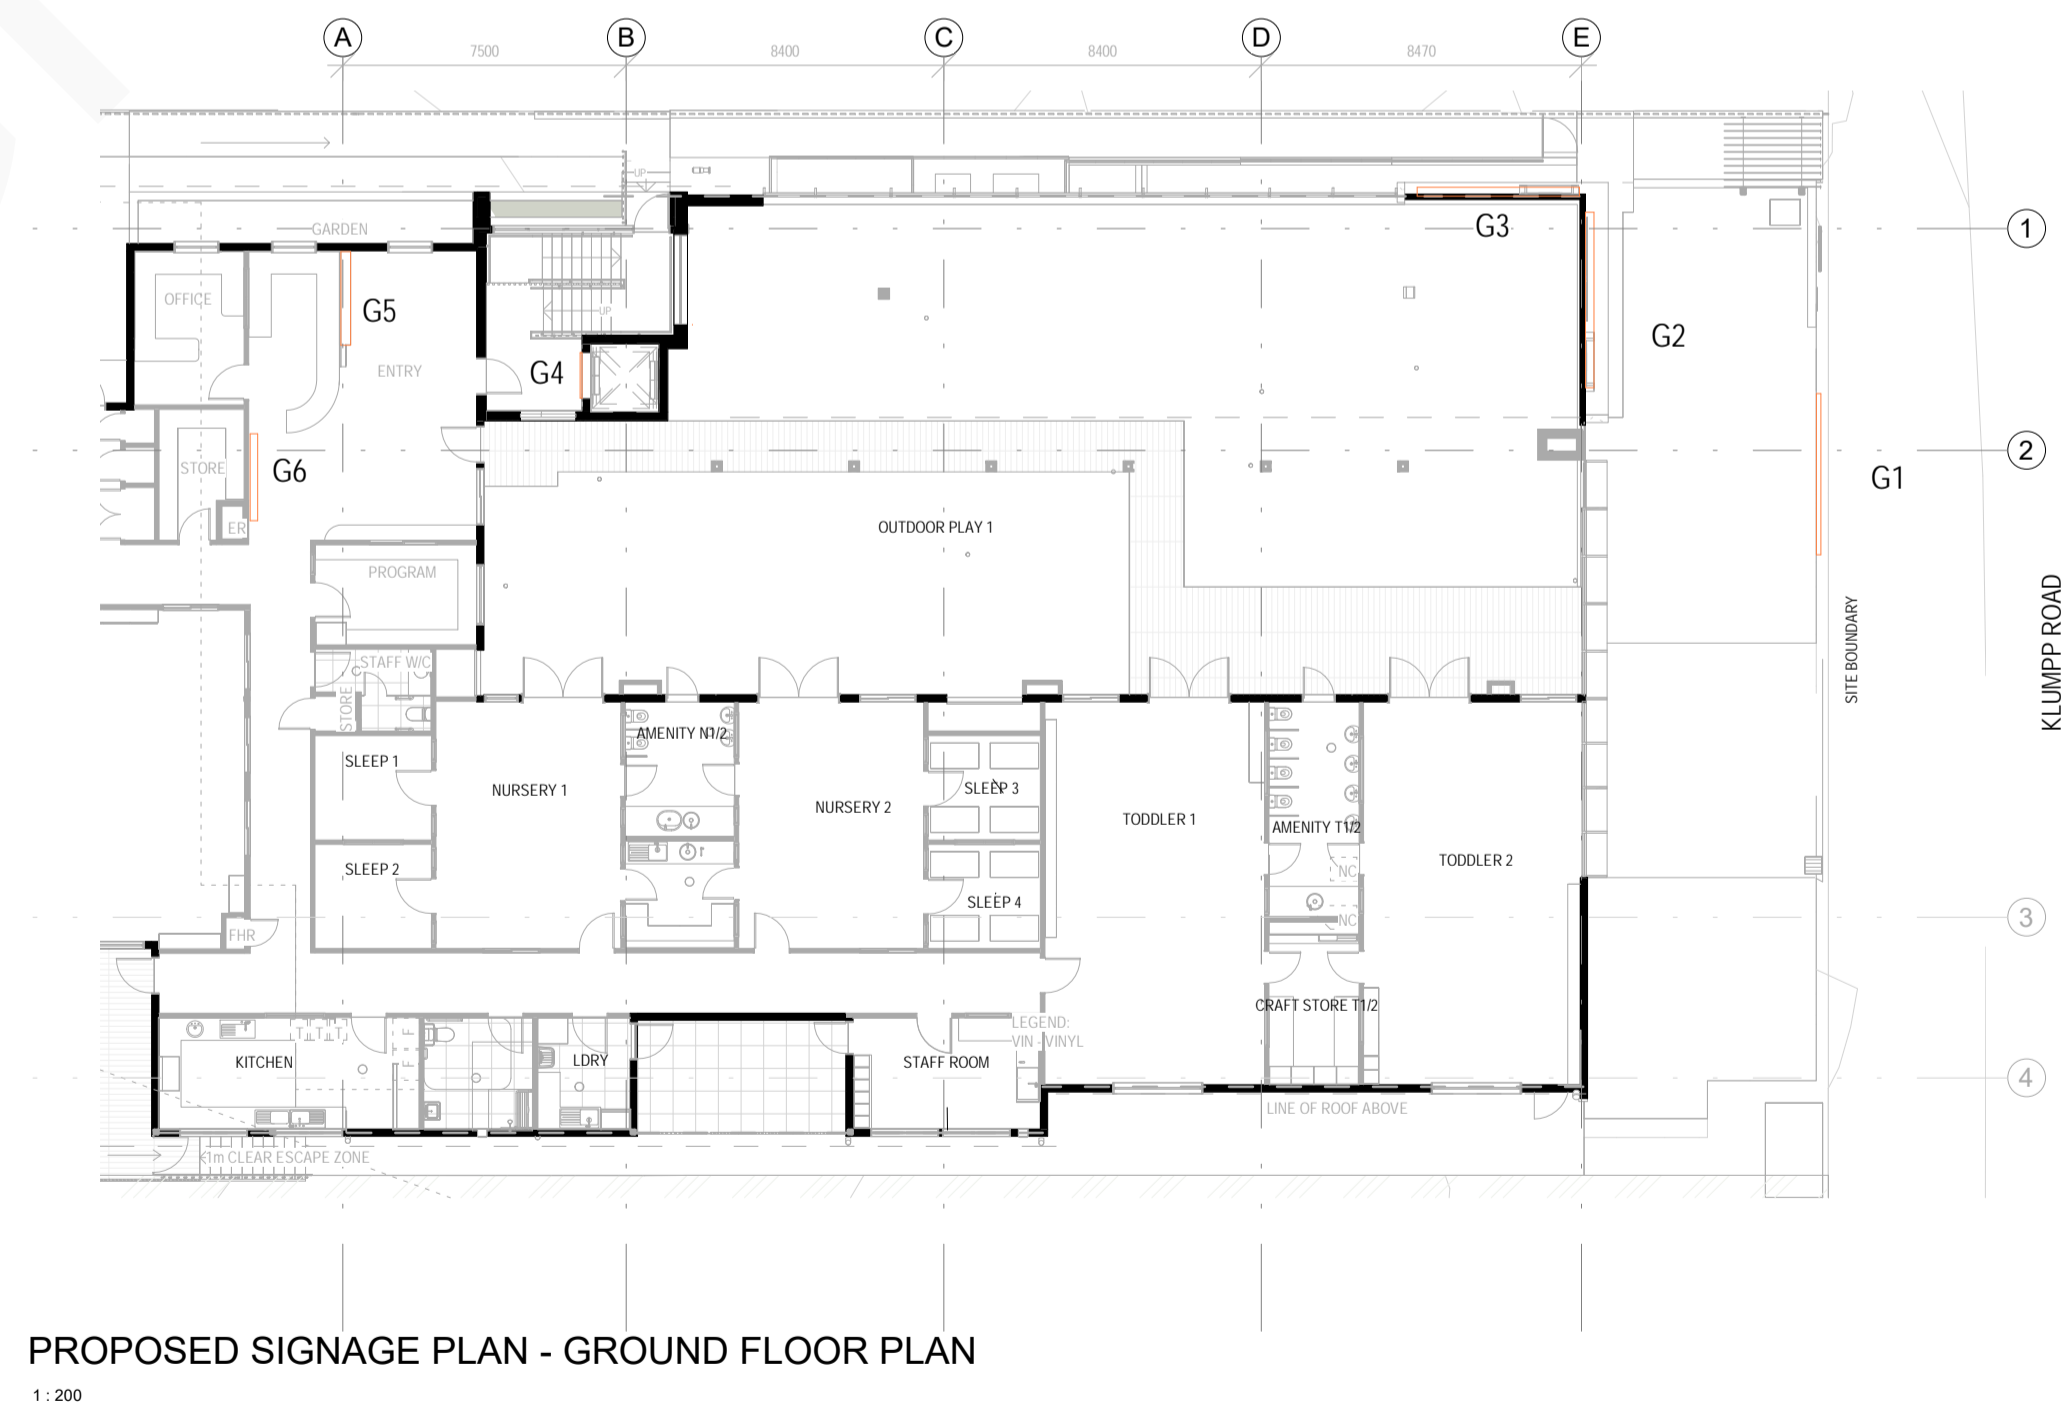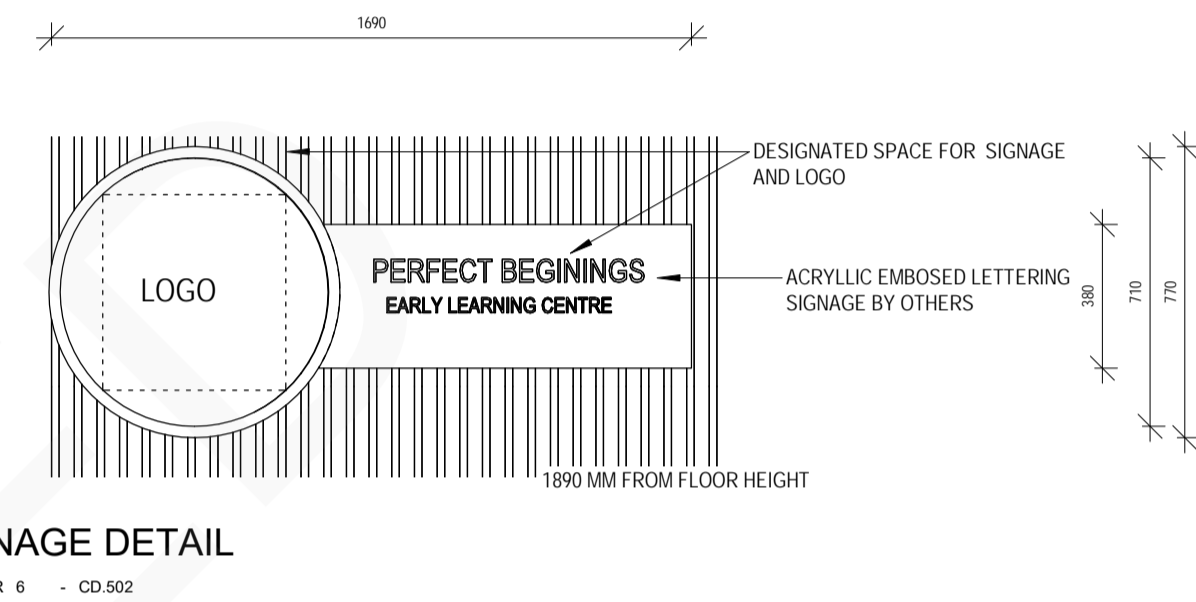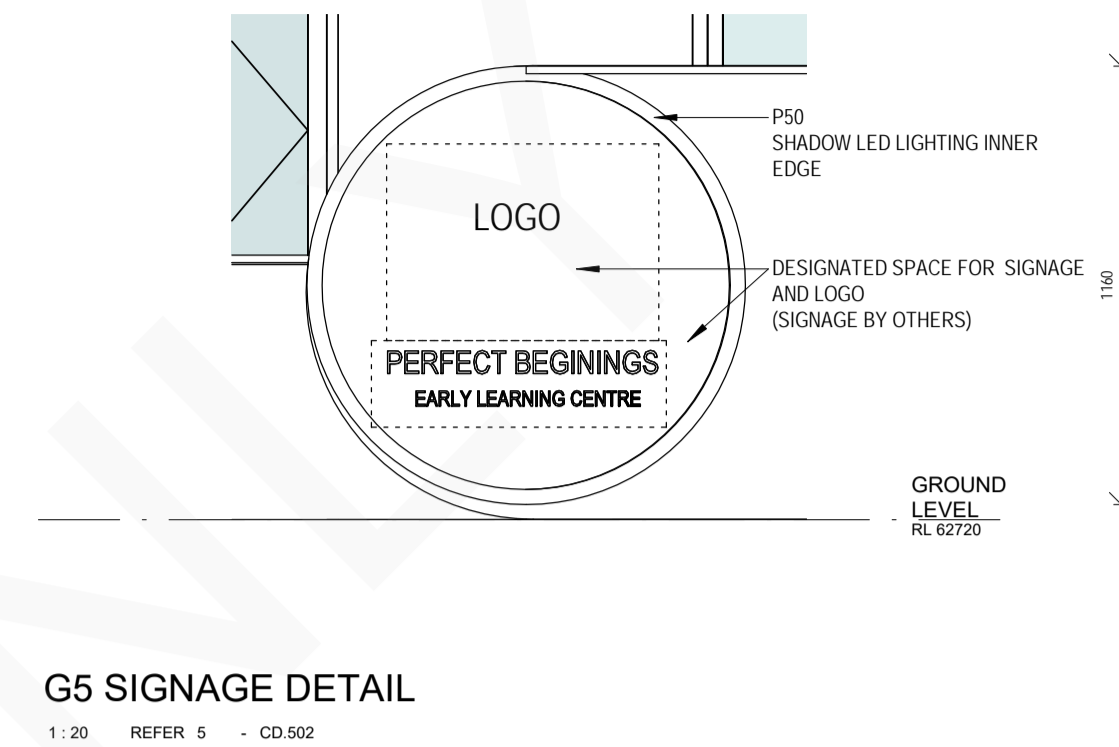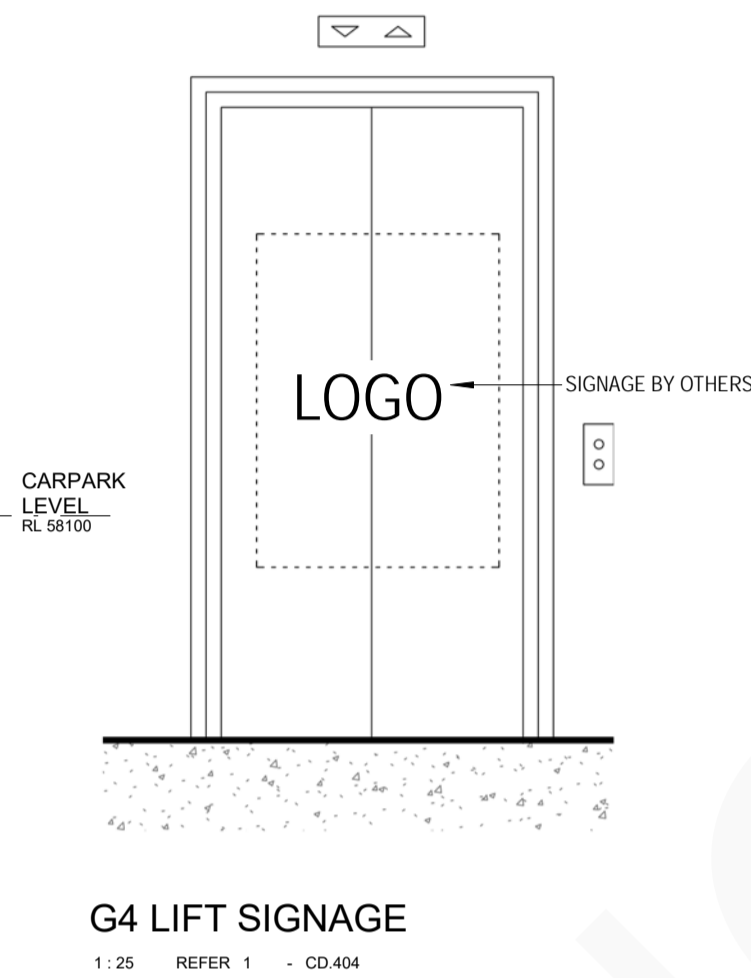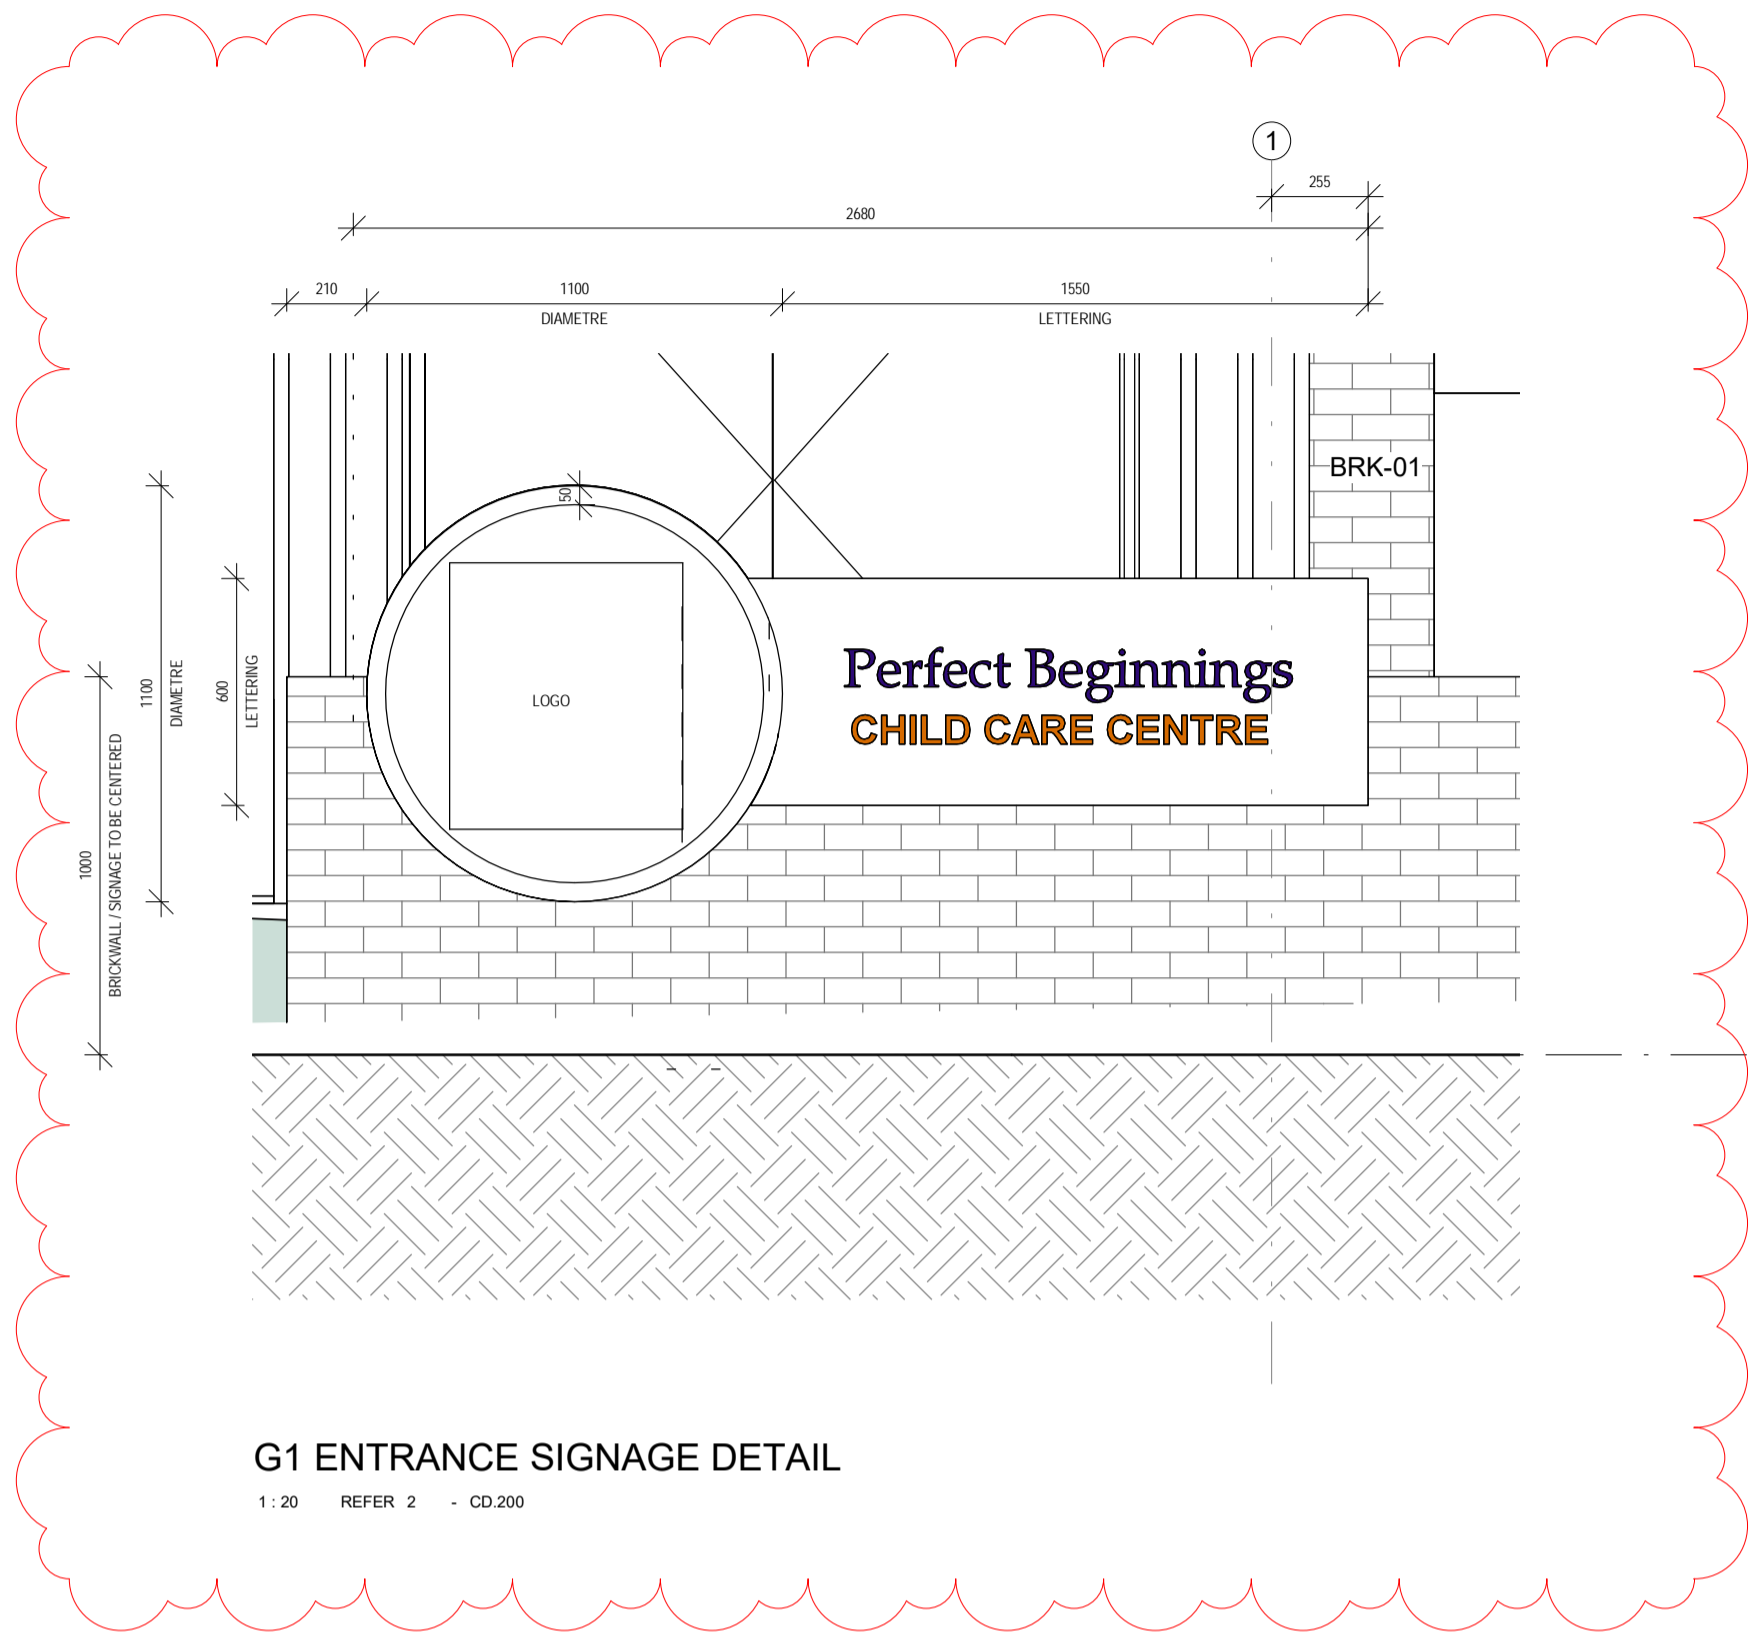


CODE	TYPE	DIMENSION (mm)	HEIGHT AFL (mm)
G1	RESIDENTIAL APARTMENT - ILLUMINATED WALL SIGN	4570 L x 1840H	NOMINAL 750
G2	RESIDENTIAL APARTMENT - ILLUMINATED WALL SIGN	4620L x 1560H (CORNER)	NOMINAL 6200
G3	COMMERCIAL TENANCY - BUILDING MOUNTED WALL SIGN	3000L x 700H (CORNER)	NOMINAL 4100
G4	COMMERCIAL TENANCY - BUILDING MOUNTED	700L x 700H	NOMINAL 700
G5	INTERIOR - RECEPTION - ILLUMINATED SIGNAGE	1200 DIA	NOMINAL 50
G6	INTERIOR - RECEPTION - SIGNAGE	1690L x 770H	NOMINAL 1890

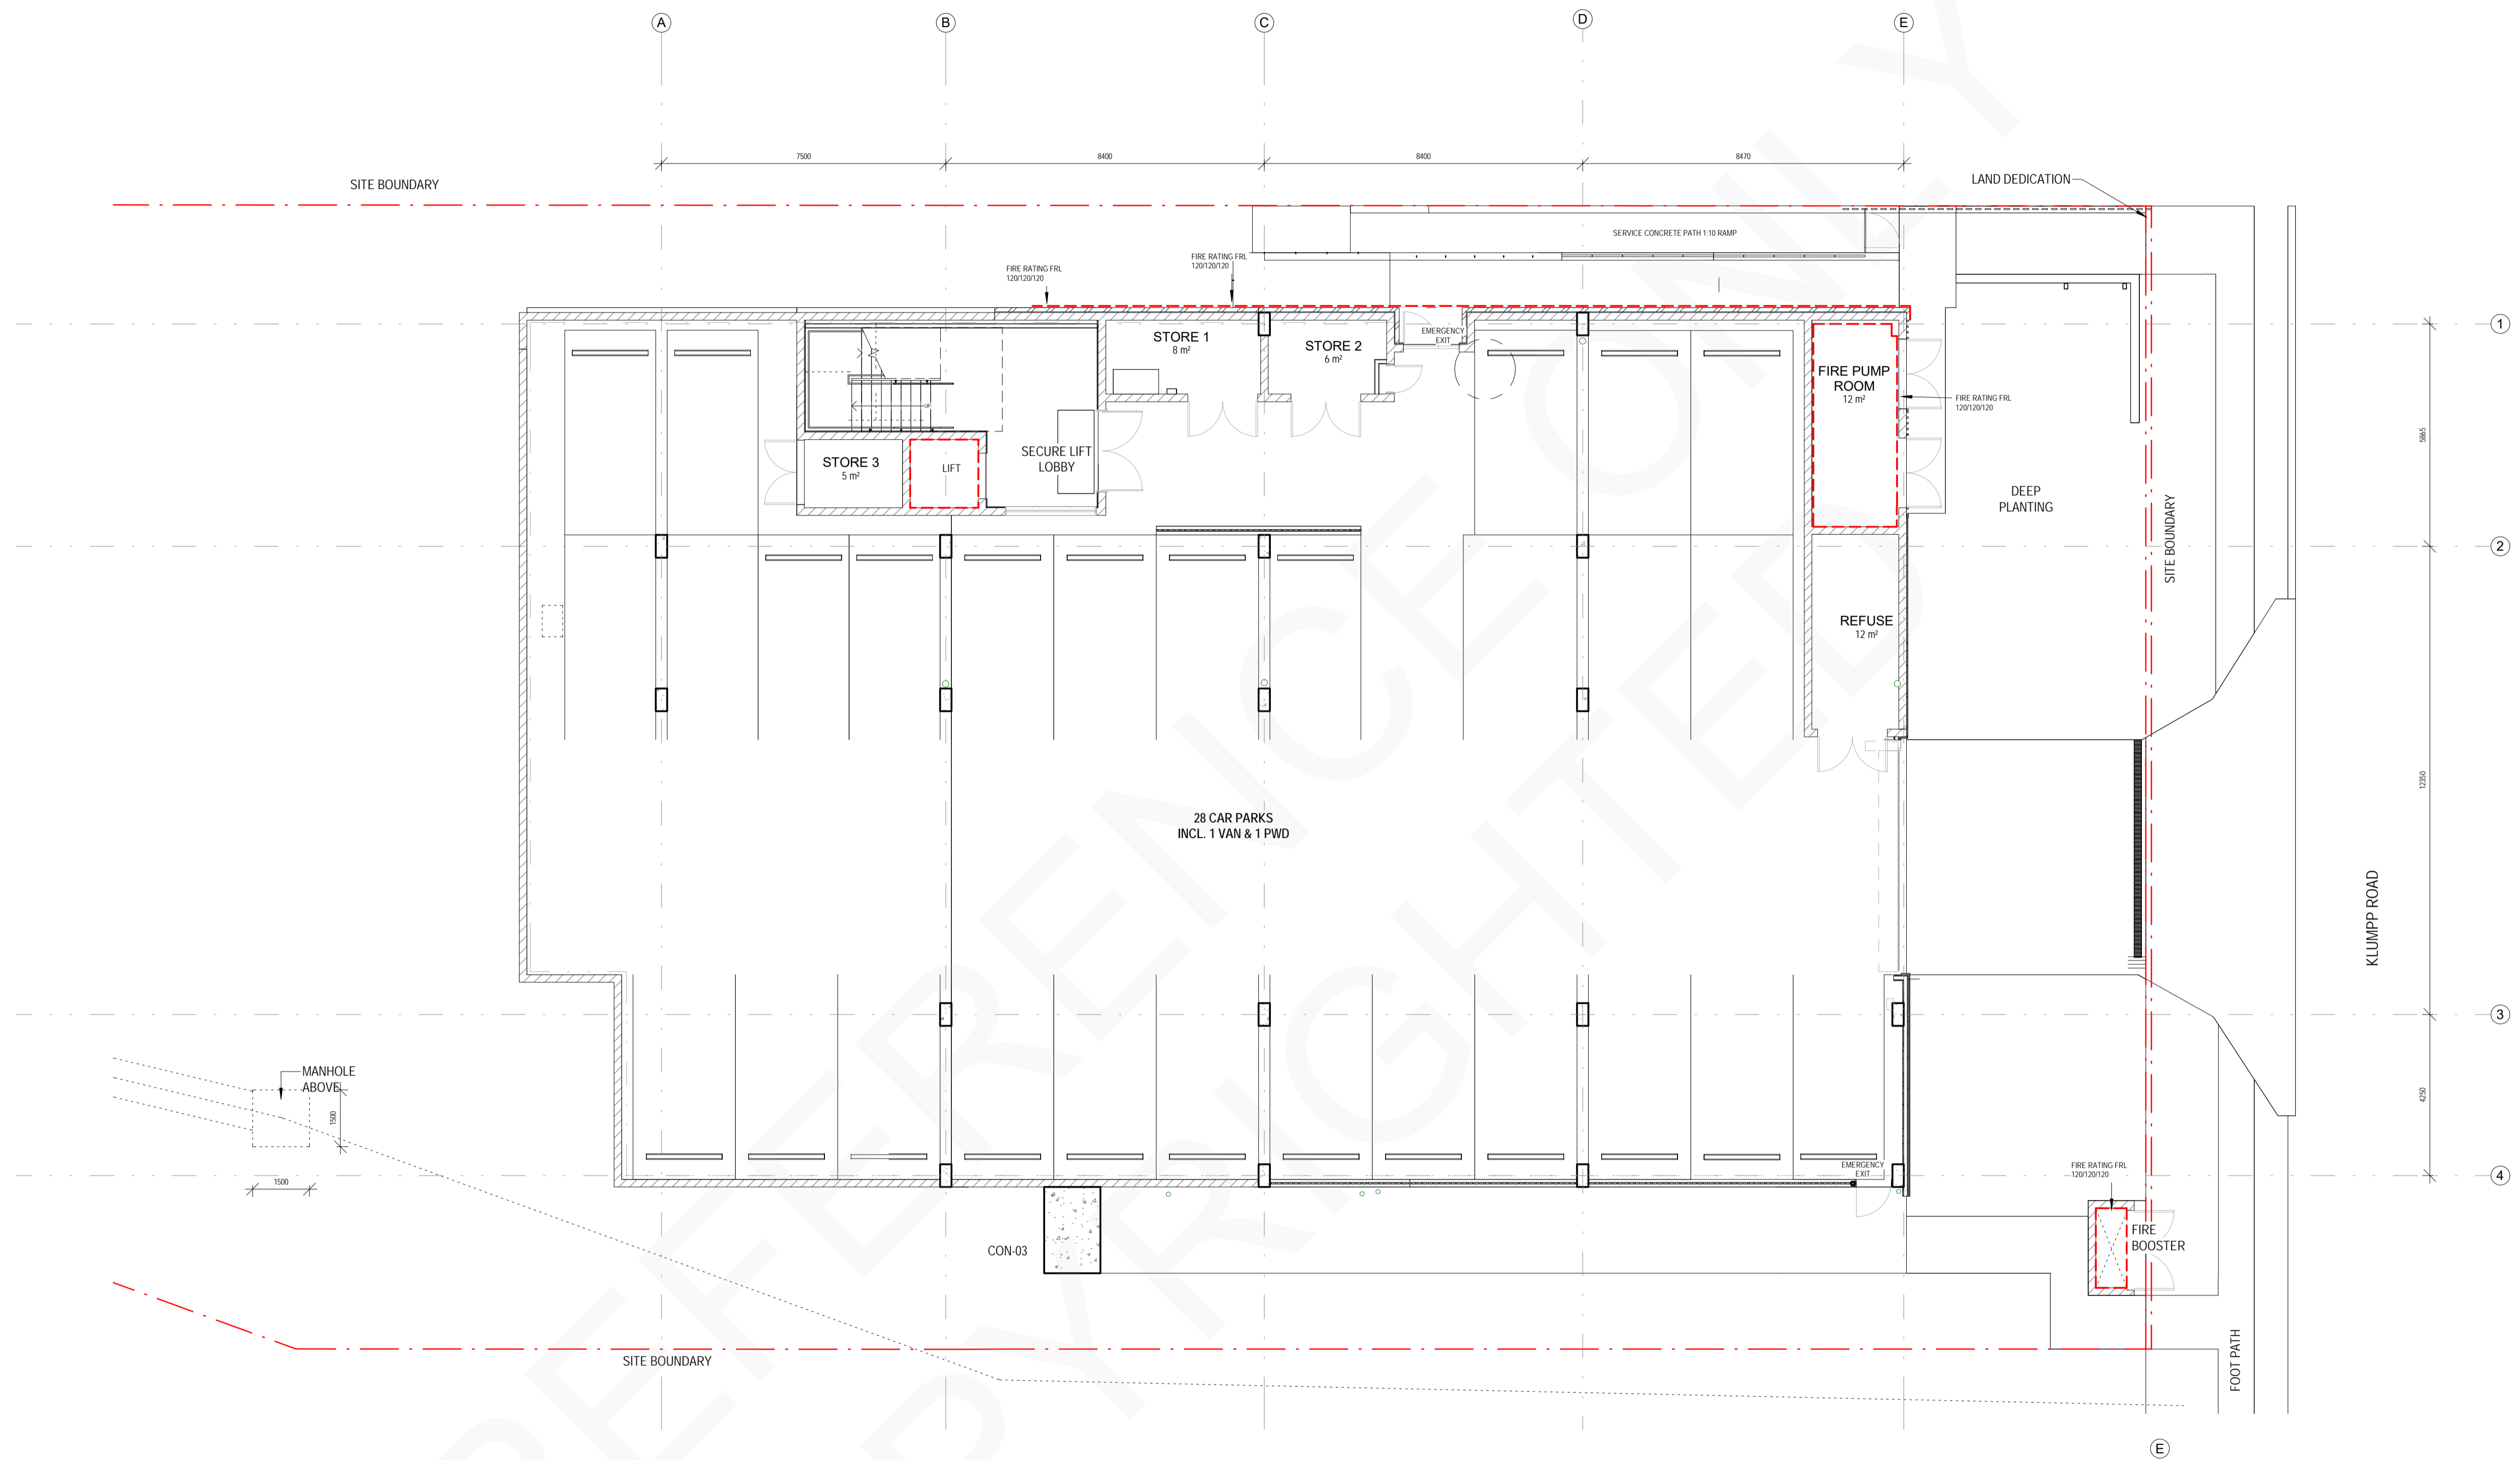

PROPOSED FIREWALL PLAN - CARPARK FLOOR PLAN
1:100

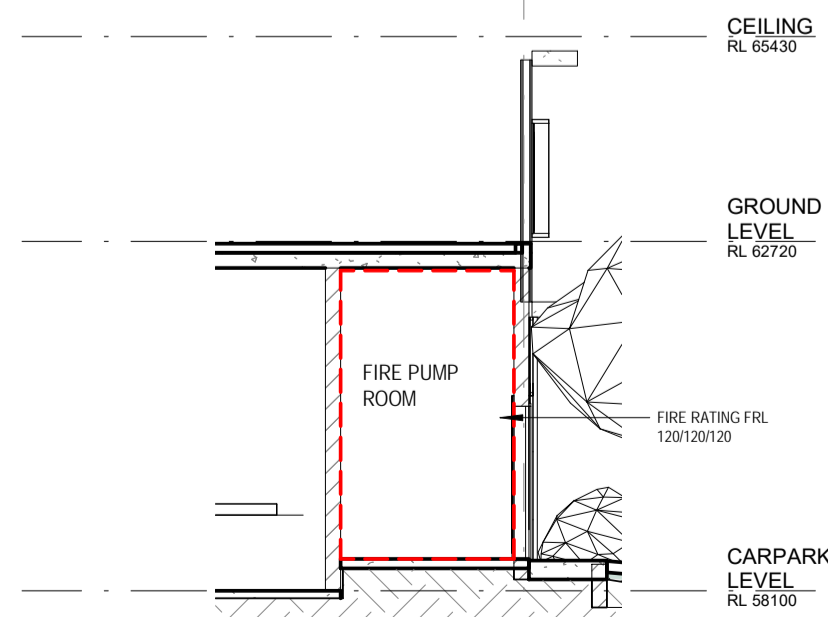


FIRE PUMP ROOM - FIRE RATING
REFER 2

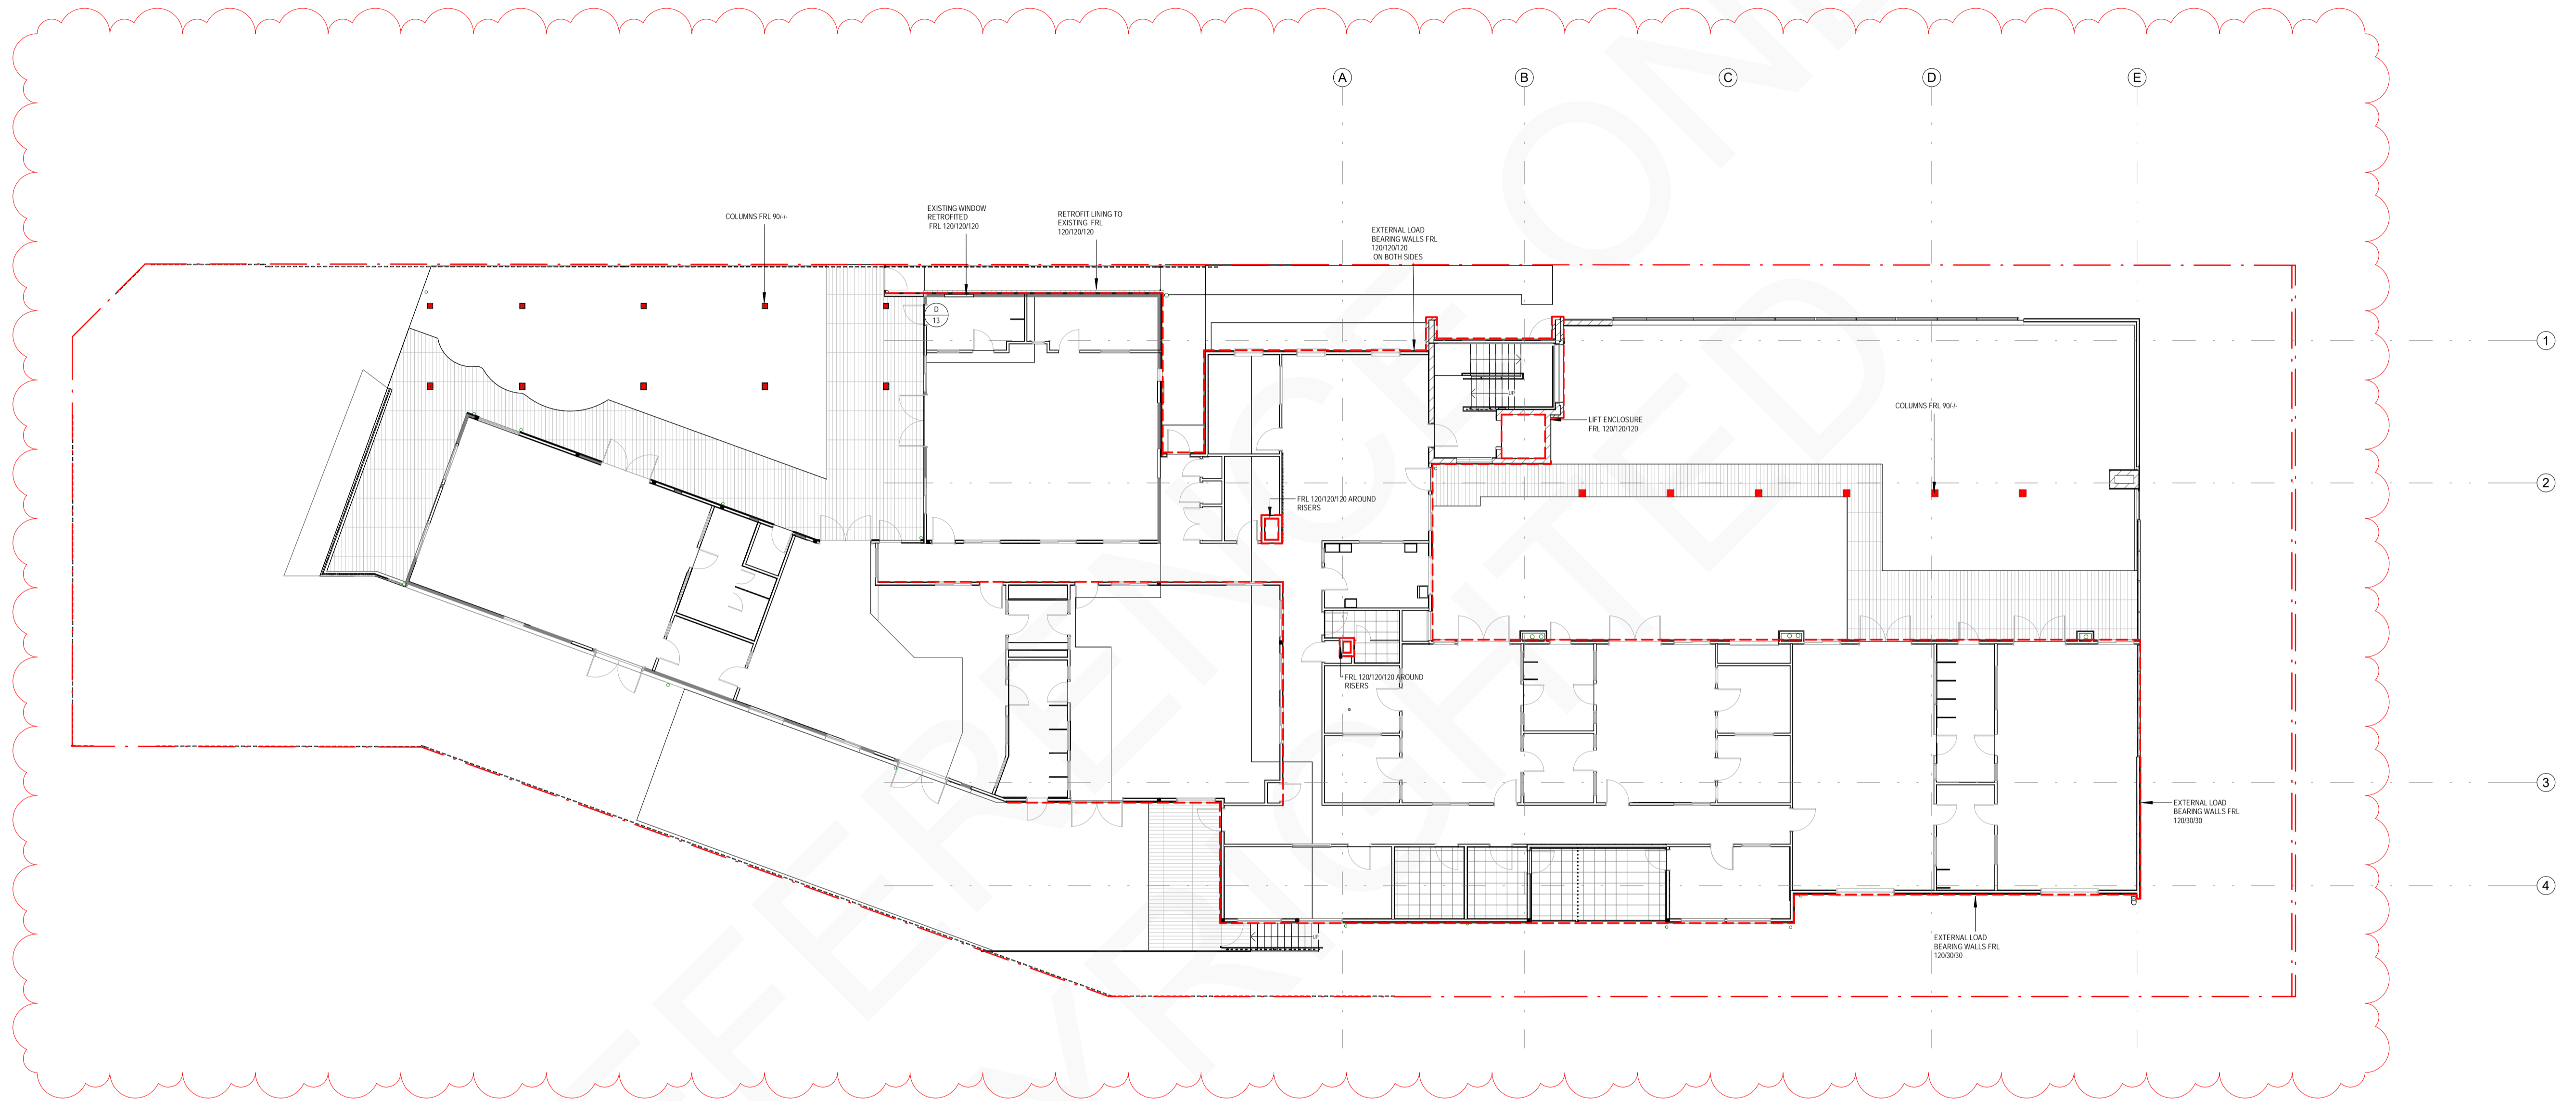


PROPOSED FIRE WALL PLAN - GROUND FLOOR

1:150


EXTERIOR GLAZING LEGEND

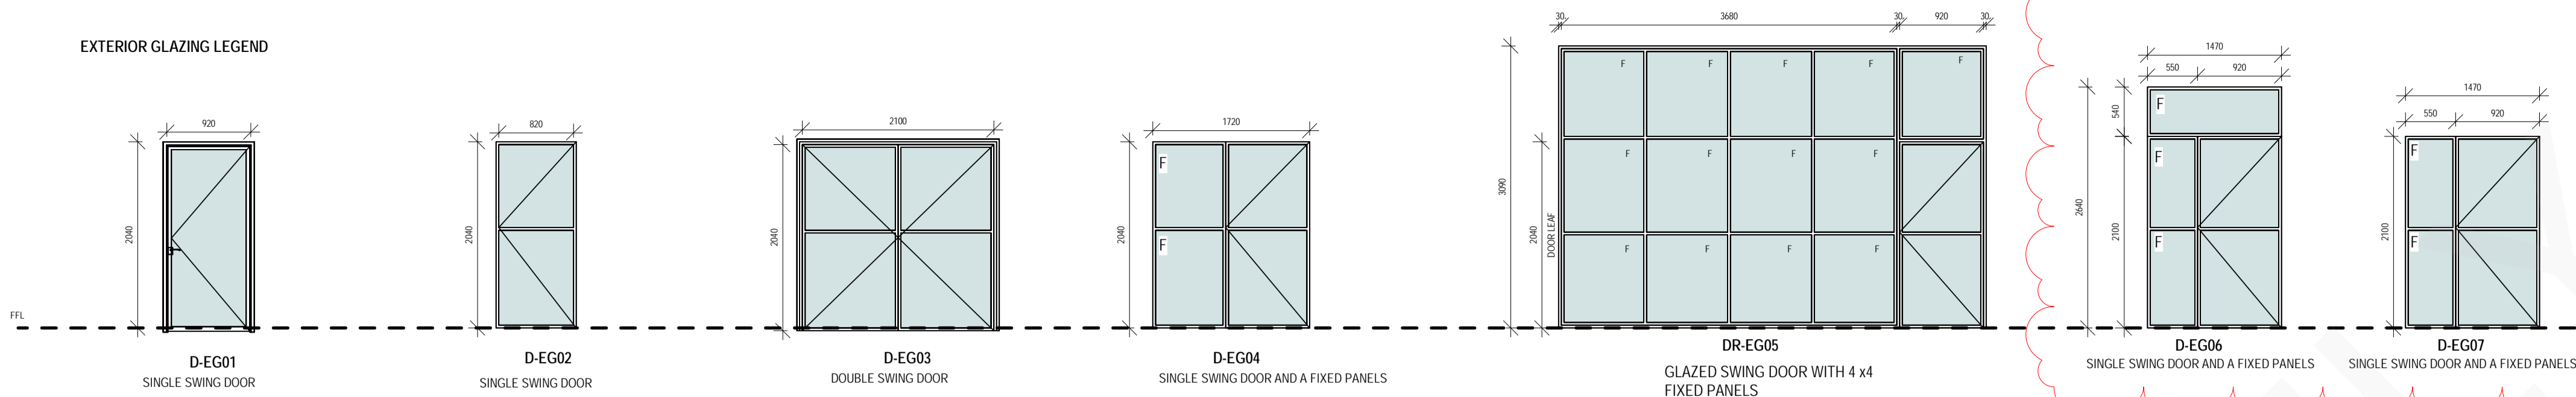

INTERIOR GLAZING LEGEND

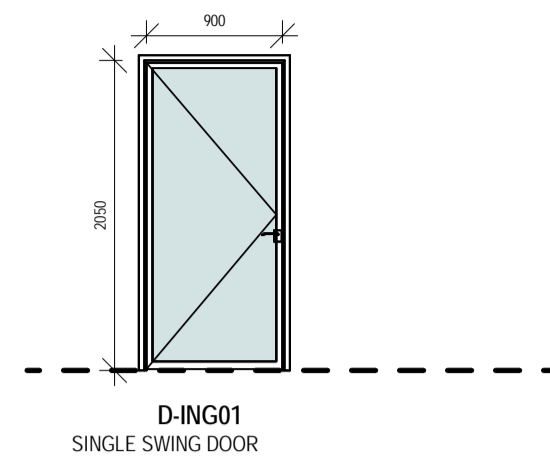


EXTERNAL DOOR SCHEDULE LEGEND

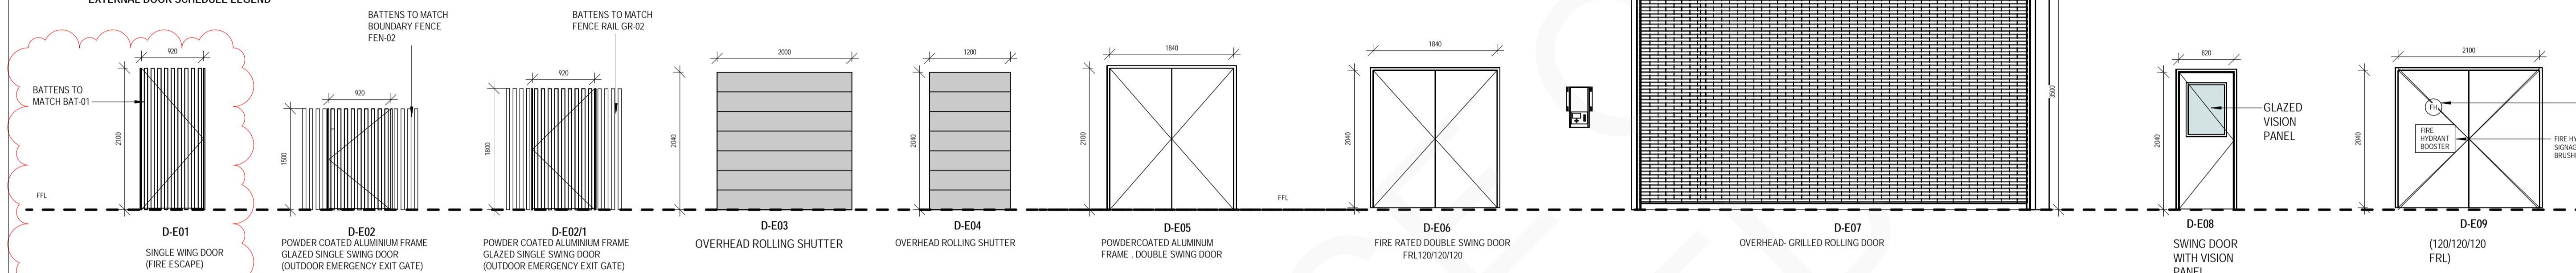


Level	Mark	Type Mark	Room Name	Width	Height	Function	Description	Frame Material	Finish	Glass	HARDWARE	Lock	Fire Rating	OTHER
CARPARK LEVEL	801	EG04	SECURE LIFT LOBBY	2100	2040	Interior	GLAZED SWING DOUBLE DOOR	ALUMINIUM	POWDER COATED	SINGLE GLAZING, CLEAR		SMART LOCK		
CARPARK LEVEL	802	EG01	PARKING	1840	2040	Interior	DOUBLE SWING DOOR	ALUMINIUM	POWDER COATED	SINGLE GLAZING, CLEAR	LEVER AND LOCK 1500MM HIGH	LOCK AND KEY		
CARPARK LEVEL	803	EG06	PARKING	1840	2040	Interior	DOUBLE SWING DOOR	ALUMINIUM	POWDER COATED	SINGLE GLAZING, CLEAR	LEVER AND LOCK 1500MM HIGH	LOCK AND KEY		
CARPARK LEVEL	804	EG06	PARKING	1840	2040	Interior	GLAZED SINGLE SWING DOOR AND FIXED PANEL	PRESSED METAL	POWDER COATED	SINGLE GLAZING, CLEAR	LEVER AND LOCK 1500MM HIGH	TURBULO		SELF CLOSING AND FINGER GUARD
CARPARK LEVEL	805	IN04	FHR	720	2040	Interior	SINGLE SWING DOOR	PRESSED METAL	POWDER COATED		LEVER AND LOCK 1500MM HIGH	LOCK AND KEY		
CARPARK LEVEL	806	EG06	FIRE PUMP	1840	2040	Interior	DOUBLE FIRE RATED SWING	PRESSED METAL	FIRE DOOR		LEVER AND LOCK 900 MM HIGH	FIRE ESCAPE HARDWARE	120/120/120 FIRE DOOR	
CARPARK LEVEL	807	EG06	FIRE PUMP	1840	2040	Interior	DOUBLE FIRE RATED SWING	PRESSED METAL	FIRE DOOR		LEVER AND LOCK 900 MM HIGH	FIRE ESCAPE HARDWARE	120/120/120 FIRE DOOR	
CARPARK LEVEL	808	EG06	PARKING	1840	2040	Interior	DOUBLE SWING DOOR	ALUMINIUM	POWDER COATED		LEVER AND LOCK 1500MM HIGH	LOCK AND KEY		
CARPARK LEVEL	809	E01	PARKING	920	2100	Exterior	CARPARK	ALUMINIUM BATTENS	POWDER COATED		LEVER AND LOCK 1500MM HIGH	FIRE ESCAPE HARDWARE		SELF CLOSING AND FINGER GUARD
CARPARK LEVEL	810	E01	PARKING	920	2040	Interior	SECURITY KILLER GRILL DOOR	ALUMINIUM	POWDER COATED		LOCK AND KEY			
CARPARK LEVEL	811	E01	STORE	1700	2040	Interior	DOUBLE SWING MESH DOOR	ALUMINIUM	POWDER COATED		LOCK AND KEY			
CARPARK LEVEL	812	EG01	EMERGENCY EXIT GATE	700	1100	Exterior	EMERGENCY EXIT GATE	ALUMINIUM BATTENS	POWDER COATED		FIRE HARDWARE			
CARPARK LEVEL	813	EG01	FIRE PUMP ROOM	2100	2040	Exterior	EMERGENCY EXIT GATE	ALUMINIUM BATTENS	POWDER COATED		FIRE HARDWARE		120/120/120 FIRE DOOR	CLOSING AND FINGER GUARD


Door Schedule														
Level	Mark	Type Mark	Room Name	Width	Height	Function	Description	Frame Material	Finish	Glass	HARDWARE	Lock	Fire Rating	OTHER
GROUND LEVEL	01	EG01	STAIR/ LIFT LOBBY	900	2040	Exterior	GLAZED SINGLE SWING DOOR	ALUMINIUM	POWDER COATED	SINGLE GLAZING, CLEAR	LEVER AND LOCK 1500MM HIGH	LOCK AND KEY		
GROUND LEVEL	03	EG01	ENTRY	900	2100	Exterior	GLAZED SINGLE SWING DOOR	ALUMINIUM	POWDER COATED	SINGLE GLAZING, CLEAR	LEVER AND LOCK 900 MM HIGH			
GROUND LEVEL	04	ING01	OFFICE	920	2040	Interior	GLAZED SINGLE SWING DOOR	ALUMINIUM	POWDER COATED	SINGLE GLAZING, FROSTED	LEVER 1500MM HIGH			SELF CLOSING AND FINGER GUARD
GROUND LEVEL	05	EG01	EXTERNAL STAIRCASE	920	1000	Exterior	EXTENSION	ALUMINIUM BATTENS	POWDER COATED			FIRE HARDWARE		
GROUND LEVEL	06	IN01	STORE	800	2040	Interior	SINGLE SWING DOOR	TIMBER	PAINTED		LEVER AND LOCK 1500MM HIGH	LOCK AND KEY		
GROUND LEVEL	07	IN02	STORE	1340	2100	Interior	DOUBLE SWING DOOR	TIMBER	PAINTED		LEVER AND LOCK 1500MM HIGH			
GROUND LEVEL	08	IN03	STORE	800	2100	Interior	SINGLE SWING DOOR	TIMBER	PAINTED		LEVER 1500 MM HIGH			
GROUND LEVEL	09	IN04	STORE	720	2040	Interior	SINGLE SWING DOOR	TIMBER	PAINTED		LEVER 1500 MM HIGH			
GROUND LEVEL	10	IN01	EMERGENCY EXIT	920	2040	Interior	SINGLE SWING DOOR	ALUMINIUM	POWDER COATED		LEVER 1500MM HIGH	SMART LOCK AND KEY		SELF CLOSING AND FINGER GUARD
GROUND LEVEL	11	ING01	KINDY1	920	2040	Interior	GLAZED SINGLE SWING DOOR	ALUMINIUM	POWDER COATED	SINGLE GLAZING, FROSTED	LEVER 1500MM HIGH	LOCK AND KEY		SELF CLOSING AND FINGER GUARD
GROUND LEVEL	12	EG03	OUTDOOR PLAY 02	2100	2040	Interior	GLAZED SWING DOUBLE DOOR	ALUMINIUM	POWDER COATED	SINGLE GLAZING, CLEAR	LEVER AND LOCK 1500MM HIGH	INT LOCK - NO KEY		SELF CLOSING AND FINGER GUARD
GROUND LEVEL	13	EG03	OUTDOOR PLAY 02	800	2040	Exterior	SINGLE DOOR WITH GLAZING PANEL	ALUMINIUM	POWDER COATED	SINGLE GLAZING, CLEAR	LEVER AND LOCK 1500MM HIGH	INT LOCK - NO KEY		SELF CLOSING AND FINGER GUARD
GROUND LEVEL	14	EG02	EXIT GATE	920	1500	Exterior	EMERGENCY EXIT GATE	ALUMINIUM	POWDER COATED		LEVER AND LOCK 1500MM HIGH	FIRE ESCAPE HARDWARE		FIRE ESCAPE
GROUND LEVEL	15	IN05	KINDY1	800	1100	Interior	1/2 HEIGHT TIMBER SWING DOOR HOLLOW CORE	TIMBER	PAINTED		LEVER 900 MM HIGH			
GROUND LEVEL	16	IN05	KINDY1	800	1100	Interior	1/2 HEIGHT TIMBER SWING DOOR HOLLOW CORE	TIMBER	PAINTED		LEVER 900 MM HIGH			
GROUND LEVEL	17	EG03	OUTDOOR PLAY 02	1840	2040	Exterior	GLAZED SINGLE SWING DOOR AND FIXED PANEL	ALUMINIUM SLATES	POWDER COATED	SINGLE GLAZING, CLEAR	LEVER AND LOCK 1500MM HIGH	TURBULO		SELF CLOSING AND FINGER GUARD
GROUND LEVEL	18	EG03	OUTDOOR PLAY 02	2100	2040	Interior	GLAZED SWING DOUBLE DOOR	ALUMINIUM	POWDER COATED	SINGLE GLAZING, CLEAR	LEVER AND LOCK 1500MM HIGH	INT LOCK - NO KEY		SELF CLOSING AND FINGER GUARD
GROUND LEVEL	19	IN03	STAFF WC	800	2040	Interior	SINGLE SWING DOOR	TIMBER	PAINTED		LEVER AND LOCK 1500MM HIGH	LOCK AND KEY		
GROUND LEVEL	21	EG03	OUTDOOR PLAY 02	2100	2040	Interior	GLAZED SWING DOUBLE DOOR	ALUMINIUM	POWDER COATED	SINGLE GLAZING, CLEAR	LEVER AND LOCK 1500MM HIGH	INT LOCK - NO KEY		SELF CLOSING AND FINGER GUARD
GROUND LEVEL	22	EG03	LANDSCAPE (WEST)	2100	2040	Interior	GLAZED SWING DOUBLE DOOR	ALUMINIUM	POWDER COATED	SINGLE GLAZING, CLEAR	LEVER AND LOCK 1500MM HIGH	INT LOCK - NO KEY		SELF CLOSING AND FINGER GUARD
GROUND LEVEL	23	IN05	KINDY2	800	1100	Interior	1/2 HEIGHT TIMBER SWING DOOR HOLLOW CORE	TIMBER	PAINTED		LEVER 900 MM HIGH			
GROUND LEVEL	24	IN05	KINDY2	800	1100	Interior	1/2 HEIGHT TIMBER SWING DOOR HOLLOW CORE	TIMBER	PAINTED		LEVER 900 MM HIGH			
GROUND LEVEL	25	IN05	PRE KINDY1	800	1100	Interior	1/2 HEIGHT TIMBER SWING DOOR HOLLOW CORE	TIMBER	PAINTED		LEVER 900 MM HIGH			
GROUND LEVEL	26	EG03	OUTDOOR PLAY 01	2100	2040	Interior	GLAZED SWING DOUBLE DOOR	ALUMINIUM	POWDER COATED	SINGLE GLAZING, CLEAR	LEVER AND LOCK 1500MM HIGH	INT LOCK - NO KEY		SELF CLOSING AND FINGER GUARD
GROUND LEVEL	27	IN05	PRE KINDY1	800	1100	Interior	1/2 HEIGHT TIMBER SWING DOOR HOLLOW CORE	TIMBER	PAINTED		LEVER 900 MM HIGH			
GROUND LEVEL	28	IN05	PRE KINDY1	800	1100	Interior	1/2 HEIGHT TIMBER SWING DOOR HOLLOW CORE	TIMBER	PAINTED		LEVER 900 MM HIGH			
GROUND LEVEL	29	ING01	KITCHEN	920	2040	Interior	GLAZED SINGLE SWING DOOR	ALUMINIUM	POWDER COATED	SINGLE GLAZING, FROSTED	LEVER 1500MM HIGH	LOCK AND KEY		SELF CLOSING AND FINGER GUARD
GROUND LEVEL	30	ING01	KITCHEN	920	2040	Interior	GLAZED SINGLE SWING DOOR	ALUMINIUM	POWDER COATED	SINGLE GLAZING, FROSTED	LEVER 1500MM HIGH	LOCK AND KEY		SELF CLOSING AND FINGER GUARD
GROUND LEVEL	31	IN05	PRE KINDY2	800	1100	Interior	1/2 HEIGHT TIMBER SWING DOOR HOLLOW CORE	TIMBER	PAINTED		LEVER 900 MM HIGH			
GROUND LEVEL	32	IN05	PRE KINDY2	800	1100	Interior	1/2 HEIGHT TIMBER SWING DOOR HOLLOW CORE	TIMBER	PAINTED		LEVER 900 MM HIGH			
GROUND LEVEL	33	EG02	OUTDOOR PLAY 02	880	2040	Exterior	GLAZED SINGLE SWING DOOR	ALUMINIUM	POWDER COATED	SINGLE GLAZING, CLEAR	LEVER AND LOCK 1500MM HIGH	INT LOCK - NO KEY		SELF CLOSING AND FINGER GUARD
GROUND LEVEL	34	EG03	OUTDOOR PLAY 01	2100	2040	Interior	GLAZED SWING DOUBLE DOOR	ALUMINIUM	POWDER COATED	SINGLE GLAZING, CLEAR	LEVER AND LOCK 1500MM HIGH	INT LOCK - NO KEY		SELF CLOSING AND FINGER GUARD
GROUND LEVEL	35	ING01	PROGRAM	900	2040	Interior	GLAZED SINGLE SWING DOOR	ALUMINIUM	POWDER COATED	SINGLE GLAZING, FROSTED	LEVER 1500MM HIGH			SELF CLOSING AND FINGER GUARD
GROUND LEVEL	36	IN01	STAFF WC	920	2040	Interior	SINGLE SWING DOOR	TIMBER	PAINTED		LEVER 900 MM HIGH			
GROUND LEVEL	37	IN01	AMENITY K2	600	1000	Interior	HALF TOILET PARTITION DOOR	TIMBER	LAMINATE		LEVER 900 MM HIGH			
GROUND LEVEL	38	IN01	STORE	800	2040	Interior	SINGLE SWING DOOR	TIMBER	PAINTED		LEVER AND LOCK 1500MM HIGH	LOCK AND KEY		
GROUND LEVEL	39	IN04	FHR	720	2040	Interior	SINGLE SWING DOOR	TIMBER	PAINTED		LEVER 1500MM HIGH			
GROUND LEVEL	40	EG01	STAIR/ LIFT LOBBY	920	2100	Exterior	GLAZED SINGLE SWING DOOR	ALUMINIUM	POWDER COATED	SINGLE GLAZING, CLEAR	LEVER AND LOCK 1500MM HIGH	LOCK AND KEY		SELF CLOSING AND FINGER GUARD
GROUND LEVEL	41	ING01	KITCHEN	920	2040	Exterior	SWING DOOR	TIMBER	PAINTED		LEVER 1500MM HIGH			SELF CLOSING AND FINGER GUARD
GROUND LEVEL	42	ING01	KITCHEN	920	2040	Exterior	SWING DOOR	TIMBER	PAINTED		LEVER AND LOCK 1500MM HIGH	INT TURBULO		FIRE ESCAPE
GROUND LEVEL	43	IN10	PWD	920	2040	Exterior	SWING DOOR	TIMBER	PAINTED		LEVER AND LOCK 1500MM HIGH	INT TURBULO		SELF CLOSING AND FINGER GUARD
GROUND LEVEL	44	IN10	LAUNDRY	920	2040	Exterior	SWING DOOR	TIMBER	PAINTED		LEVER AND LOCK 1500MM HIGH	INT TURBULO		SELF CLOSING AND FINGER GUARD
GROUND LEVEL	45	F10	LAUNDRY	920	2040	Exterior	SWING DOOR	TIMBER	PAINTED		LEVER AND LOCK 1500MM HIGH	INT TURBULO		SELF CLOSING AND FINGER GUARD
GROUND LEVEL	46	EG03	STAFF DECK	800	2040	Interior	GLAZED SINGLE SWING DOOR	TIMBER	PAINTED	SINGLE GLAZING, CLEAR	LEVER AND LOCK 1500MM HIGH	INT LOCK - NO KEY		SELF CLOSING AND FINGER GUARD
GROUND LEVEL	47	ING01	STAFF ROOM	920	2040	Interior	SINGLE SWING DOOR	TIMBER	PAINTED		LEVER 900 MM HIGH			
GROUND LEVEL	48	ING01	TODDLER1	920	2040	Interior	GLAZED SINGLE SWING DOOR	ALUMINIUM	POWDER COATED	SINGLE GLAZING, FROSTED	LEVER 1500MM HIGH			SELF CLOSING AND FINGER GUARD
GROUND LEVEL	49	IN05	TODDLER1	800	1100	Interior	1/2 HEIGHT TIMBER SWING DOOR HOLLOW CORE	TIMBER	PAINTED		LEVER 900 MM HIGH			
GROUND LEVEL	50	IN05	TODDLER1	800	1100	Interior	1/2 HEIGHT TIMBER SWING DOOR HOLLOW CORE	TIMBER	PAINTED		LEVER 900 MM HIGH			
GROUND LEVEL	51	IN05	TODDLER2	800	1100	Interior	1/2 HEIGHT TIMBER SWING DOOR HOLLOW CORE	TIMBER	PAINTED		LEVER 900 MM HIGH			
GROUND LEVEL	52	IN05	TODDLER2	800	1100	Interior	1/2 HEIGHT TIMBER SWING DOOR HOLLOW CORE	TIMBER	PAINTED		LEVER 900 MM HIGH			
GROUND LEVEL	53	EG03	OUTDOOR PLAY 01	2100	2040	Interior	GLAZED SWING DOUBLE DOOR	ALUMINIUM	POWDER COATED	SINGLE GLAZING, CLEAR	LEVER AND LOCK 1500MM HIGH	INT LOCK - NO KEY		SELF CLOSING AND FINGER GUARD
GROUND LEVEL	54	EG02	OUTDOOR PLAY 01	880	2040	Exterior	GLAZED SINGLE SWING DOOR	ALUMINIUM	POWDER COATED	SINGLE GLAZING, CLEAR	LEVER AND LOCK 1500MM HIGH	INT LOCK - NO KEY		SELF CLOSING AND FINGER GUARD
GROUND LEVEL	55	EG03	OUTDOOR PLAY 02	2100	2040	Interior	GLAZED SWING DOUBLE DOOR	ALUMINIUM	POWDER COATED	SINGLE GLAZING, CLEAR	LEVER AND LOCK 1500MM HIGH	INT LOCK - NO KEY		SELF CLOSING AND FINGER GUARD
GROUND LEVEL	56	EG03	OUTDOOR PLAY 01	2000	2040	Exterior	ROLLER DOOR	ALUMINIUM	POWDER COATED		LEVER AND LOCK 1500MM HIGH	KEY		
GROUND LEVEL	57	EG04	OUTDOOR PLAY 01	2100	2040	Interior	GLAZED SWING DOUBLE DOOR	ALUMINIUM	POWDER COATED	SINGLE GLAZING, CLEAR	LEVER AND LOCK 1500MM HIGH	SMART LOCK		SELF CLOSING AND FINGER GUARD
GROUND LEVEL	58	EG02	OUTDOOR PLAY 01	880	2040	Exterior	GLAZED SINGLE SWING DOOR	ALUMINIUM	POWDER COATED	SINGLE GLAZING, CLEAR	LEVER AND LOCK 1500MM HIGH	INT LOCK - NO KEY		SELF CLOSING AND FINGER GUARD
GROUND LEVEL	59	EG03	OUTDOOR PLAY 01	2100	2040	Interior	GLAZED SWING DOUBLE DOOR	ALUMINIUM	POWDER COATED	SINGLE GLAZING, CLEAR	LEVER AND LOCK 1500MM HIGH	INT LOCK - NO KEY		SELF CLOSING AND FINGER GUARD
GROUND LEVEL	60	EG04	OUTDOOR PLAY 01	1200	2040	Exterior	ROLLER DOOR	ALUMINIUM	POWDER COATED		LEVER 900 MM HIGH			
GROUND LEVEL	61	IN05	NURSERY 1	800	1100	Interior	1/2 HEIGHT TIMBER SWING DOOR HOLLOW CORE	TIMBER	PAINTED		LEVER 900 MM HIGH			SELF CLOSING AND FINGER GUARD
GROUND LEVEL	62	IN05	NURSERY 2	800	1100	Interior	1/2 HEIGHT TIMBER SWING DOOR HOLLOW CORE	TIMBER	PAINTED		LEVER 900 MM HIGH			SELF CLOSING AND FINGER GUARD
GROUND LEVEL	63	IN05	NURSERY 2	800	1100	Interior	1/2 HEIGHT TIMBER SWING DOOR HOLLOW CORE	TIMBER	PAINTED		LEVER 900 MM HIGH			SELF CLOSING AND FINGER GUARD
GROUND LEVEL	64	IN05	NURSERY 2	800	1100	Interior	1/2 HEIGHT TIMBER SWING DOOR HOLLOW CORE	TIMBER	PAINTED		LEVER 900 MM HIGH			SELF CLOSING AND FINGER GUARD
GROUND LEVEL	65	SLEP	SLEEP	920	2040	Interior	GLAZED SINGLE SWING DOOR	ALUMINIUM	POWDER COATED	SINGLE GLAZING, FROSTED	LEVER 1500MM HIGH			SELF CLOSING AND FINGER GUARD
GROUND LEVEL	66	ING01	SLEEP	920	2040	Interior	GLAZED SINGLE SWING DOOR	ALUMINIUM	POWDER COATED	SINGLE GLAZING, FROSTED	LEVER 1500MM HIGH			SELF CLOSING AND FINGER GUARD
GROUND LEVEL	67	ING01	SLEEP	920	2040	Interior	GLAZED SINGLE SWING DOOR	ALUMINIUM	POWDER COATED	SINGLE GLAZING, FROSTED	LEVER 1500MM HIGH			SELF CLOSING AND FINGER GUARD
GROUND LEVEL	68	ING01	SLEEP	920	2040	Interior	GLAZED SINGLE SWING DOOR	ALUMINIUM	POWDER COATED	SINGLE GLAZING, FROSTED	LEVER 1500MM HIGH			SELF CLOSING AND FINGER GUARD
GROUND LEVEL	69	ING01	SLEEP	920	2040	Interior	GLAZED SINGLE SWING DOOR	ALUMINIUM	POWDER COATED	SINGLE GLAZING, FROSTED	LEVER 1500MM HIGH			SELF CLOSING AND FINGER GUARD
GROUND LEVEL	70	ING01	SLEEP	920	2040	Interior	GLAZED SINGLE SWING DOOR	ALUMINIUM	POWDER COATED	SINGLE GLAZING, FROSTED	LEVER 1500MM HIGH			SELF CLOSING AND FINGER GUARD
GROUND LEVEL	71	E02	EXIT GATE	920	1500	Exterior	EMERGENCY EXIT GATE	ALUMINIUM BATTENS	POWDER COATED		FIRE ESCAPE	FIRE ESCAPE HARDWARE		FIRE ESCAPE
GROUND LEVEL	74	IN01	STAFF ROOM	920	2040	Interior	SINGLE SWING DOOR	TIMBER	PAINTED		LEVER 900 MM HIGH			
GROUND LEVEL	75	IN01	AMENITY K2	600	1000	Interior	HALF TOILET PARTITION DOOR	TIMBER	LAMINATE		LEVER 900 MM HIGH			
GROUND LEVEL	76	IN01	AMENITY K2	600	1000	Interior	HALF TOILET PARTITION DOOR	TIMBER	LAMINATE		LEVER 900 MM HIGH			
GROUND LEVEL	79	EG02	STAIR/ LIFT LOBBY	920	2040	Exterior	GLAZED SINGLE SWING DOOR AND FIXED PANEL	ALUMINIUM	POWDER COATED	SINGLE GLAZING, CLEAR	LEVER AND LOCK 1500MM HIGH	FIRE ESCAPE HARDWARE		FIRE ESCAPE
GROUND LEVEL	86	EG03	STAIR/ LIFT LOBBY	4680	3000	Exterior	GLAZED SINGLE SWING DOOR AND FIXED PANEL	ALUMINIUM	POWDER COATED	SINGLE GLAZING, CLEAR	LEVER AND LOCK 1500MM HIGH	LOCK AND KEY		EXT ALARM TO BE INSTALLED

EXTERNAL WINDOW LEGEND

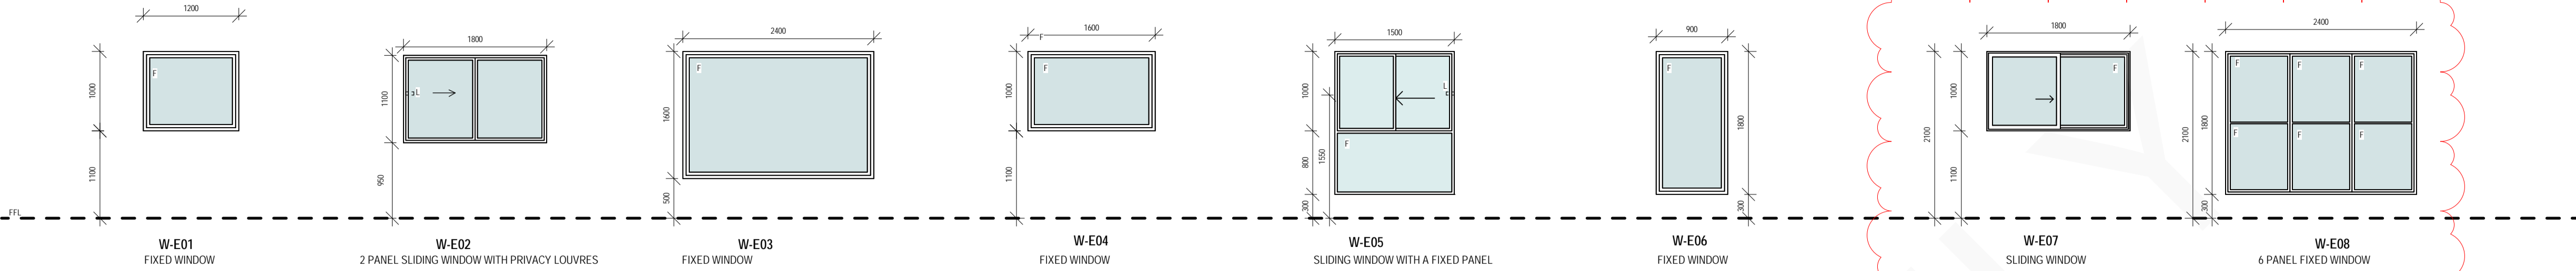


INTERNAL WINDOW LEGEND

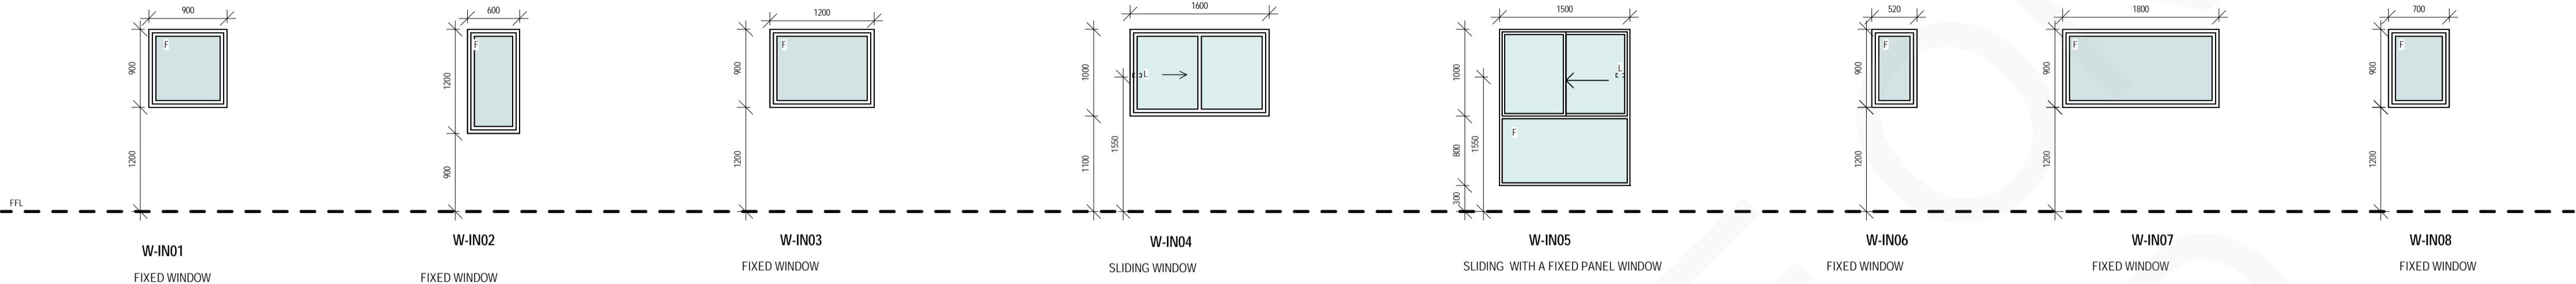[illegible]

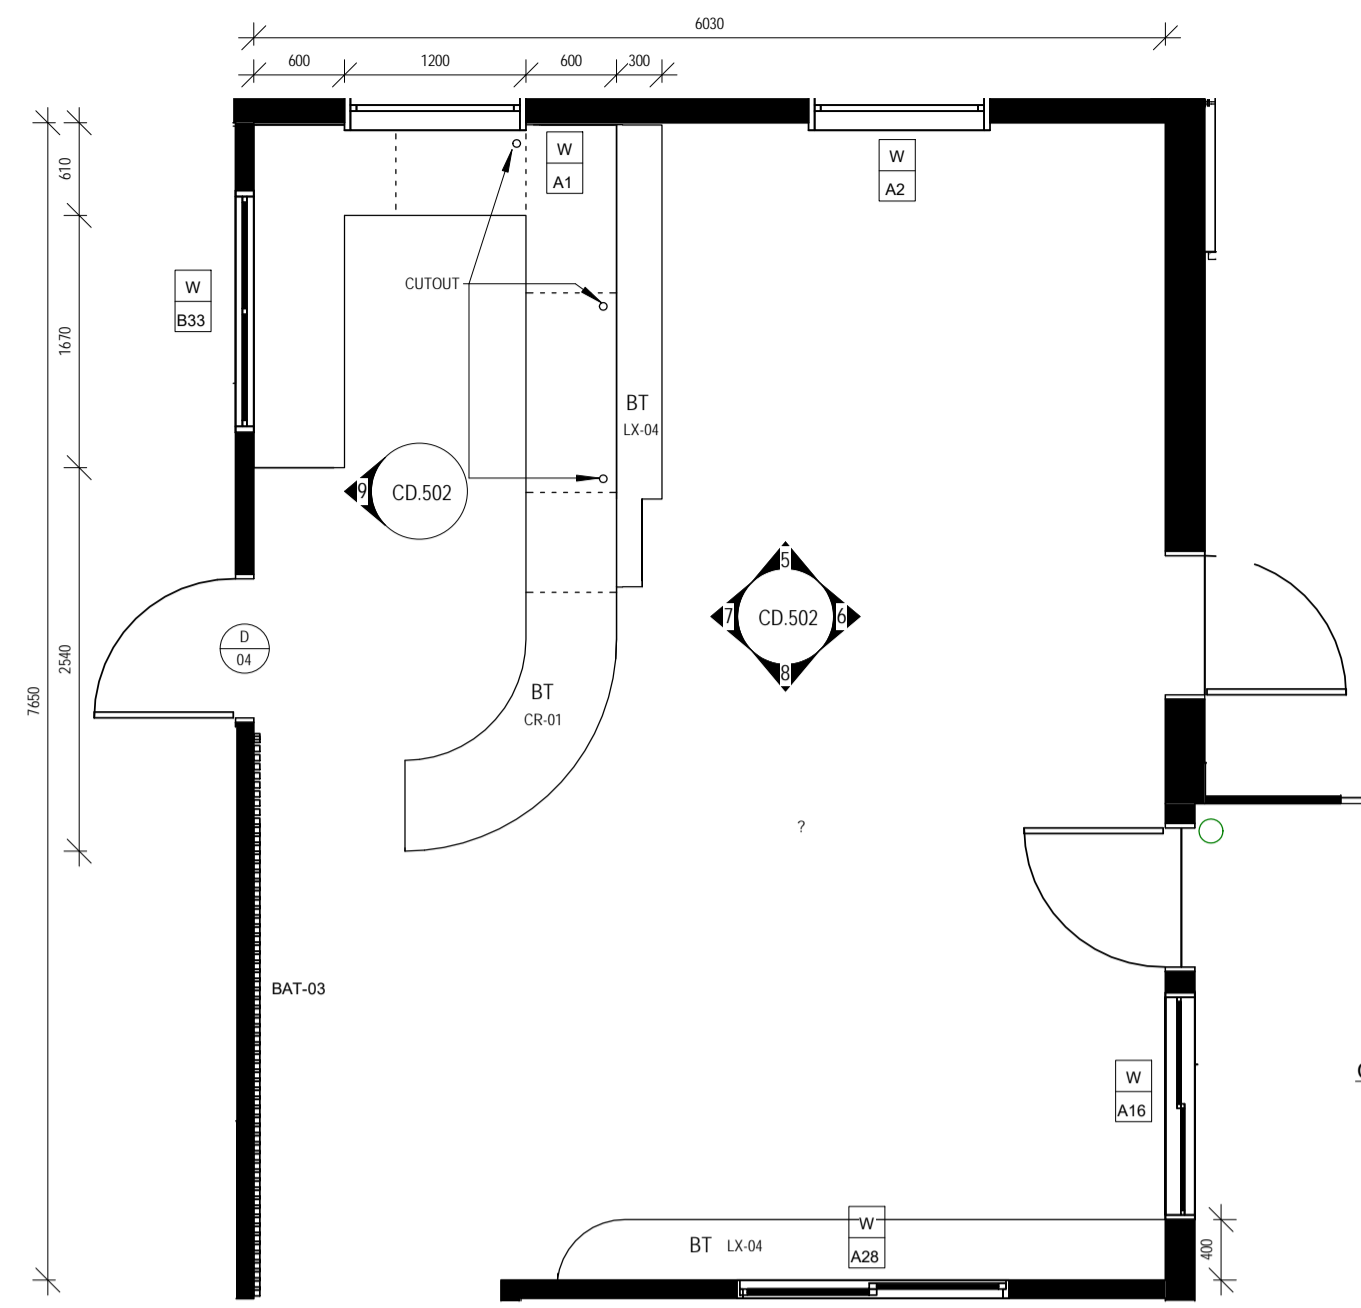


RECEPTION - PLAN

1:50 REFER 1 - CD.200

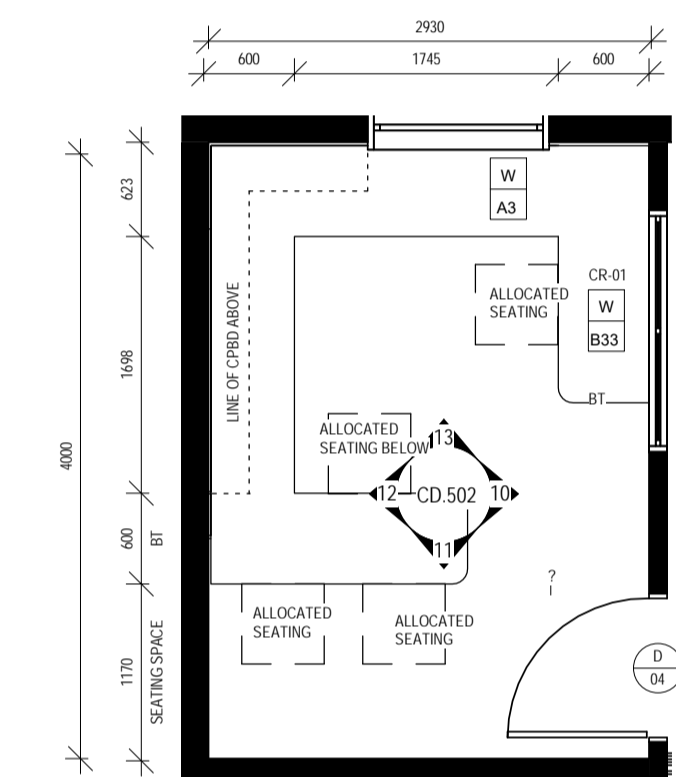


OFFICE - PLAN

1:50 REFER 2 - CD.200

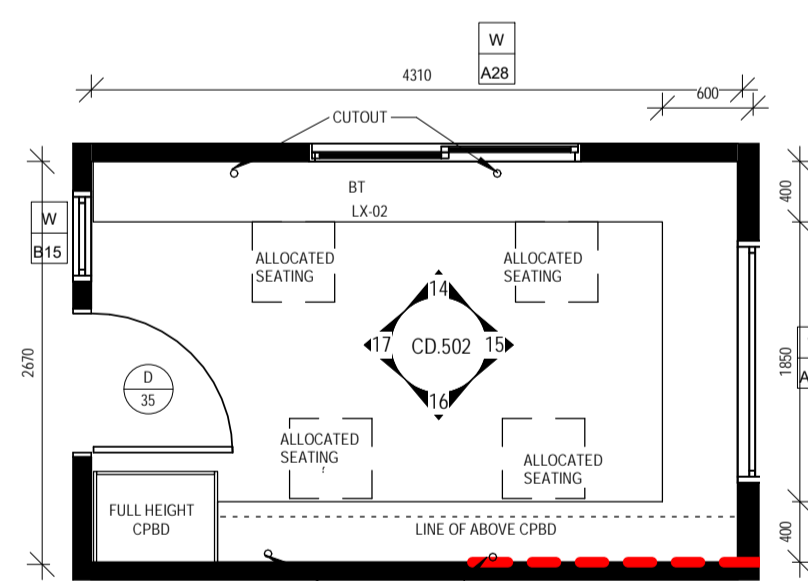


PROGRAM - PLAN

1:50 REFER 3 - CD.200

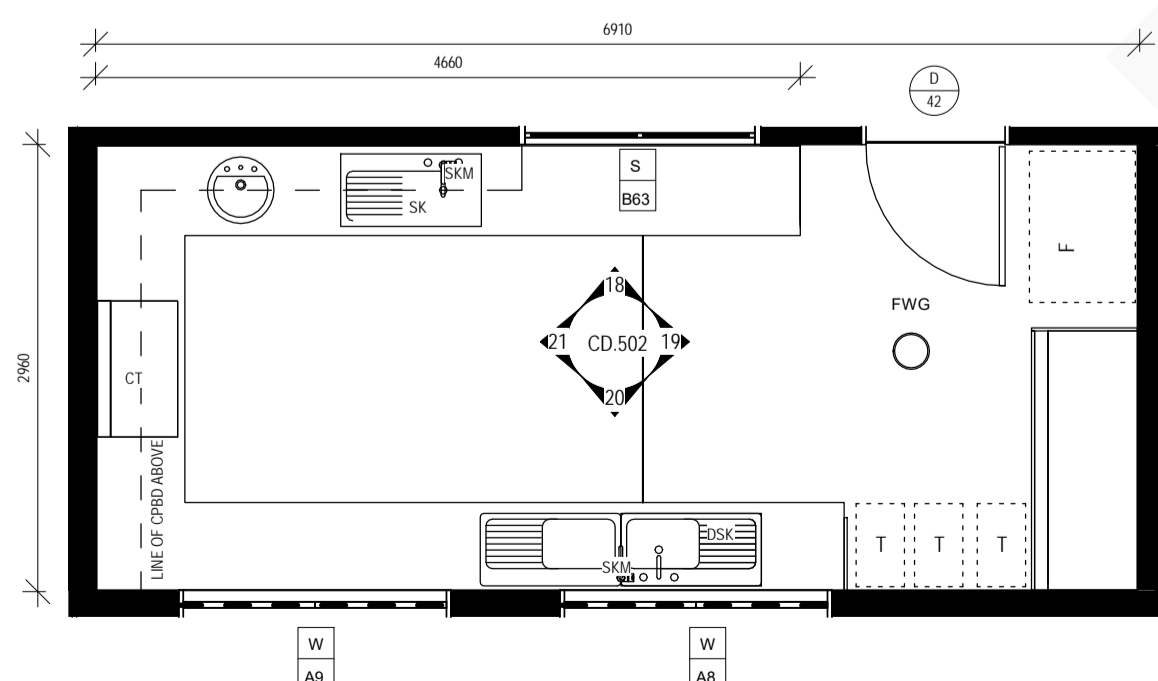


KITCHEN - PLAN

1:50 REFER 4 - CD.200

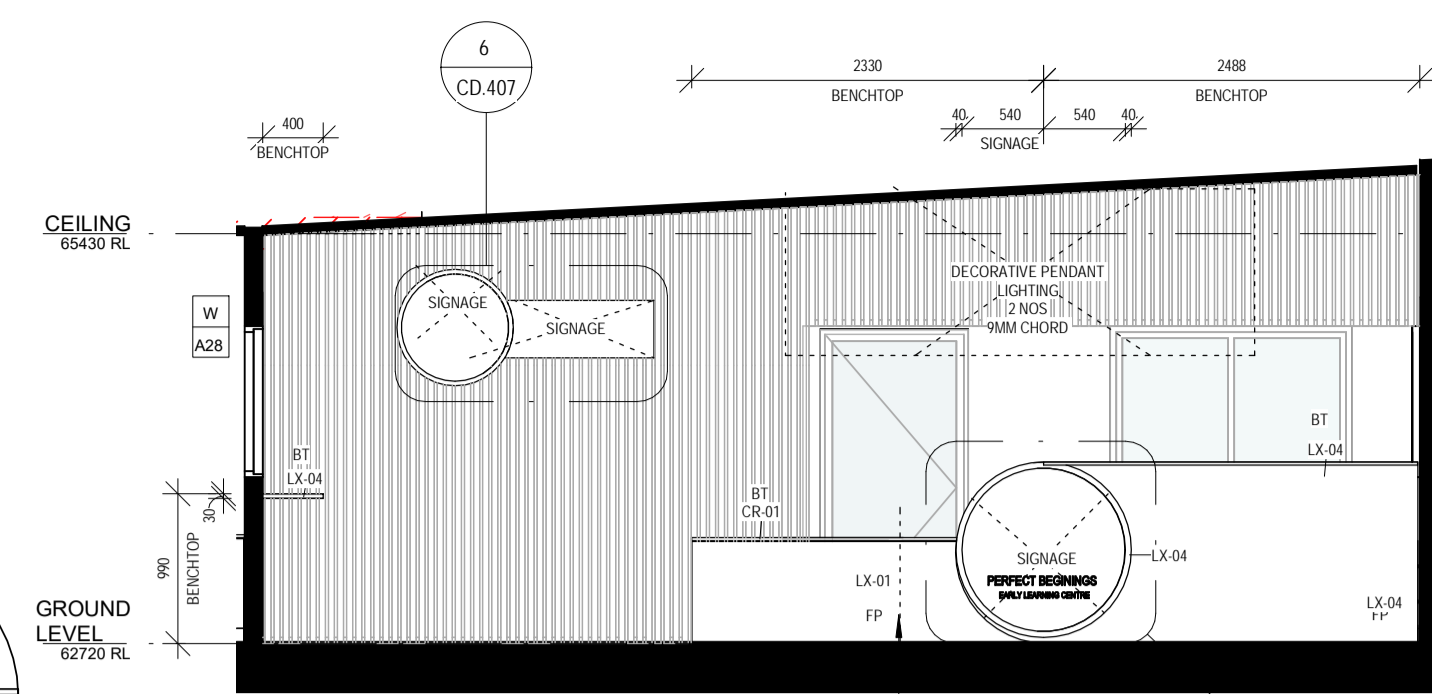


RECEPTION ELEV.7

REFER 7 - CD.502

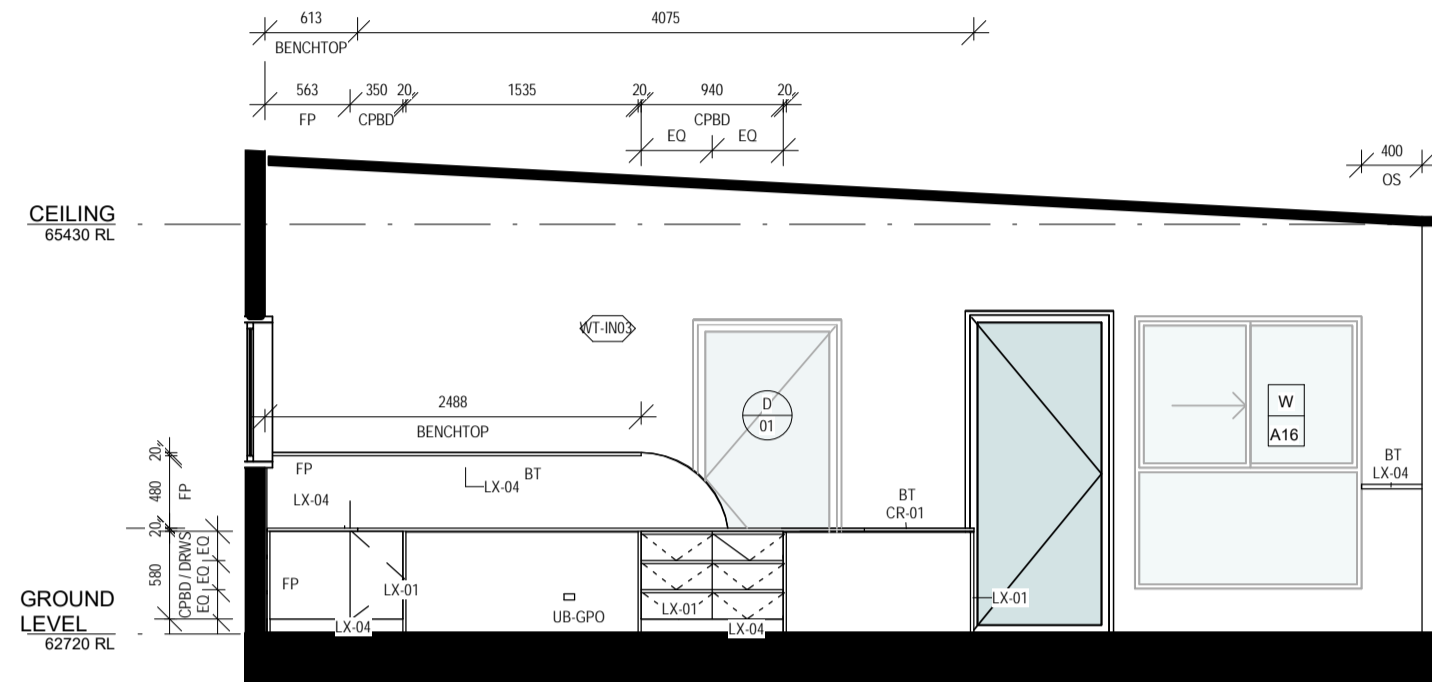


RECEPTION ELEV. 6

1:50 REFER 6 - CD.502

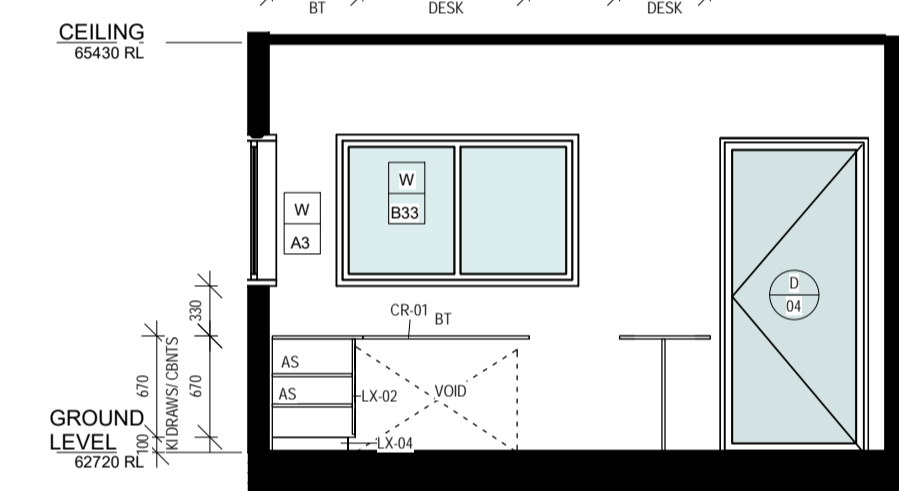


OFFICE ELEV. 10

1:50 REFER 10 - CD.502

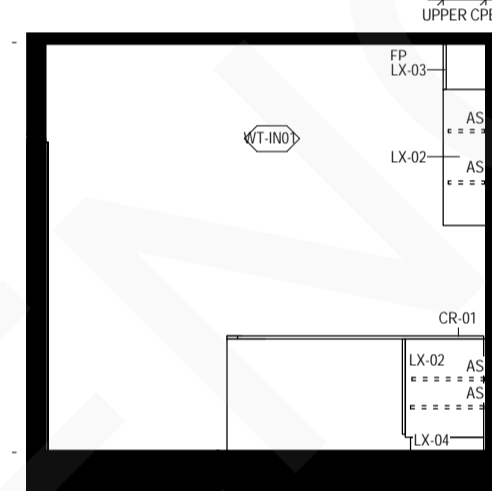


OFFICE ELEV. 11

1:50 REFER 11 - CD.405

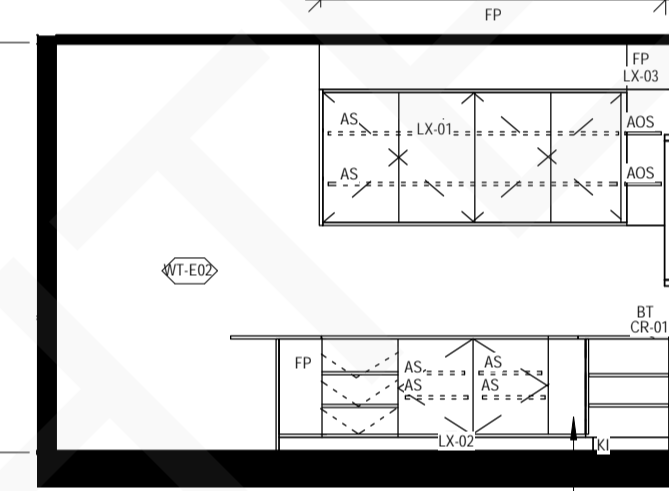


OFFICE ELEV. 12

1:50 REFER 12 - CD.502

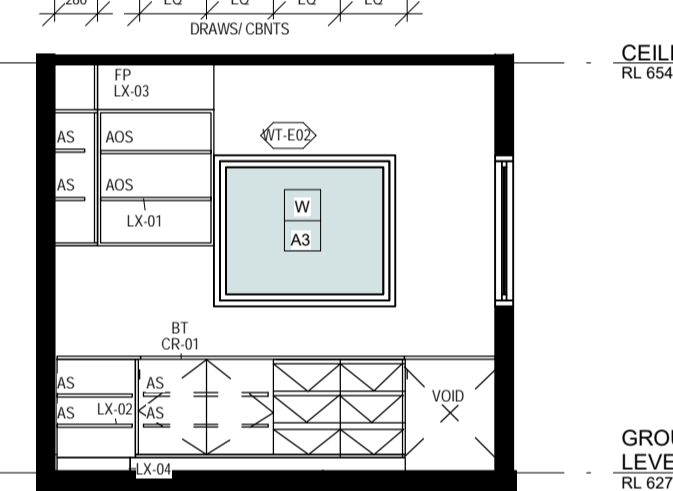


OFFICE ELEV. 13

1:50 REFER 13 - CD.405

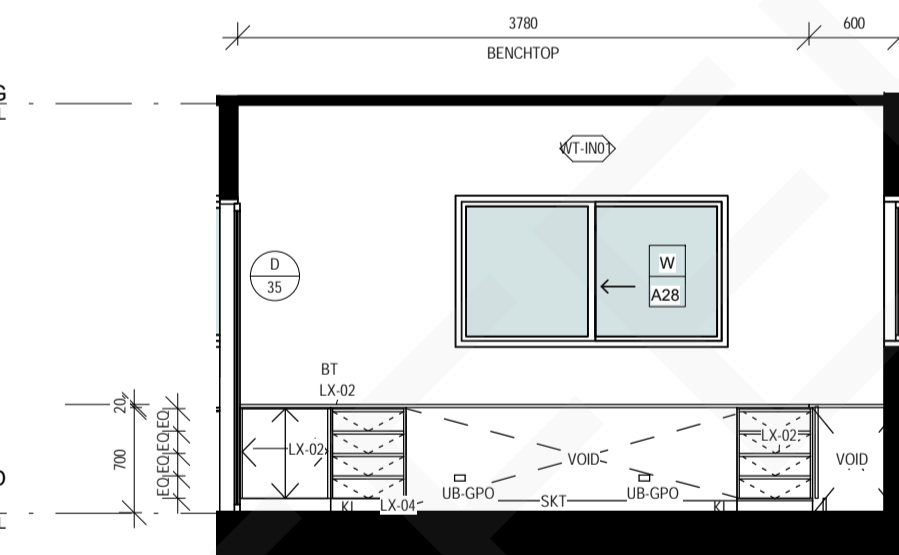


PROGRAM ELEV.14

1:50 REFER 14 - CD.502

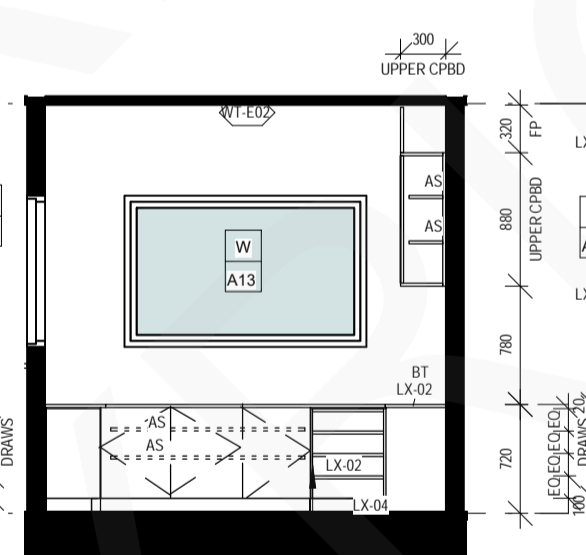


PROGRAM ELEV. 15

1:50 REFER 15 - CD.502

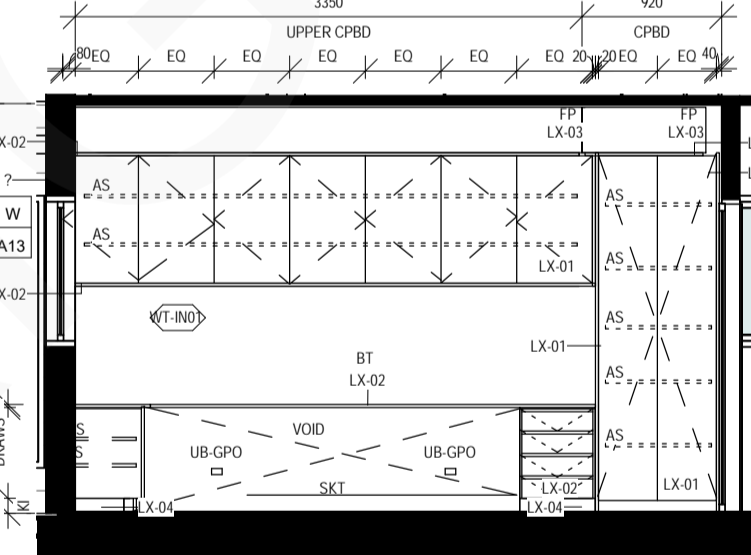


PROGRAM ELEV.16

1:50 REFER 16 - CD.502

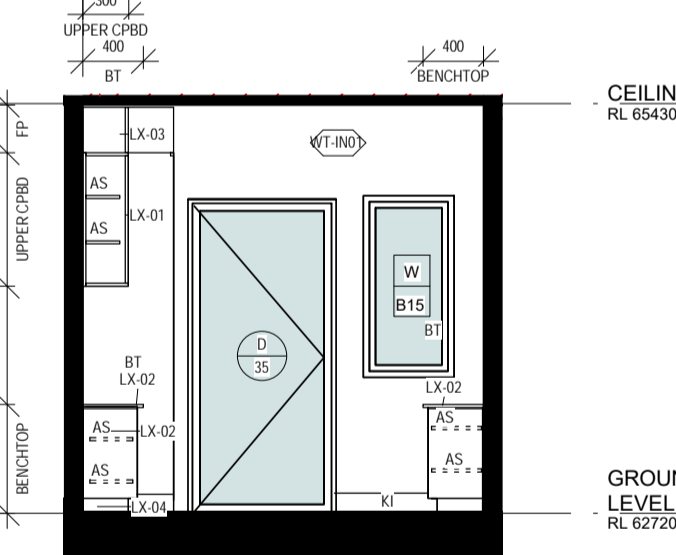


PREGRAM ELEV. 17

1:50 REFER 17 - CD.502

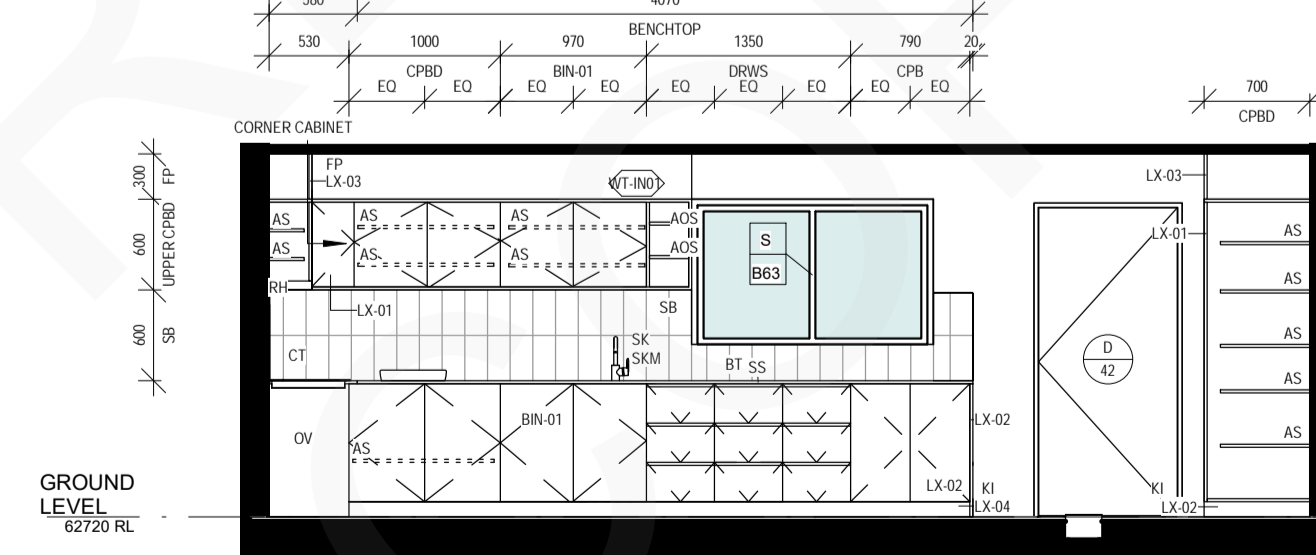


KITCHEN ELEV. 18

1:50 REFER 18 - CD.502

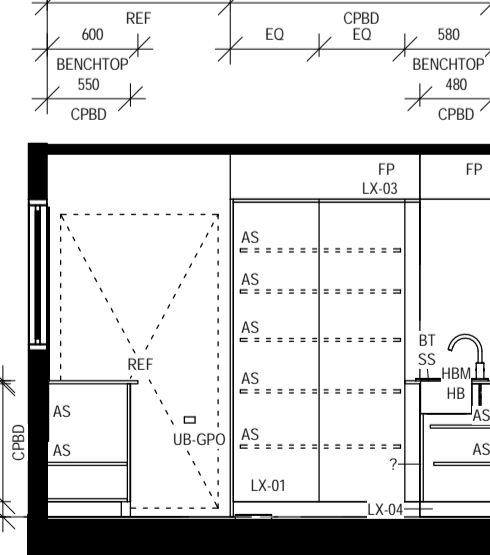


KITCHEN ELEV. 19

1:50 REFER 19 - CD.405

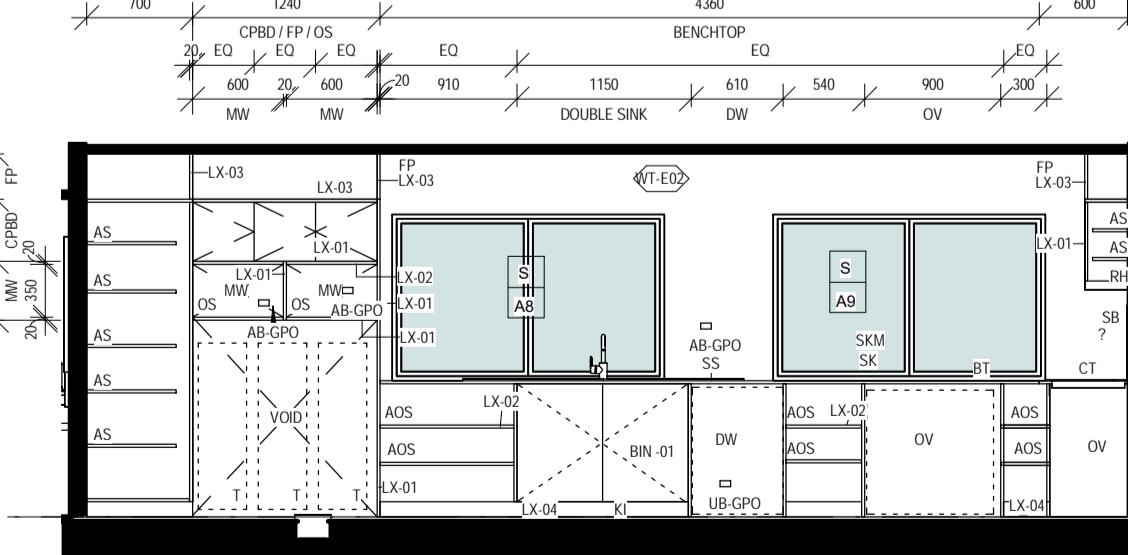


KITCHEN ELEV. 20

1:50 REFER 20 - CD.502

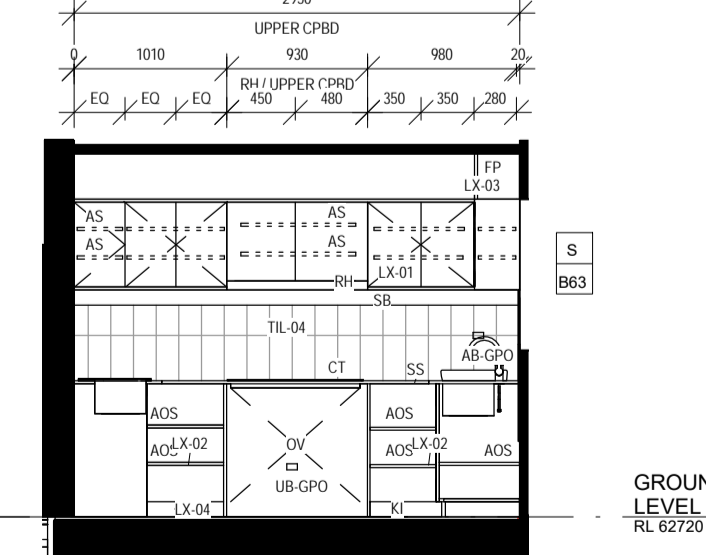


KITCHEN ELEV. 21

1:50 REFER 21 - CD.405

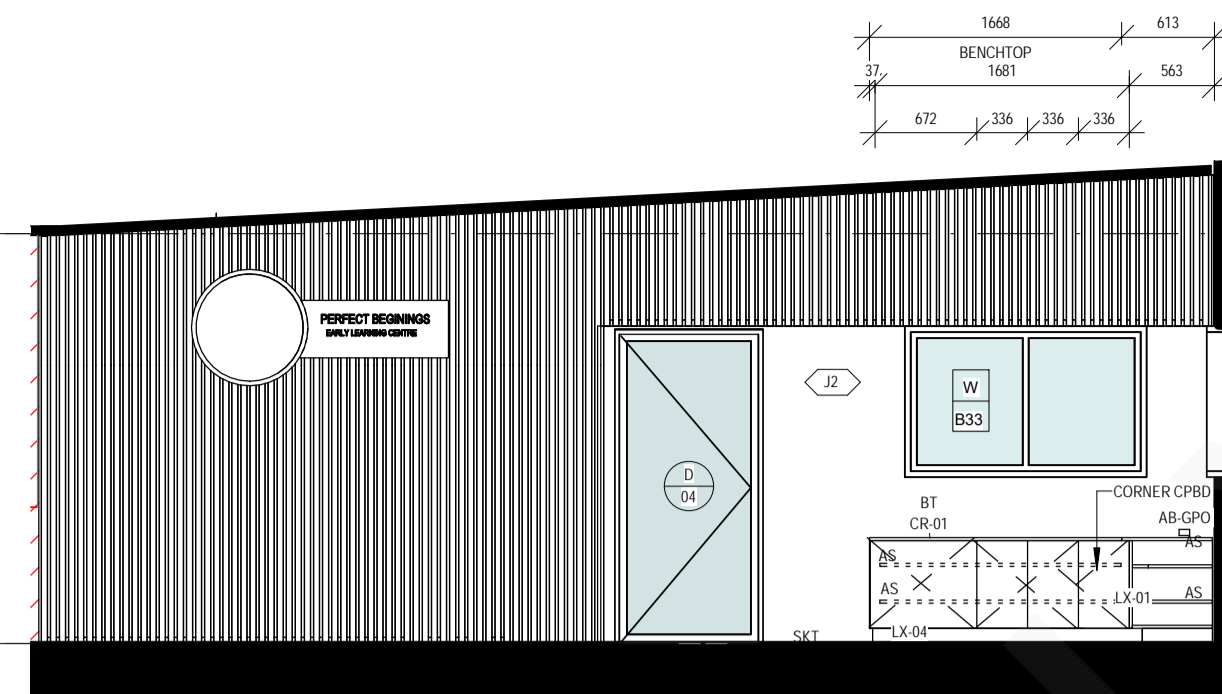

RECEPTION ELEV.9

REFER 9 - CD.502

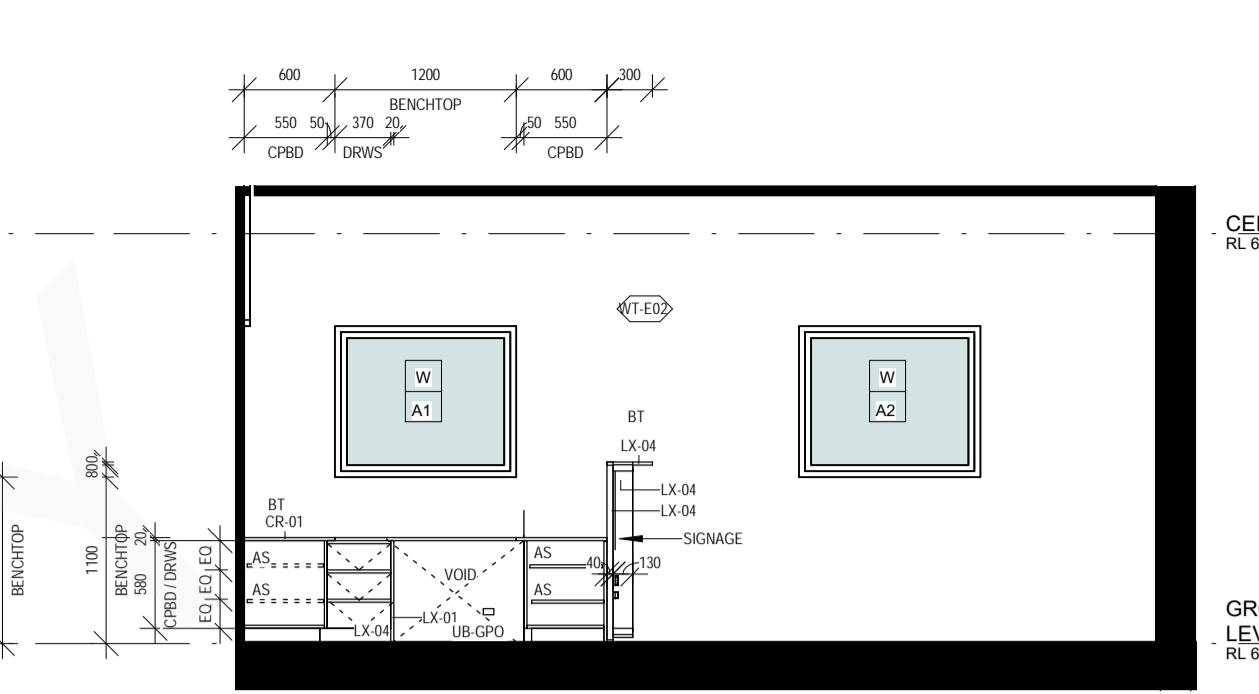

RECEPTION ELEV. 5

REFER 5 - CD.404

LEGEND:

- AS ADJUSTABLE SHELF
- B BASIN
- BB BABY BATH
- BR BACK REST
- BT BENCHTOP
- COH COAT HOOK
- CS CLEANER'S SINK
- CSM CLEANER'S SINK MIXER
- CT COOK TOP
- D DRYER
- DRWS DRAWERS
- DW DISHWASHER
- DWC DISABLED WATER CLOSET
- DSK DOUBLE BOWL & DRAIN SINK
- F REFRIGERATOR
- FB FRUIT WASH BASIN
- FP FIXED PANEL
- FS FOLDING SEAT
- FT FILTER TAP
- FWG FLOOR WASTE
- HB HAND BASIN
- HD HAND BASIN MIXER
- HDM HAND DRYER
- GPO DOUBLE GENERAL POWER OUTLET
- GR GRAB RAIL
- JB JUNIOR BASIN
- JWC JUNIOR TOILET
- KI KICK
- LO LOCK
- LS LOCKER SYSTEM
- LT LAUNDRY TUB
- LTM LAUNDRY TUB MIXER
- M MIRROR
- MW MICROWAVE
- OS OPEN SHELF
- AOS ADJUSTIVE OPEN SHELF
- OV OVEN
- PTD PAPER TOWEL DISPENSER
- RH RANGE HOOD
- SB SPLASHBACK
- SC SHOWER CURTAIN
- SD SOAP DISPENSER
- SH SHELF
- SHR SHOWER
- SK SINK
- SKD SINK - DOUBLE BOWL
- SKM SINK MIXER
- SKT-OTSKIRTING - GENERAL
- SKT-OTSKIRTING - VINYL COVE
- SM SHOWER MIXER
- S.S. STAINLESS STEEL
- T TRAYS
- TRH TOILET ROLL HOLDER
- TR TOWEL RAIL
- TS TILED SPLASHBACK
- UF UNDER BENCH REFRIGERATOR
- WM WASHING MACHINE
- WT WALL TAP

ELECTRICAL LEGEND


- AB-GPO ABOVE BENCH GPO
- UB-GPO UNDER BENCH GPO
- ALL OTHER EXPOSED GPDS TO BE CHILD SAFE AND MIN 1500mm HIGH IN PLAYROOMS AND CHILDREN'S AMENITIES

**REFER TO ELECTRICAL ENGINEERS DRAWINGS FOR DETAIL


REFER TO ARCHITECTURAL SCHEDULE OF FINISHES FOR MATERIAL AND COLOUR

NOTES:


- ALL JOINERY DIMENSIONED FROM FINISHED FACE OF WALL.
- ALL PLUMBING DIMENSIONED FROM WALL STRUCTURE.
- LAMINATE SYSTEM FOR TOILET PARTITIONS
- ALL OPEN SHELVES ON THIS SHEET SHOULD HAVE BACKING AS SAME AS THE SHELVING

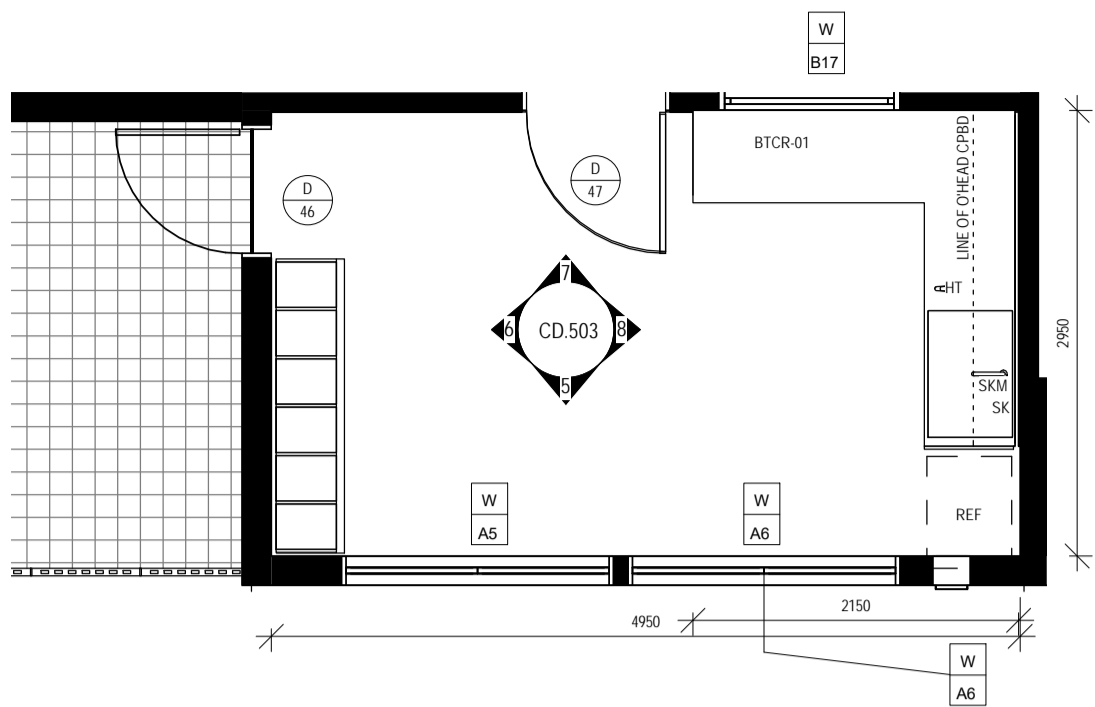


STAFF ROOM - PLAN
1: 50 REFER 1 - CD.200

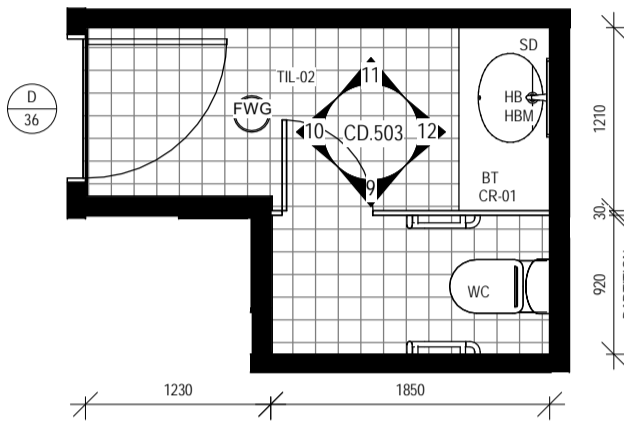


STAFF WC - PLAN
1: 50 REFER 2 - CD.200

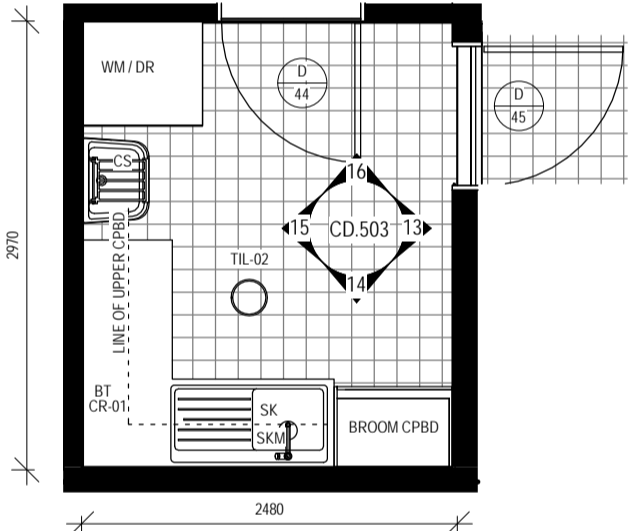


LAUNDRY - PLAN
1: 50 REFER 3 - CD.200

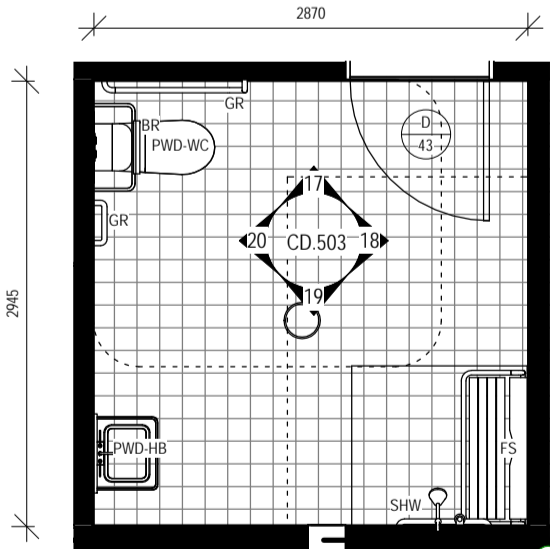


PWD - PLAN
1: 50 REFER 4 - CD.200

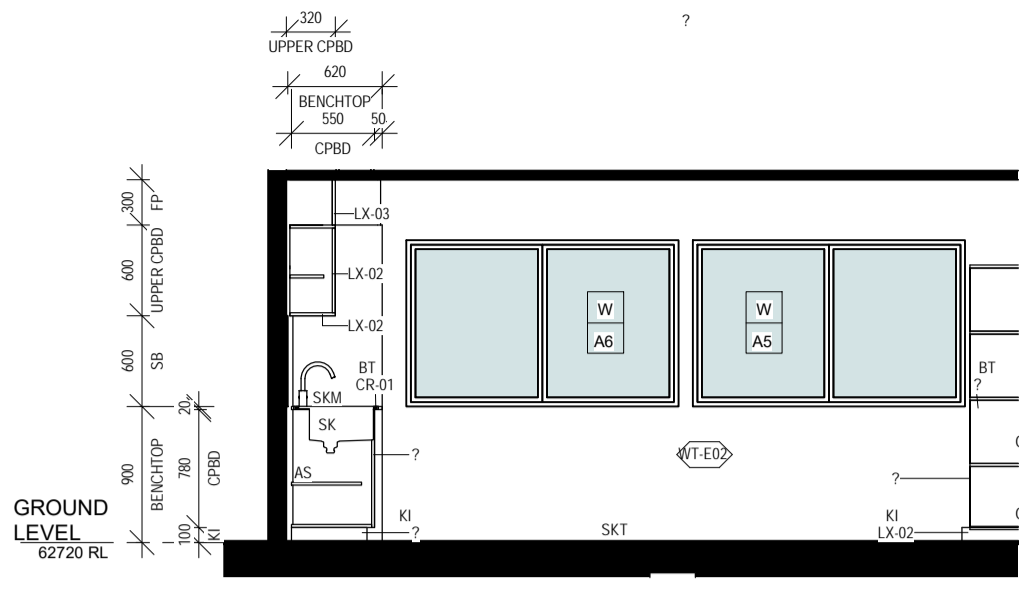


STAFF ROOM ELEV. 5
1: 50 REFER 5 - CD.503

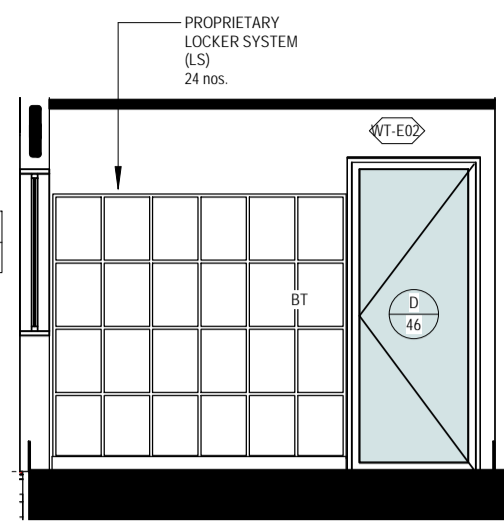


STAFF ROOM ELEV. 6
1: 50 REFER 6 - CD.503

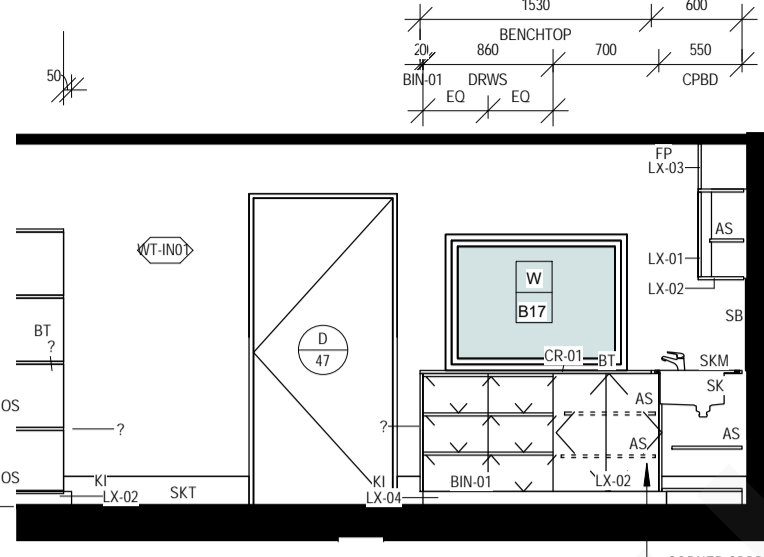


STAFF ROOM ELEV. 7
1: 50 REFER 7 - CD.503

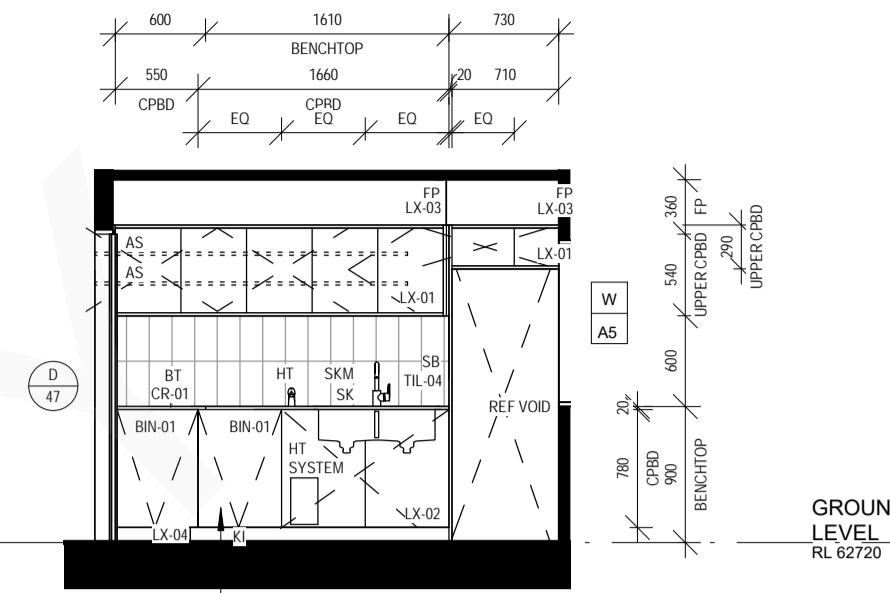


STAFF ROOM ELEV. 8
1: 50 REFER 8 - CD.503

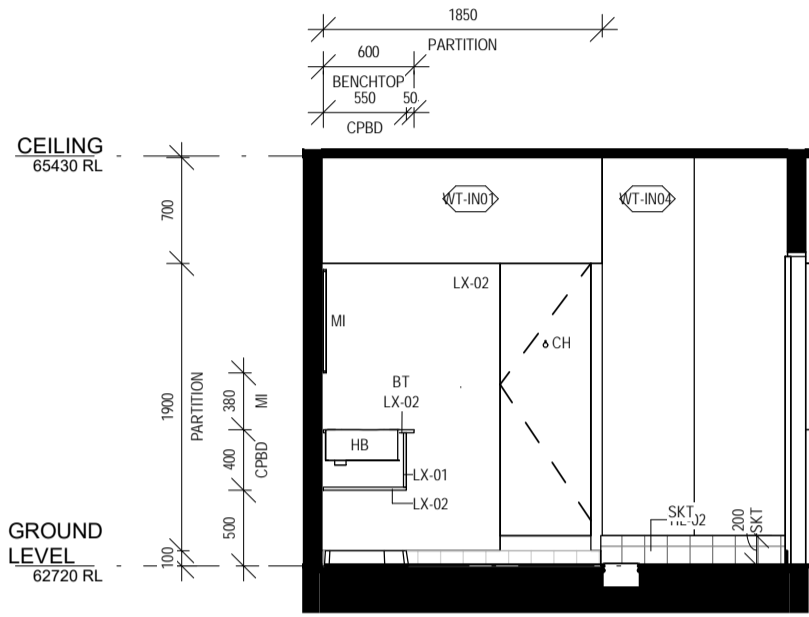


STAFF WC ELEV.9
1: 50 REFER 9 - CD.503

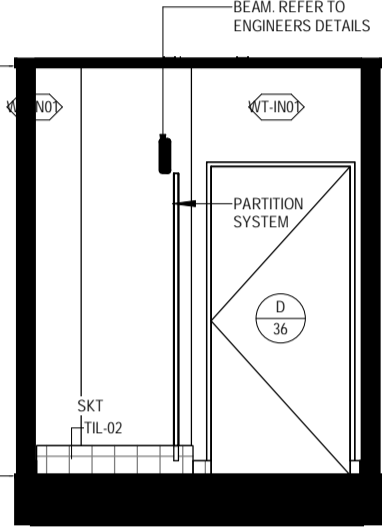


STAFF WC ELEV. 10
1: 50 REFER 10 - CD.502

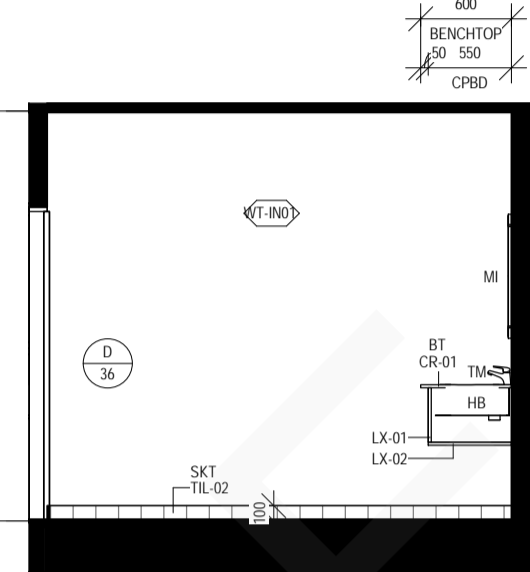


STAFF WC ELEV. 11
1: 50 REFER 11 - CD.503

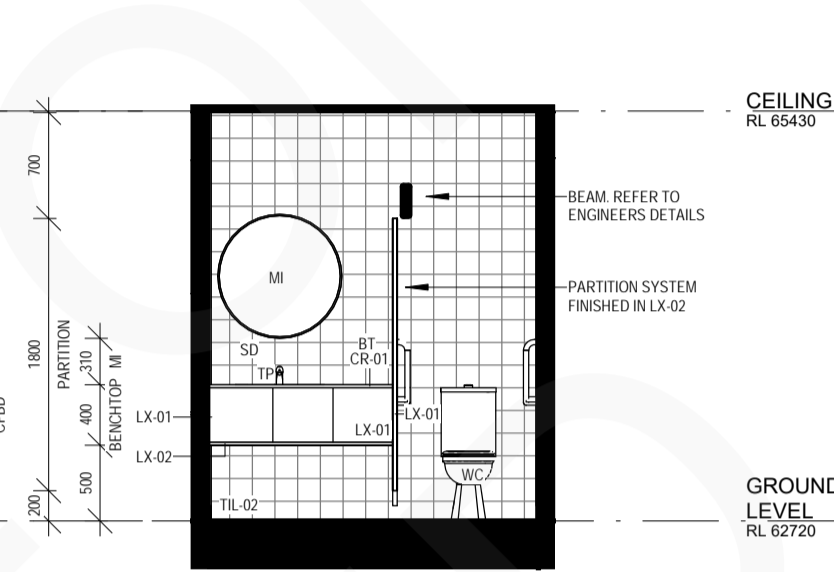


STAFF WC ELEV. 12
1: 50 REFER 12 - CD.502

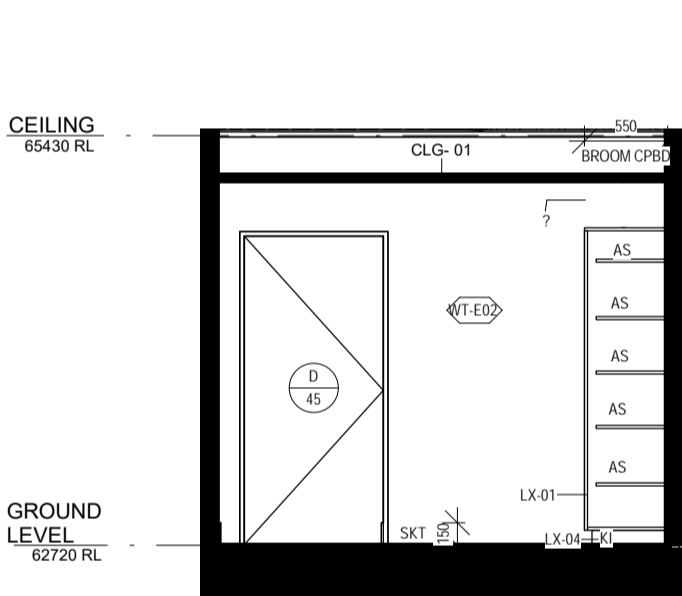


LAUNDRY ELEV. 13
1: 50 REFER 13 - CD.503

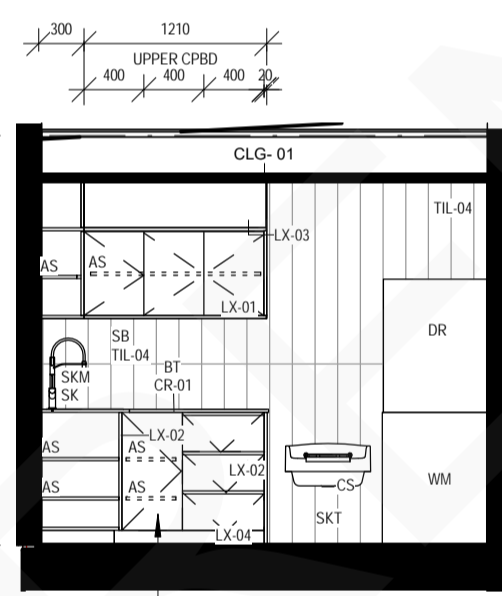


LAUNDRY ELEV. 14
1: 50 REFER 14 - CD.503

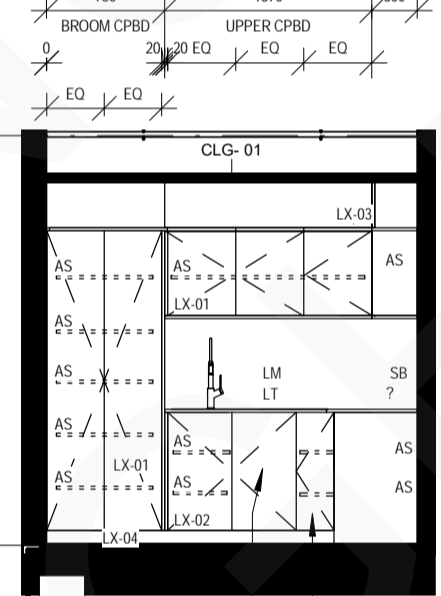


LAUNDRY ELEV. 15
1: 50 REFER 15 - CD.503

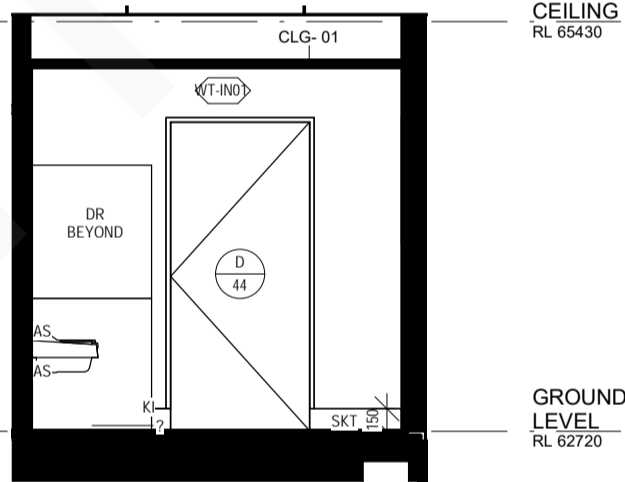


LAUNDRY ELEV. 16
1: 50 REFER 16 - CD.503

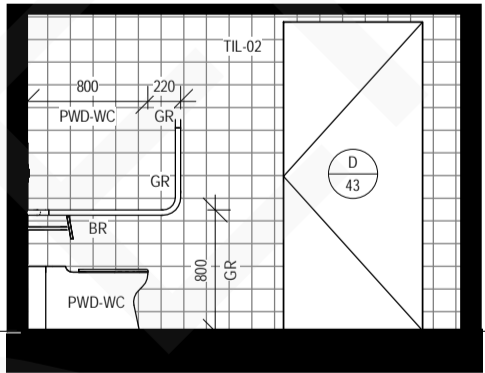


PWD ELEV. 17
1: 50 REFER 17 - CD.503

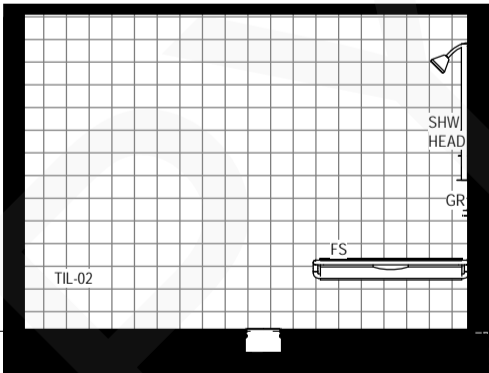

PWD ELEV. 18
1: 50 REFER 18 - CD.503

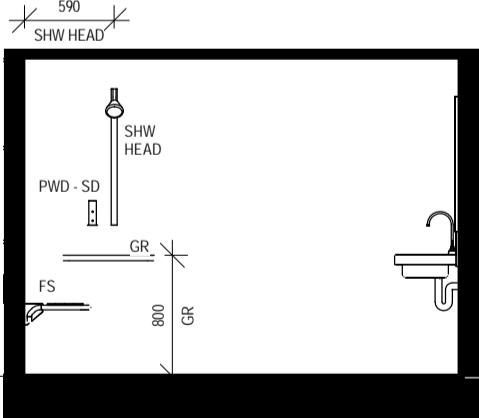

PWD ELEV. 19
1: 50 REFER 19 - CD.503

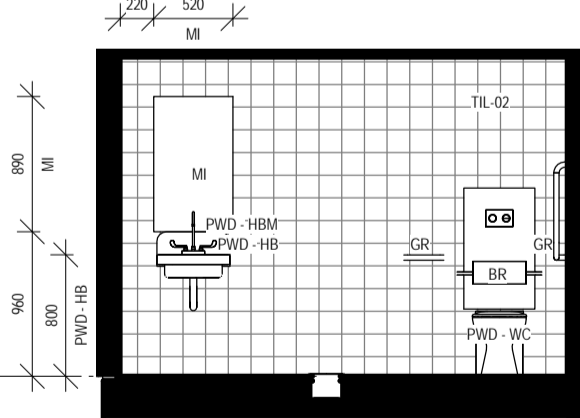

PWD ELEV. 20
1: 50 REFER 20 - CD.503

LEGEND:

- AS ADJUSTABLE SHELF
- B BASIN
- BB BABY BATH
- BR BACK REST
- BT BENCHTOP
- COH COAT HOOK
- CS CLEANER'S SINK
- CSM CLEANER'S SINK MIXER
- CT COOK TOP
- D DRYER
- DRWS DRAWERS
- DW DISHWASHER
- DWC DISABLED WATER CLOSET
- DSK DOUBLE BOWL & DRAIN SINK
- F REFRIGERATOR
- FB FRUIT WASH BASIN
- FP FIXED PANEL
- FS FOLDING SEAT
- FT FILTER TAP
- FWG FLOOR WASTE
- HB HAND BASIN
- HD HAND BASIN MIXER
- HDM HAND DRYER
- GPO DOUBLE GENERAL POWER OUTLET
- GR GRAB RAIL
- JB JUNIOR BASIN
- JWC JUNIOR TOILET
- KI KICK
- LO LOCK
- LS LOCKER SYSTEM
- LT LAUNDRY TUB
- LTM LAUNDRY TUB MIXER
- MI MIRROR
- MW MICROWAVE
- OS OPEN SHELF
- AOS ADJUSTIVE OPEN SHELF
- OV OVEN
- PTD PAPER TOWEL DISPENSER
- RH RANGE HOOD
- SB SPLASHBACK
- SC SHOWER CURTAIN
- SD SOAP DISPENSER
- SH SHELF
- SHR SHOWER
- SK SINK
- SKD SINK - DOUBLE BOWL
- SKM SINK MIXER
- SKT-01SKIRTING - GENERAL
- SKT-02SKIRTING - VINYL COVE
- SM SHOWER MIXER
- S.S. STAINLESS STEEL
- T TRAYS
- TRH TOILET ROLL HOLDER
- TR TOWEL RAIL
- TS TILED SPLASHBACK
- UF UNDER BENCH REFRIGERATOR
- WM WASHING MACHINE
- WT WALL TAP

ELECTRICAL LEGEND

- AB-GPO ABOVE BENCH GPO
- UB-GPO UNDER BENCH GPO
- ALL OTHER EXPOSED GPOS TO BE CHILD SAFE AND MIN 1500mm HIGH IN PLAYROOMS AND CHILDREN'S AMENITIES


**REFER TO ELECTRICAL ENGINEERS DRAWINGS FOR DETAIL

REFER TO ARCHITECTURAL SCHEDULE OF FINISHES FOR MATERIAL AND COLOUR


NOTES:

- ALL JOINERY DIMENSIONED FROM FINISHED FACE OF WALL
- ALL PLUMBING DIMENSIONED FROM WALL STRUCTURE
- LAMINATE SYSTEM FOR TOILET PARTITIONS
- ALL OPEN SHELVES ON THIS SHEET SHOULD HAVE BACKING AS SAME AS THE SHELVING


- LX-01 LAMINEX, PERUVIAN CLAY
- LX-02 LAMINEX, EARTH
- LX-03 LAMINEX, NATURAL WHITE
- LX-04 LAMINEX, FOSSIL

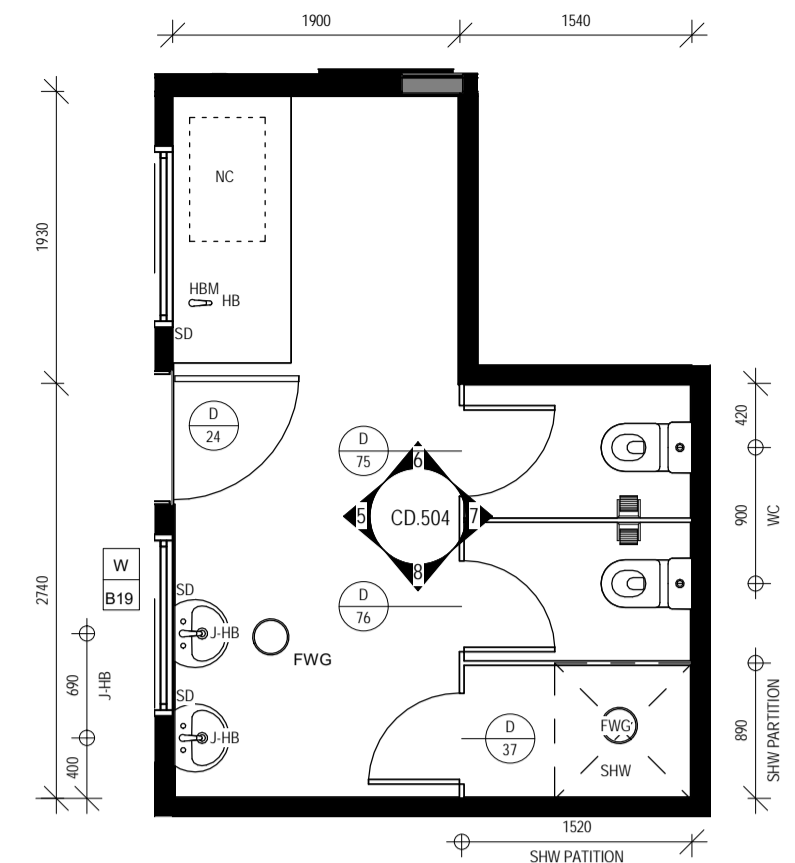


AMENITY K2 - PLAN
1:50 REFER 1 - CD.200

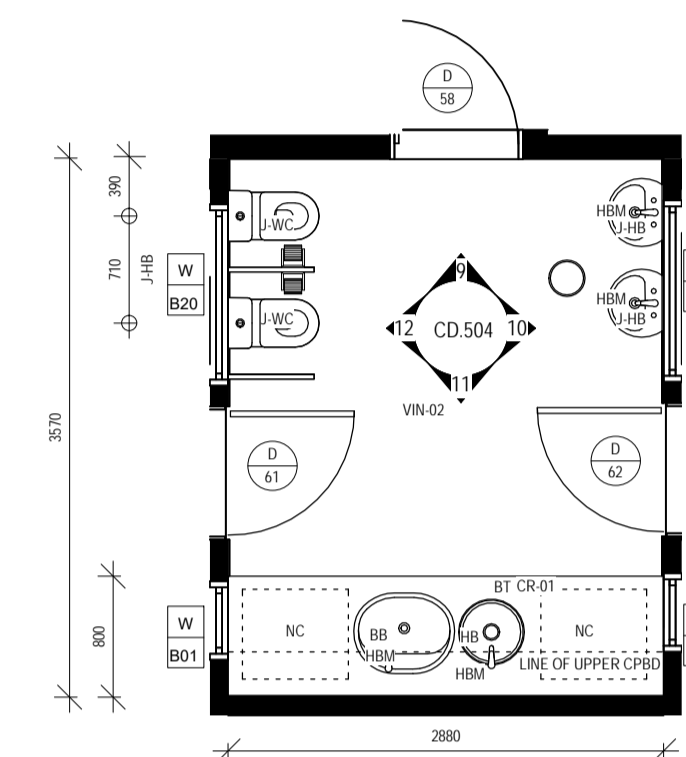


AMENITY N1/2 - PLAN
1:50 REFER 3 - CD.200

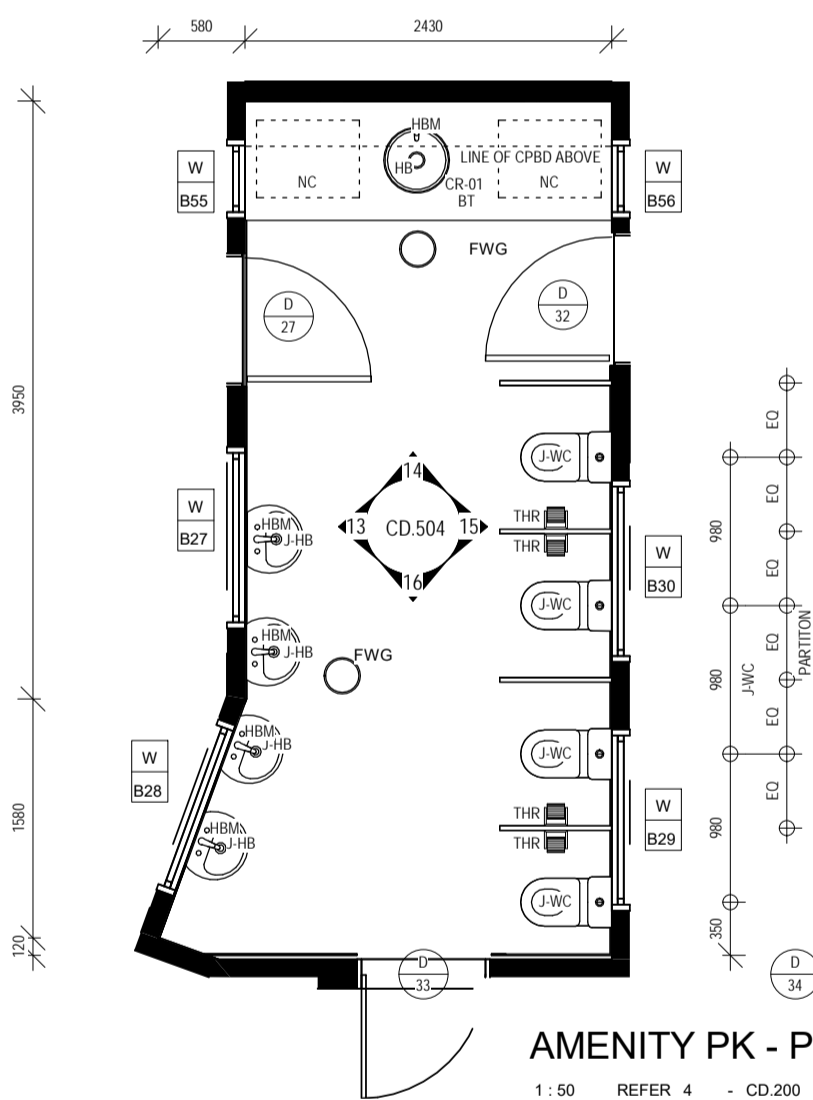


AMENITY PK - PLAN
1:50 REFER 4 - CD.200

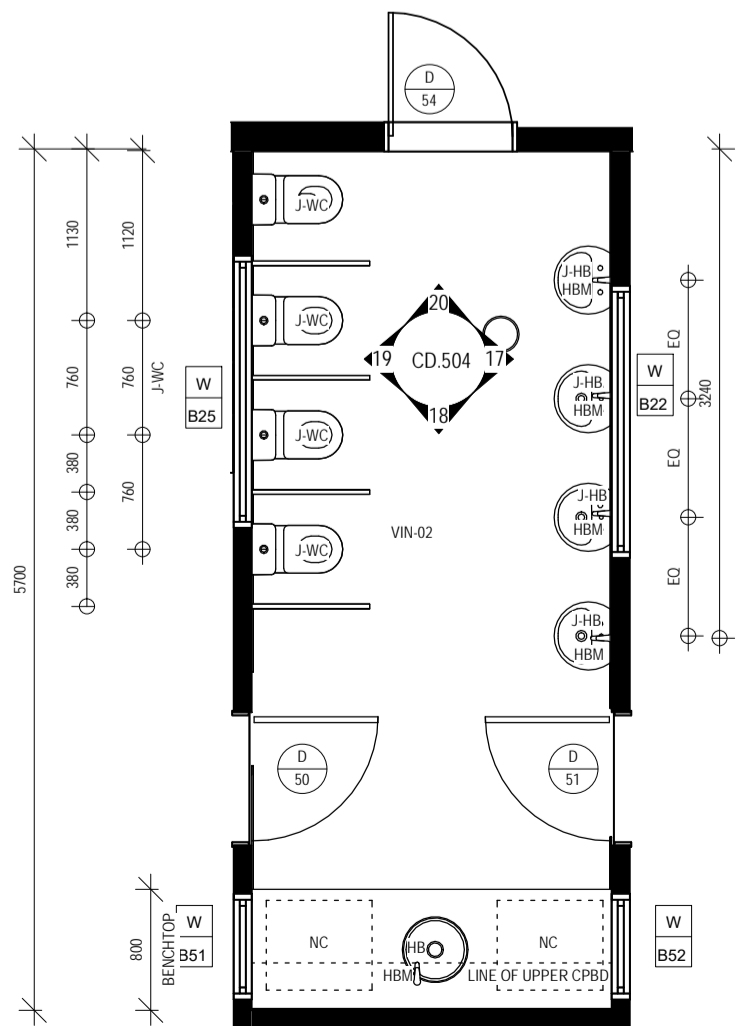


AMENITY T1/2 - PLAN
1:50 REFER 2 - CD.200

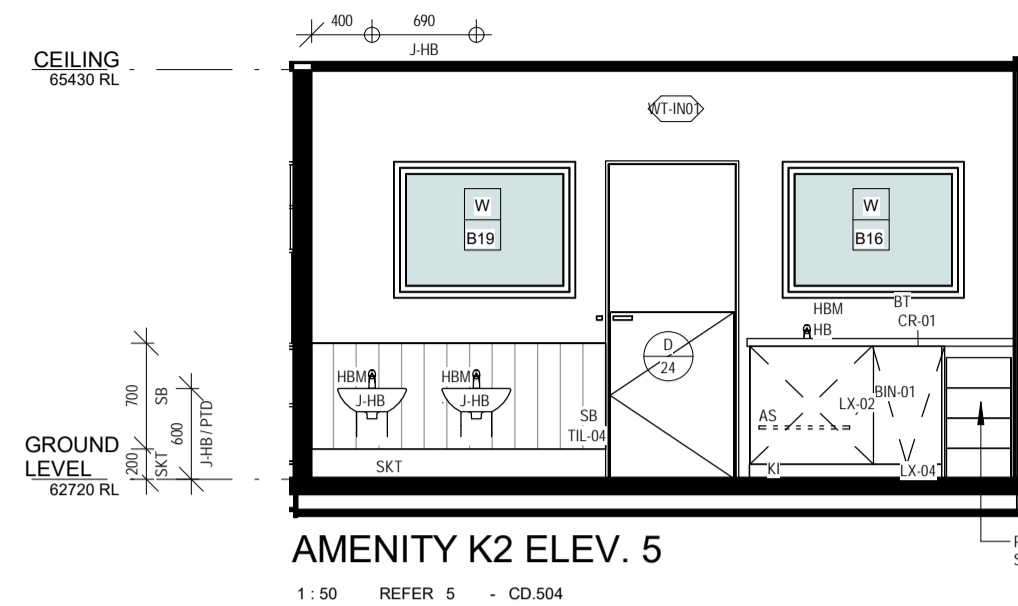


AMENITY K2 ELEV. 5
1:50 REFER 5 - CD.504

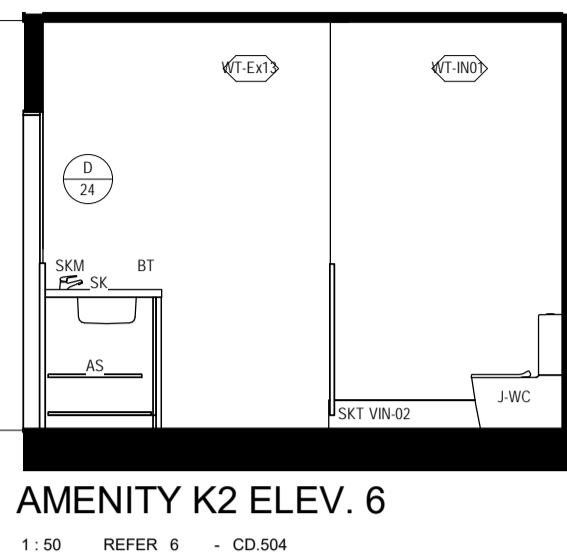


AMENITY K2 ELEV. 6
1:50 REFER 6 - CD.504

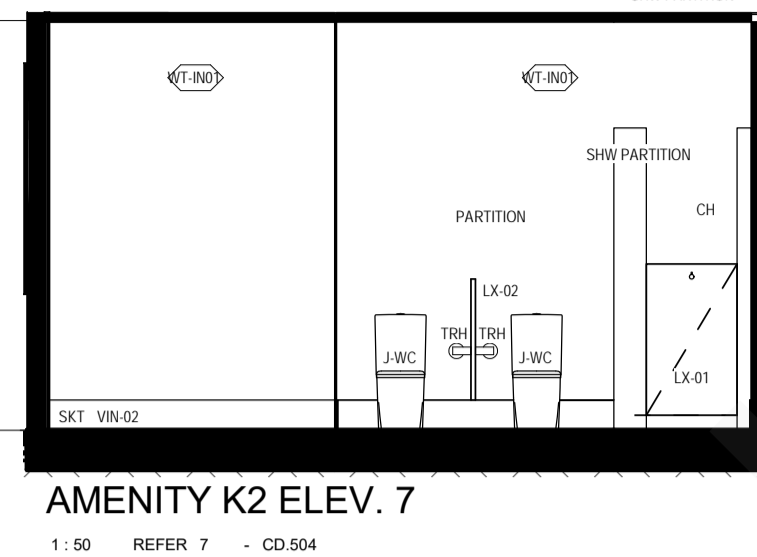


AMENITY K2 ELEV. 7
1:50 REFER 7 - CD.504

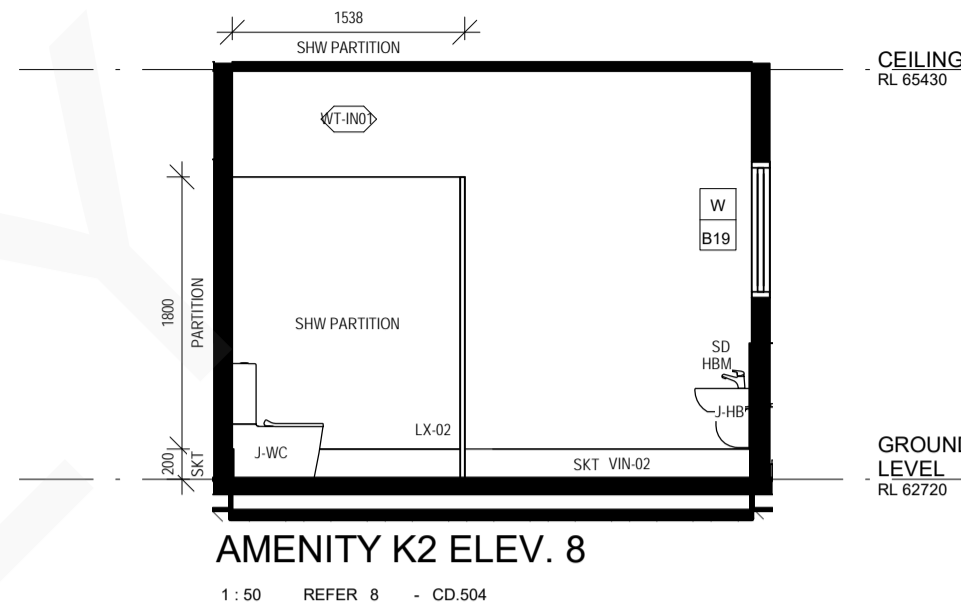


AMENITY K2 ELEV. 8
1:50 REFER 8 - CD.504

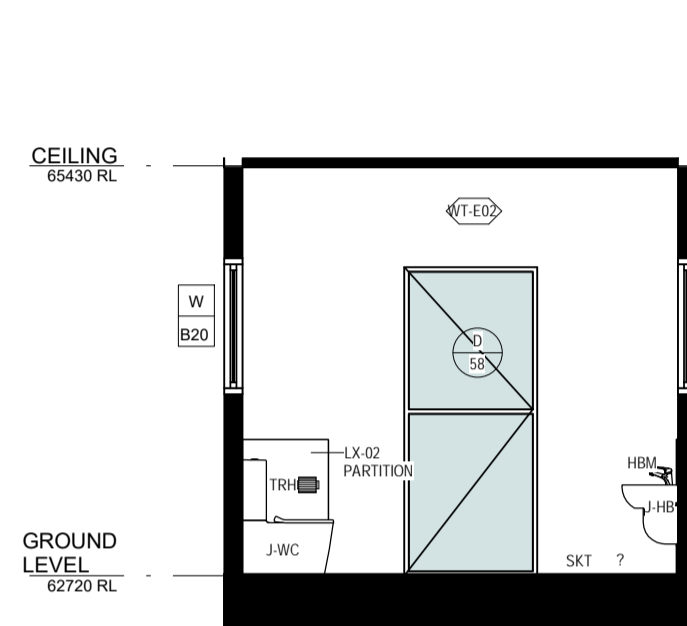


AMENITY N1/2 ELEV. 9
1:50 REFER 9 - CD.504

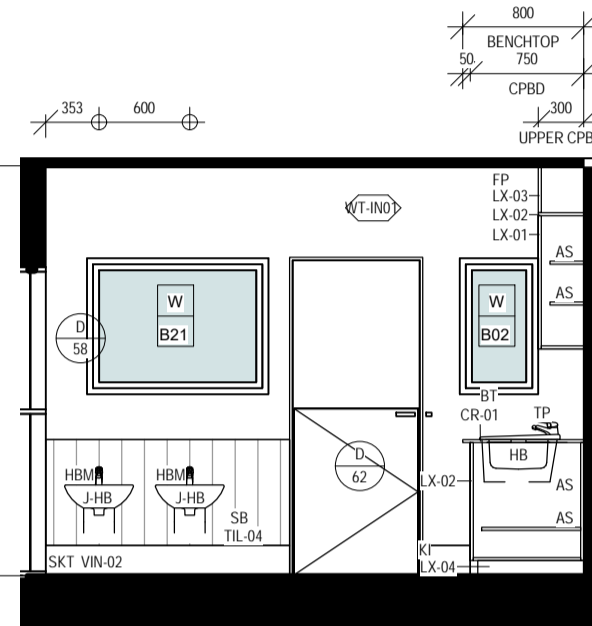


AMENITY N1/2 ELEV. 10
1:50 REFER 10 - CD.504

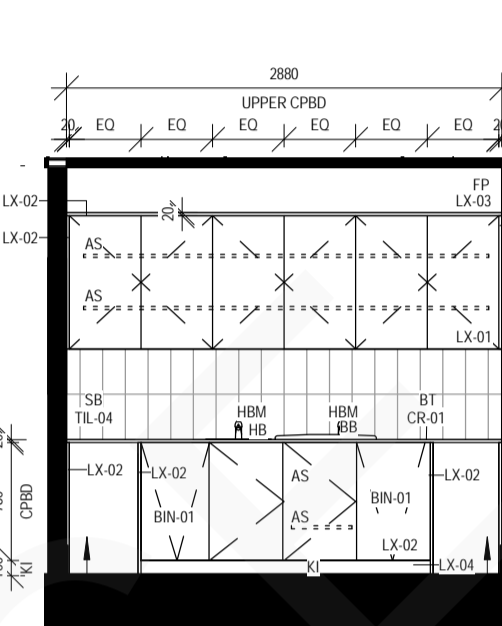


AMENITY N1/2 ELEV. 11
1:50 REFER 11 - CD.504

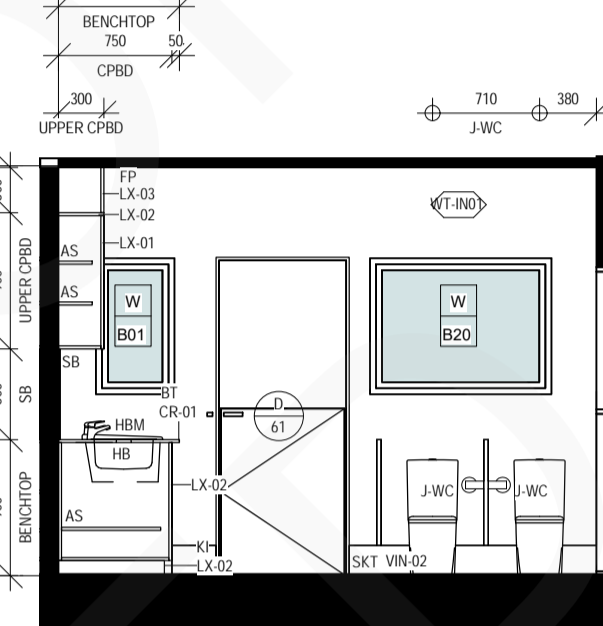


AMENITY N1/2 ELEV. 12
1:50 REFER 12 - CD.504

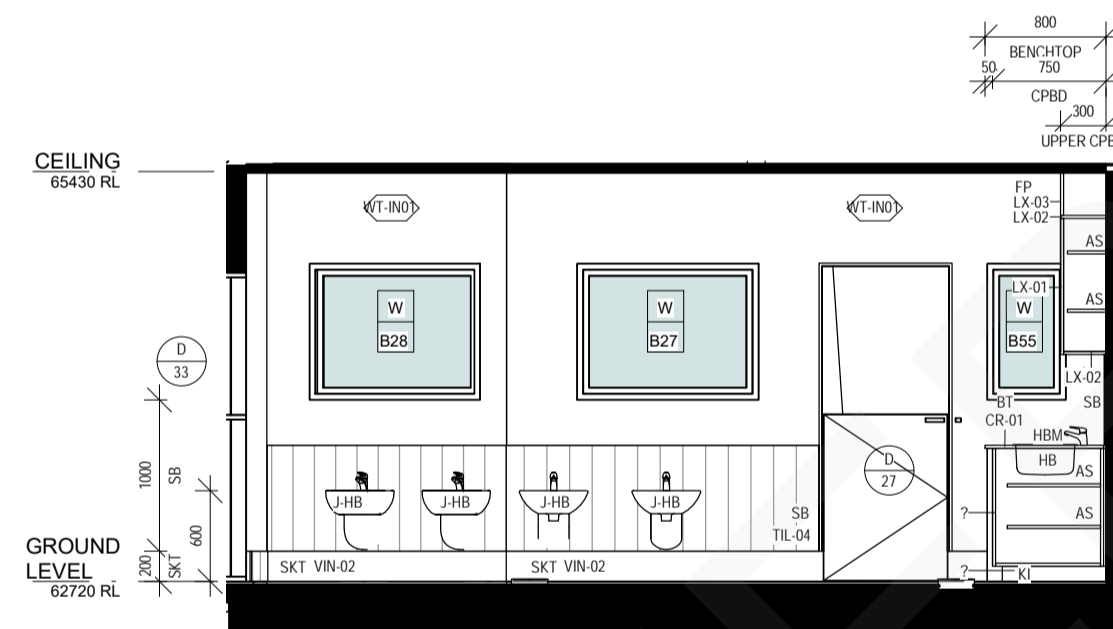


AMENITY PK ELEV. 13
1:50 REFER 13 - CD.504

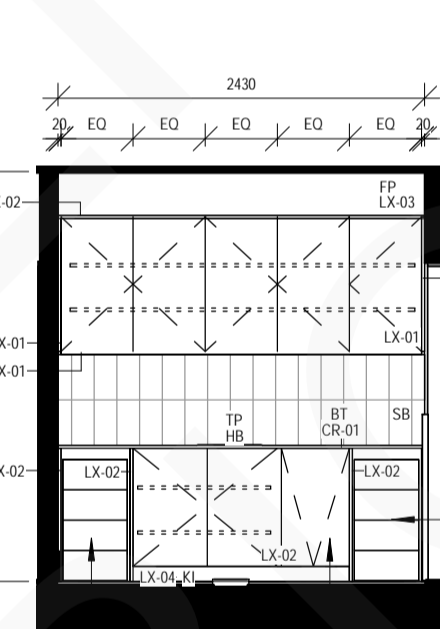


AMENITY PK ELEV. 14
1:50 REFER 14 - CD.504

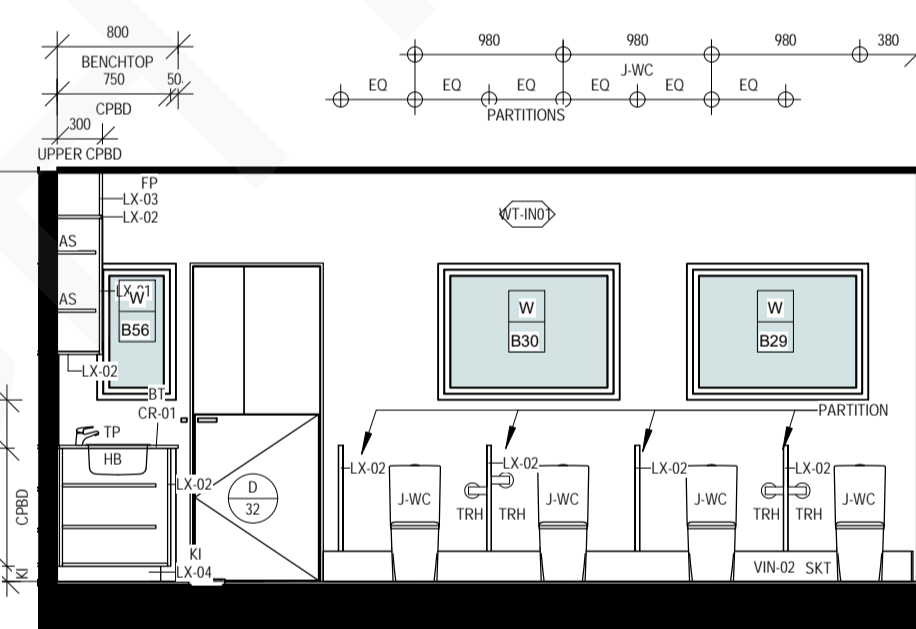


AMENITY PK ELEV. 15
1:50 REFER 15 - CD.504

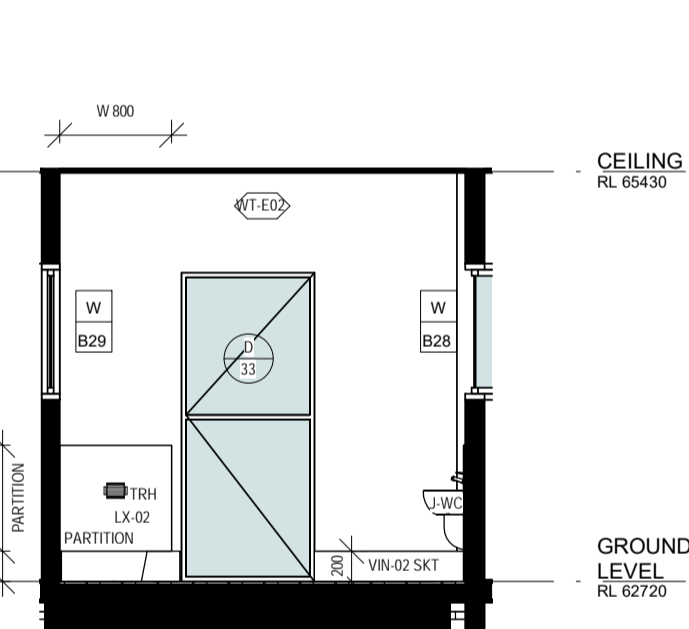


AMENITY PK ELEV. 16
1:50 REFER 16 - CD.504

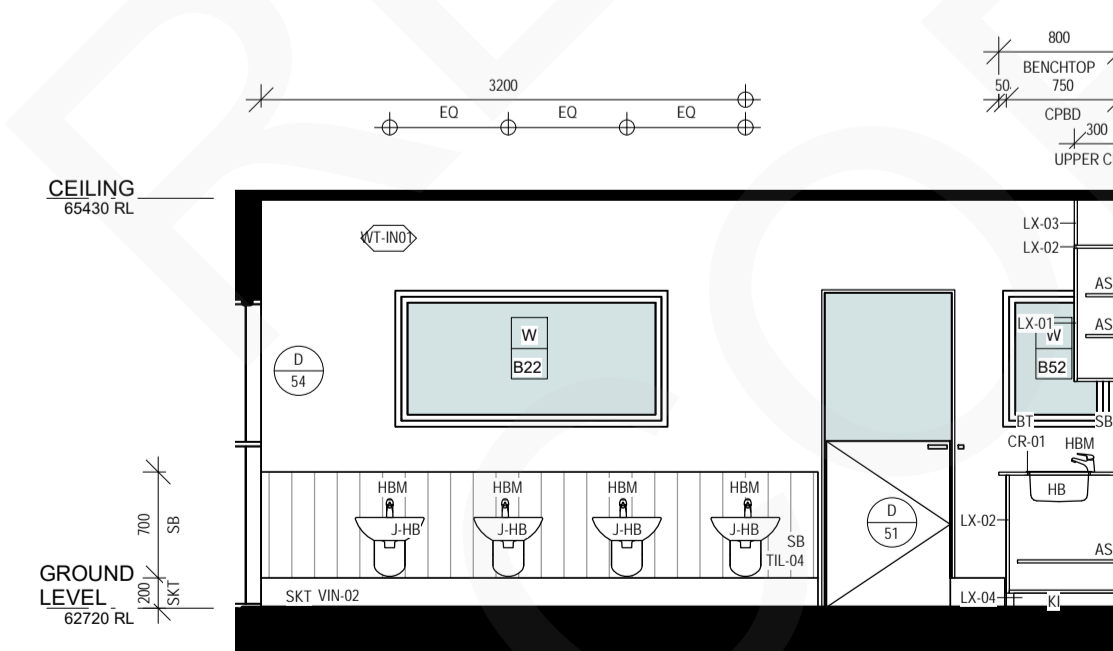


AMENITY T1/2 ELEV. 17
1:50 REFER 17 - CD.504

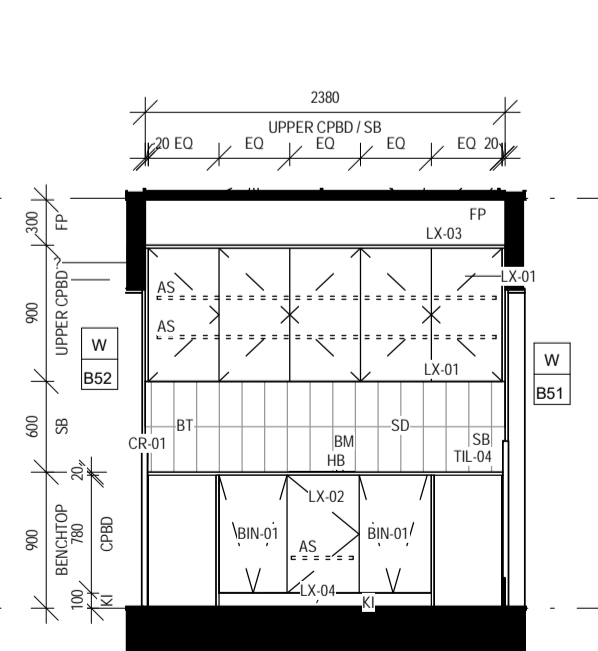

AMENITY T1/2 ELEV. 18
1:50 REFER 18 - CD.504

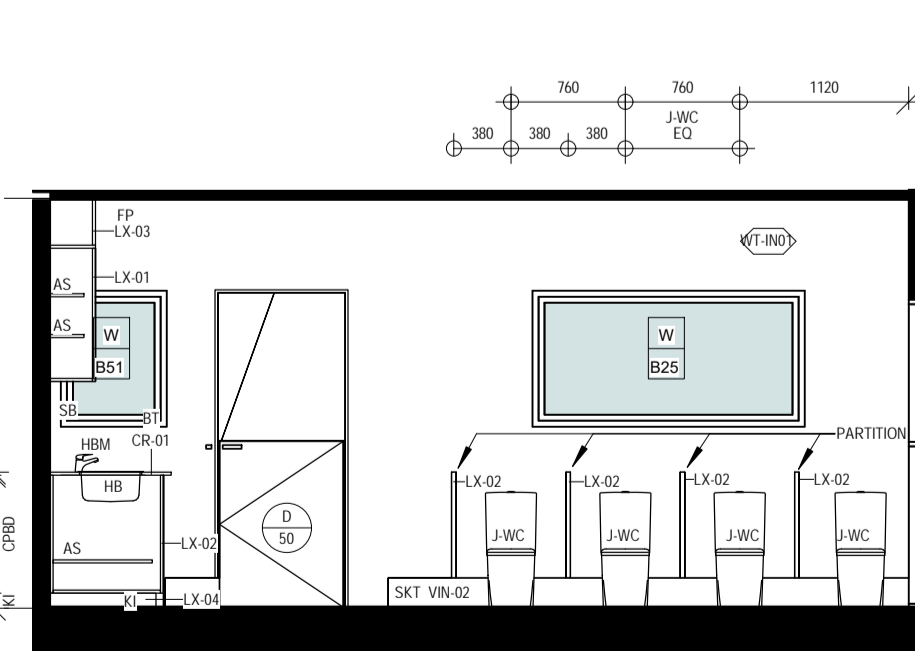

AMENITY T1/2 ELEV. 19
1:50 REFER 19 - CD.504

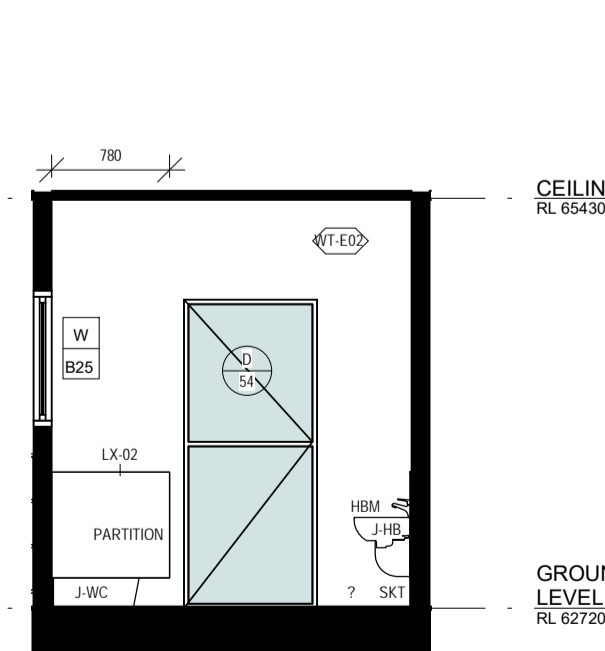

AMENITY T1/2 ELEV. 20
1:50 REFER 20 - CD.504

LEGEND:

- AS ADJUSTABLE SHELF
- B BASIN
- BB BABY BATH
- BR BACK REST
- BT BENCHTOP
- COH COAT HOOK
- CS CLEANER'S SINK
- CSM CLEANER'S SINK MIXER
- CT COOK TOP
- D DRYER
- DRWS DRAWERS
- DW DISHWASHER
- DWC DISABLED WATER CLOSET
- DSK DOUBLE BOWL & DRAIN SINK
- F REFRIGERATOR
- FB FRUIT WASH BASIN
- FP FIXED PANEL
- FS FOLDING SEAT
- FT FILTER TAP
- FWG FLOOR WASTE
- HB HAND BASIN
- HD HAND BASIN MIXER
- HDM HAND DRYER
- GPO DOUBLE GENERAL POWER OUTLET
- GR GRAB RAIL
- JB JUNIOR BASIN
- JWC JUNIOR TOILET
- KI KICK
- LO LOCK
- LS LOCKER SYSTEM
- LT LAUNDRY TUB
- LTM LAUNDRY TUB MIXER
- M MIRROR
- MW MICROWAVE
- OS OPEN SHELF
- AOS ADJUSTIVE OPEN SHELF
- OV OVEN
- PTD PAPER TOWEL DISPENSER
- RH RANGE HOOD
- SB SPLASHBACK
- SC SHOWER CURTAIN
- SD SOAP DISPENSER
- SH SHELF
- SHR SHOWER
- SK SINK
- SKD SINK - DOUBLE BOWL
- SKM SINK MIXER
- SKT-01 SKIRTING - GENERAL
- SKT-02 SKIRTING - VINYL COVE
- SM SHOWER MIXER
- S.S. STAINLESS STEEL
- T TRAYS
- TRH TOILET ROLL HOLDER
- TR TOWEL RAIL
- TS TILED SPLASHBACK
- UF UNDER BENCH REFRIGERATOR
- WM WASHING MACHINE
- WT WALL TAP

ELECTRICAL LEGEND


- AB-GPO ABOVE BENCH GPO
- UB-GPO UNDER BENCH GPO
- ALL OTHER EXPOSED GPOS TO BE CHILD SAFE
- AND MIN 1500mm HIGH IN PLAYROOMS AND CHILDRENS AMENITIES
- **REFER TO ELECTRICAL ENGINEERS DRAWINGS FOR DETAIL

REFER TO ARCHITECTURAL SCHEDULE OF FINISHES FOR MATERIAL AND COLOUR


NOTES:

- ALL JOINERY DIMENSIONED FROM FINISHED FACE OF WALL
- ALL PLUMBING DIMENSIONED FROM WALL STRUCTURE
- LAMINATE SYSTEM FOR TOILET PARTITIONS
- ALL OPEN SHELVES ON THIS SHEET SHOULD HAVE BACKING AS SAME AS THE SHELVING


- LX-01 LAMINEX, PERUVIAN CLAY
- LX-02 LAMINEX, EARTH
- LX-03 LAMINEX, NATURAL WHITE
- LX-04 LAMINEX, FOSSIL

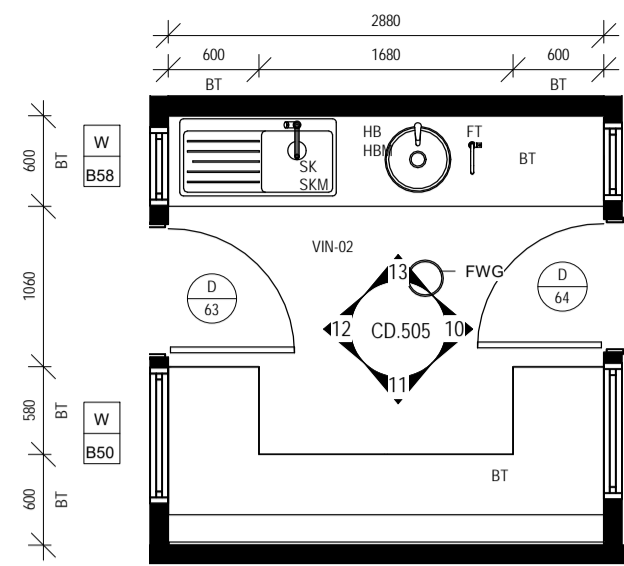


BOTTLE PREP N1/2 - PLAN
1:50 REFER 2 - CD.200

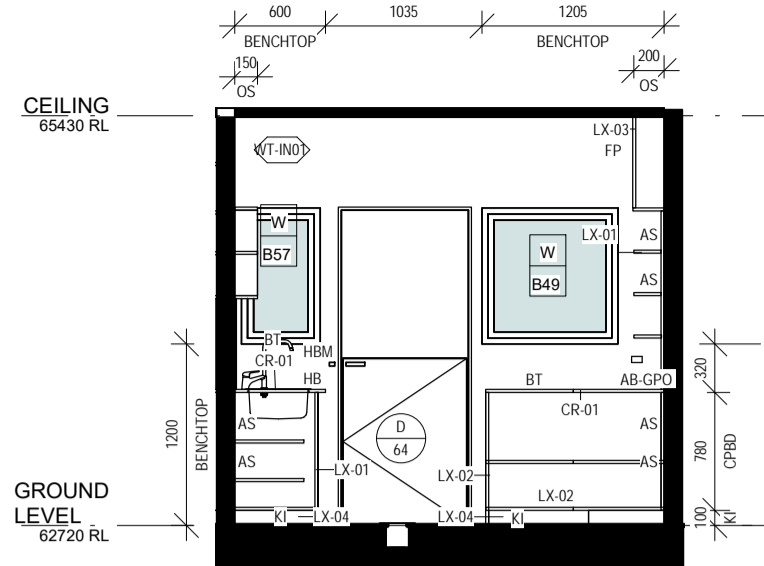


BOTTLE PREP N1/2 ELEV. 10
1:50 REFER 10 - CD.504

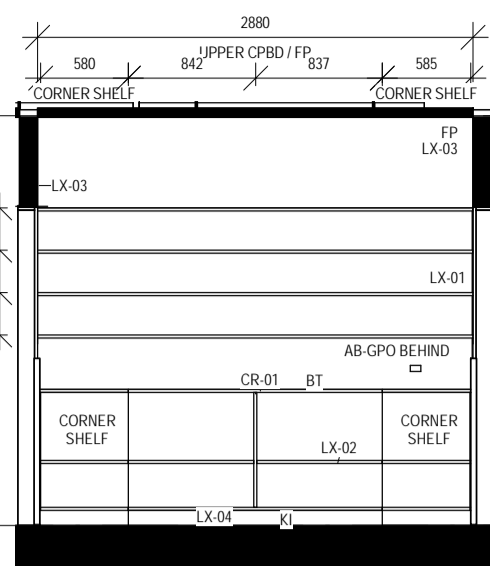


BOTTLE PREP N1/2 ELEV. 11
1:50 REFER 11 - CD.505

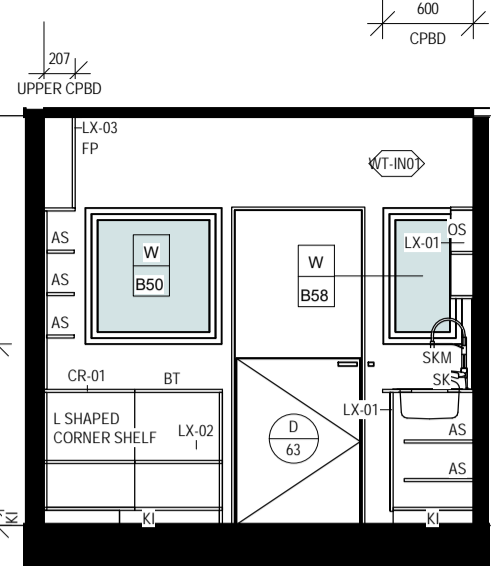


BOTTLE PREP N1/2 ELEV. 12
1:50 REFER 12 - CD.504

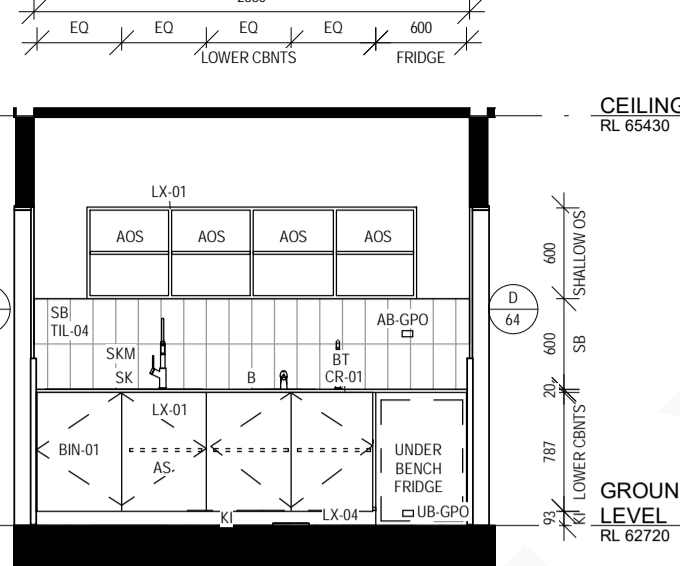


BOTTLE PREP N1/2 ELEV. 13
1:50 REFER 13 - CD.505

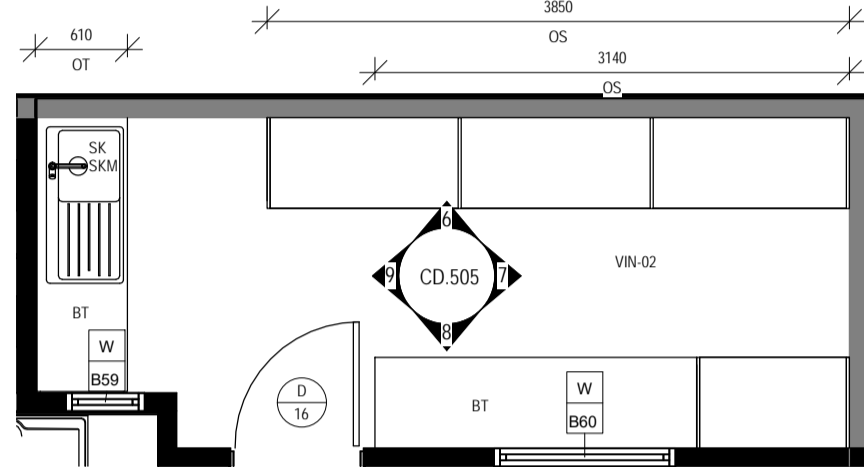


CRAFT STORE K1 - PLAN
1:50 REFER 3 - CD.200

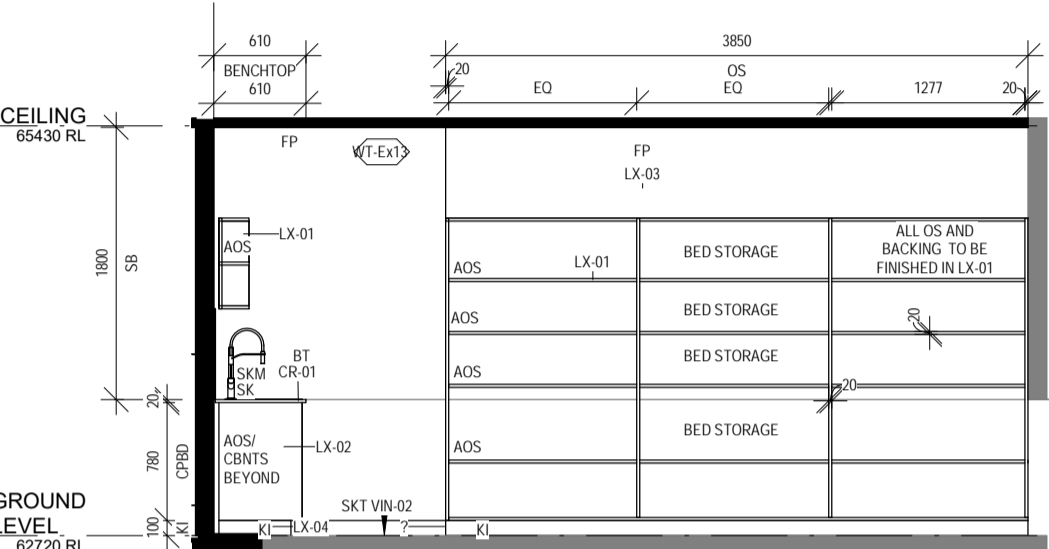


CRAFT STORE K1 ELEV. 6
1:50 REFER 6 - CD.505

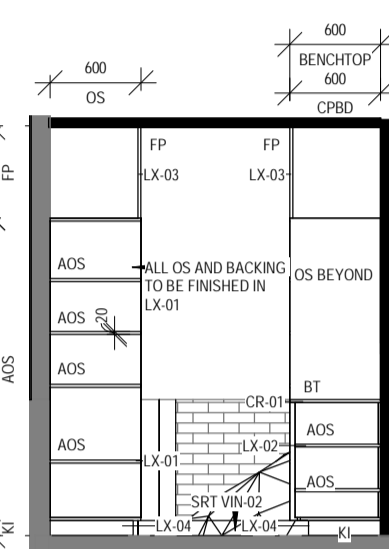


CRAFT STORE K1 ELEV. 7
1:50 REFER 7 - CD.505

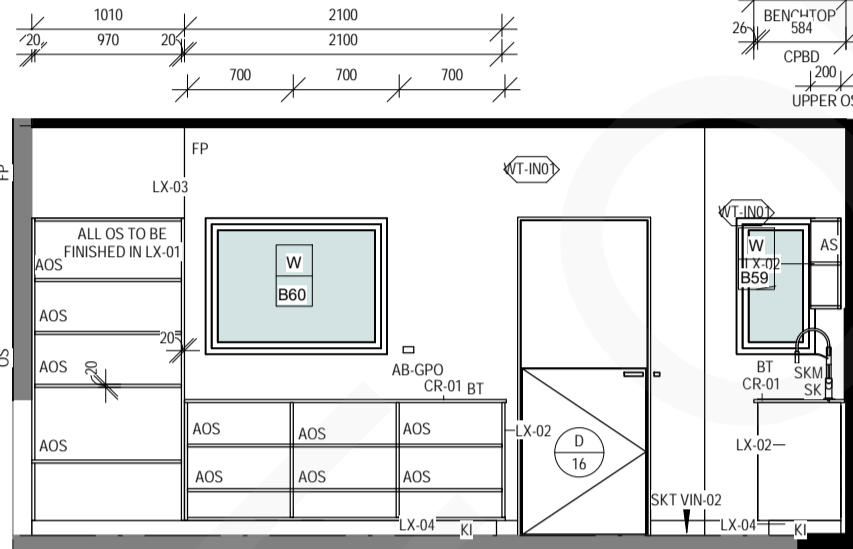


CRAFT STORE K1 ELEV. 8
1:50 REFER 8 - CD.505

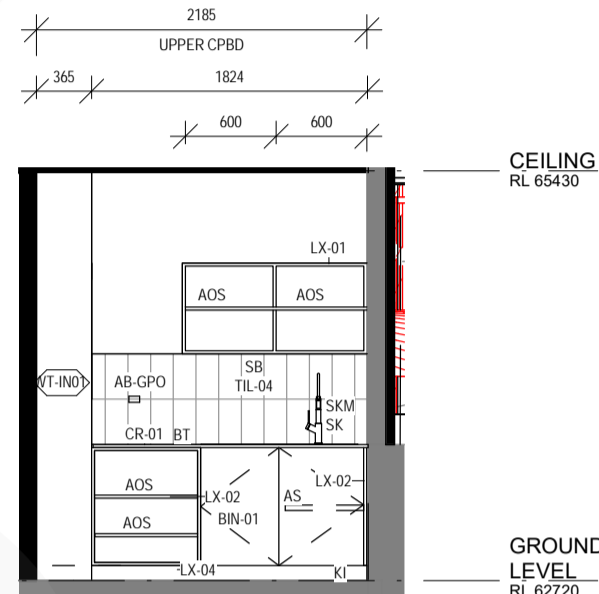


CRAFT STORE K1 ELEV. 9
1:50 REFER 9 - CD.505

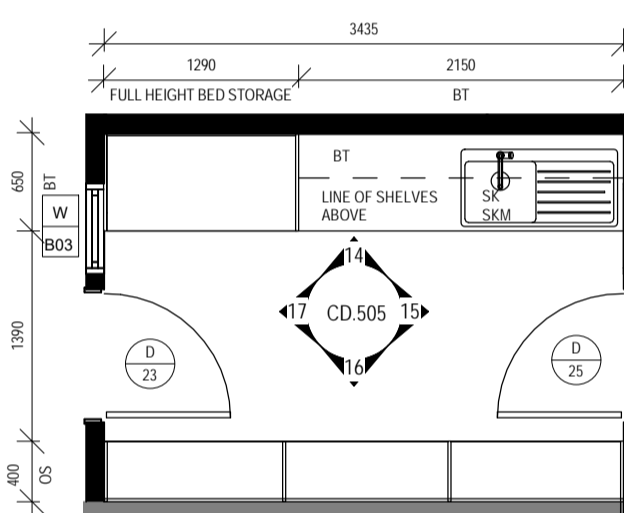


CRAFT STORE K2 - PLAN
1:50 REFER 4 - CD.200

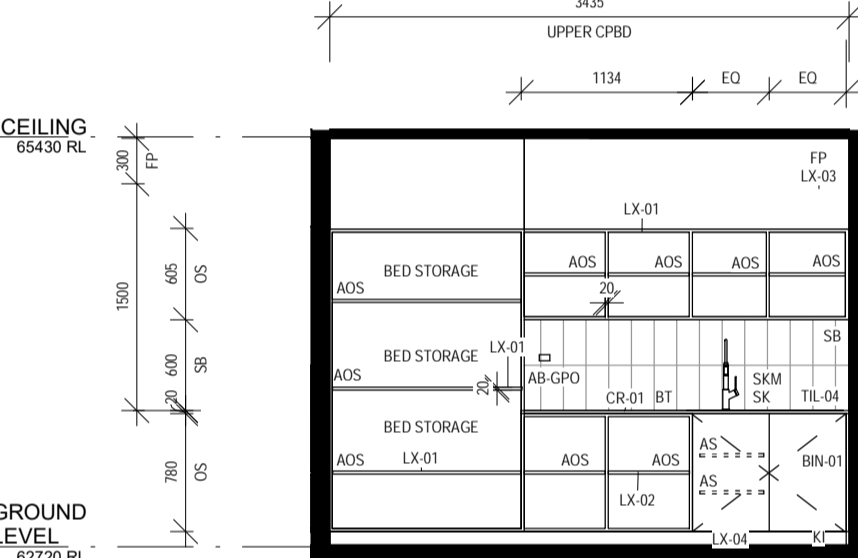


CRAFT STORE K2 ELEV. 14
1:50 REFER 14 - CD.505

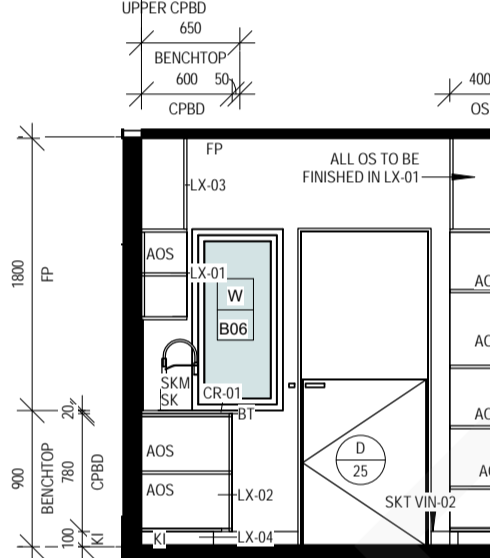


CRAFT STORE K2 ELEV. 15
1:50 REFER 15 - CD.504

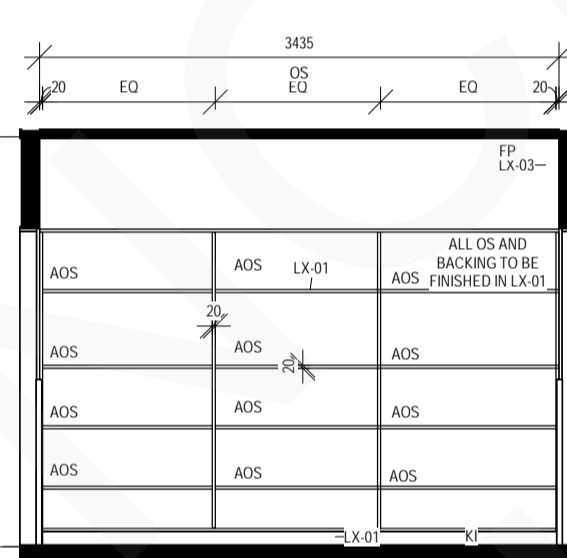


CRAFT STORE K2 ELEV. 16
1:50 REFER 16 - CD.505

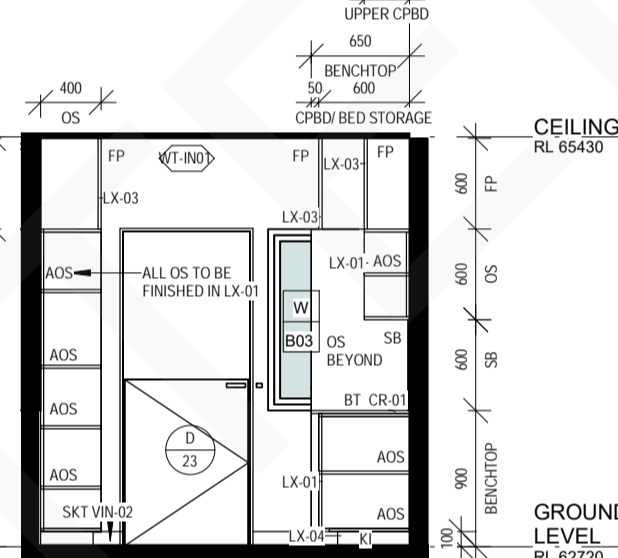


CRAFT STORE K2 ELEV. 17
1:50 REFER 17 - CD.504

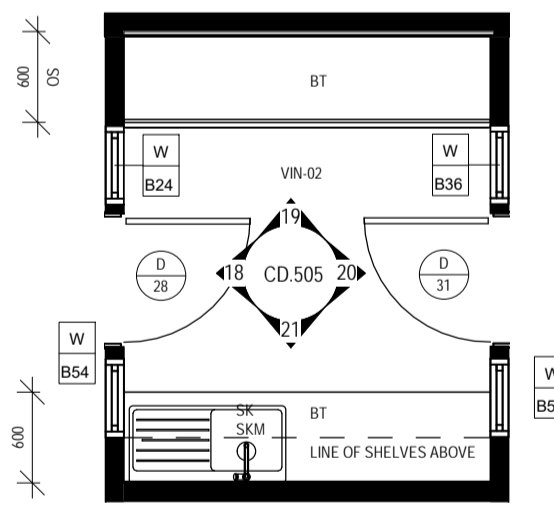


CRAFT STORE PK - PLAN
1:50 REFER 5 - CD.200

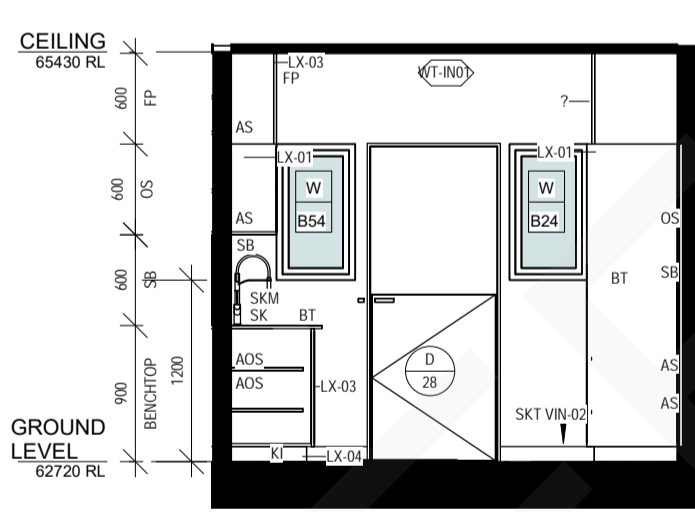


CRAFT STORE PK ELEV. 18
1:50 REFER 18 - CD.504

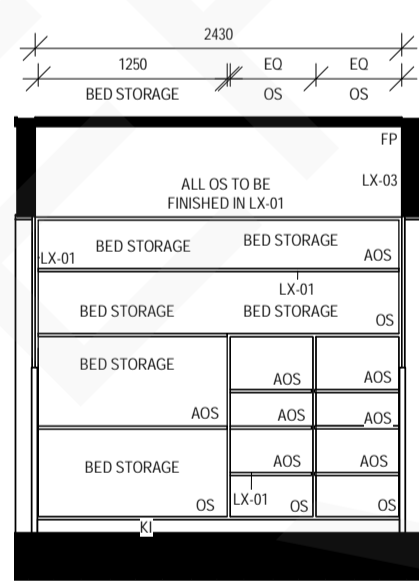


CRAFT STORE PK ELEV. 20
1:50 REFER 20 - CD.504

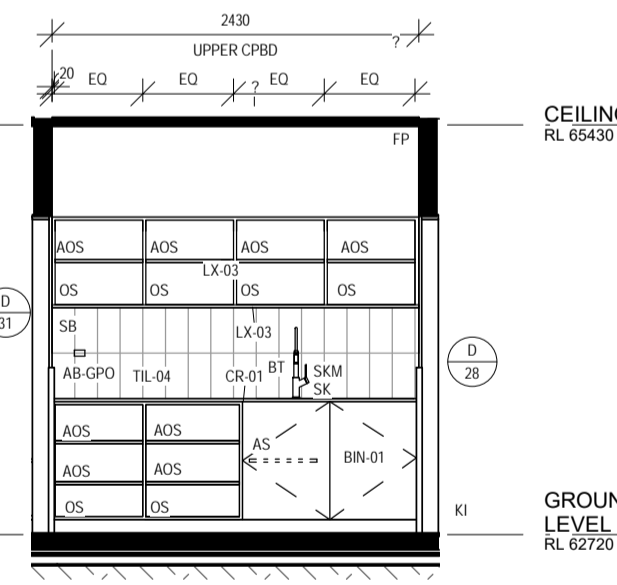


CRAFT STORE PK ELEV. 21
1:50 REFER 21 - CD.505

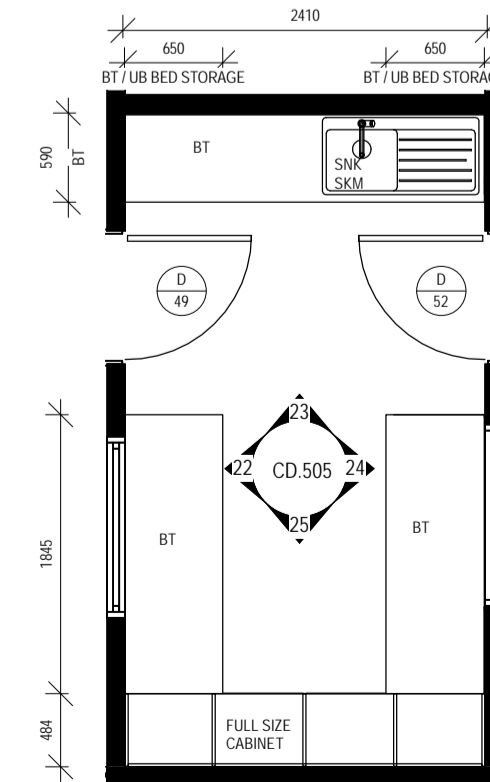


CRAFT STORE T1/2 - PLAN
1:50 REFER 1 - CD.200

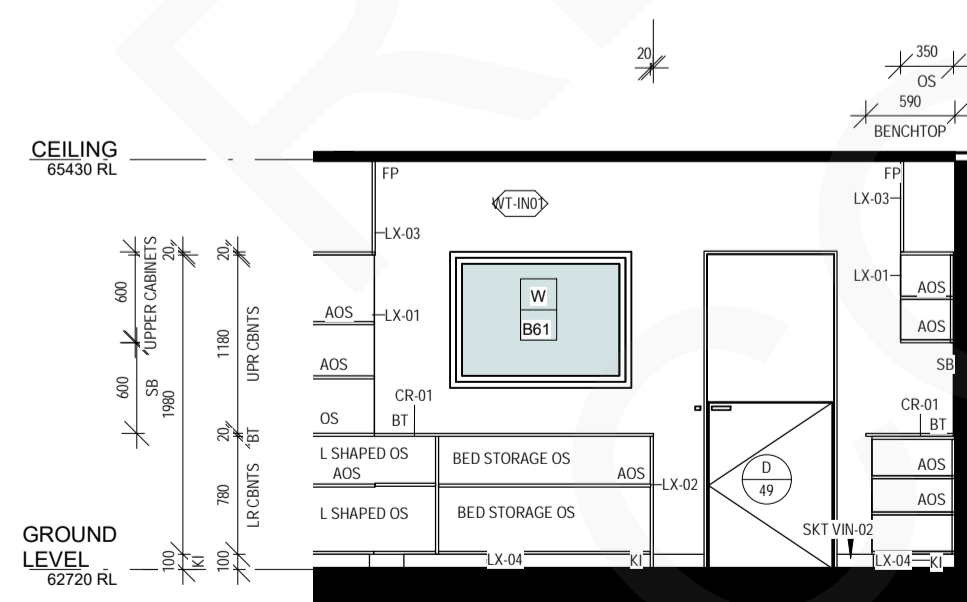


CRAFT STORE ELEVATION 22
1:50 REFER 22 - CD.504

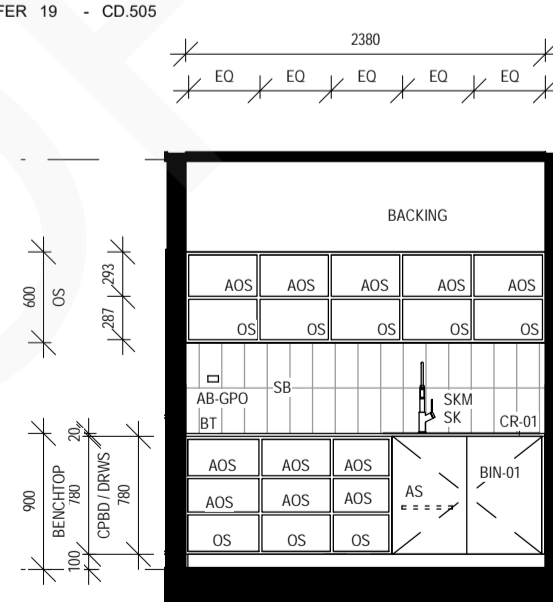

CRAFT STORE ELEVATION 23
1:50 REFER 23 - CD.505

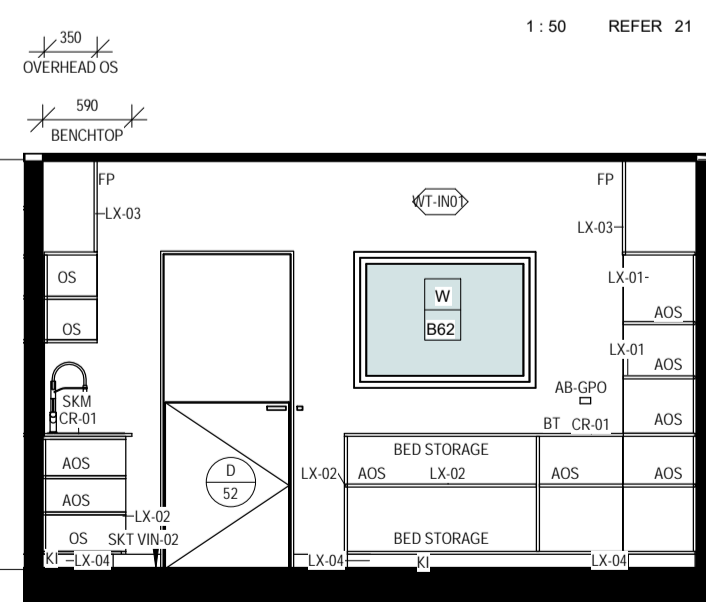

CRAFT STORE ELEVATION 24
1:50 REFER 24 - CD.504

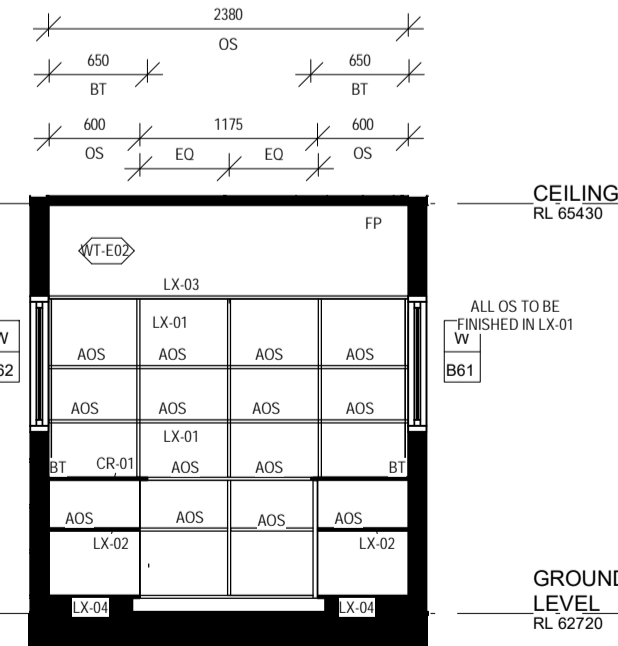

CRAFT STORE ELEVATION 25
1:50 REFER 25 - CD.505

LEGEND:

- AS ADJUSTABLE SHELF
B BASIN
BB BABY BATH
BR BACK REST
BT BENCHTOP
COH COAT HOOK
CS CLEANER'S SINK
CSM CLEANER'S SINK MIXER
CT COOK TOP
D DRYER
DRWS DRAWERS
DW DISHWASHER
DWC DISABLED WATER CLOSET
DSK DOUBLE BOWL & DRAIN SINK
F REFRIGERATOR
FB FRUIT WASH BASIN
FP FIXED PANEL
FS FOLDING SEAT
FT FILTER TAP
FWG FLOOR WASTE
HB HAND BASIN
HD HAND BASIN MIXER
HDM HAND DRYER
GPO DOUBLE GENERAL POWER OUTLET
GR GRAB RAIL
JB JUNIOR BASIN
JWC JUNIOR TOILET
K KICK
L LOCK
LO LOCKER SYSTEM
LT LAUNDRY TUB
LTM LAUNDRY TUB MIXER
M MIRROR
MW MICROWAVE
OS OPEN SHELF
AOS ADJUSTIVE OPEN SHELF
OV OVEN
PTD PAPER TOWEL DISPENSER
RH RANGE HOOD
SB SPLASHBACK
SG SHOWER CURTAIN
SD SOAP DISPENSER
SH SHELF
SHR SHOWER
SK SINK
SKD SINK - DOUBLE BOWL
SKM SINK MIXER
SKT-01 SKIRTING - GENERAL
SKT-02 SKIRTING - VINYL COVE
SM SHOWER MIXER
S.S. STAINLESS STEEL
T TRAYS
TRH TOILET ROLL HOLDER
TR TOWEL RAIL
TS TILED SPLASHBACK
UF UNDER BENCH REFRIGERATOR
WM WASHING MACHINE
WT WALL TAP

ELECTRICAL LEGEND

- AB-GPO ABOVE BENCH GPO
UB-GPO UNDER BENCH GPO
ALL OTHER EXPOSED GPOS TO BE CHILD SAFE
AND MIN 1500mm HIGH IN PLAYROOMS AND
CHILDRENS AMENITIES


*REFER TO ELECTRICAL ENGINEERS
DRAWINGS FOR DETAIL

REFER TO ARCHITECTURAL SCHEDULE OF FINISHES
FOR MATERIAL AND COLOUR


NOTES:

- ALL JOINERY DIMENSIONED FROM FINISHED FACE OF WALL.
- ALL PLUMBING DIMENSIONED FROM WALL STRUCTURE.
- LAMINATE SYSTEM FOR TOILET PARTITIONS
- ALL OPEN SHELVES ON THIS SHEET SHOULD HAVE BACKING AS SAME AS THE SHELVING


- LX-01 LAMINEX, PERUVIAN CLAY
LX-02 LAMINEX, EARTH
LX-03 LAMINEX, NATURAL WHITE
LX-04 LAMINEX, FOSSIL

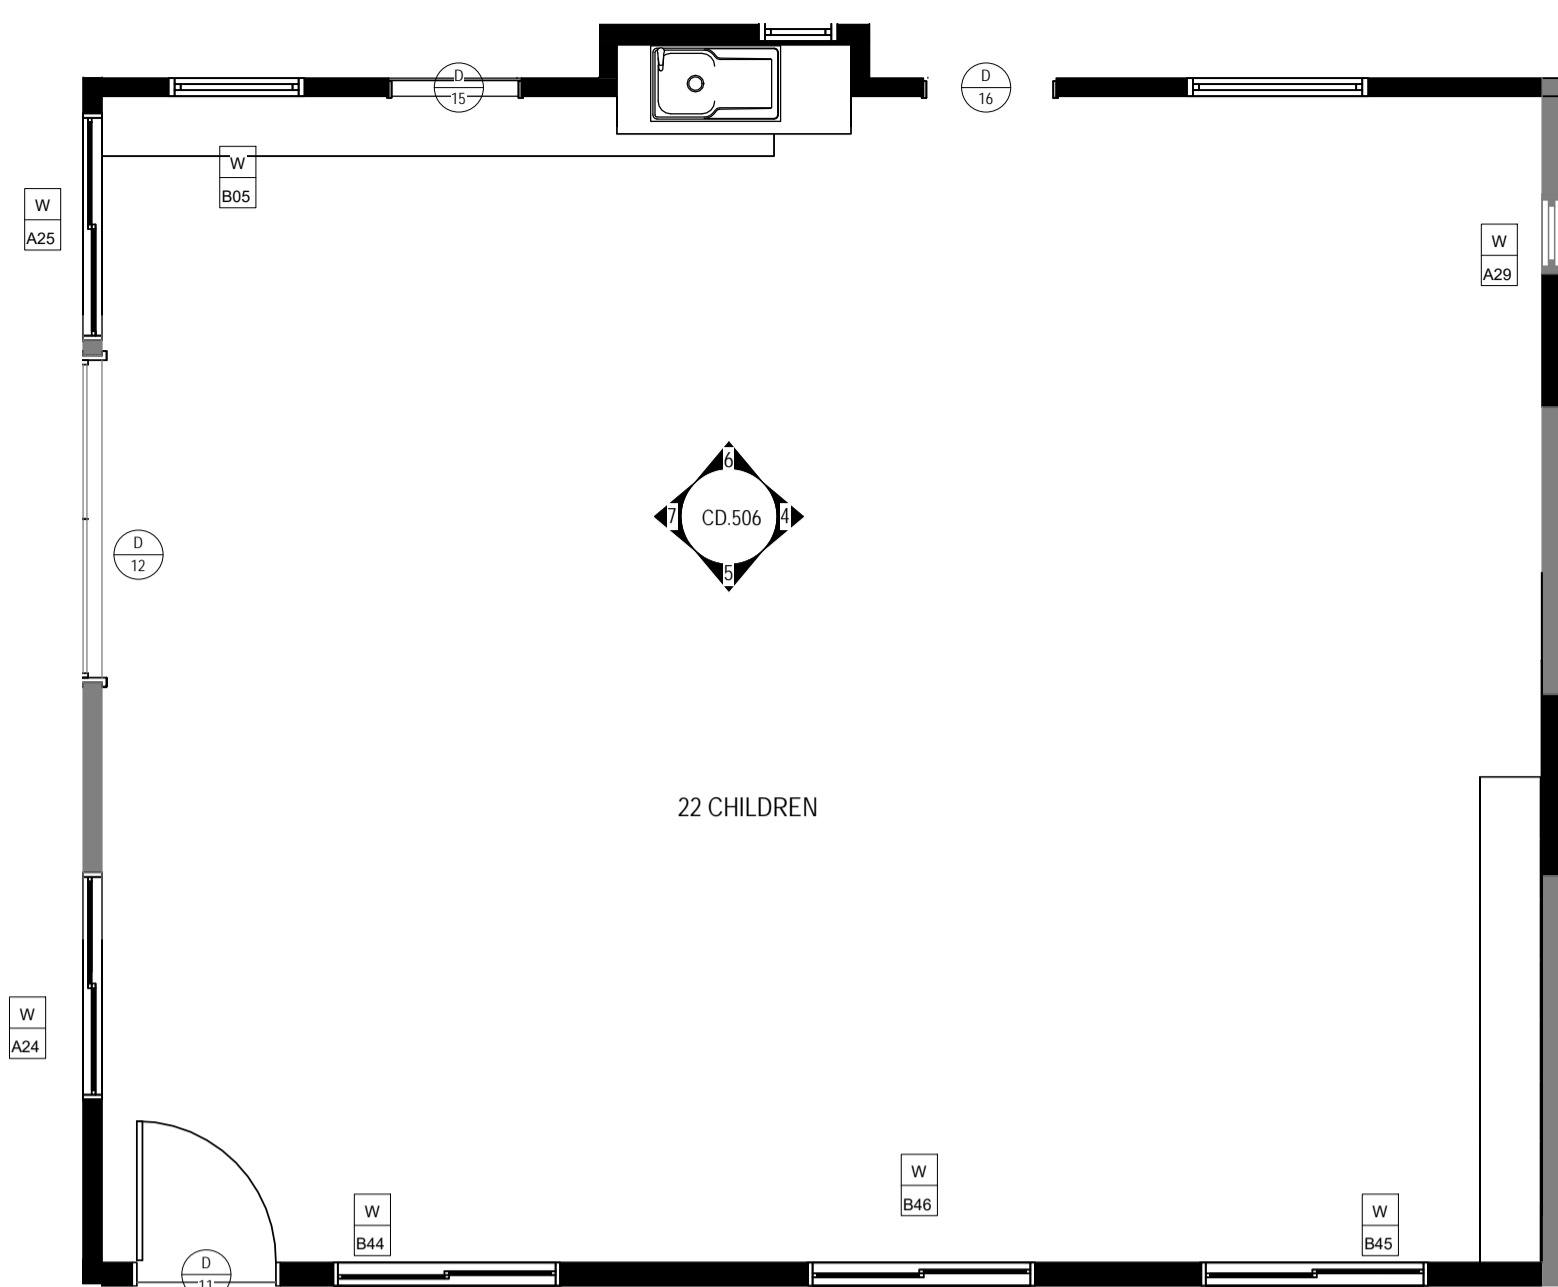


KINDY 1 (K1) - PLAN
1:50 REFER 1 - CD 200

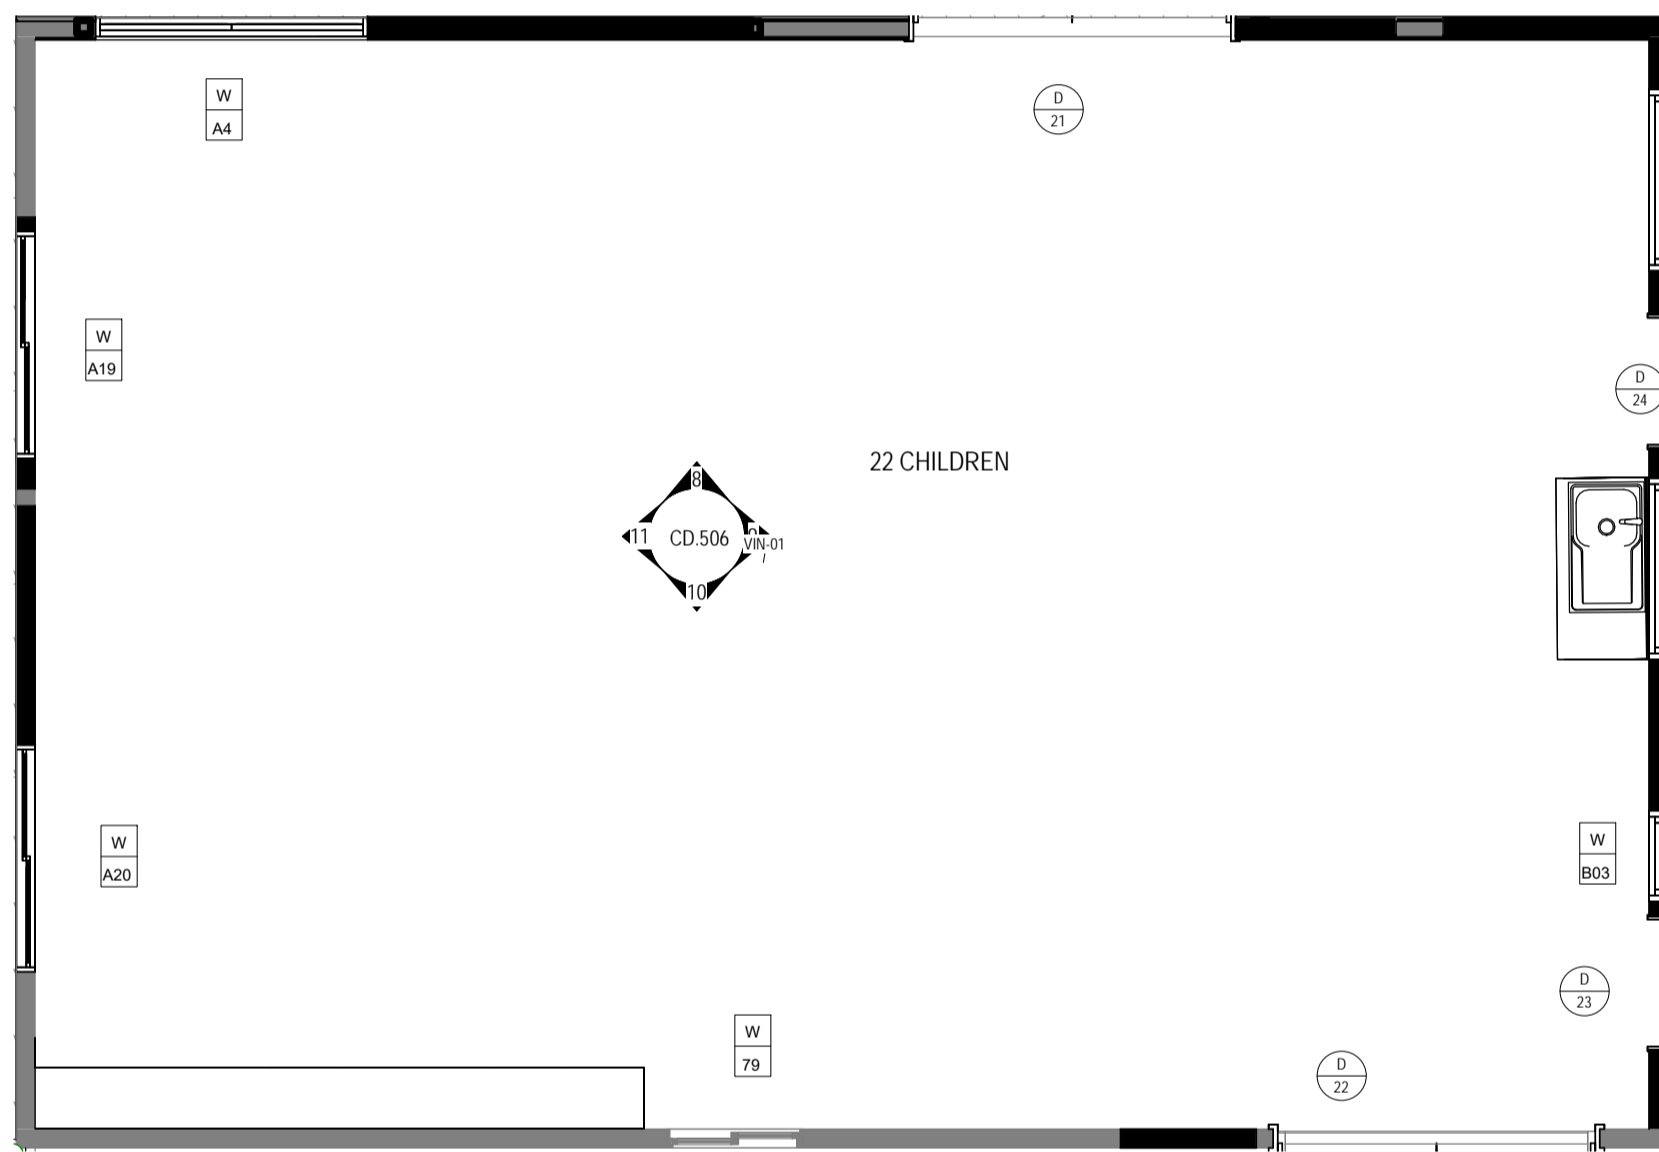


KINDY 2 (K2) - PLAN
1:50 REFER 2 - CD 200

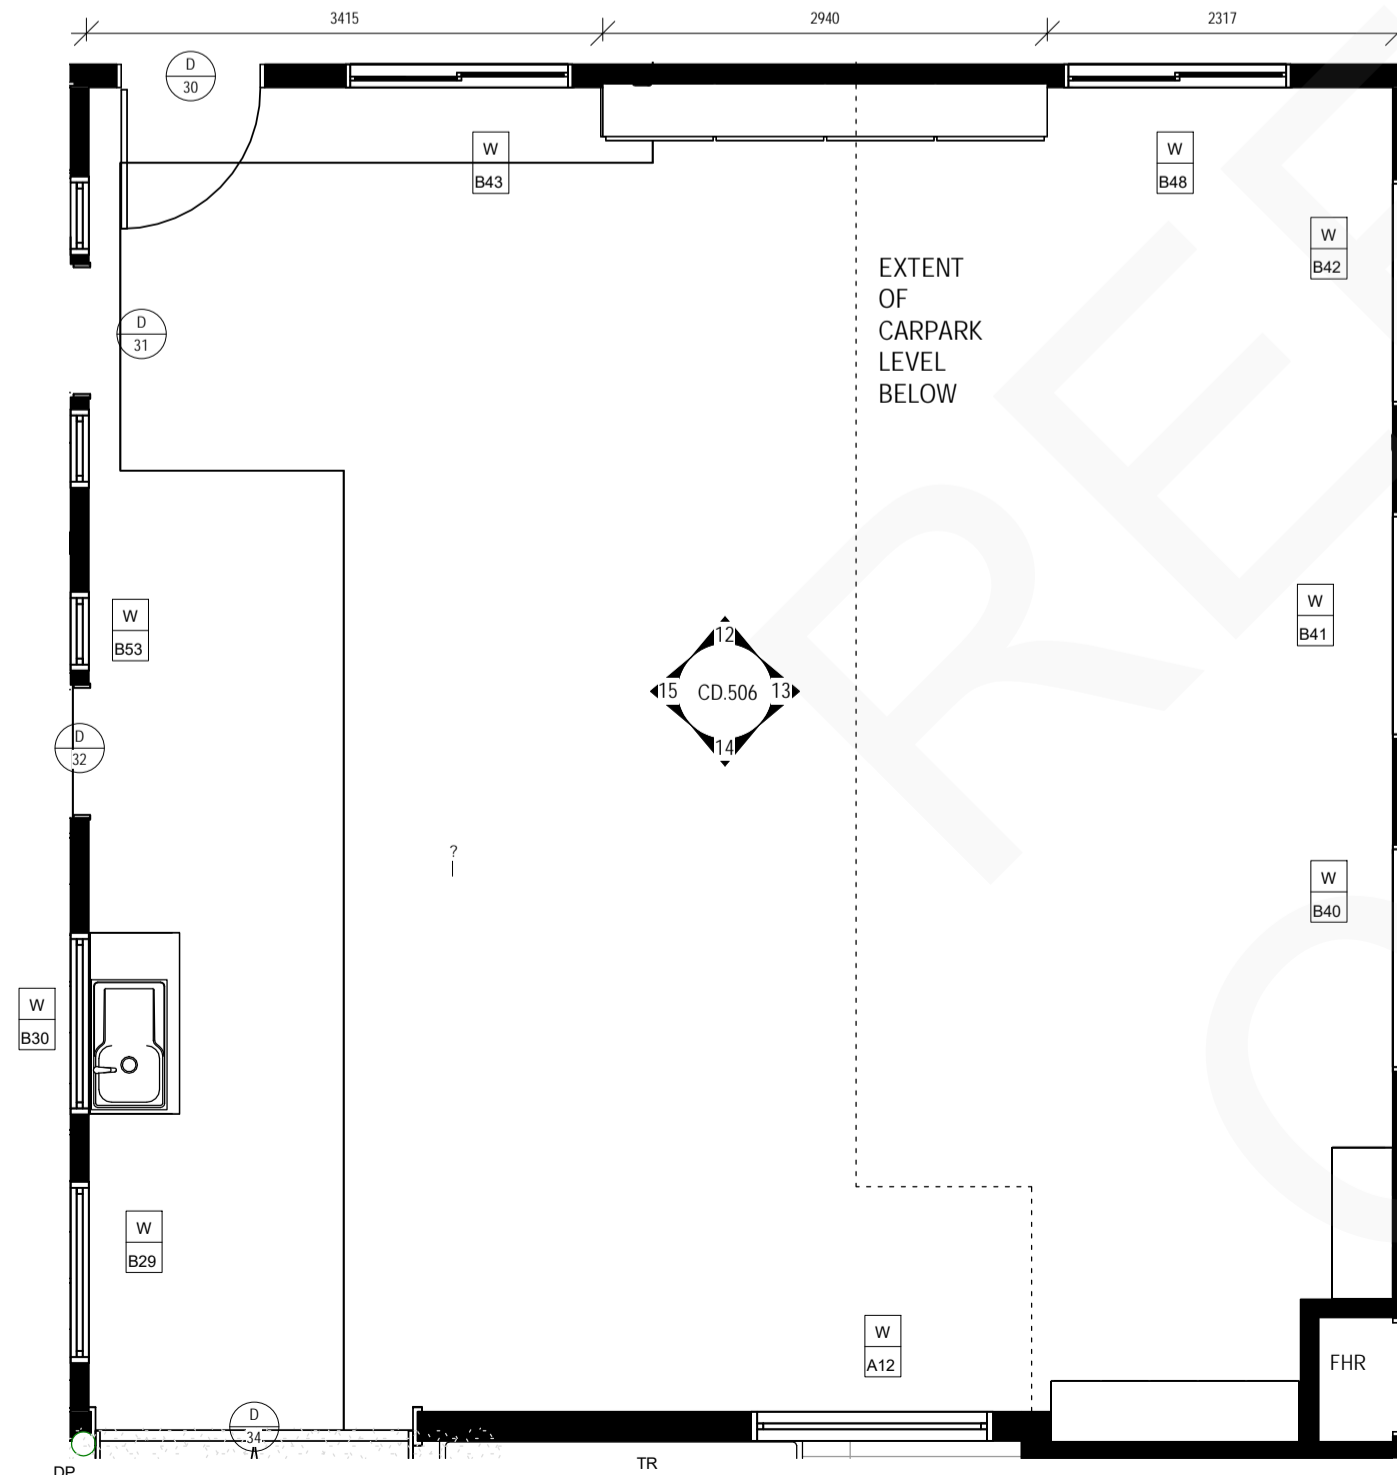


PRE-KINDY 2 (PK)- PLAN
1:50 REFER 3 - CD 200

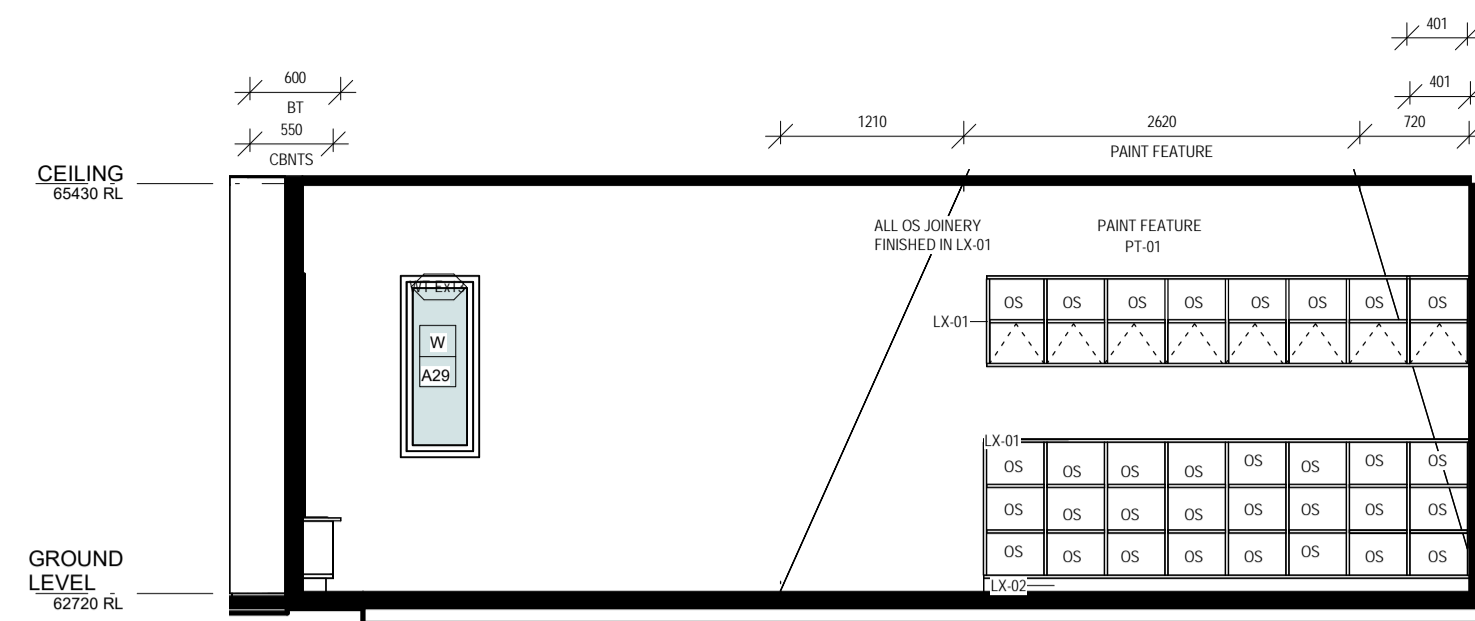


KINDY 1 ELEV. 4
1:50 REFER 4 - CD 506

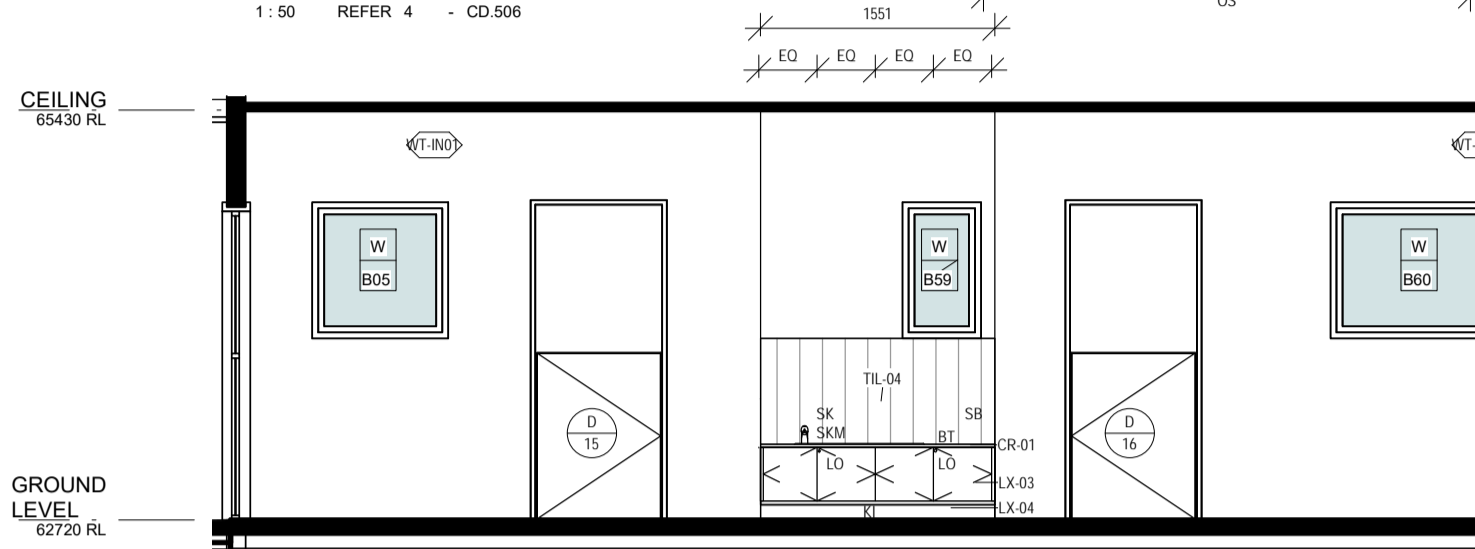

KINDY 1 ELEV. 6
1:50 REFER 6 - CD 405

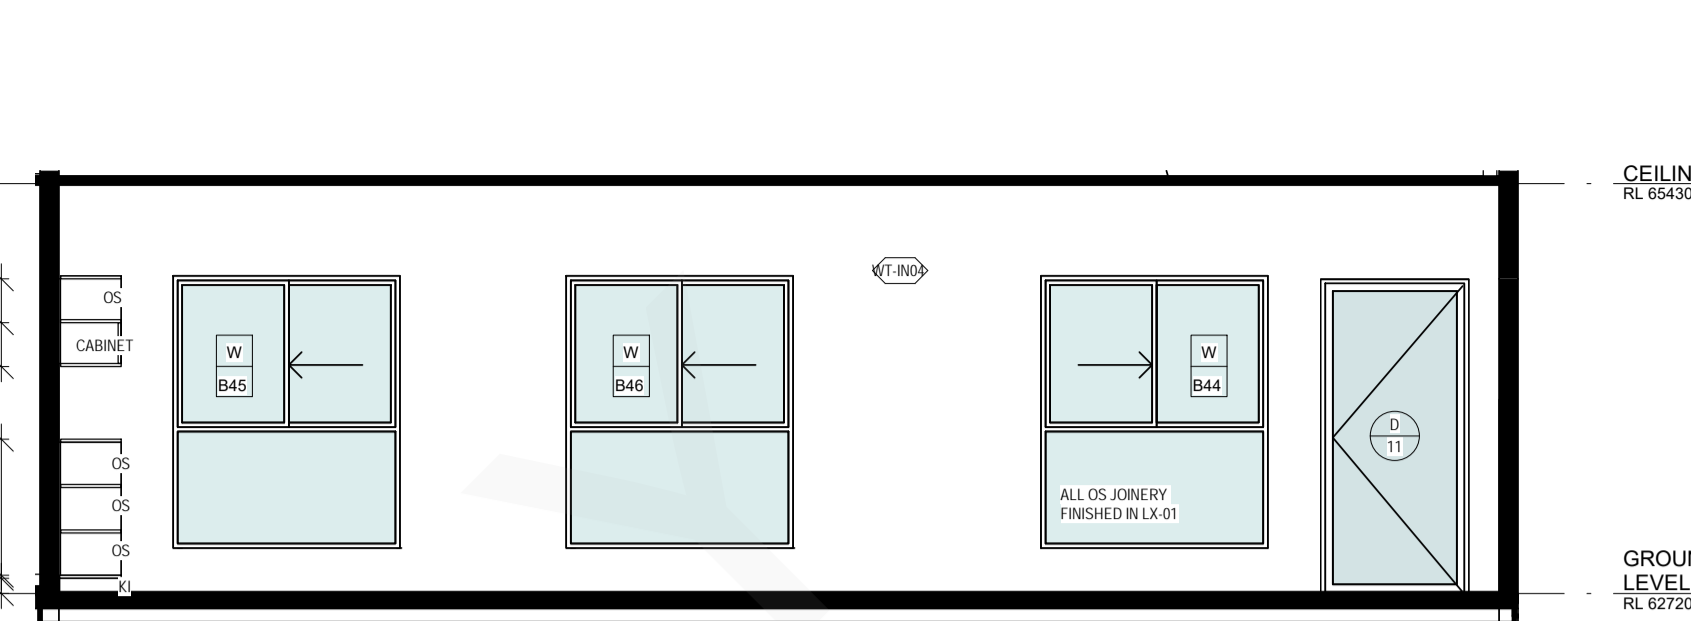


KINDY 1 ELEV. 5
1:50 REFER 5 - CD 506

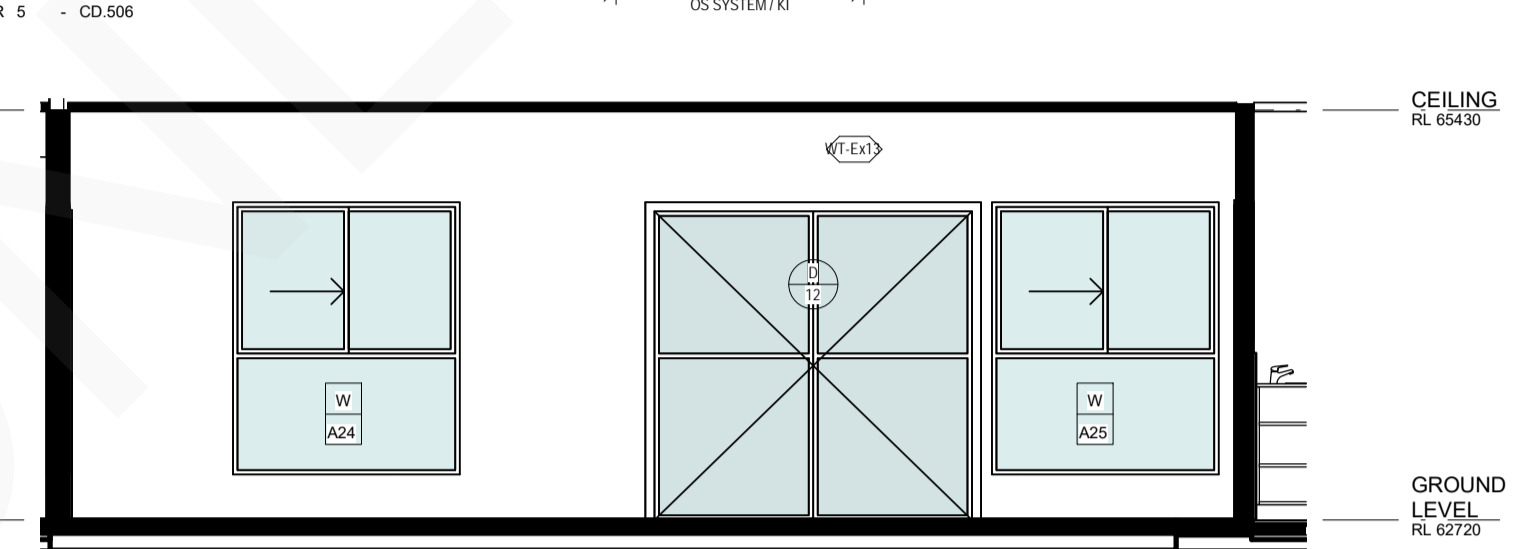


KINDY 1 ELEV. 7
1:50 REFER 7 - CD 506




KINDY 2 ELEV. 8
1:50 REFER 8 - CD 504

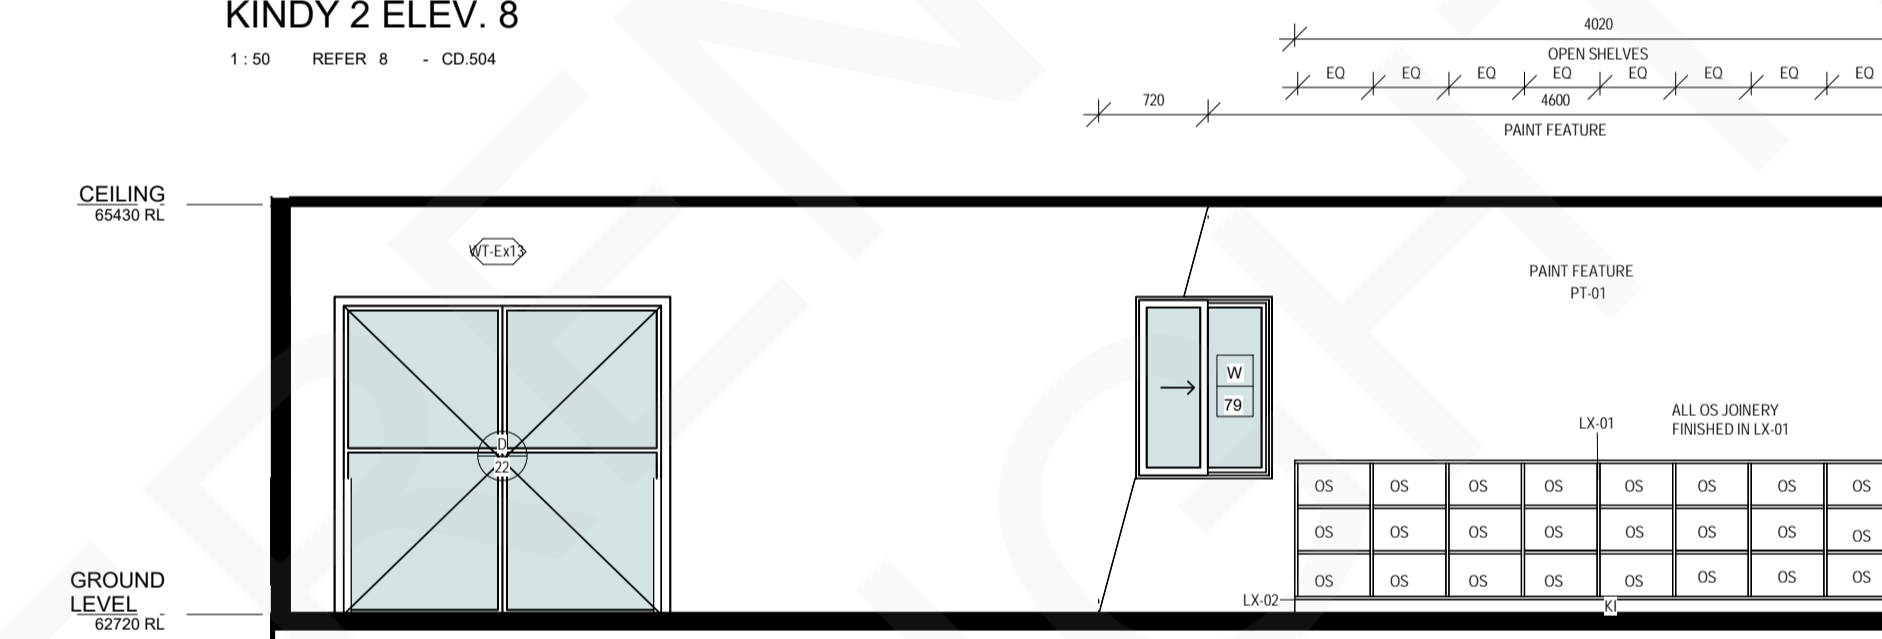


KINDY 2 ELEV. 10
1:50 REFER 10 - CD 504

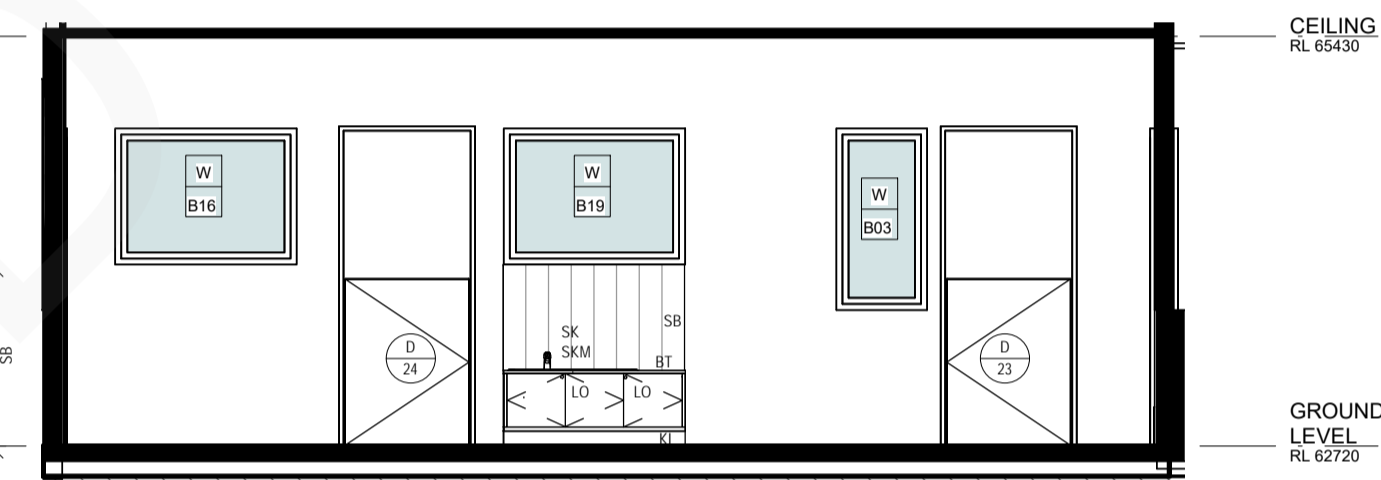


KINDY 2 ELEV. 9
1:50 REFER 9 - CD 506

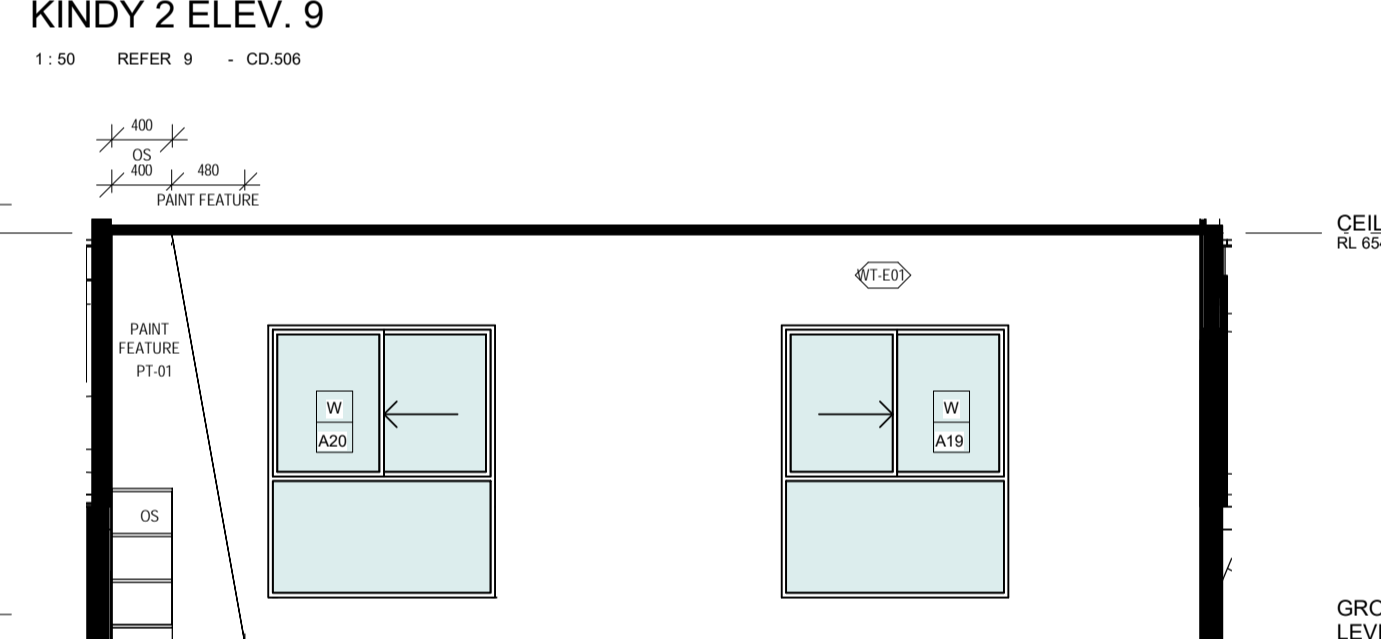


KINDY 2 ELEV. 11
1:50 REFER 11 - CD 506

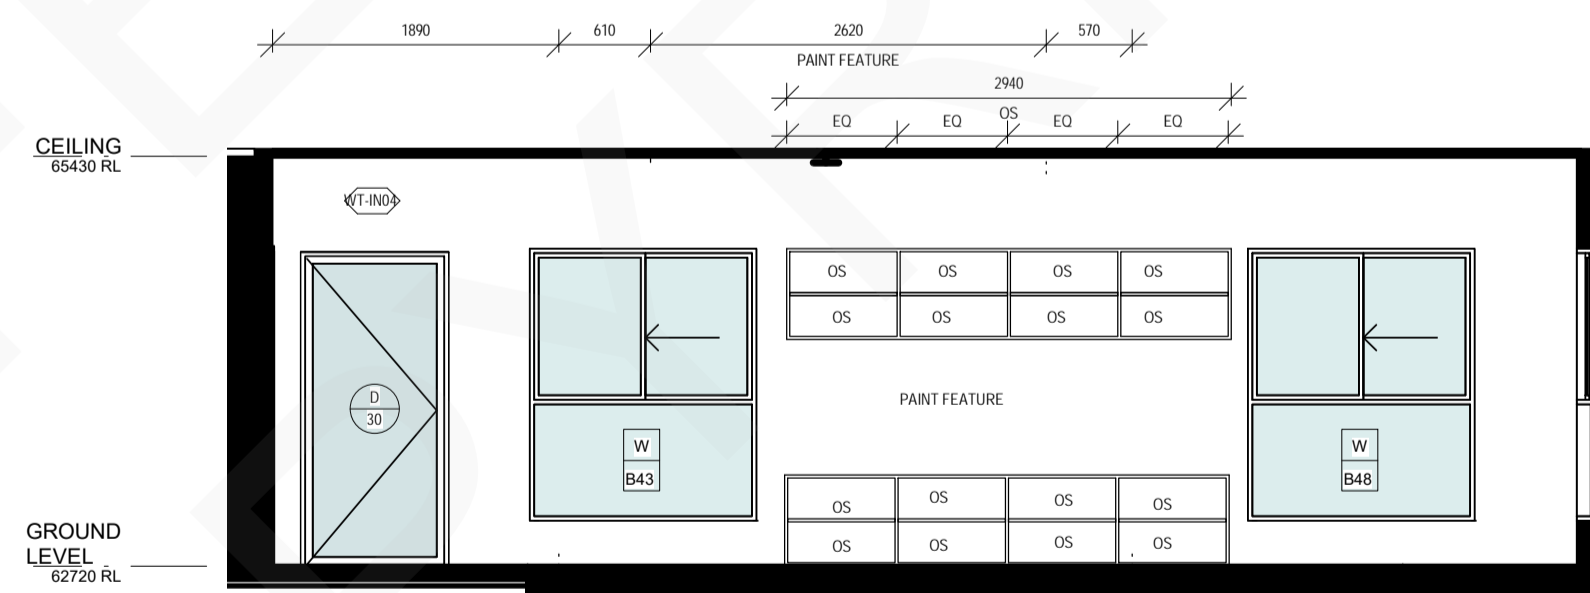


PRE-KINDY ELEV. 12
1:50 REFER 12 - CD 505

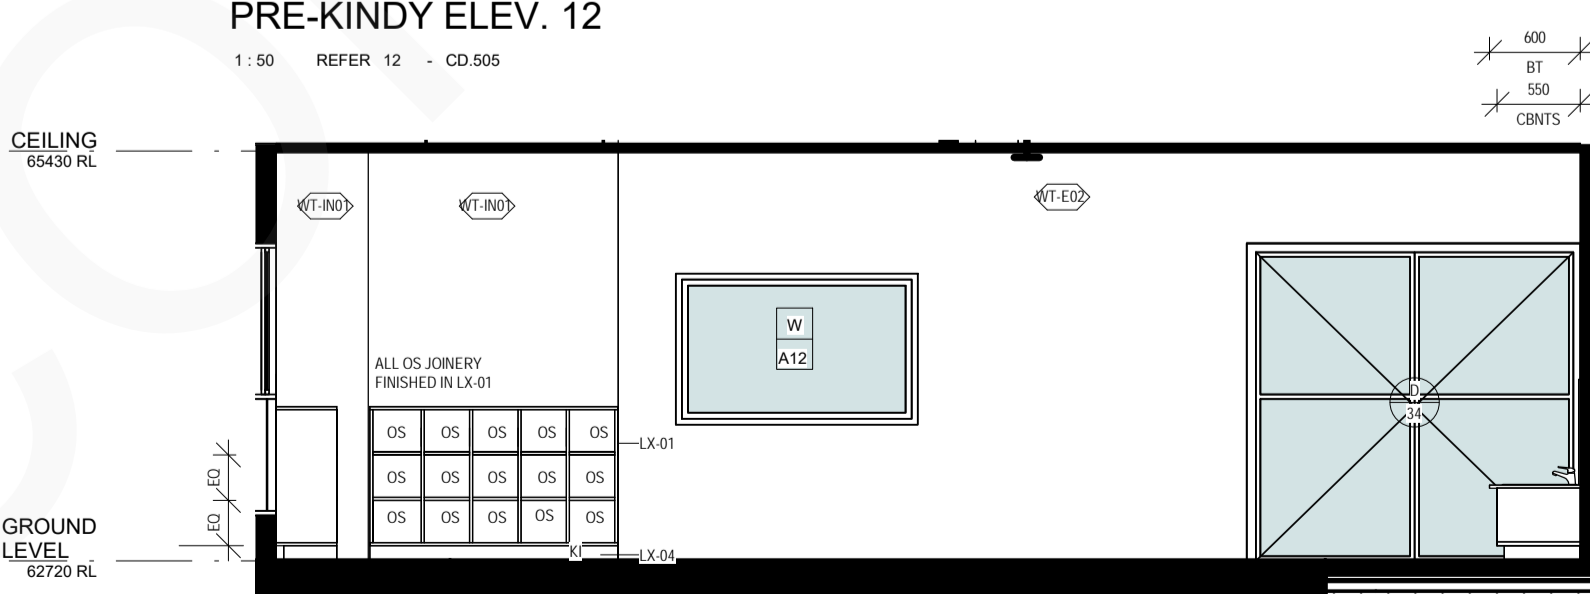

PRE-KINDY ELEV. 14
1:50 REFER 14 - CD 506

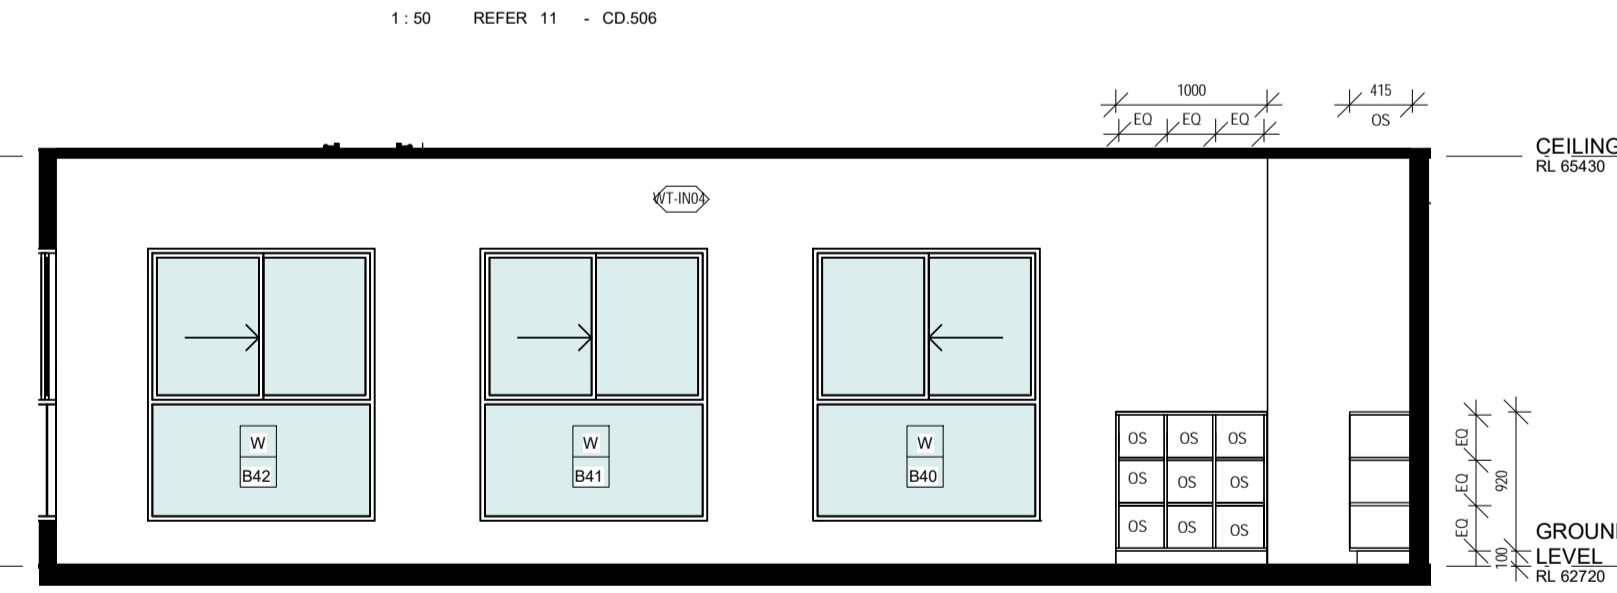

PRE-KINDY ELEV. 13
1:50 REFER 13 - CD 506

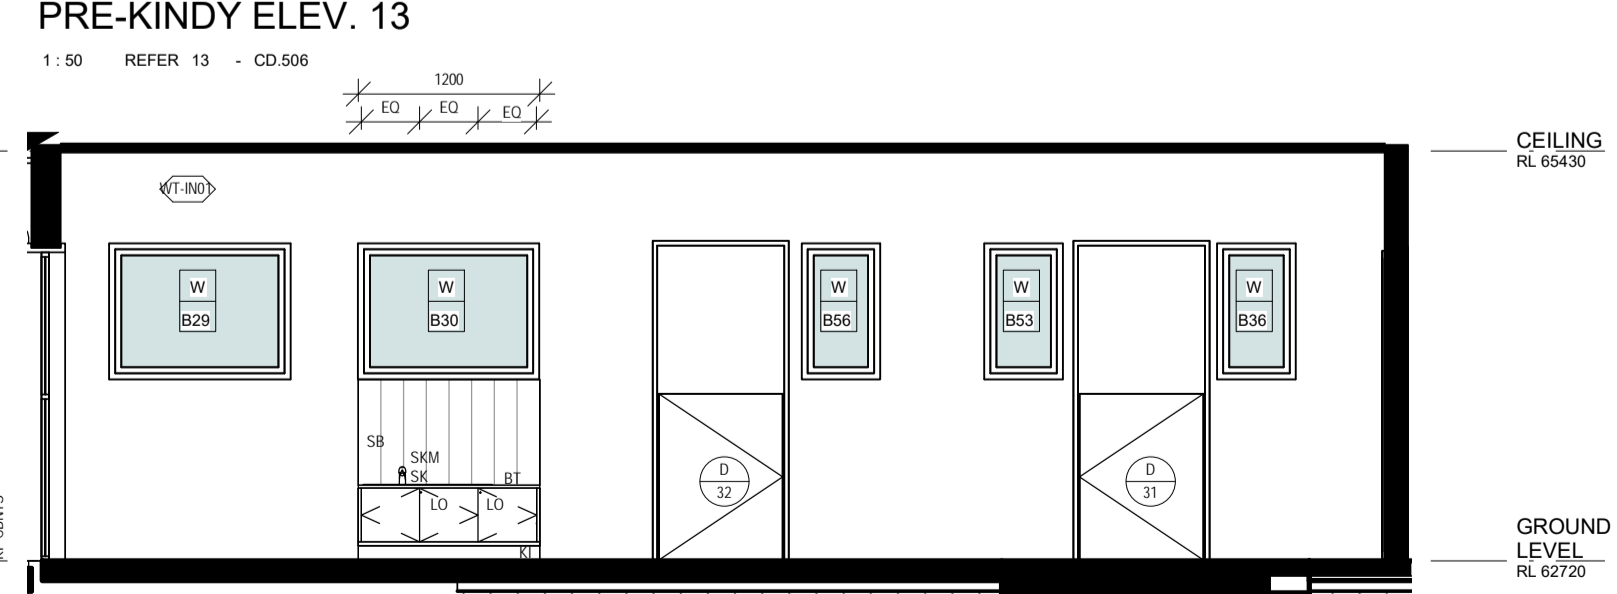

PRE-KINDY ELEV. 15
1:50 REFER 15 - CD 506

LEGEND:

- AS ADJUSTABLE SHELF
- B BASIN
- BB BABY BATH
- BR BACK REST
- BT BENCHTOP
- COH COAT HOOK
- CS CLEANER'S SINK
- CSM CLEANER'S SINK MIXER
- CT COOK TOP
- D DRYER
- DRWS DRAWERS
- DW DISHWASHER
- DWC DISABLED WATER CLOSET
- DSK DOUBLE BOWL & DRAIN SINK
- F REFRIGERATOR
- FB FRUIT WASH BASIN
- FP FIXED PANEL
- FS FOLDING SEAT
- FT FILTER TAP
- FWG FLOOR WASTE
- HB HAND BASIN
- HD HAND BASIN MIXER
- HDM HAND DRYER
- GPO DOUBLE GENERAL POWER OUTLET
- GR GRAB RAIL
- JB JUNIOR BASIN
- JWC JUNIOR TOILET
- KI KICK
- LO LOCK
- LS LOCKER SYSTEM
- LT LAUNDRY TUB
- LTM LAUNDRY TUB MIXER
- MI MIRROR
- MW MICROWAVE
- OS OPEN SHELF
- AOS ADJUSTIVE OPEN SHELF
- OY OVEN
- PTD PAPER TOWEL DISPENSER
- RH RANGE HOOD
- SB SPLASHBACK
- SC SHOWER CURTAIN
- SD SOAP DISPENSER
- SH SHELF
- SHR SHOWER
- SK SINK
- SKD SINK - DOUBLE BOWL
- SKM SINK MIXER
- SKT-01 SKIRTING - GENERAL
- SKT-02 SKIRTING - VINYL COVE
- SM SHOWER MIXER
- S.S. STAINLESS STEEL
- T TRAYS
- TRH TOILET ROLL HOLDER
- TR TOWEL RAIL
- TS TILED SPLASHBACK
- UF UNDER BENCH REFRIGERATOR
- WM WASHING MACHINE
- WT WALL TAP

ELECTRICAL LEGEND

- AB-GPO ABOVE BENCH GPO
- UB-GPO UNDER BENCH GPO
- ALL OTHER EXPOSED GPOS TO BE CHILD SAFE AND MIN 1500mm HIGH IN PLAYROOMS AND CHILDREN'S AMENITIES

*REFER TO ELECTRICAL ENGINEERS DRAWINGS FOR DETAIL

REFER TO ARCHITECTURAL SCHEDULE OF FINISHES FOR MATERIAL AND COLOUR

NOTES:

- *ALL JOINERY DIMENSIONED FROM FINISHED FACE OF WALL
- *ALL PLUMBING DIMENSIONED FROM WALL STRUCTURE
- *LAMINATE SYSTEM FOR TOILET PARTITIONS
- *ALL OPEN SHELVES ON THIS SHEET SHOULD HAVE BACKING AS SAME AS THE SHELVING

- LX-01 LAMINEX, PERUVIAN CLAY
- LX-02 LAMINEX, EARTH
- LX-03 LAMINEX, NATURAL WHITE
- LX-04 LAMINEX, FOSSIL

LEGEND:


AS	ADJUSTABLE SHELF
B	BASIN
BB	BABY BATH
BR	BACK REST
BT	BENCHTOP
COH	COOK HOOD
CS	CLEANER'S SINK
CSM	CLEANER'S SINK MIXER
CT	COOK TOP
D	DRYER
DRWS	DRAWERS
DW	DISHWASHER
DWC	DISABLED WATER CLOSET
DSK	DOUBLE BOWL & DRAIN SINK
FR	REFRIGERATOR
FB	FRUIT WASH BASIN
FP	FIXED PANEL
FS	FOLDING SEAT
FT	FILTER PAIL
FWG	FLOOR WASTE
HB	HAND BASIN
HD	HAND BASIN MIXER
HDM	HAND DRYER
GPO	GROUND GENERAL POWER OUTLET
GR	GRAB RAIL
JB	JUNIOR BASIN
JWC	JUNIOR TUB
KI	KICK
LO	LOCK
LS	LOCKER SYSTEM
LT	LAUNDRY TUB
LTM	LAUNDRY TUB MIXER
M	MIRROR
MW	MICROWAVE
OS	OPEN SHELF
AOS	ADJUSTIVE OPEN SHELF
O	OVEN
PTD	PAPER TOWEL DISPENSER
RH	RANGE HOOD
SB	SPLASHBACK
SC	SHOWER CURTAIN
SD	SOAP DISPENSER
SH	SHELF
SHR	SHOWER
S	SINK
SKD	SINK - DOUBLE BOWL
SKM	SINK MIXER
SKT-01SKRTING - GENERAL	
SKT-02SKRTING - VINYL COVE	
SM	SHOWER MIXER
S.S.	STAINLESS STEEL
T	TRAYS
TRH	TOILET ROLL HOLDER
TR	TOWEL RAIL
TS	TILED SPLASHBACK
UF	UNDER BENCH REFRIGERATOR
WM	WASHING MACHINE
WT	WALL PAT

NOTES:


- ALL JOINERY DIMENSIONED FROM FINISHED FACE OF WALL.
- ALL PLUMBING DIMENSIONED FROM WALL STRUCTURE.
- LAMINATE SYSTEM FOR TOILET PARTITIONS
- ALL OPEN SHELVES ON THIS SHEET SHOULD HAVE BACKING AS SAME AS THE SHELVING




LX-01 LAMINEX, PERUVIAN CLAY
LX-02 LAMINEX, EARTH
LX-03 LAMINEX, NATURAL WHITE
LX-04 LAMINEX, FOSSIL

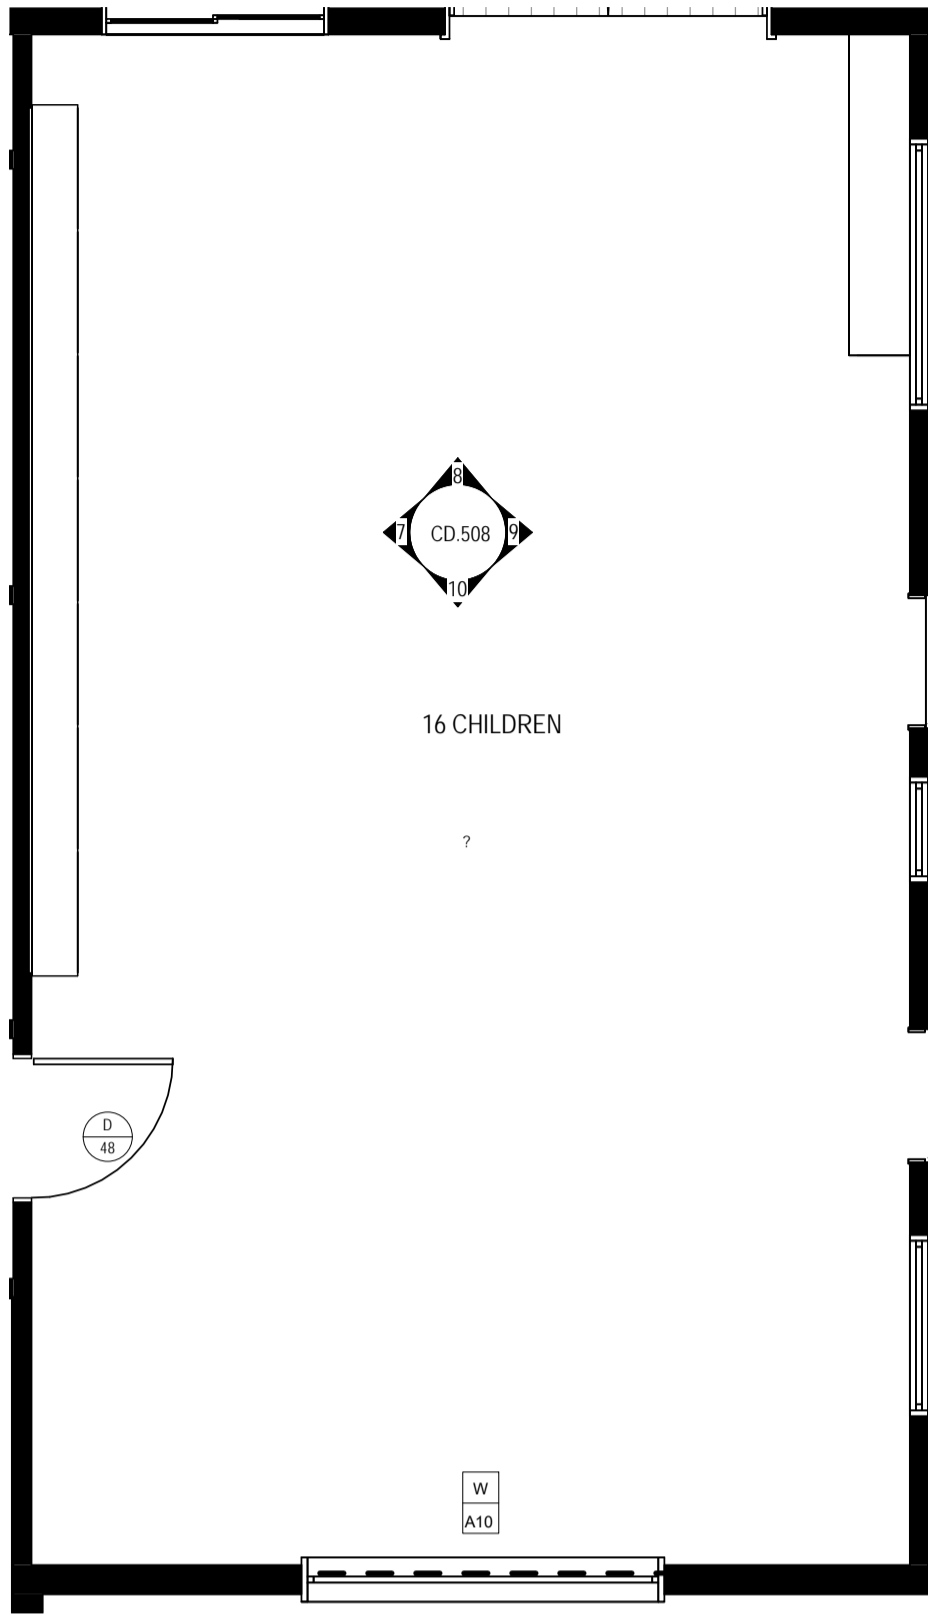


TODDLER 1 - PLAN
1: 50 REFER 1 - CD.200

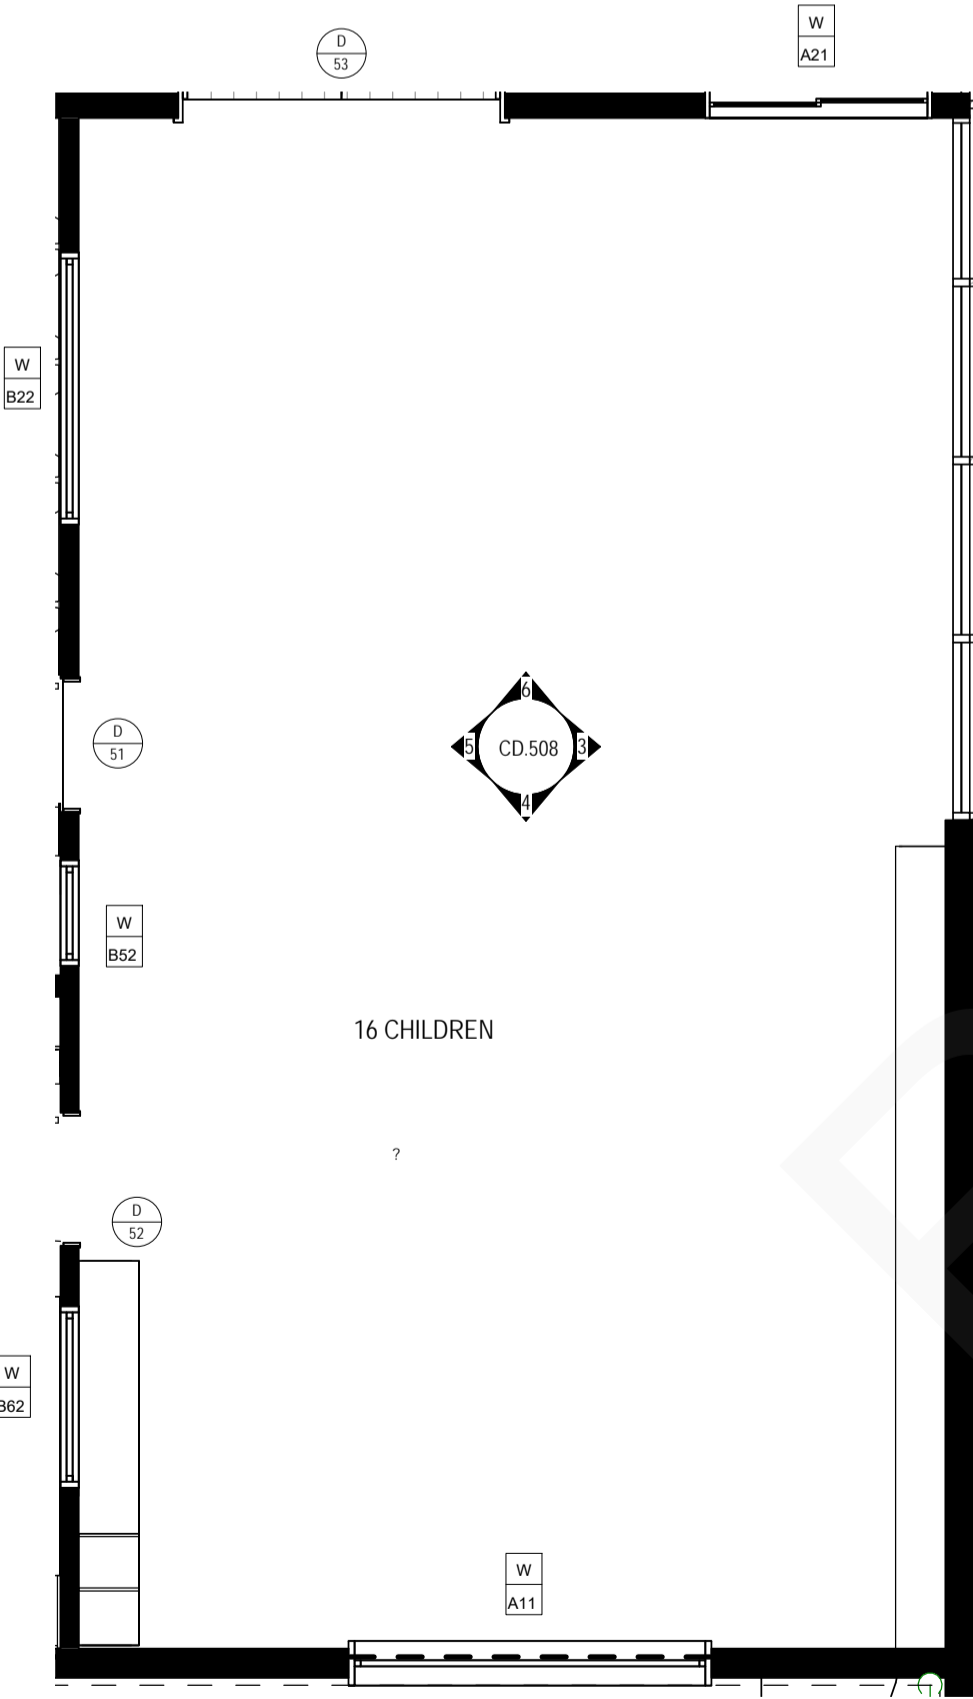


TODDLER 2 - PLAN
1: 50 REFER 2 - CD.200

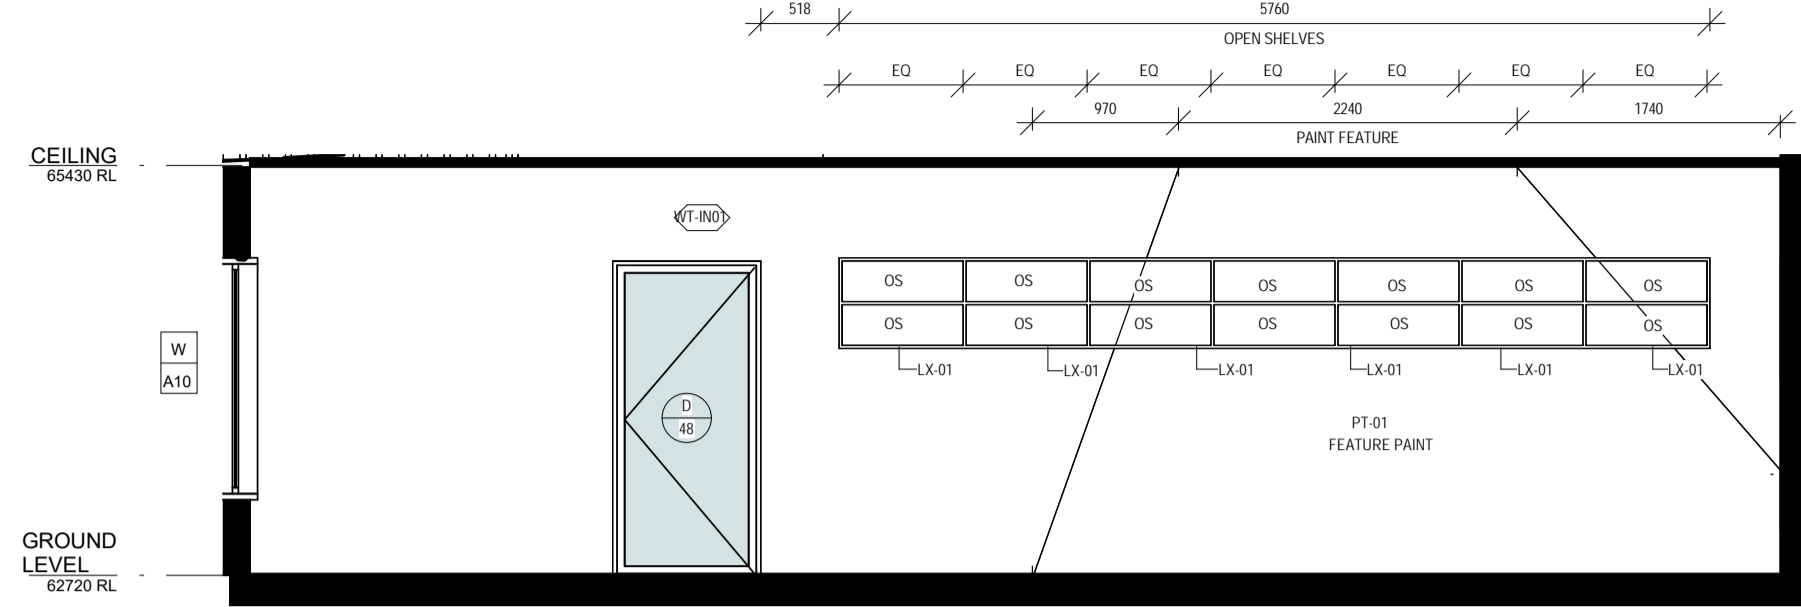


TODDLER 1 ELEV. 7
1: 50 REFER 7 - CD.508

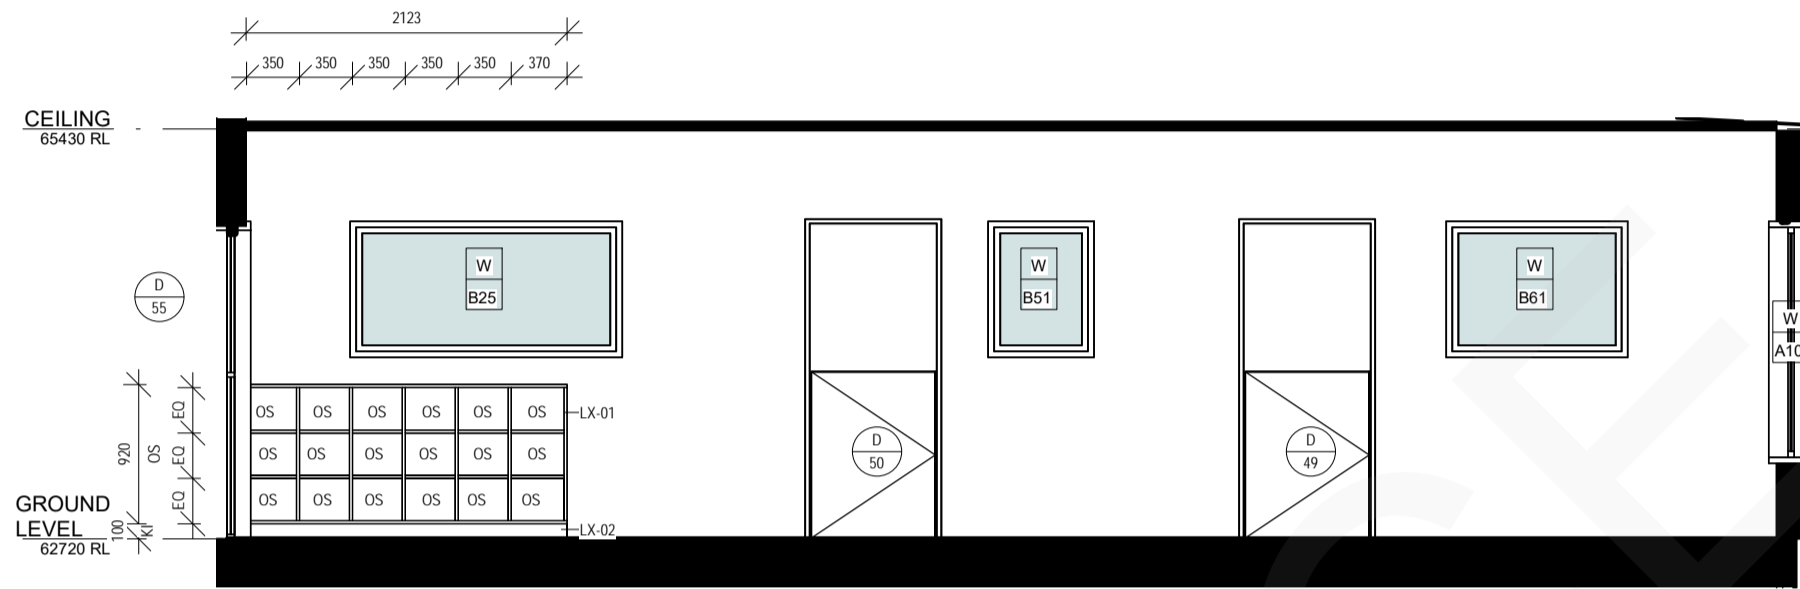


TODDLER 1 ELEV. 9
1: 50 REFER 9 - CD.508

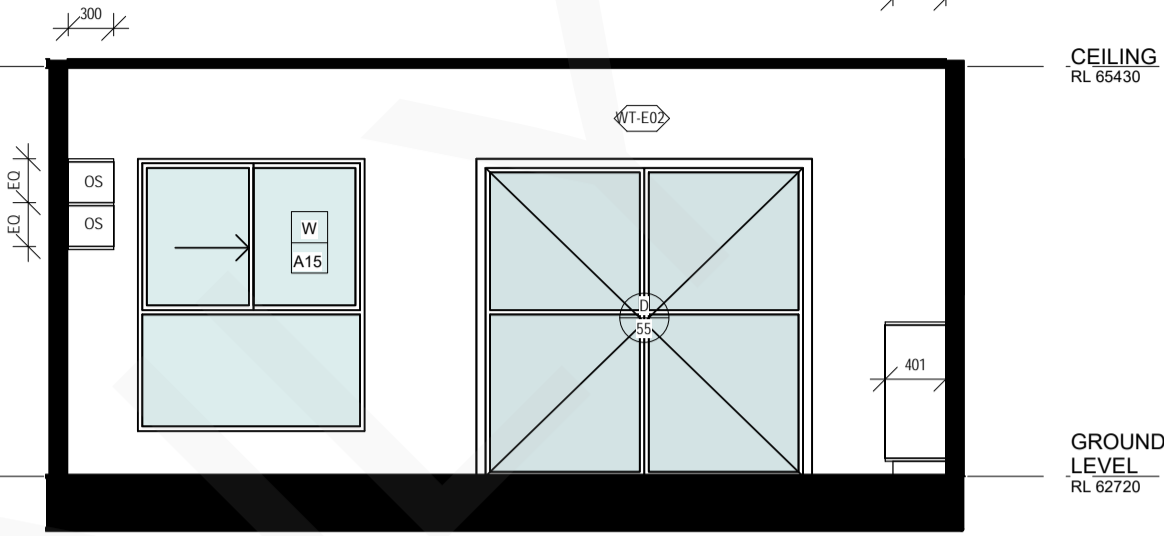


TODDLER 1 ELEV. 8
1: 50 REFER 8 - CD.504

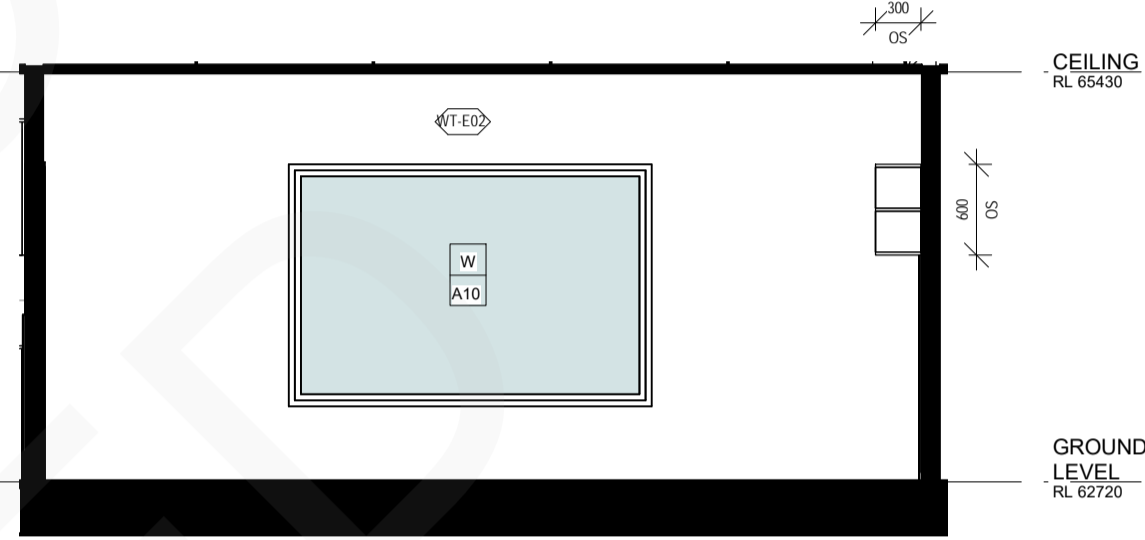


TODDLER 1 ELEV. 10
1: 50 REFER 10 - CD.504

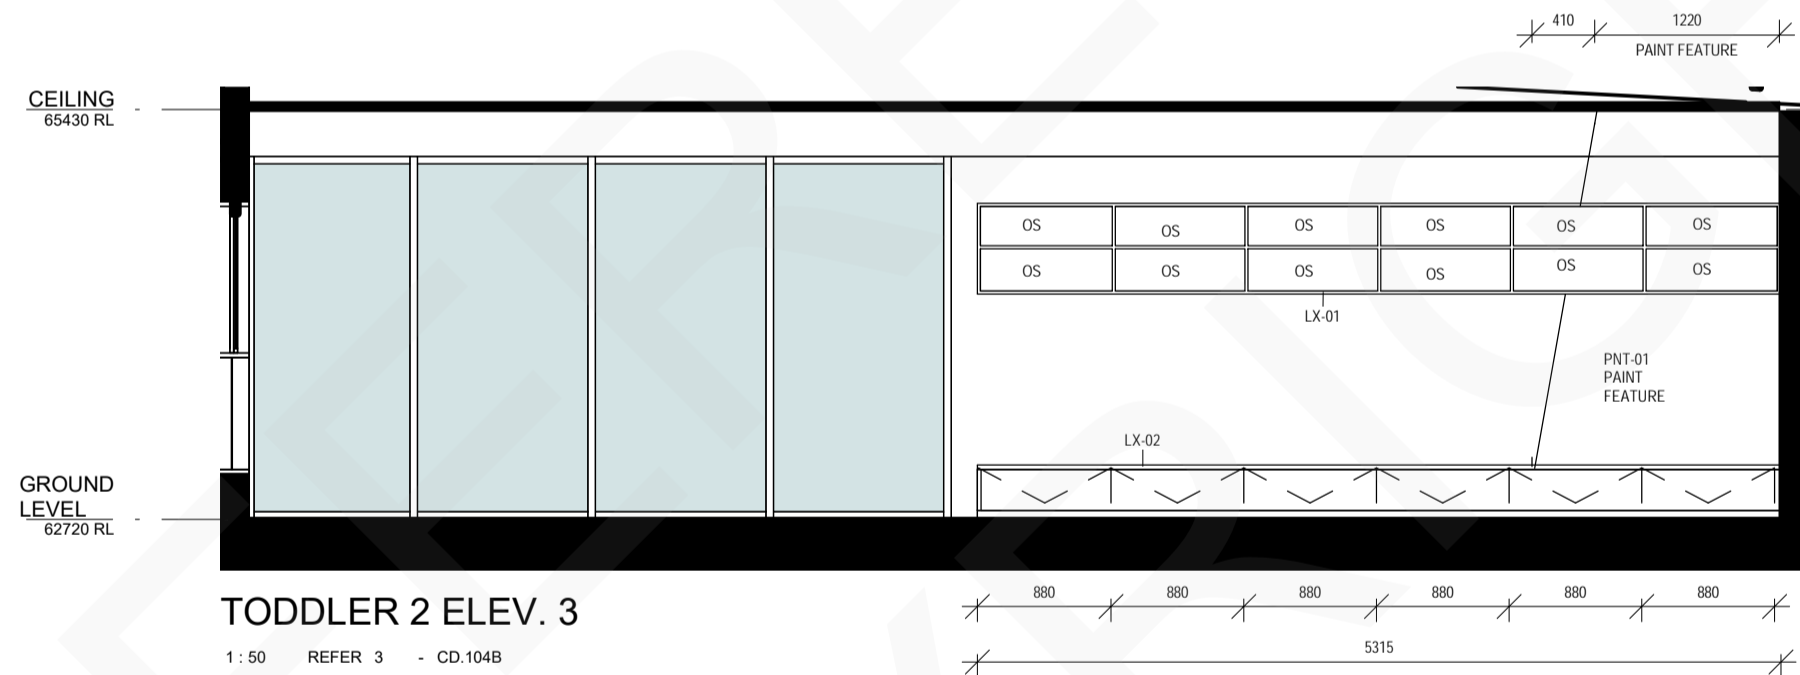


TODDLER 2 ELEV. 3
1: 50 REFER 3 - CD.1048

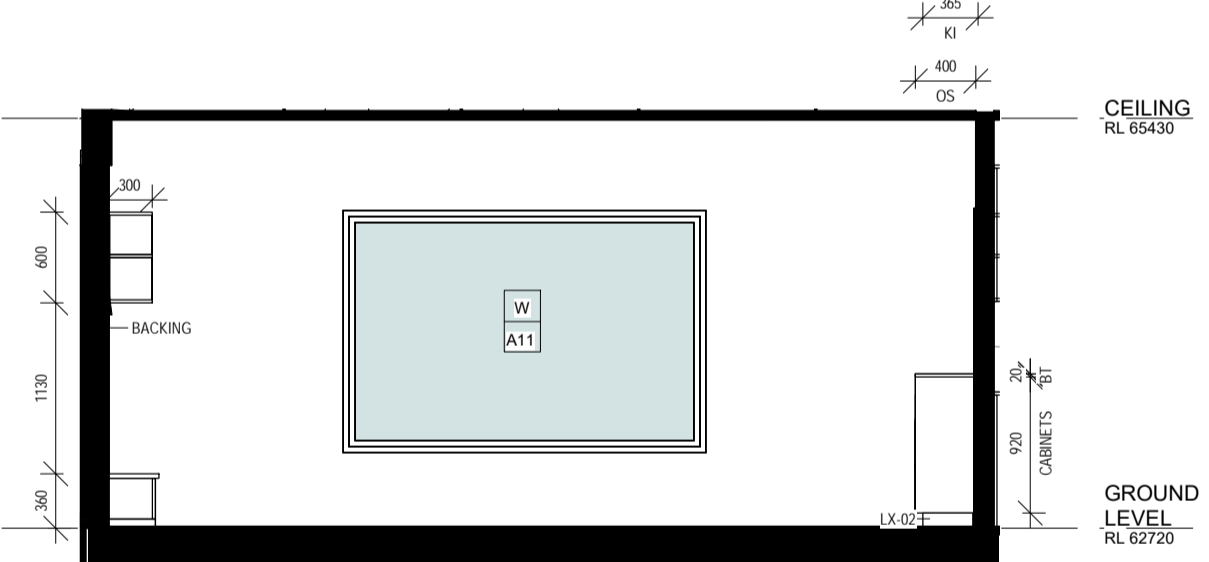

TODDLER 2 ELEV. 4
1: 50 REFER 4 - CD.505

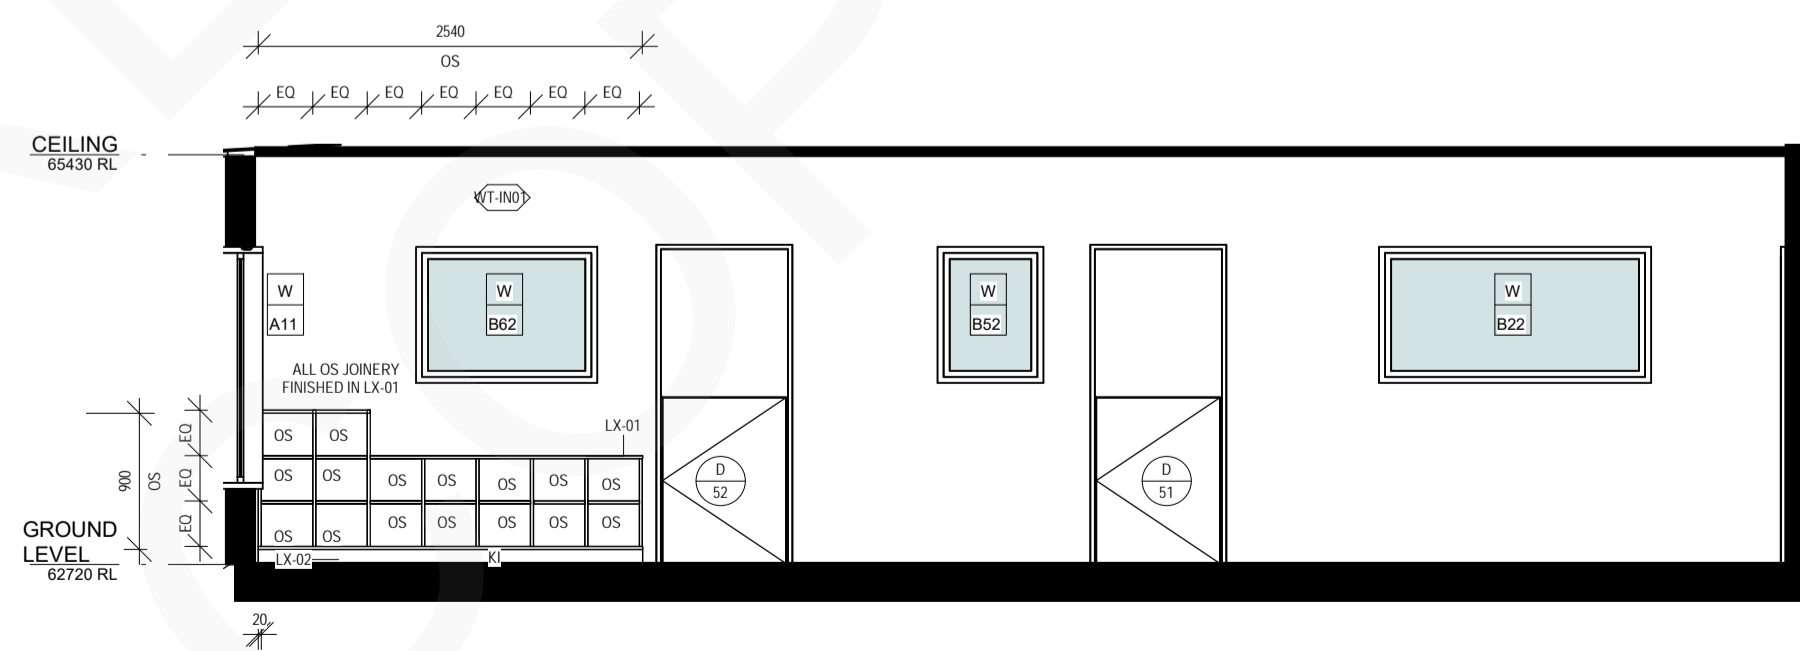

TODDLER 2 ELEV. 5
1: 50 REFER 5 - CD.508

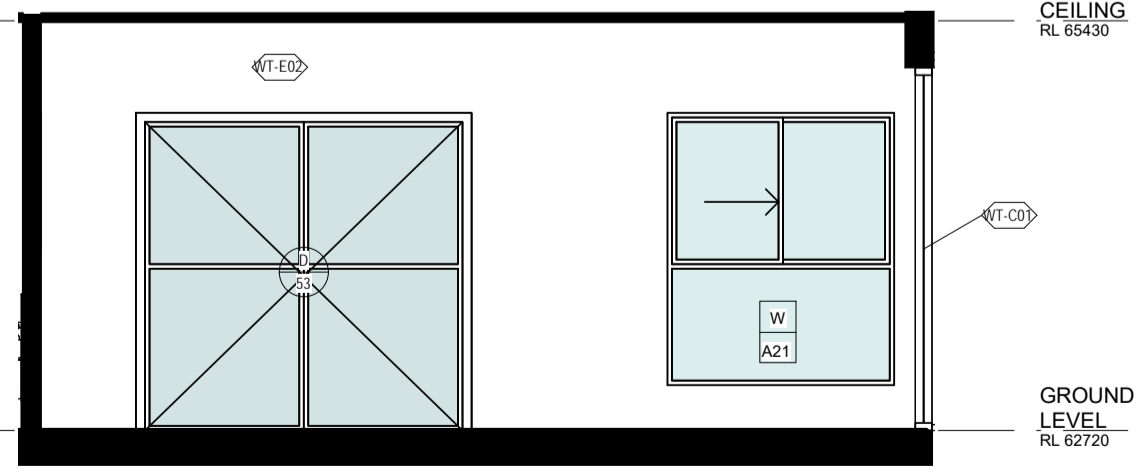

TODDLER 2 ELEV. 6
1: 50 REFER 6 - CD.508

LEGEND:

- AS ADJUSTABLE SHELF
- B BASIN
- BB BABY BATH
- BR BACK REST
- BT BENCHTOP
- COH COAT HOOK
- CS CLEANER'S SINK
- CSM CLEANER'S SINK MIXER
- CT COOK TOP
- D DRYER
- DRWS DRAWERS
- DW DISHWASHER
- DWC DISABLED WATER CLOSET
- DSK DOUBLE BOWL & DRAIN SINK
- F REFRIGERATOR
- FB FRUIT WASH BASIN
- FP FIXED PANEL
- FS FOLDING SEAT
- FT FILTER TAP
- FWG FLOOR WASTE
- HB HAND BASIN
- HD HAND BASIN MIXER
- HDW HAND DRYER
- GPO DOUBLE GENERAL POWER OUTLET
- GR GRAB RAIL
- JB JUNIOR BASIN
- JWC JUNIOR TOILET
- KJ KICK
- LO LOCK
- LS LOCKER SYSTEM
- LT LAUNDRY TUB
- LTM LAUNDRY TUB MIXER
- MI MIRROR
- MW MICROWAVE
- OS OPEN SHELF
- ADS ADJUSTIVE OPEN SHELF
- OV OVEN
- PTD PAPER TOWEL DISPENSER
- RH RANGE HOOD
- SB SPLASHBACK
- SC SHOWER CURTAIN
- SD SOAP DISPENSER
- SH SHELF
- SHR SHOWER
- SK SINK
- SKD SINK - DOUBLE BOWL
- SKM SINK MIXER
- SKT-01 SKIRTING - GENERAL
- SKT-02 SKIRTING - VINYL COVE
- SM SHOWER MIXER
- S.S. STAINLESS STEEL
- T TRAYS
- TRH TOILET ROLL HOLDER
- TR TOWEL RAIL
- TS TILED SPLASHBACK
- UF UNDER BENCH REFRIGERATOR
- WM WASHING MACHINE
- WT WALL TAP

ELECTRICAL LEGEND

- AB-GPO ABOVE BENCH GPO
- UB-GPO UNDER BENCH GPO
- ALL OTHER EXPOSED GPOS TO BE CHILD SAFE AND MIN 1500mm HIGH IN PLAYROOMS AND CHILDREN'S MENITIES
- **REFER TO ELECTRICAL ENGINEERS DRAWINGS FOR DETAIL

REFER TO ARCHITECTURAL SCHEDULE OF FINISHES FOR MATERIAL AND COLOUR

NOTES:

- ALL JOINERY DIMENSIONED FROM FINISHED FACE OF WALL.
- ALL PLUMBING DIMENSIONED FROM WALL STRUCTURE.
- LAMINATE SYSTEM FOR TOILET PARTITIONS
- ALL OPEN SHELVES ON THIS SHEET SHOULD HAVE BACKING AS SAME AS THE SHELVING

- LX-01 LAMINEX, PERUVIAN CLAY
- LX-02 LAMINEX, EARTH
- LX-03 LAMINEX, NATURAL WHITE
- LX-04 LAMINEX, FOSSIL